


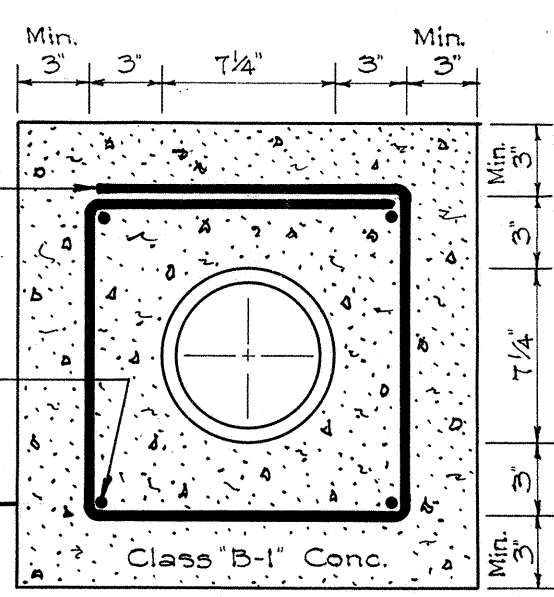


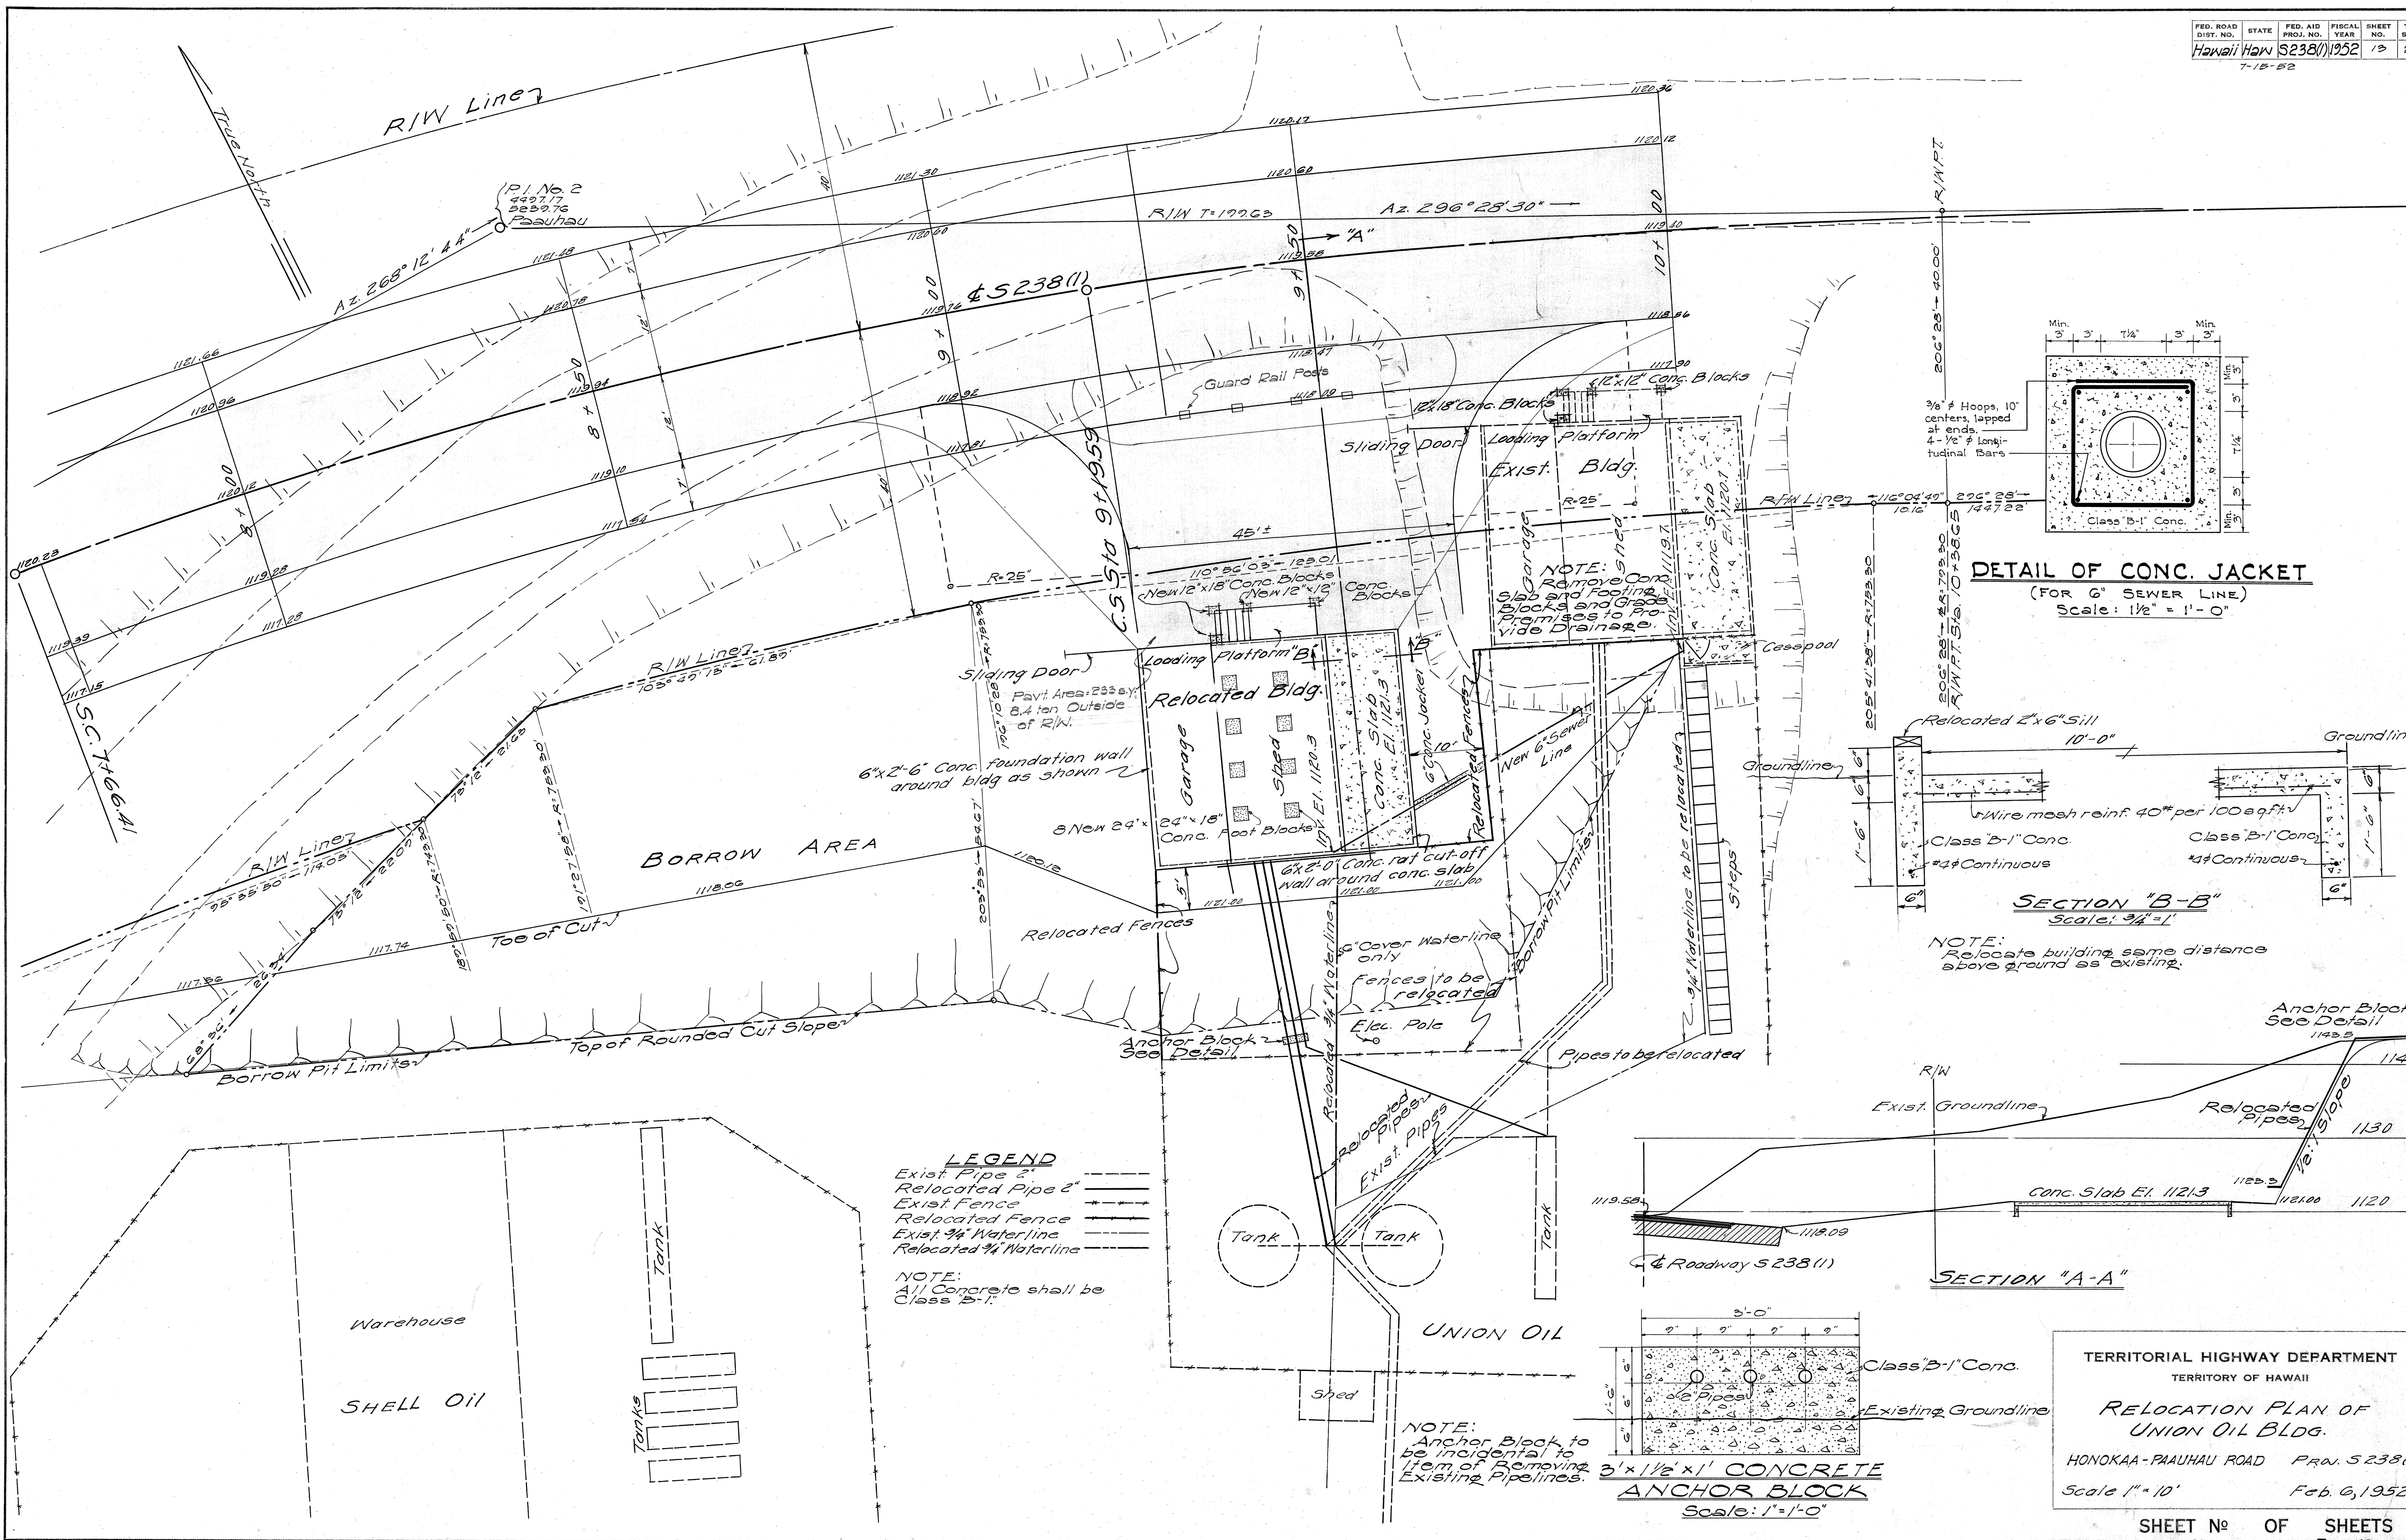


DETAIL OF CONC. JACKET
(FOR 6\"/>

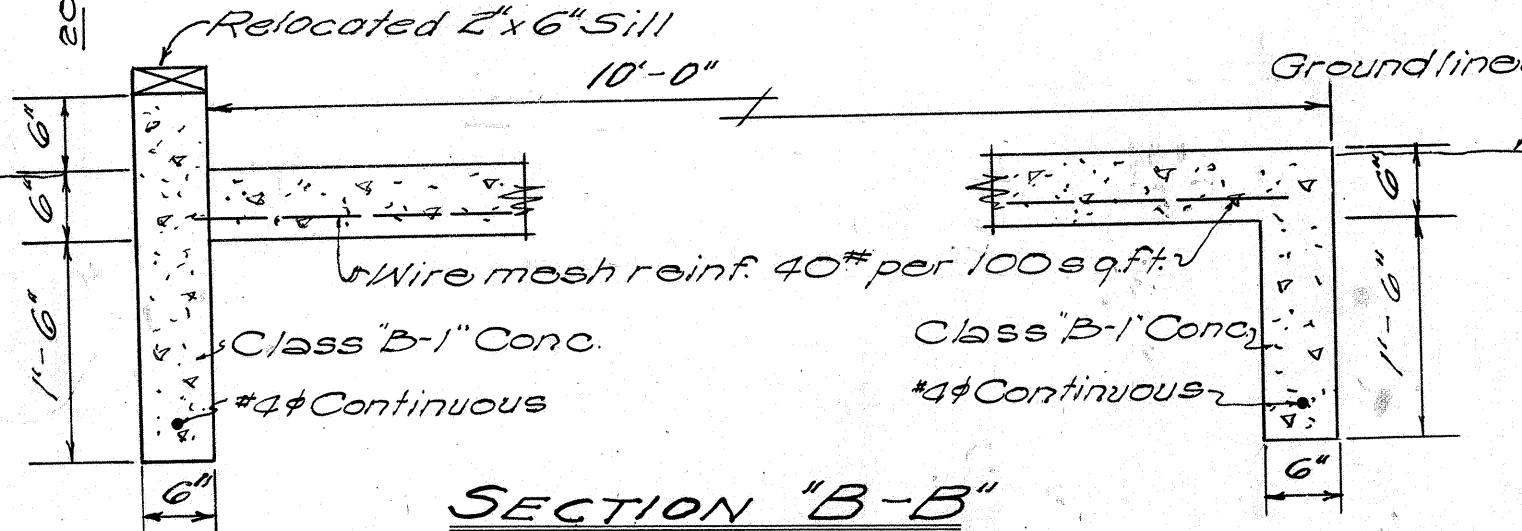

SECTION 'B-B'
Scale: 3/4\"/>

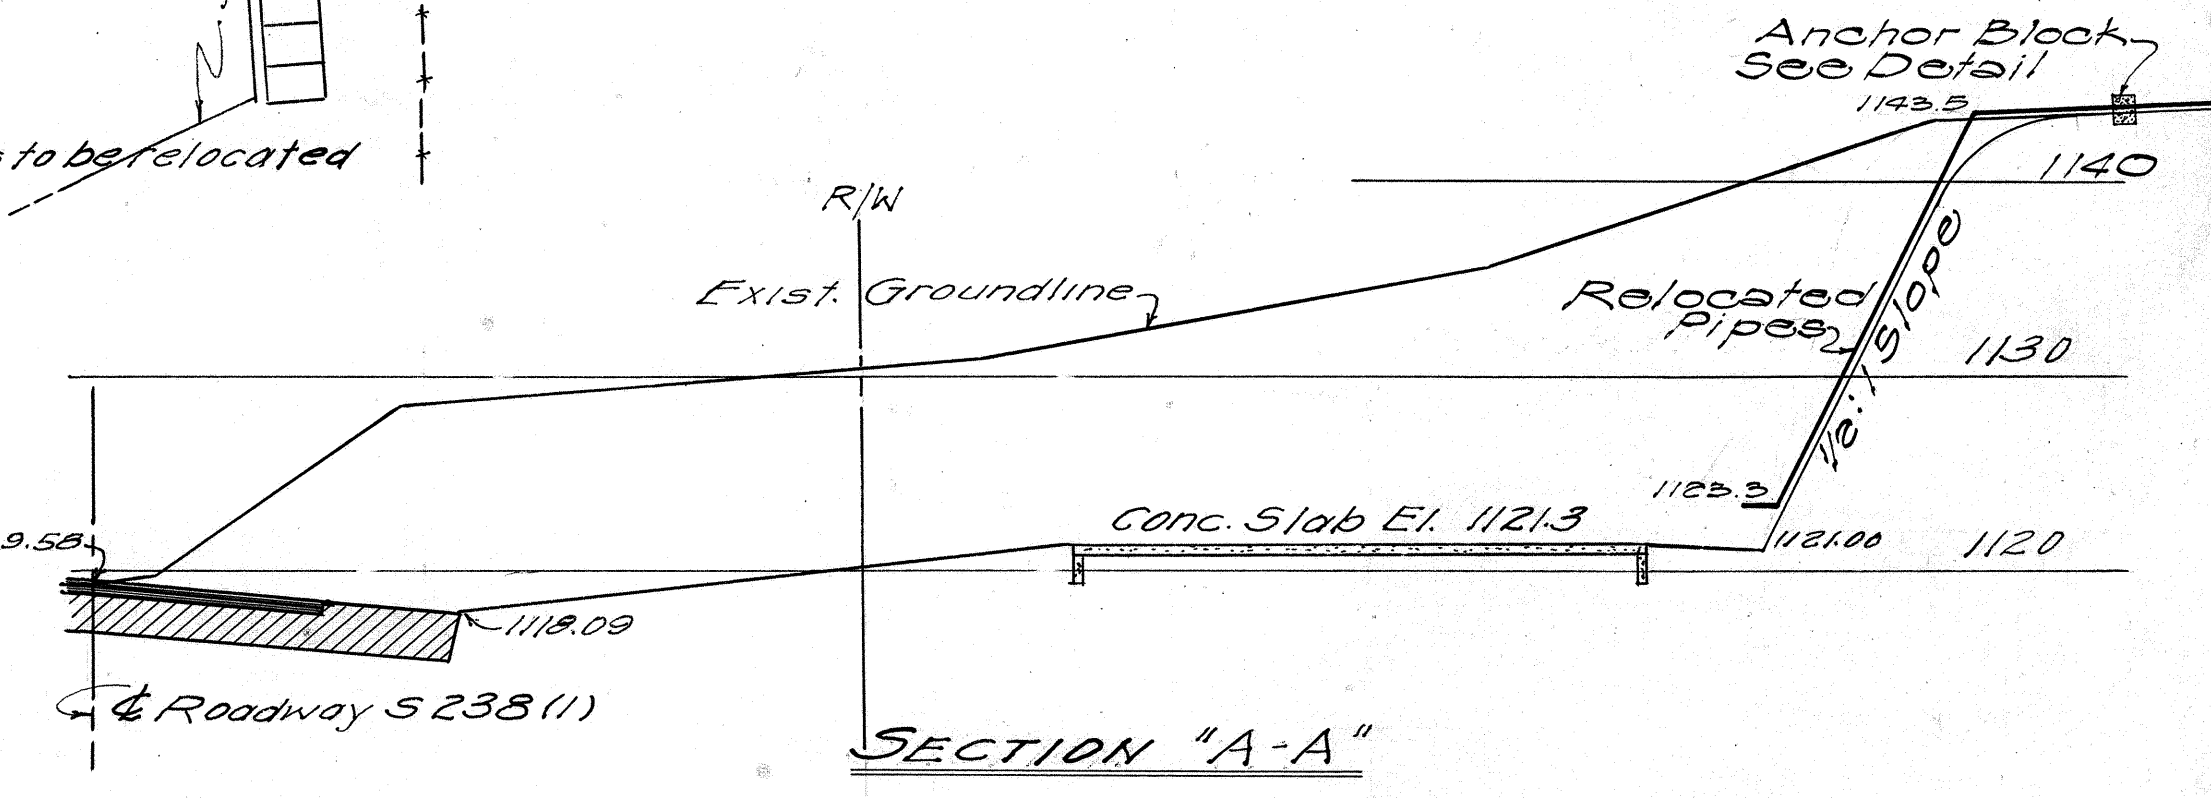

SECTION 'A-A'

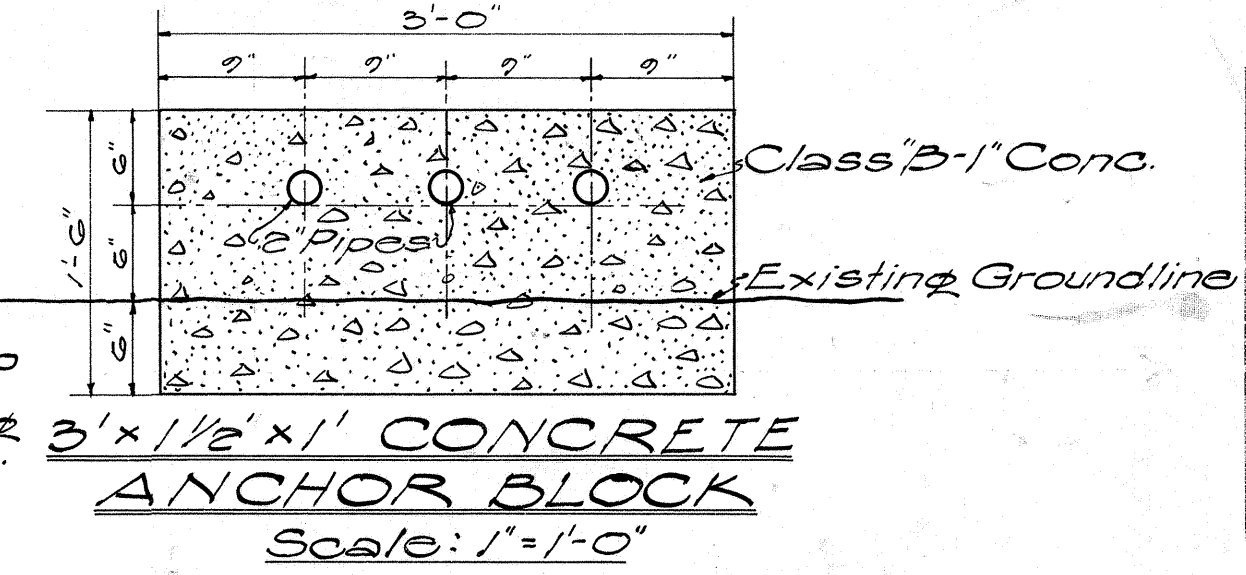

ANCHOR BLOCK
Scale: 1\"/>

LEGEND
Exist. Pipe 2\"/>
Relocated Pipe 2\"
Exist. Fence
Relocated Fence
Exist. 3/4\" Waterline
Relocated 3/4\" Waterline

NOTE:
All Concrete shall be
Class 'B-1'.

NOTE:
Anchor Block to
be incidental to
item of Removing
Existing Pipelines.

TERRITORIAL HIGHWAY DEPARTMENT
TERRITORY OF HAWAII
**RELOCATION PLAN OF
UNION OIL BLDG.**
HONOKAA-PAUHAU ROAD PRJ. 5238(1)
Scale 1\"/>