

INDEX TO DRAWINGS	
SHEET	DESCRIPTION
1	TITLE SHEET
2	TYPICAL SECTION
3	BORROW PIT
4-7	PLAN AND PROFILE
8	INTERSECTION DETAILS
9	SOIL PROFILE
10-12	STANDARD DETAILS
13	RELOCATION OF BUILDINGS
14-18	BOX CULVERT DETAILS
19-20	CROSS SECTIONS

CONVENTIONAL SIGNS USED

Centerline	155
Boundary Line	or,
Fences (Noted)	x x or,
Existing Roadway	
Box Culvert	
Circular Culvert	
Bridge	
Railroad	or,
Tree (Large)	or,
Telephone Pole	OTP
Electric Line Pole	EP
Water Main	W ₄ W ₈
Water Valve	WV
Water Valve Manhole	WVMH
Storm Drain Manhole	SDMH
Sewer Manhole	SMH
Fire Hydrant	FH
Warning & Regulatory Signs	Type
Centerline Monuments	©

TERRITORY OF HAWAII
TERRITORIAL HIGHWAY DEPARTMENT
HONOLULU T.H.
PLANS OF


HONOKAA-PAAUHAU ROAD

FEDERAL AID SECONDARY PROJECT NO. S 238(I)

DISTRICT OF HAMAKUA
ISLAND OF HAWAII


SCALES

PLAN	1 INCH = 50 FT.
PROFILE	HOR. 1 INCH = 50 FT.
	VER. 1 INCH = 5 FT.
CROSS SECTION	HOR. 1 INCH = 10 FT.
	VER. 1 INCH = 10 FT.

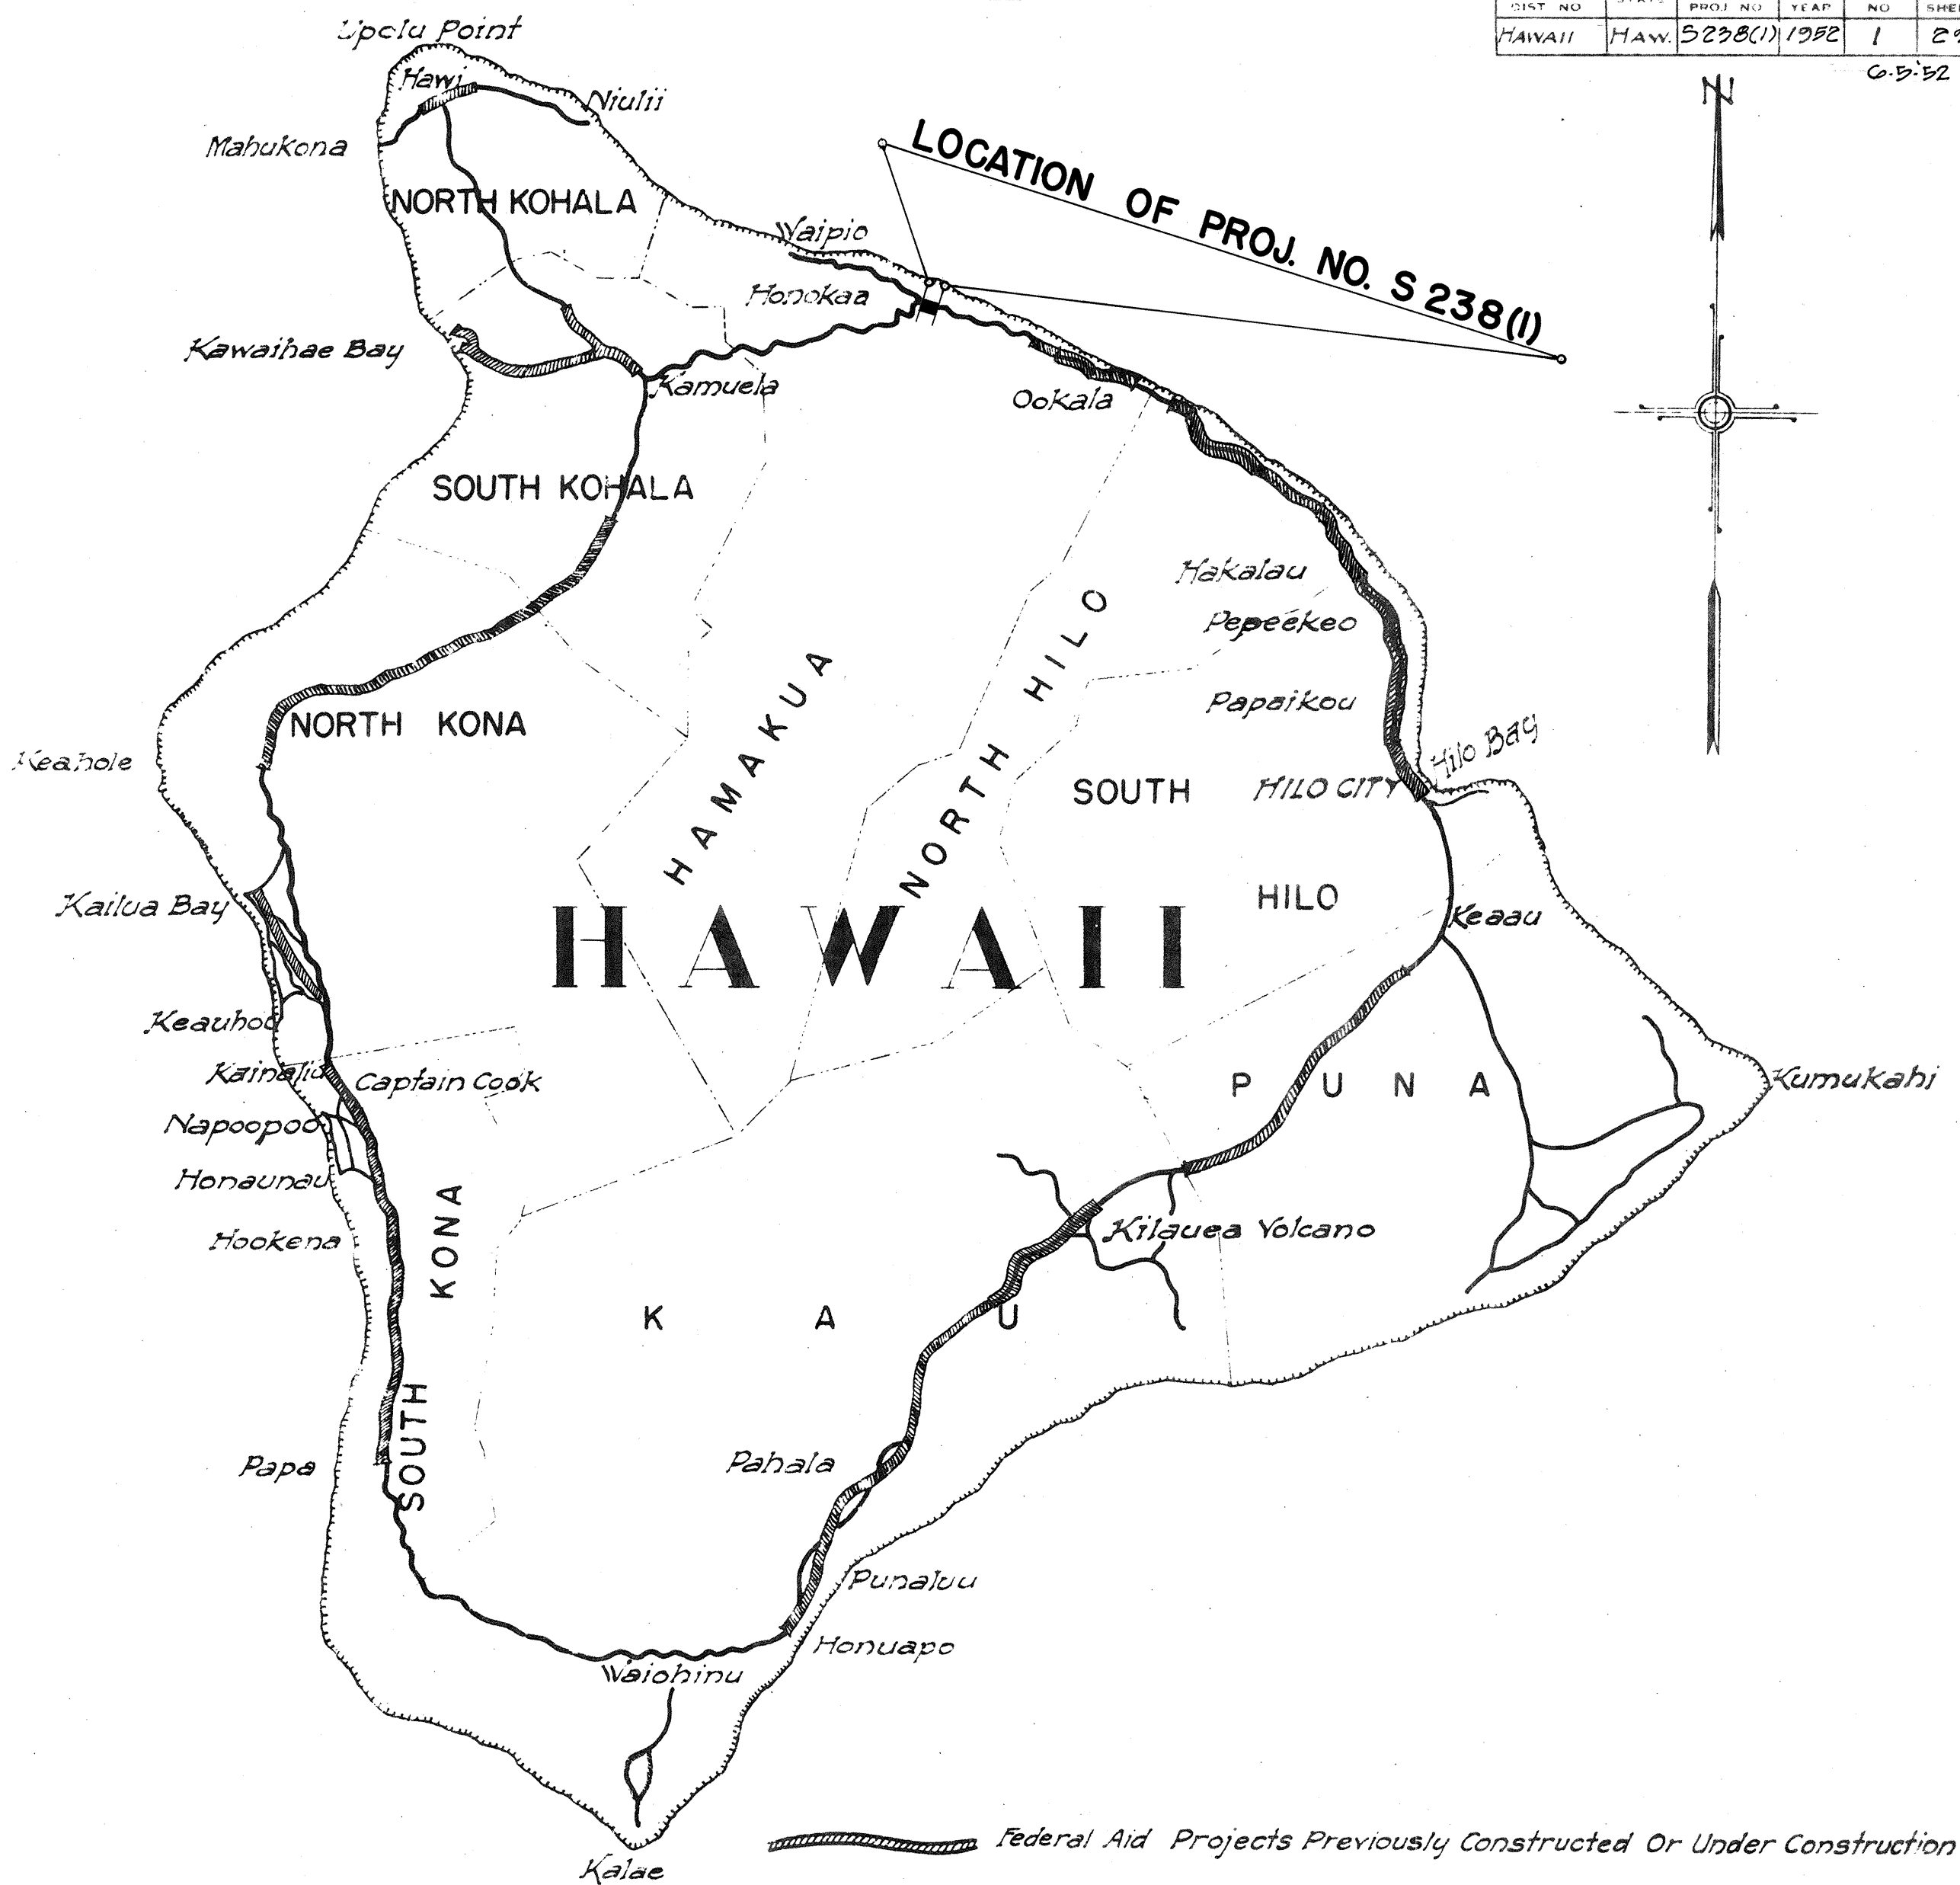

NOTE:
ALL CHANGES MADE DURING CONSTRUCTION
HAVE BEEN NOTED IN RED ON THESE TRACINGS
AND CHECKED BY:

Melvin D. Lepine
RESIDENT ENGINEER
May 8, 1953
DATE

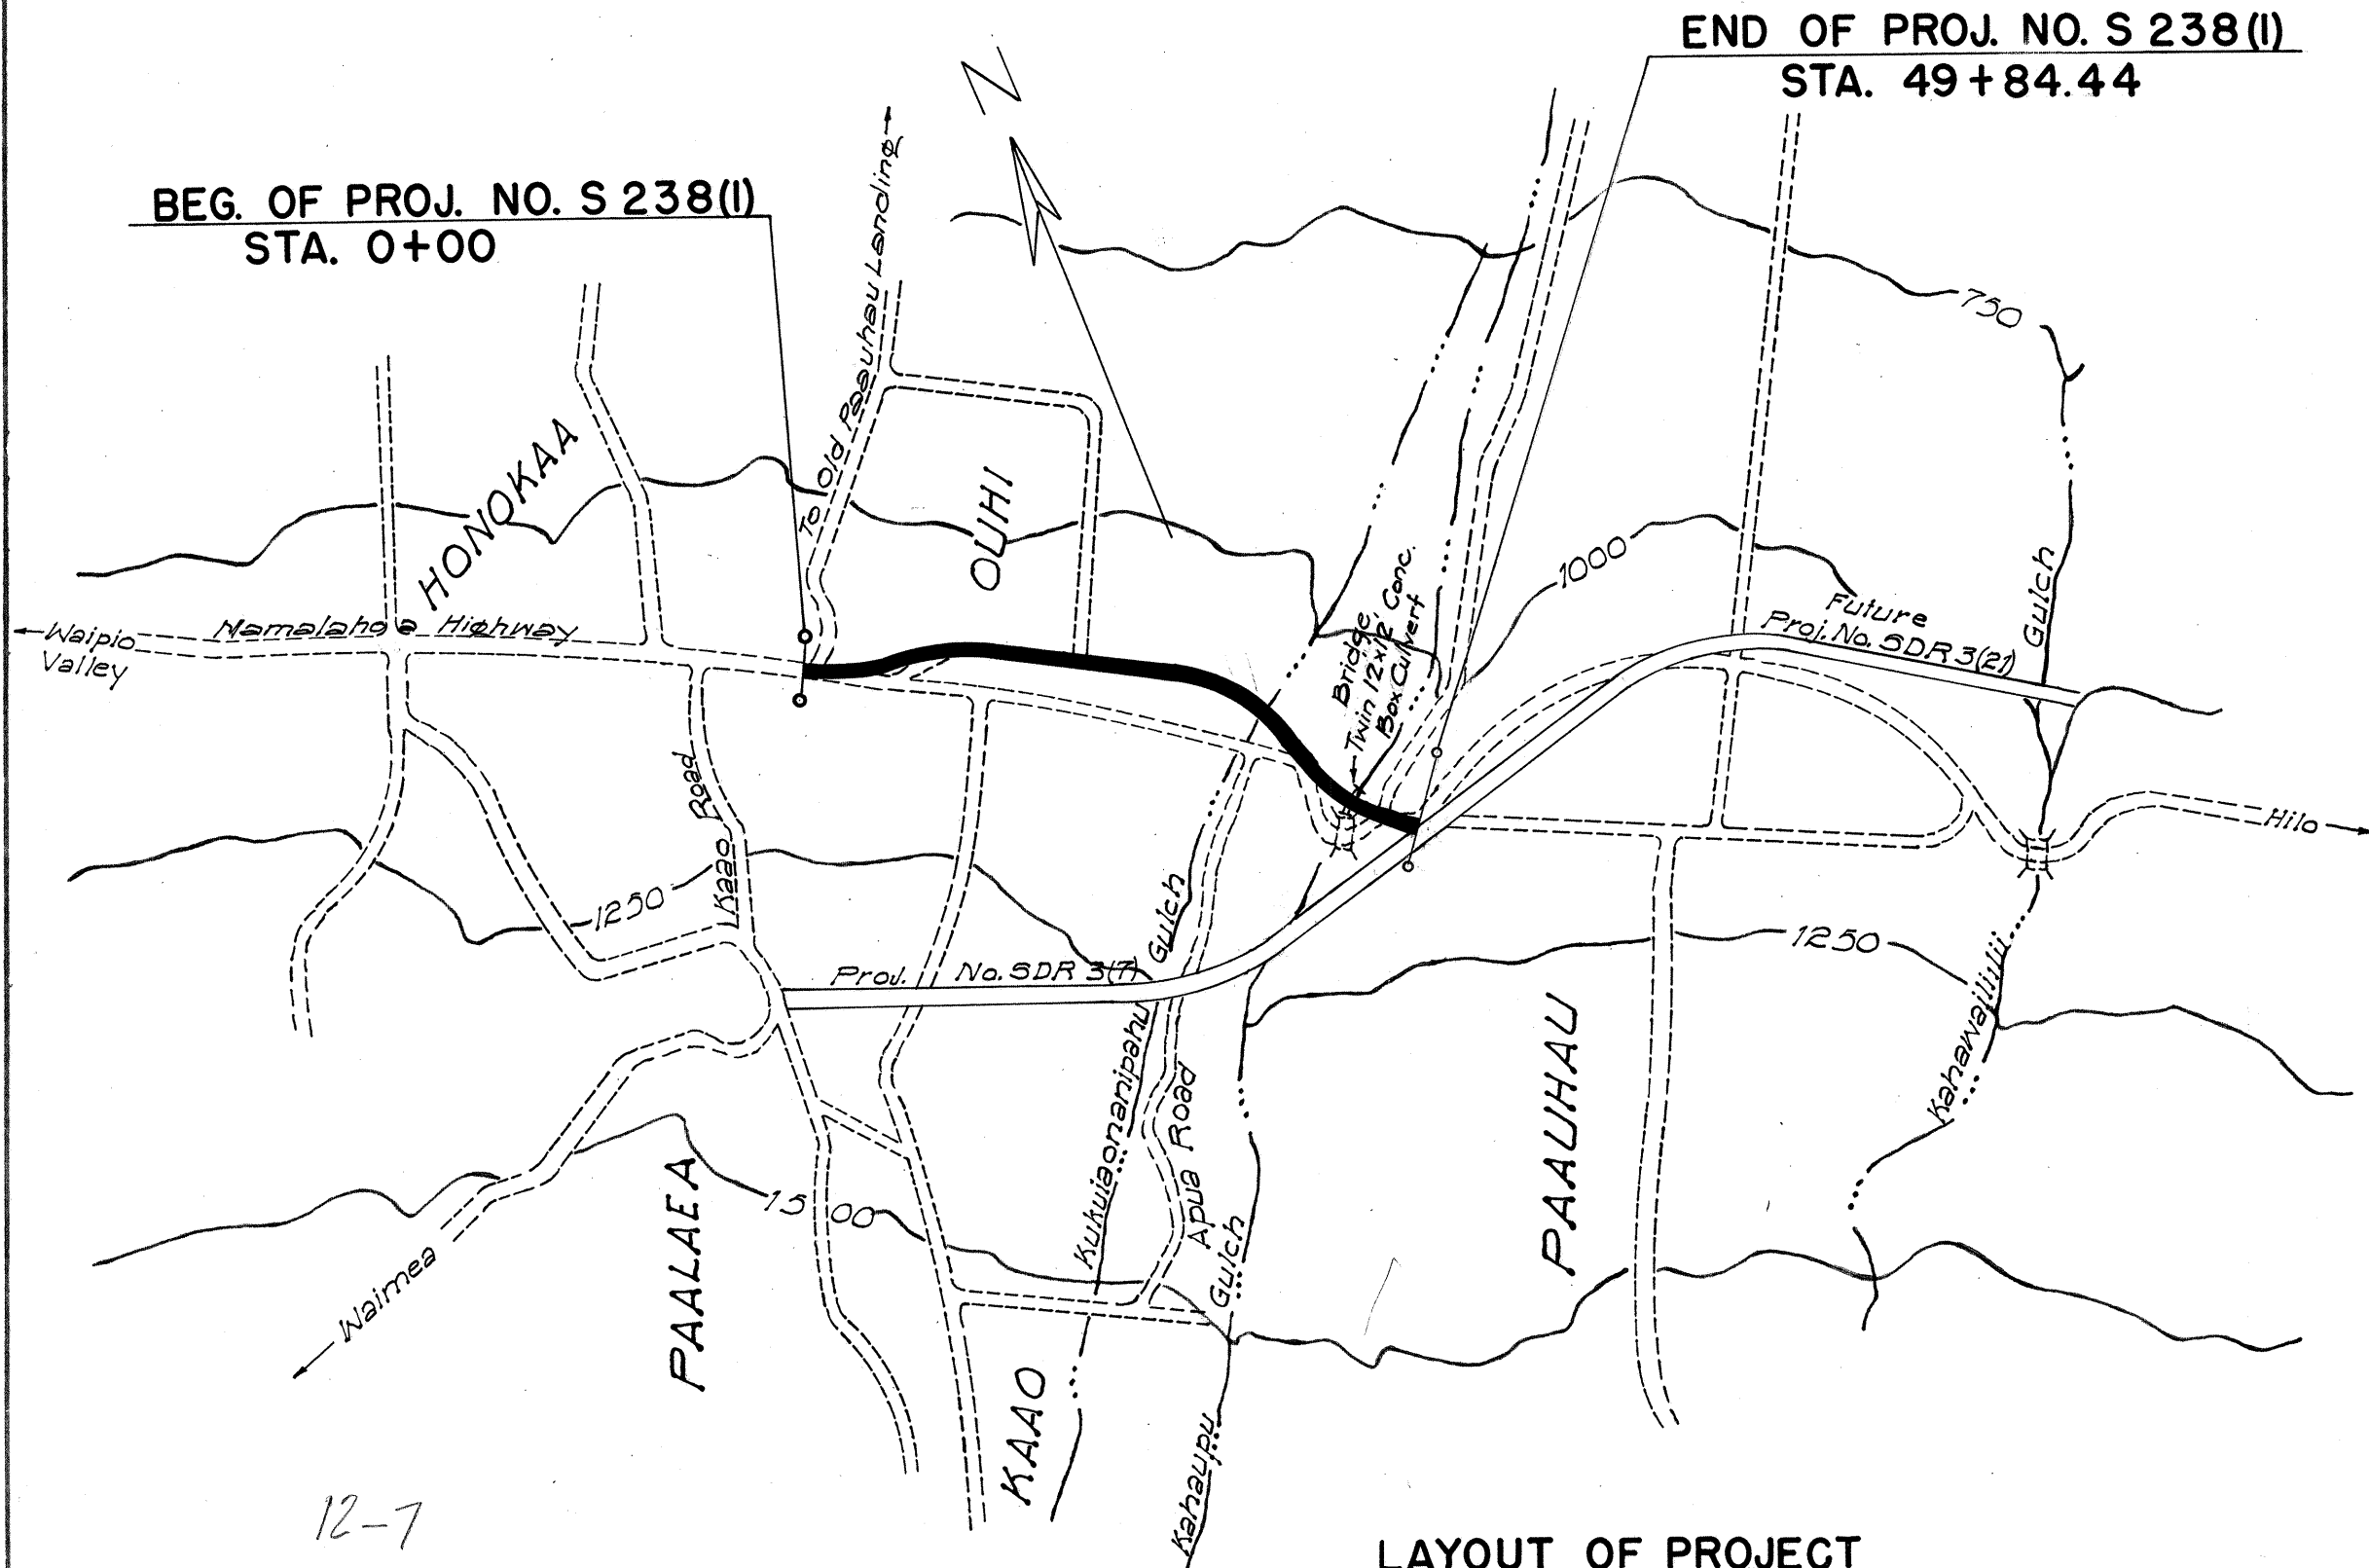

GROSS LENGTH OF PROJECT = 0.943 Miles
BRIDGES OVER 20'-0" SPAN = 0.005 Miles
NET LENGTH OF ROADWAY = 0.938 Miles

APPROVED: *Don Bell*
TERRITORIAL HIGHWAY ENGINEER

DEPARTMENT OF COMMERCE BUREAU OF PUBLIC ROADS	
RECOMMENDED FOR APPROVAL:	
DISTRICT ENGINEER	DATE
APPROVED:	
DIVISION ENGINEER	DATE