

INDEX TO DRAWINGS	
SHEET NO.	DESCRIPTION
1	TITLE SHEET
2 - 3	TYPICAL SECTIONS
4 - 8	PLAN AND PROFILE
9	DETAIL PLAN OF CONNECTION TRANSITION
10 - 19	ROADWAY STANDARD AND MISCELLANEOUS DETAILS
20 - 33	DRAINAGE DETAILS
34 - 36	WAI PUNAHOE STREAM BRIDGE
37 - 40	WAIKALOA STREAM BRIDGE
41 - 49	BRIDGE STANDARD AND MISCELLANEOUS DETAILS
50 - 69	CROSS SECTIONS


STATE OF HAWAII
DEPARTMENT OF TRANSPORTATION
HIGHWAYS DIVISION

"AS BUILT" PLANS FOR
HONOKAA - WAIPIO ROAD
PROJECT NO. 240A-01-67

DISTRICT OF HAMAKUA
ISLAND OF HAWAII

SCALES


PLAN_____	INCH = 100 FT.
PROFILE_____	HOR. INCH = 100 FT.
	VER. INCH = 10 FT.
CROSS SECTION_____	HOR. INCH = 10 FT.
	VER. INCH = 10 FT.

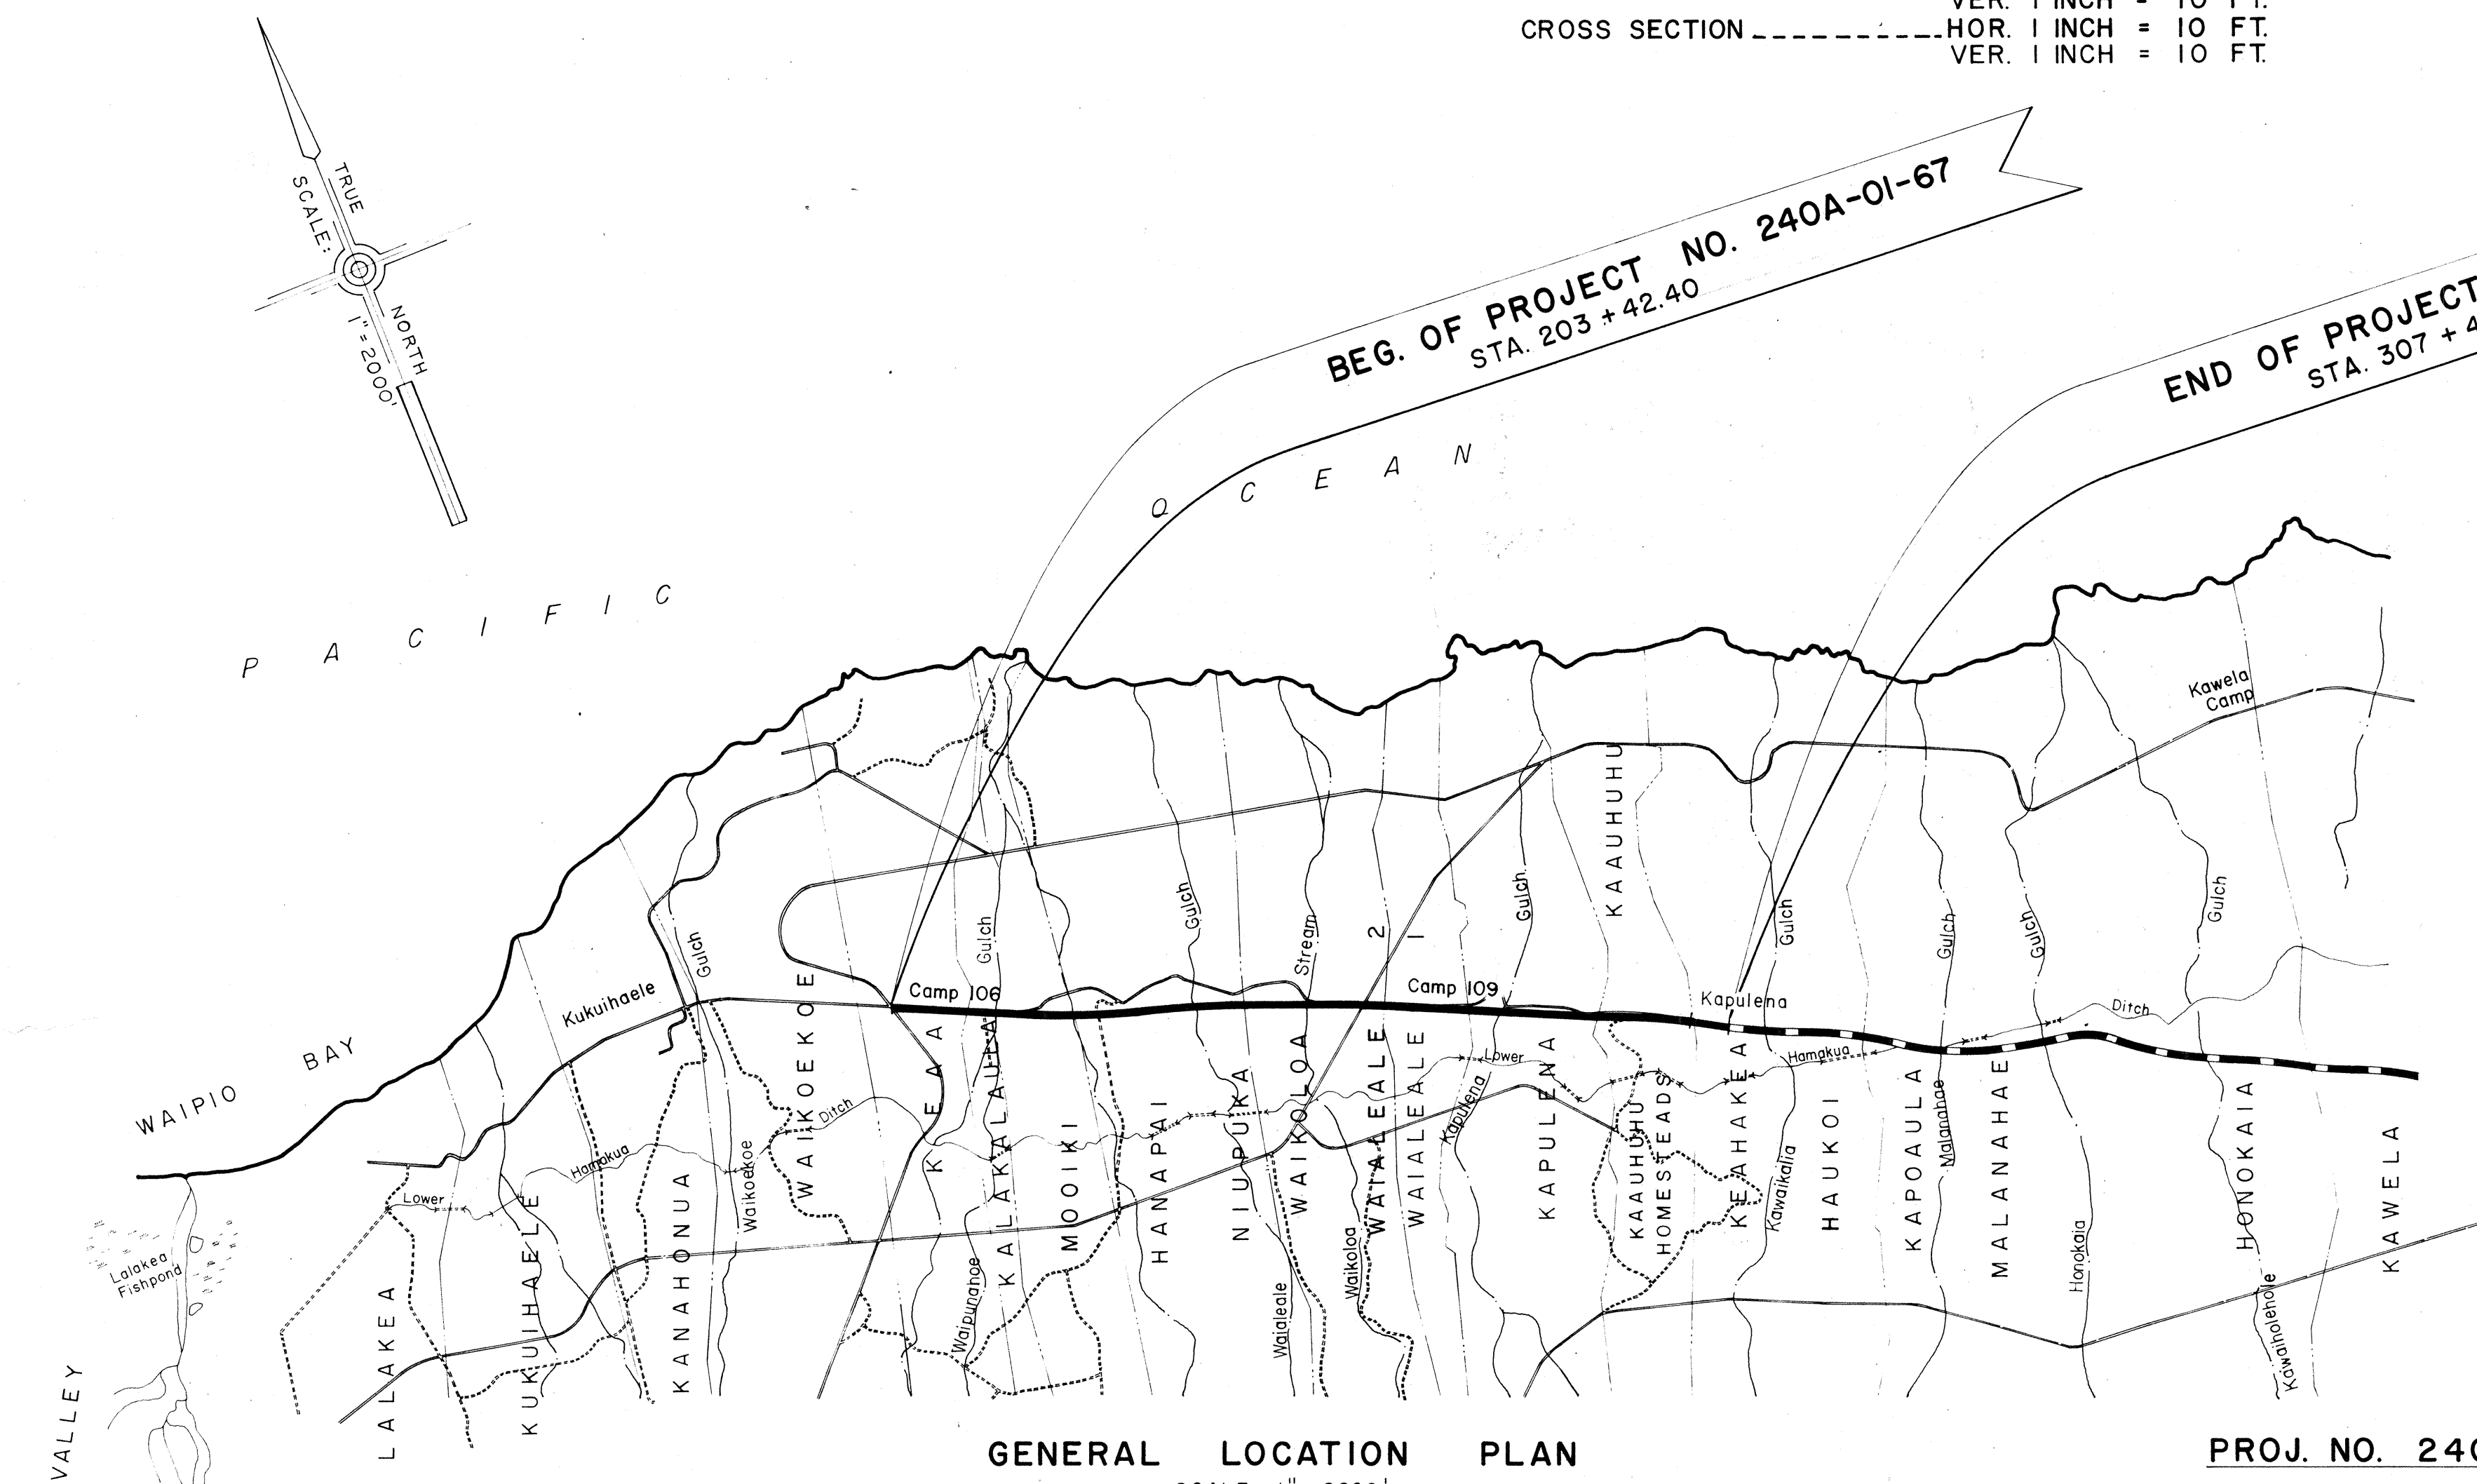

GENERAL LOCATION PLAN
SCALE: 1" = 2000'

PROJ. NO. 240A-01-67

LENGTH OF ROADWAY	2.312	Mi.
LENGTH OF BRIDGE	0.035	Mi.
LENGTH OF PROJECT	2.347	Mi.

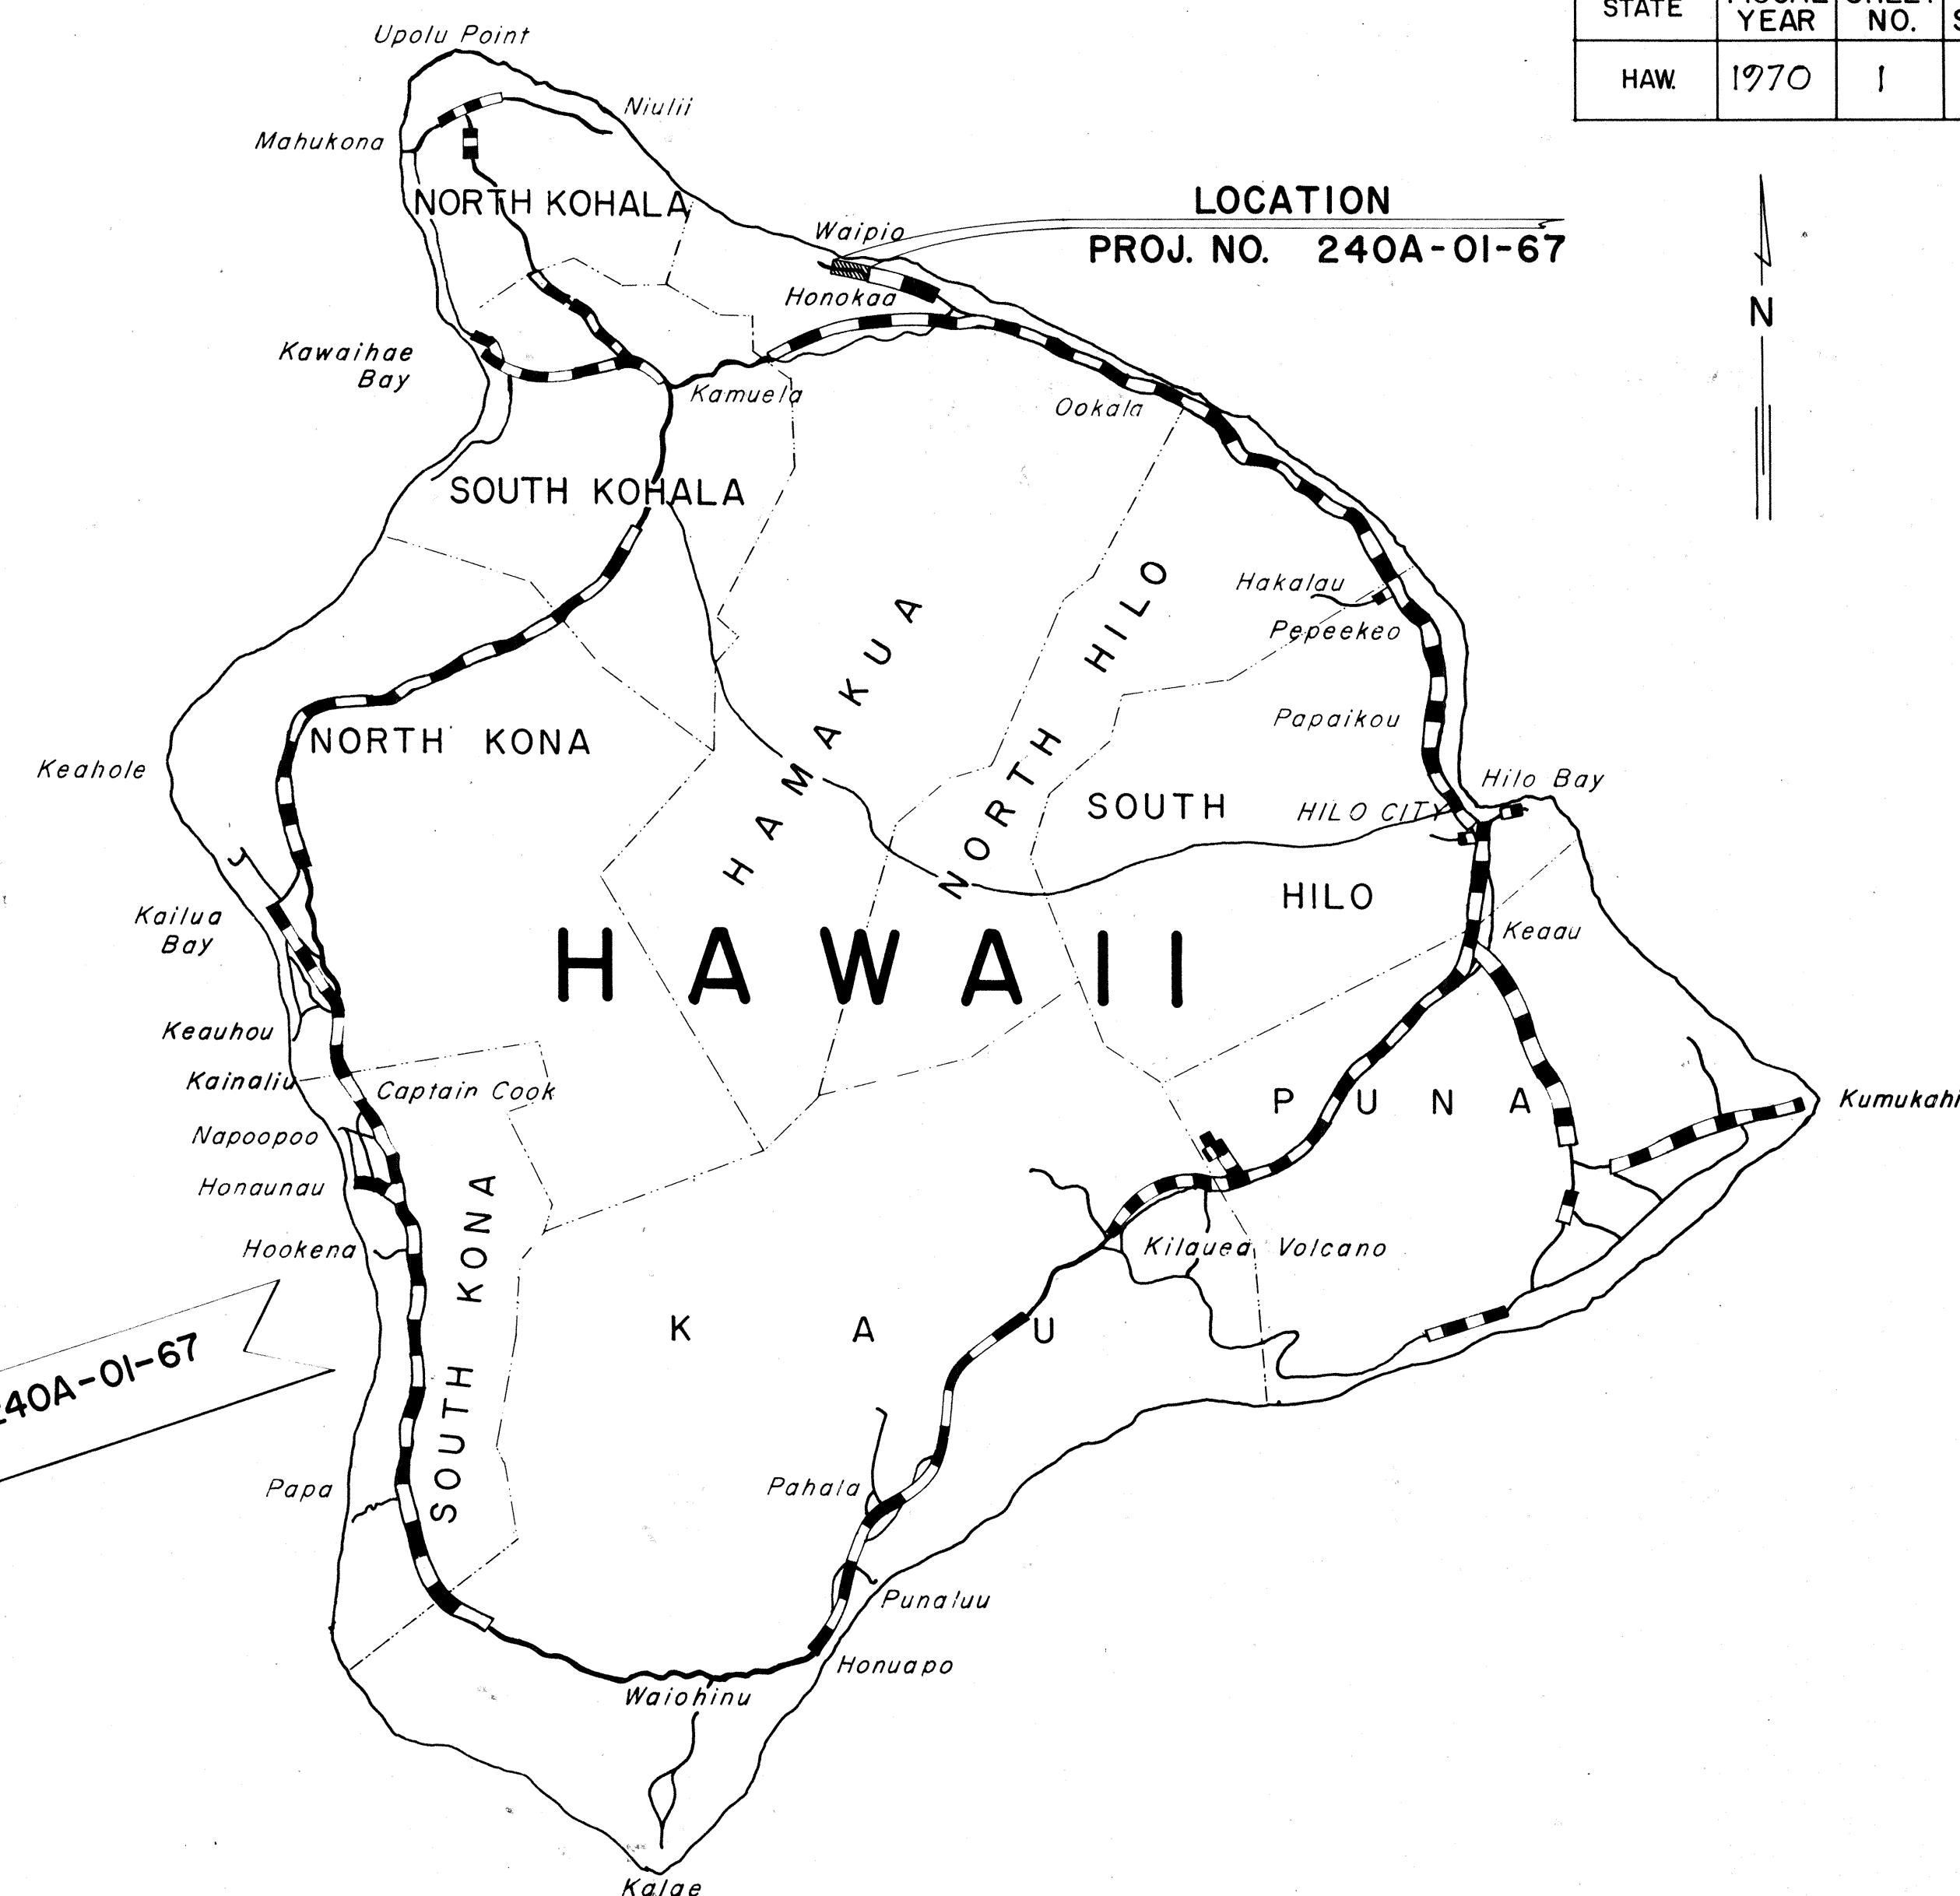

Federal Aid Projects Previously Constructed Or Under Construction

DESIGN CLASSIFICATION

ADT (1969)	860
Interim ADT (1979)	1190
Design ADT (1989)	1540
DHV	-
D	-
T	-
T24	7.5 %

NOTE:

ALL CHANGES MADE DURING CONSTRUCTION HAVE BEEN NOTED IN RED ON THESE TRACINGS AND CHECKED BY:

Carl Joborg
PROJECT ENGINEER
12/15/72
DATE

DEPARTMENT OF TRANSPORTATION STATE OF HAWAII	
APPROVED:	
<i>D. Wesley Wright</i>	5/20
DIR. OF TRANSPORTATION	DATE