



FED. ROAD DIST. NO.	STATE	FED. AID PROJ. NO.	FISCAL YEAR	SHEET NO.	TOTAL SHEETS
HAWAII	HAW.	240A-01-67	1970	39	69

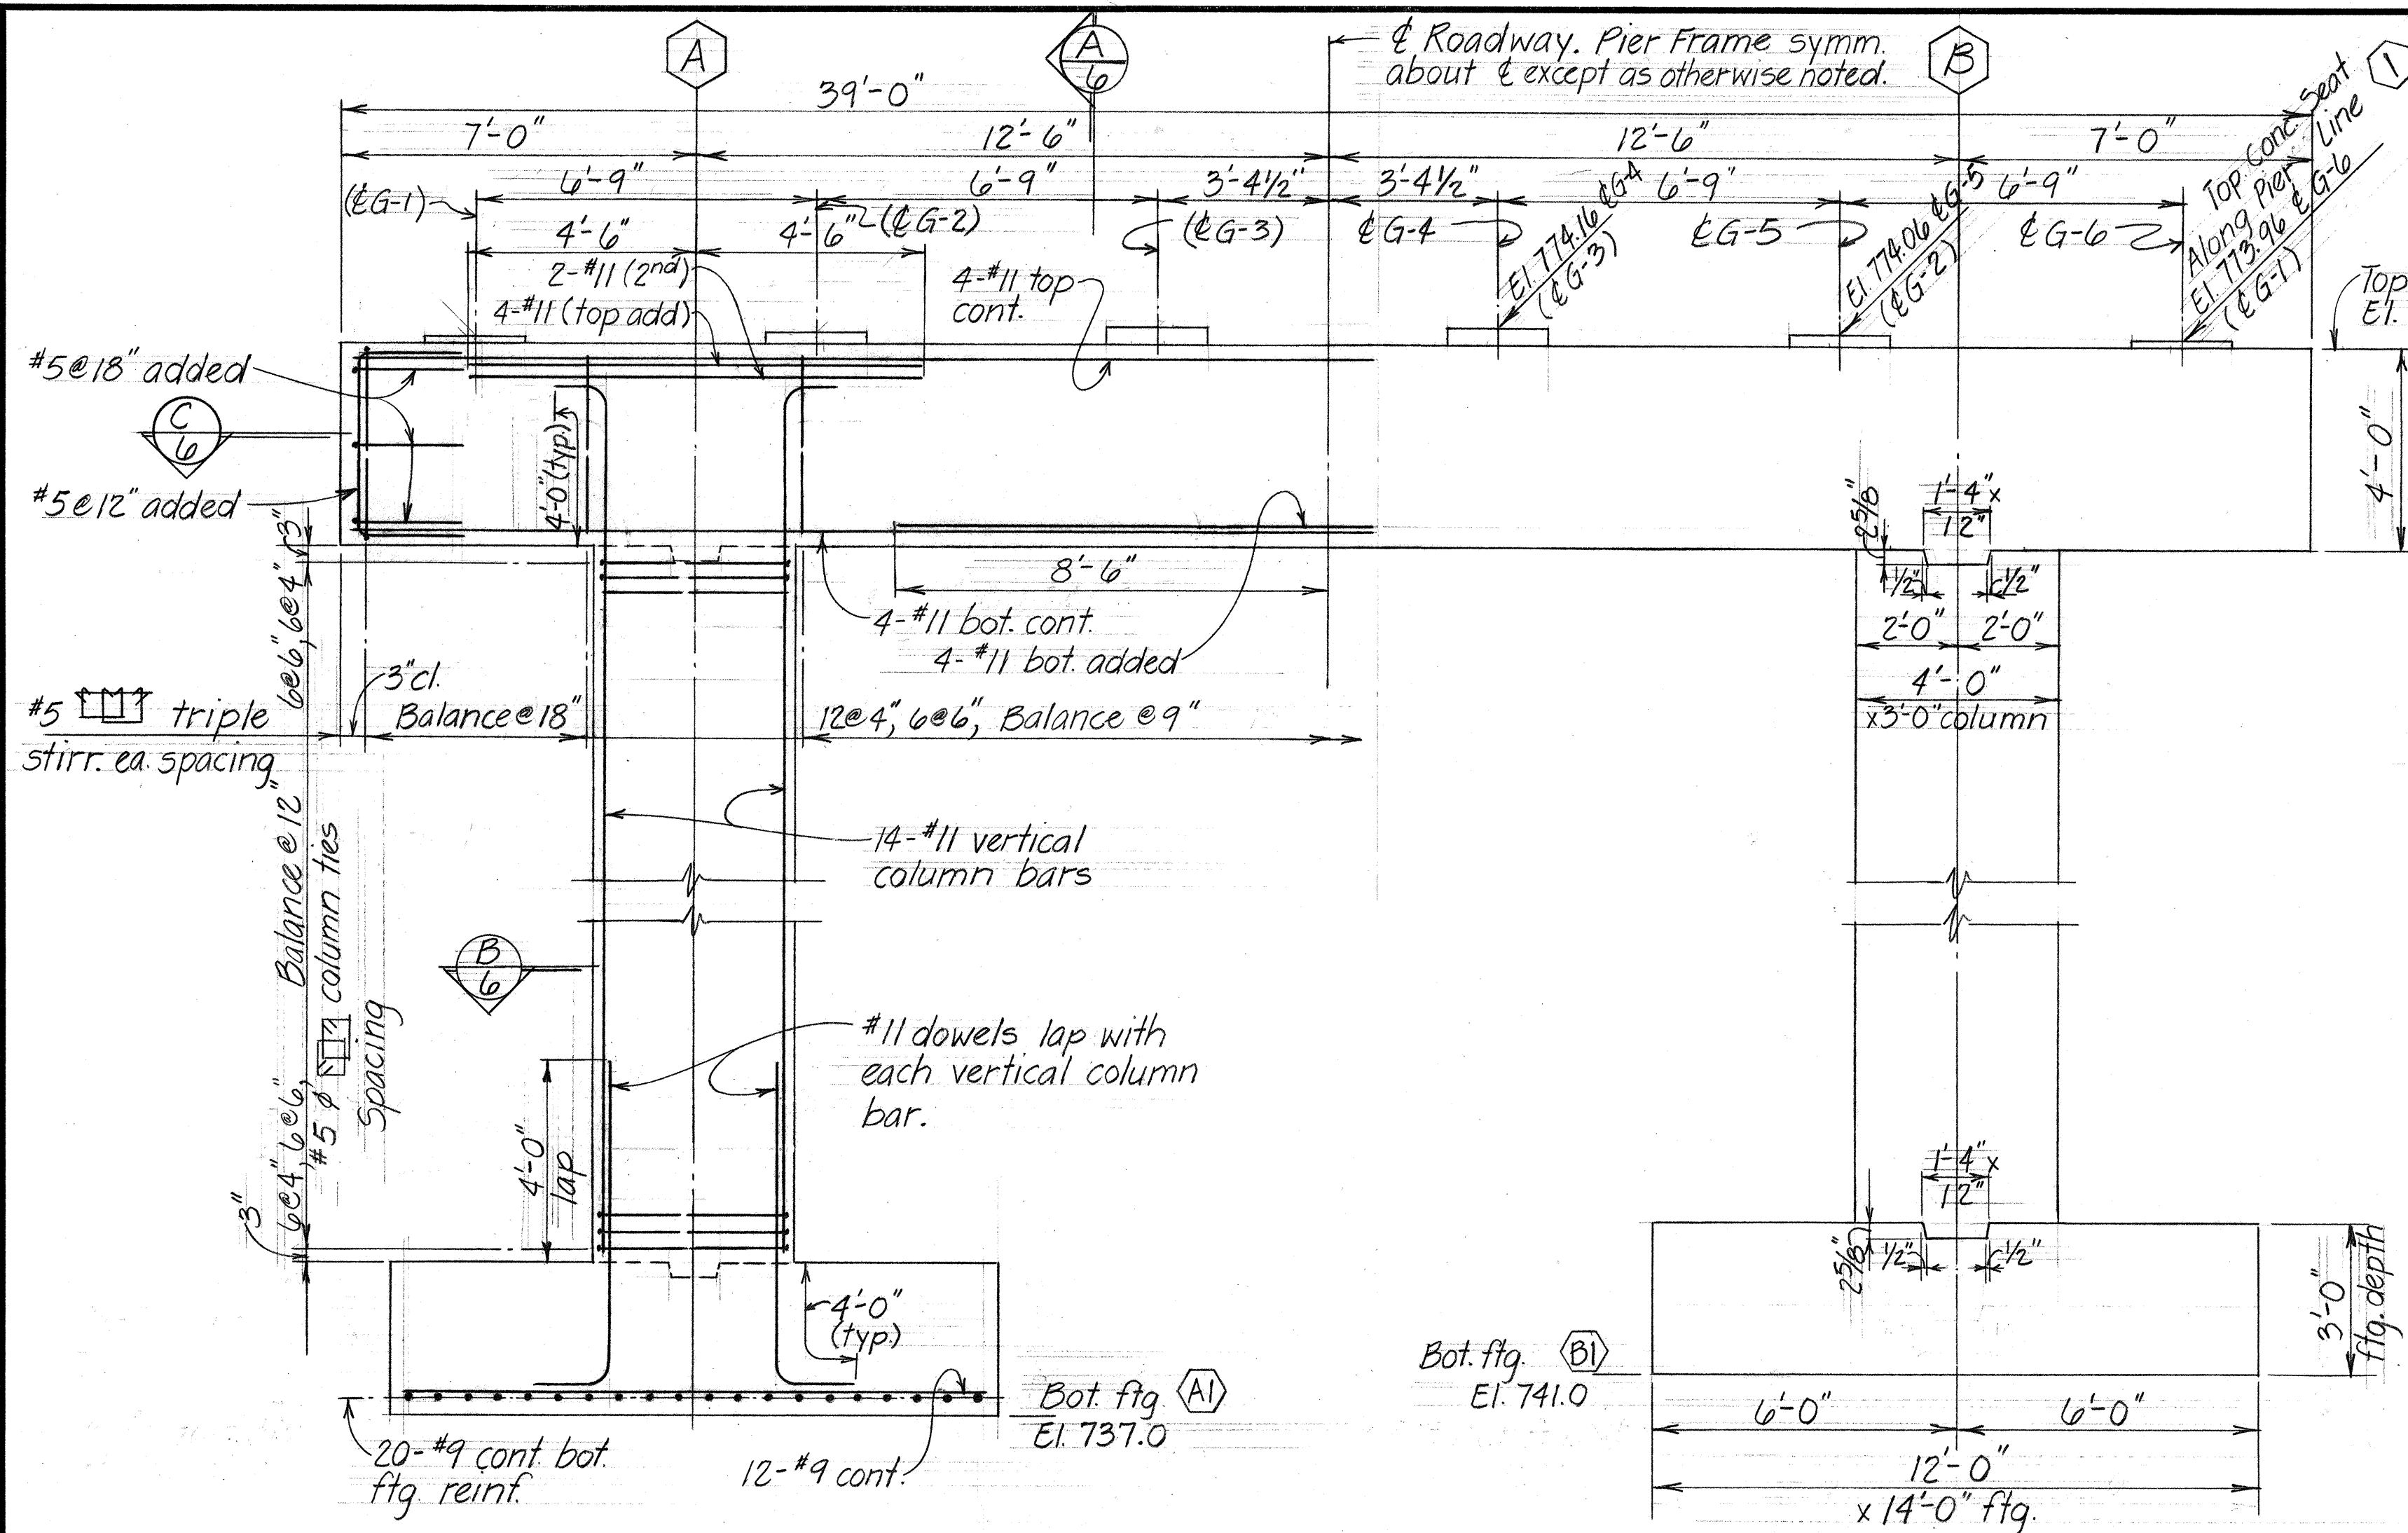


HALF PIER FRAME REINFORCEMENT


ELEVATION - PIER LINE ① FRAME Scale: 3/8"=1'-0"

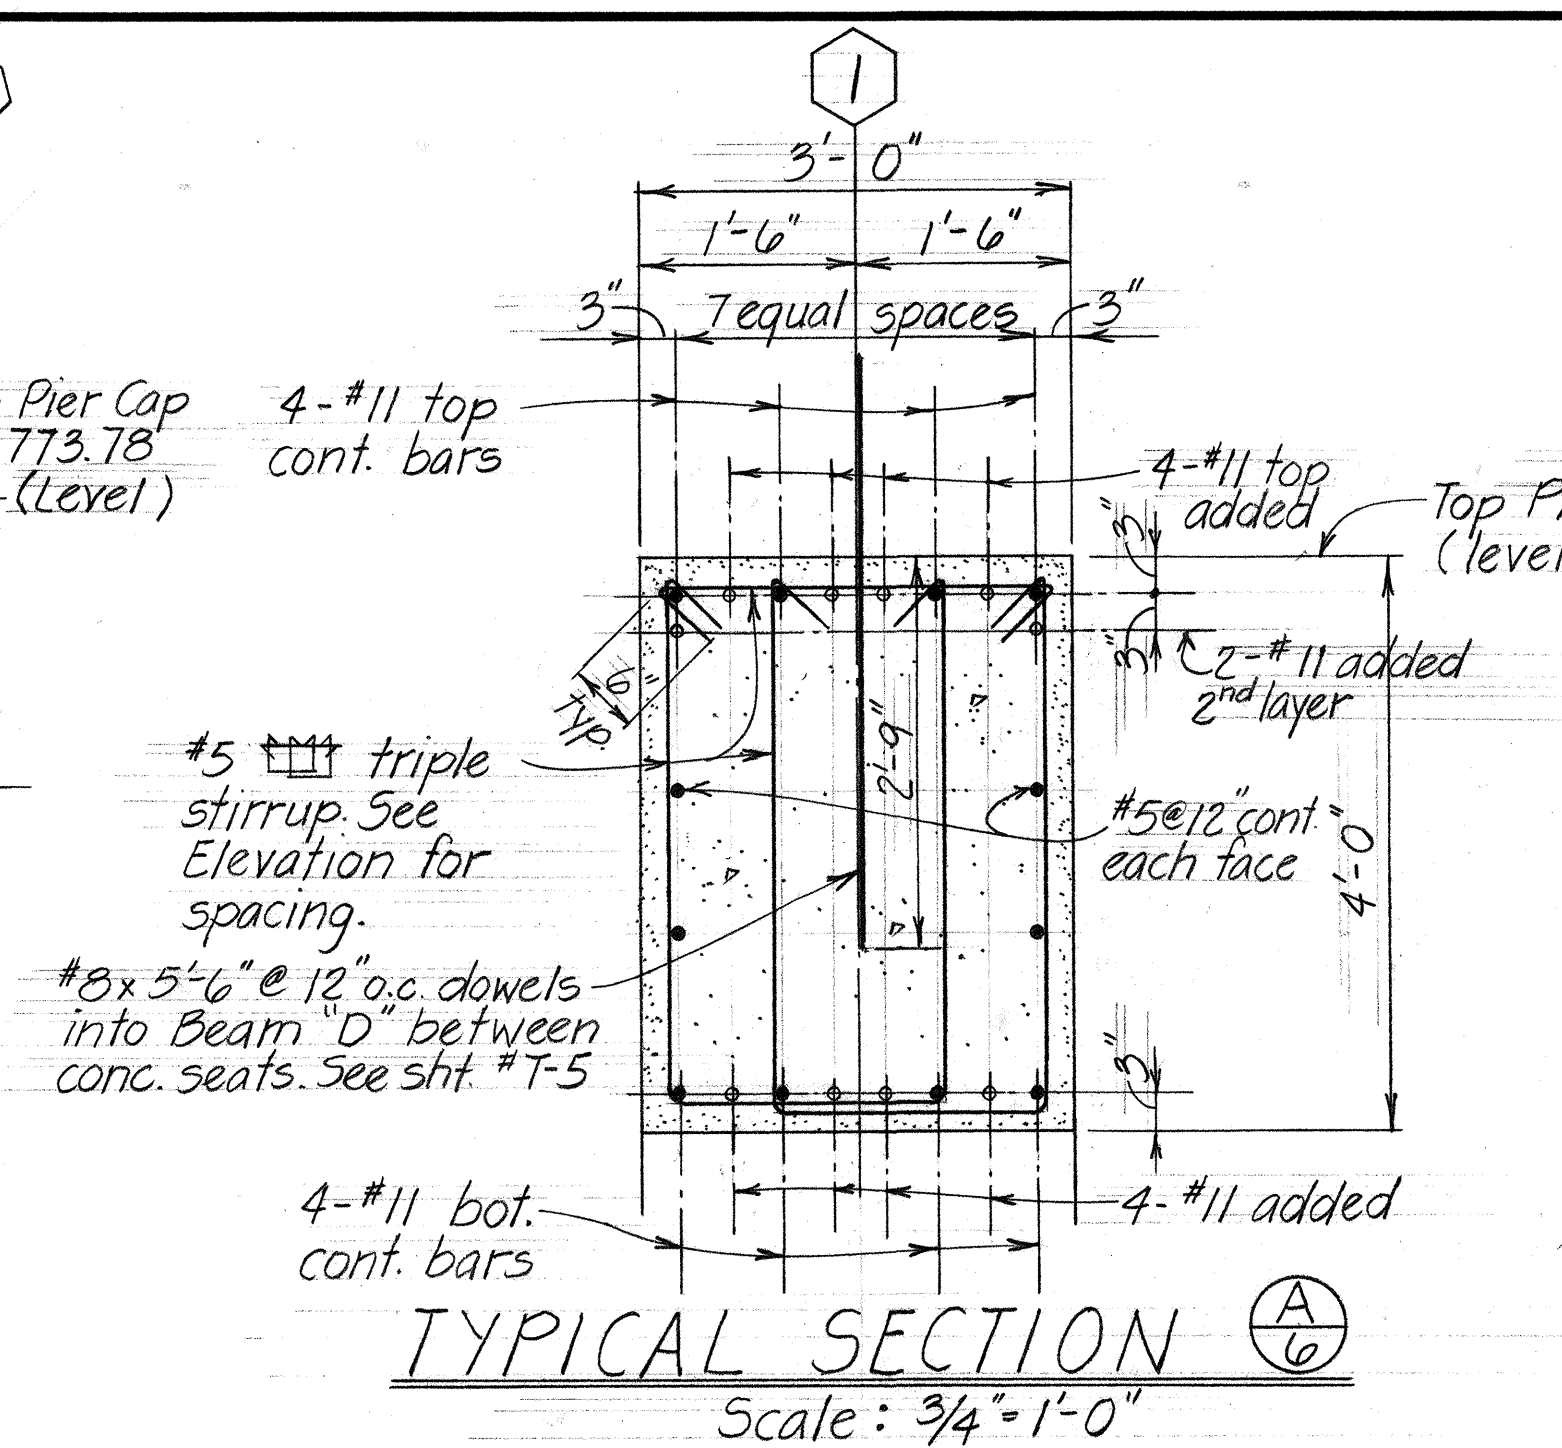

TYPICAL SECTION A-B Scale: 3/4"=1'-0"

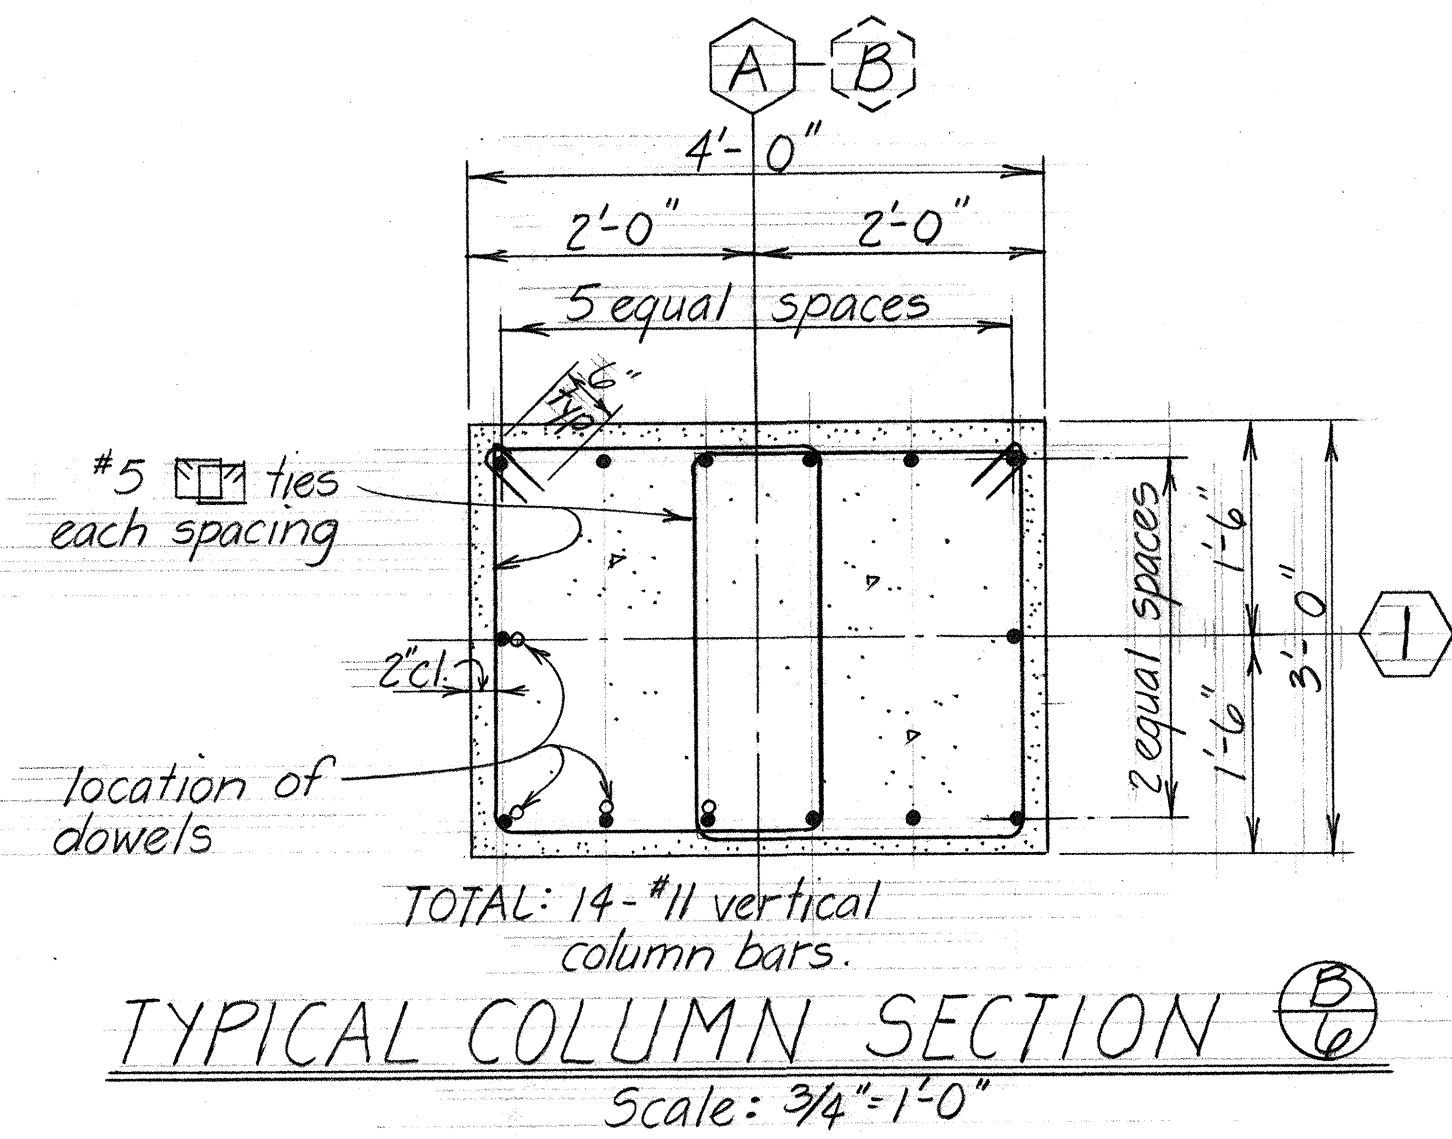


TYPICAL COLUMN SECTION B-C Scale: 3/4"=1'-0"

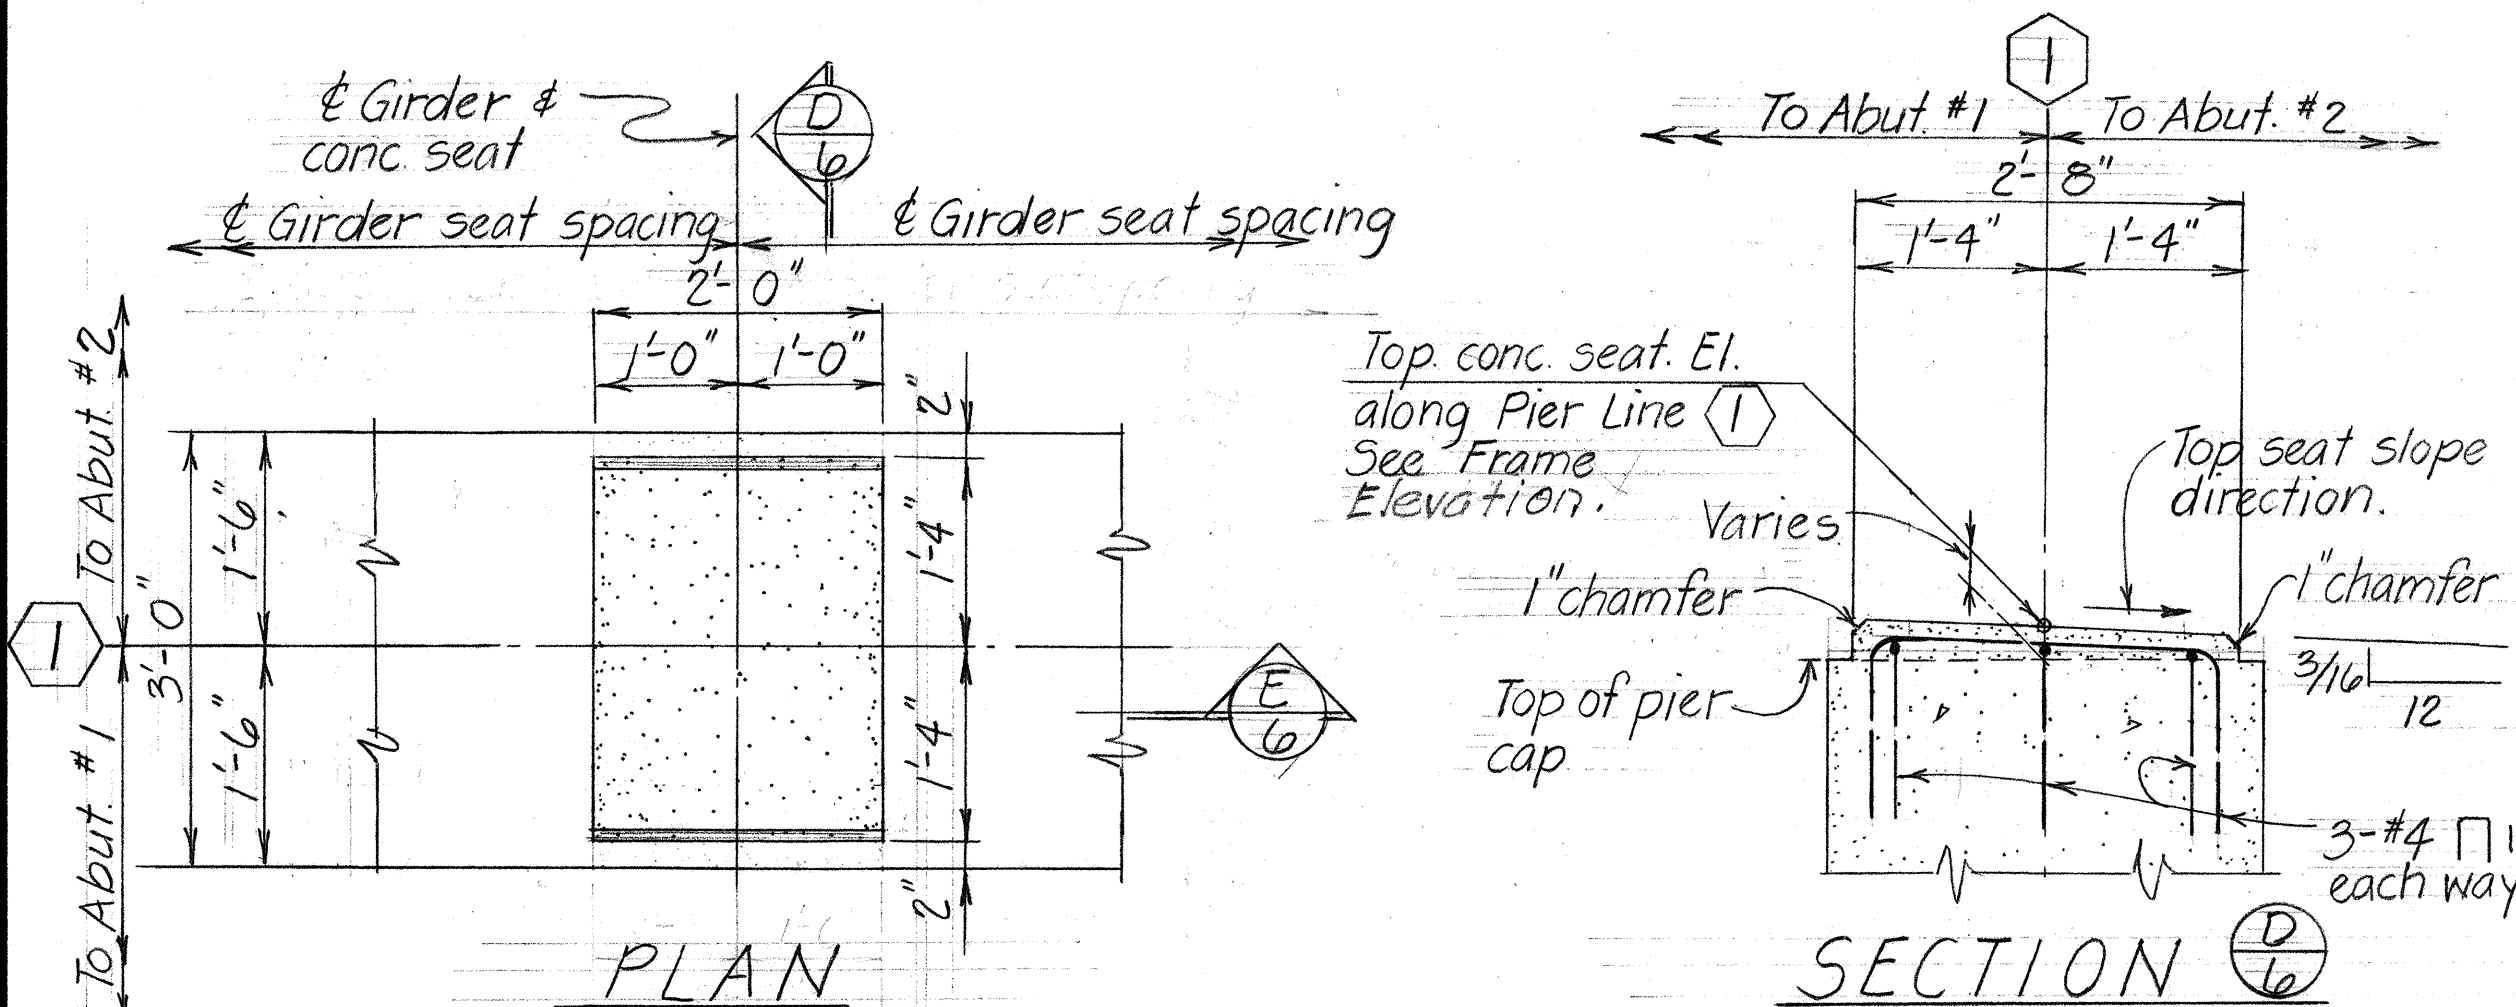

PLAN

SECTION D-E TYPICAL CONCRETE SEAT DETAILS Scale: 3/4"=1'-0"

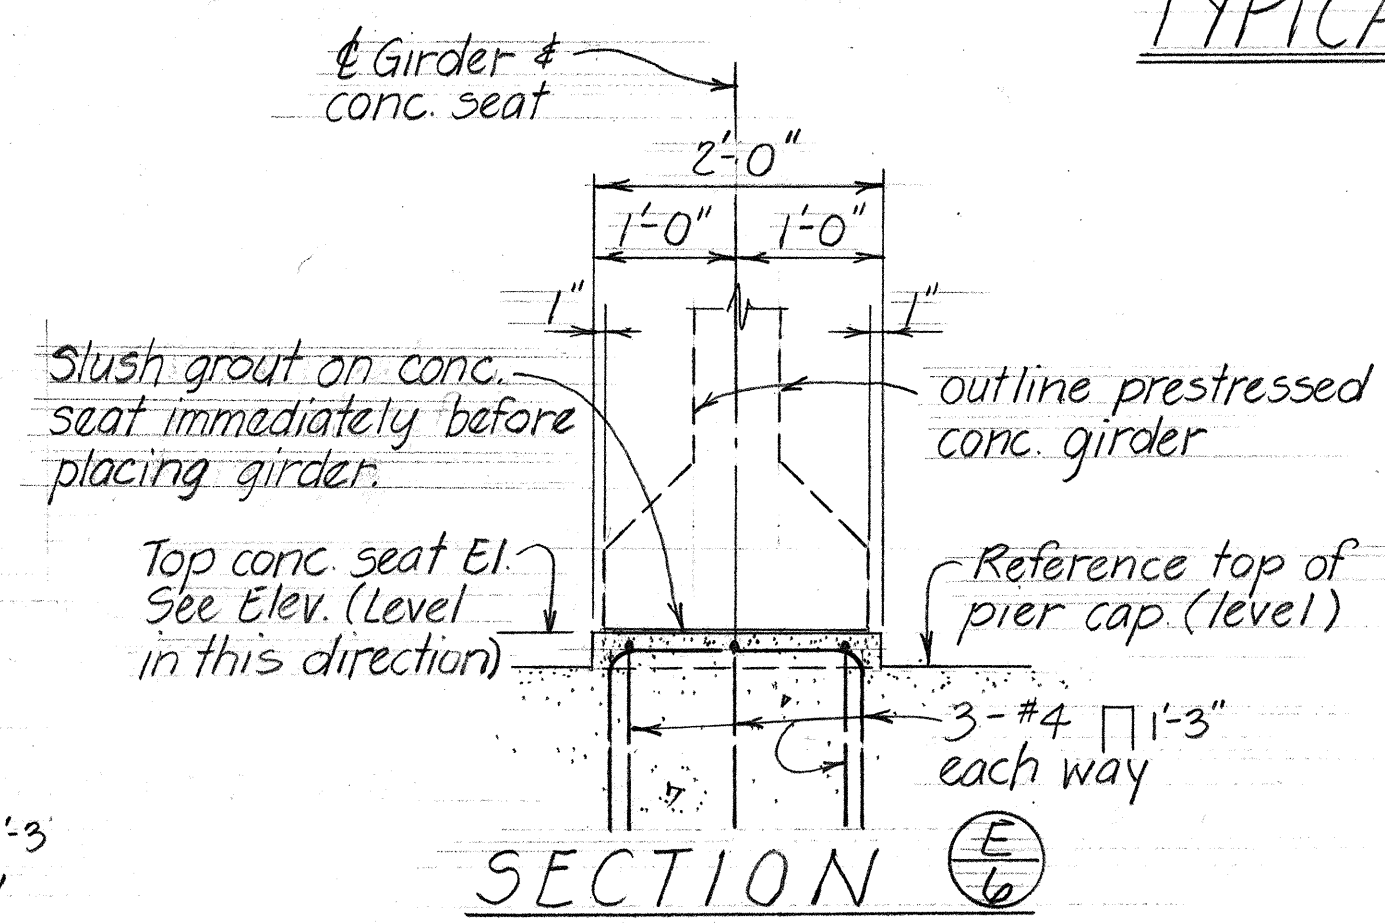

SECTION D-E

STATE OF HAWAII
DEPARTMENT OF TRANSPORTATION
HIGHWAYS DIVISION

WAIKALOA STREAM BRIDGE
PIER ① SECTIONS & DETAILS

Project No. 240A-01-67 April 1970
SHEET No. 6 OF 7 SHEETS

DATE	
DESIGNED BY	
DRAWN BY	
CHECKED BY	
APPROVED BY	
ORIGINAL PLAN	
NOTE BOOK	
No.	

