


STATE	FISCAL YEAR	SHEET NO.	TOTAL SHEETS
HAW.	1972	27	29

DATE	BY	DATE	BY
9/22/67	W. C. J.		
FINAL SURVEY	SURVEYED	NOTE BOOK	PLOTTED
NO. 326	AREAS CHECKED		


DATE	BY	DATE	BY
ORIGINAL SURVEY	SURVEYED	NOTE BOOK	PLOTTED
NO.	AREAS CHECKED		

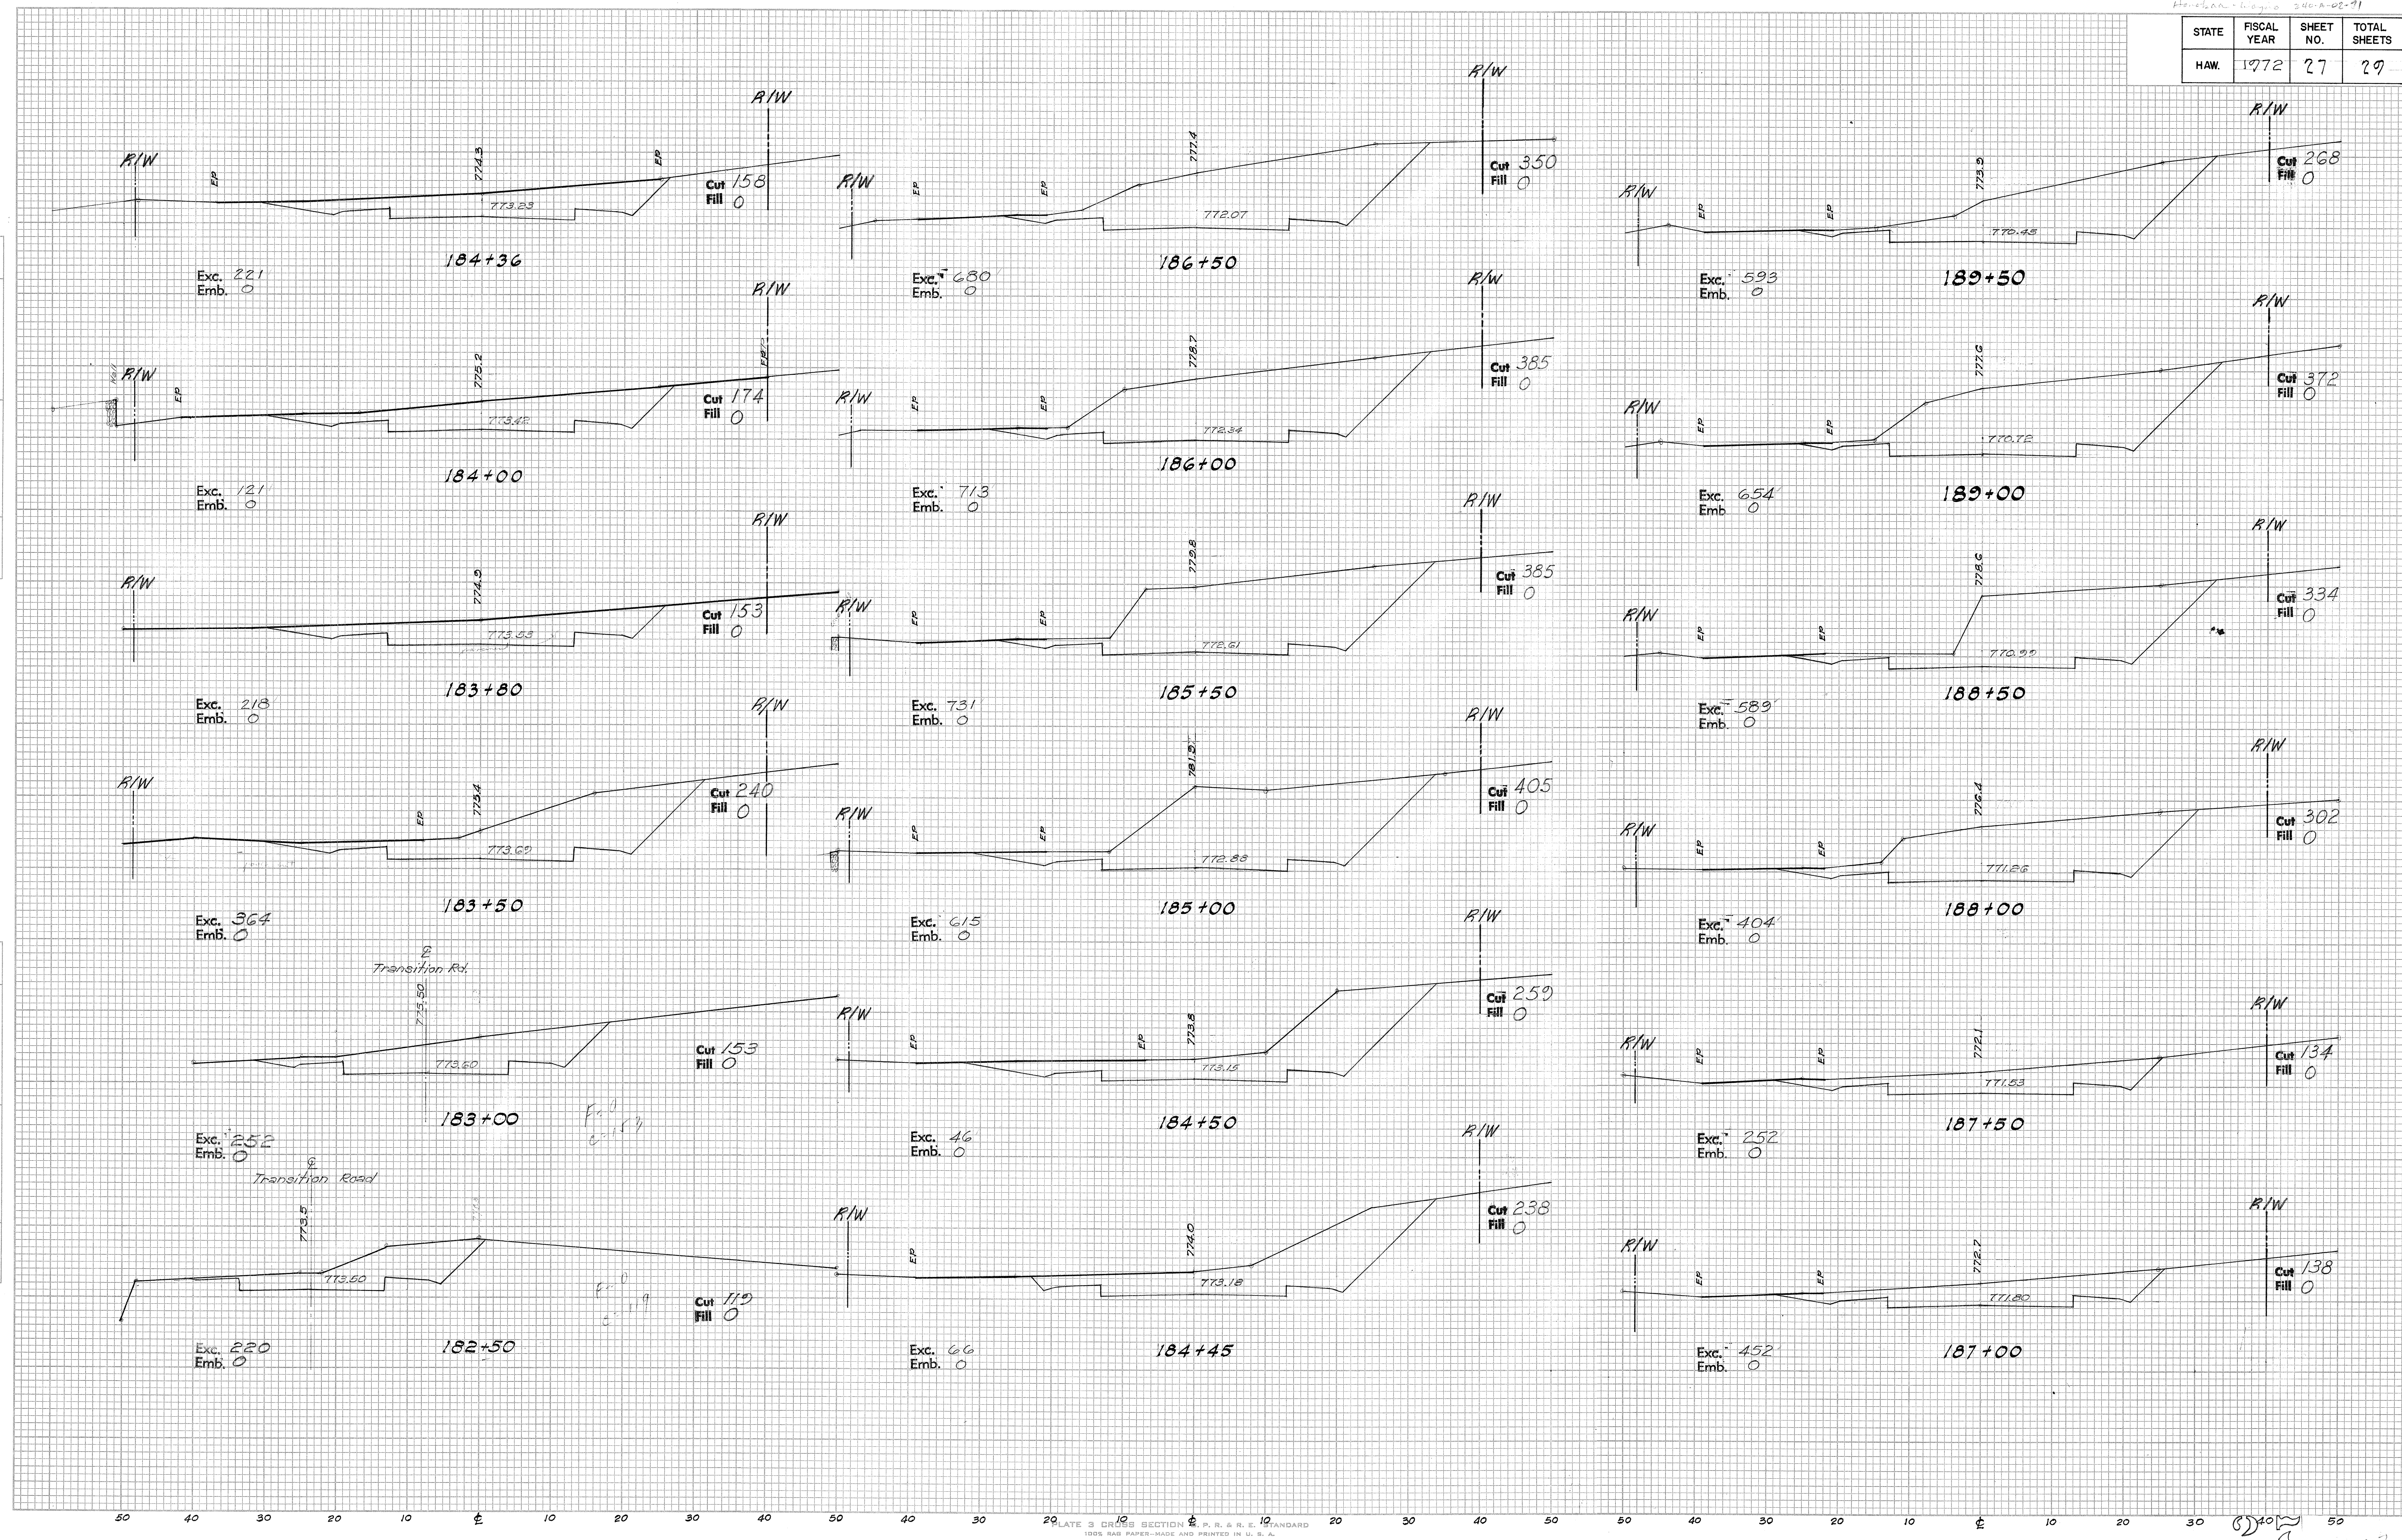

FINAL SURVEY
 DATE 9/22/67
 BY Cg
 SURVEYED
 PLOTTED
 NOTE BOOK
 DATE
 AREAS CHECKED
 NO. 506

ORIGINAL SURVEY
 DATE
 BY
 SURVEYED
 PLOTTED
 NOTE BOOK
 DATE
 AREAS CHECKED
 NO.

STATE	FISCAL YEAR	SHEET NO.	TOTAL SHEETS
HAW.	1972	28	29

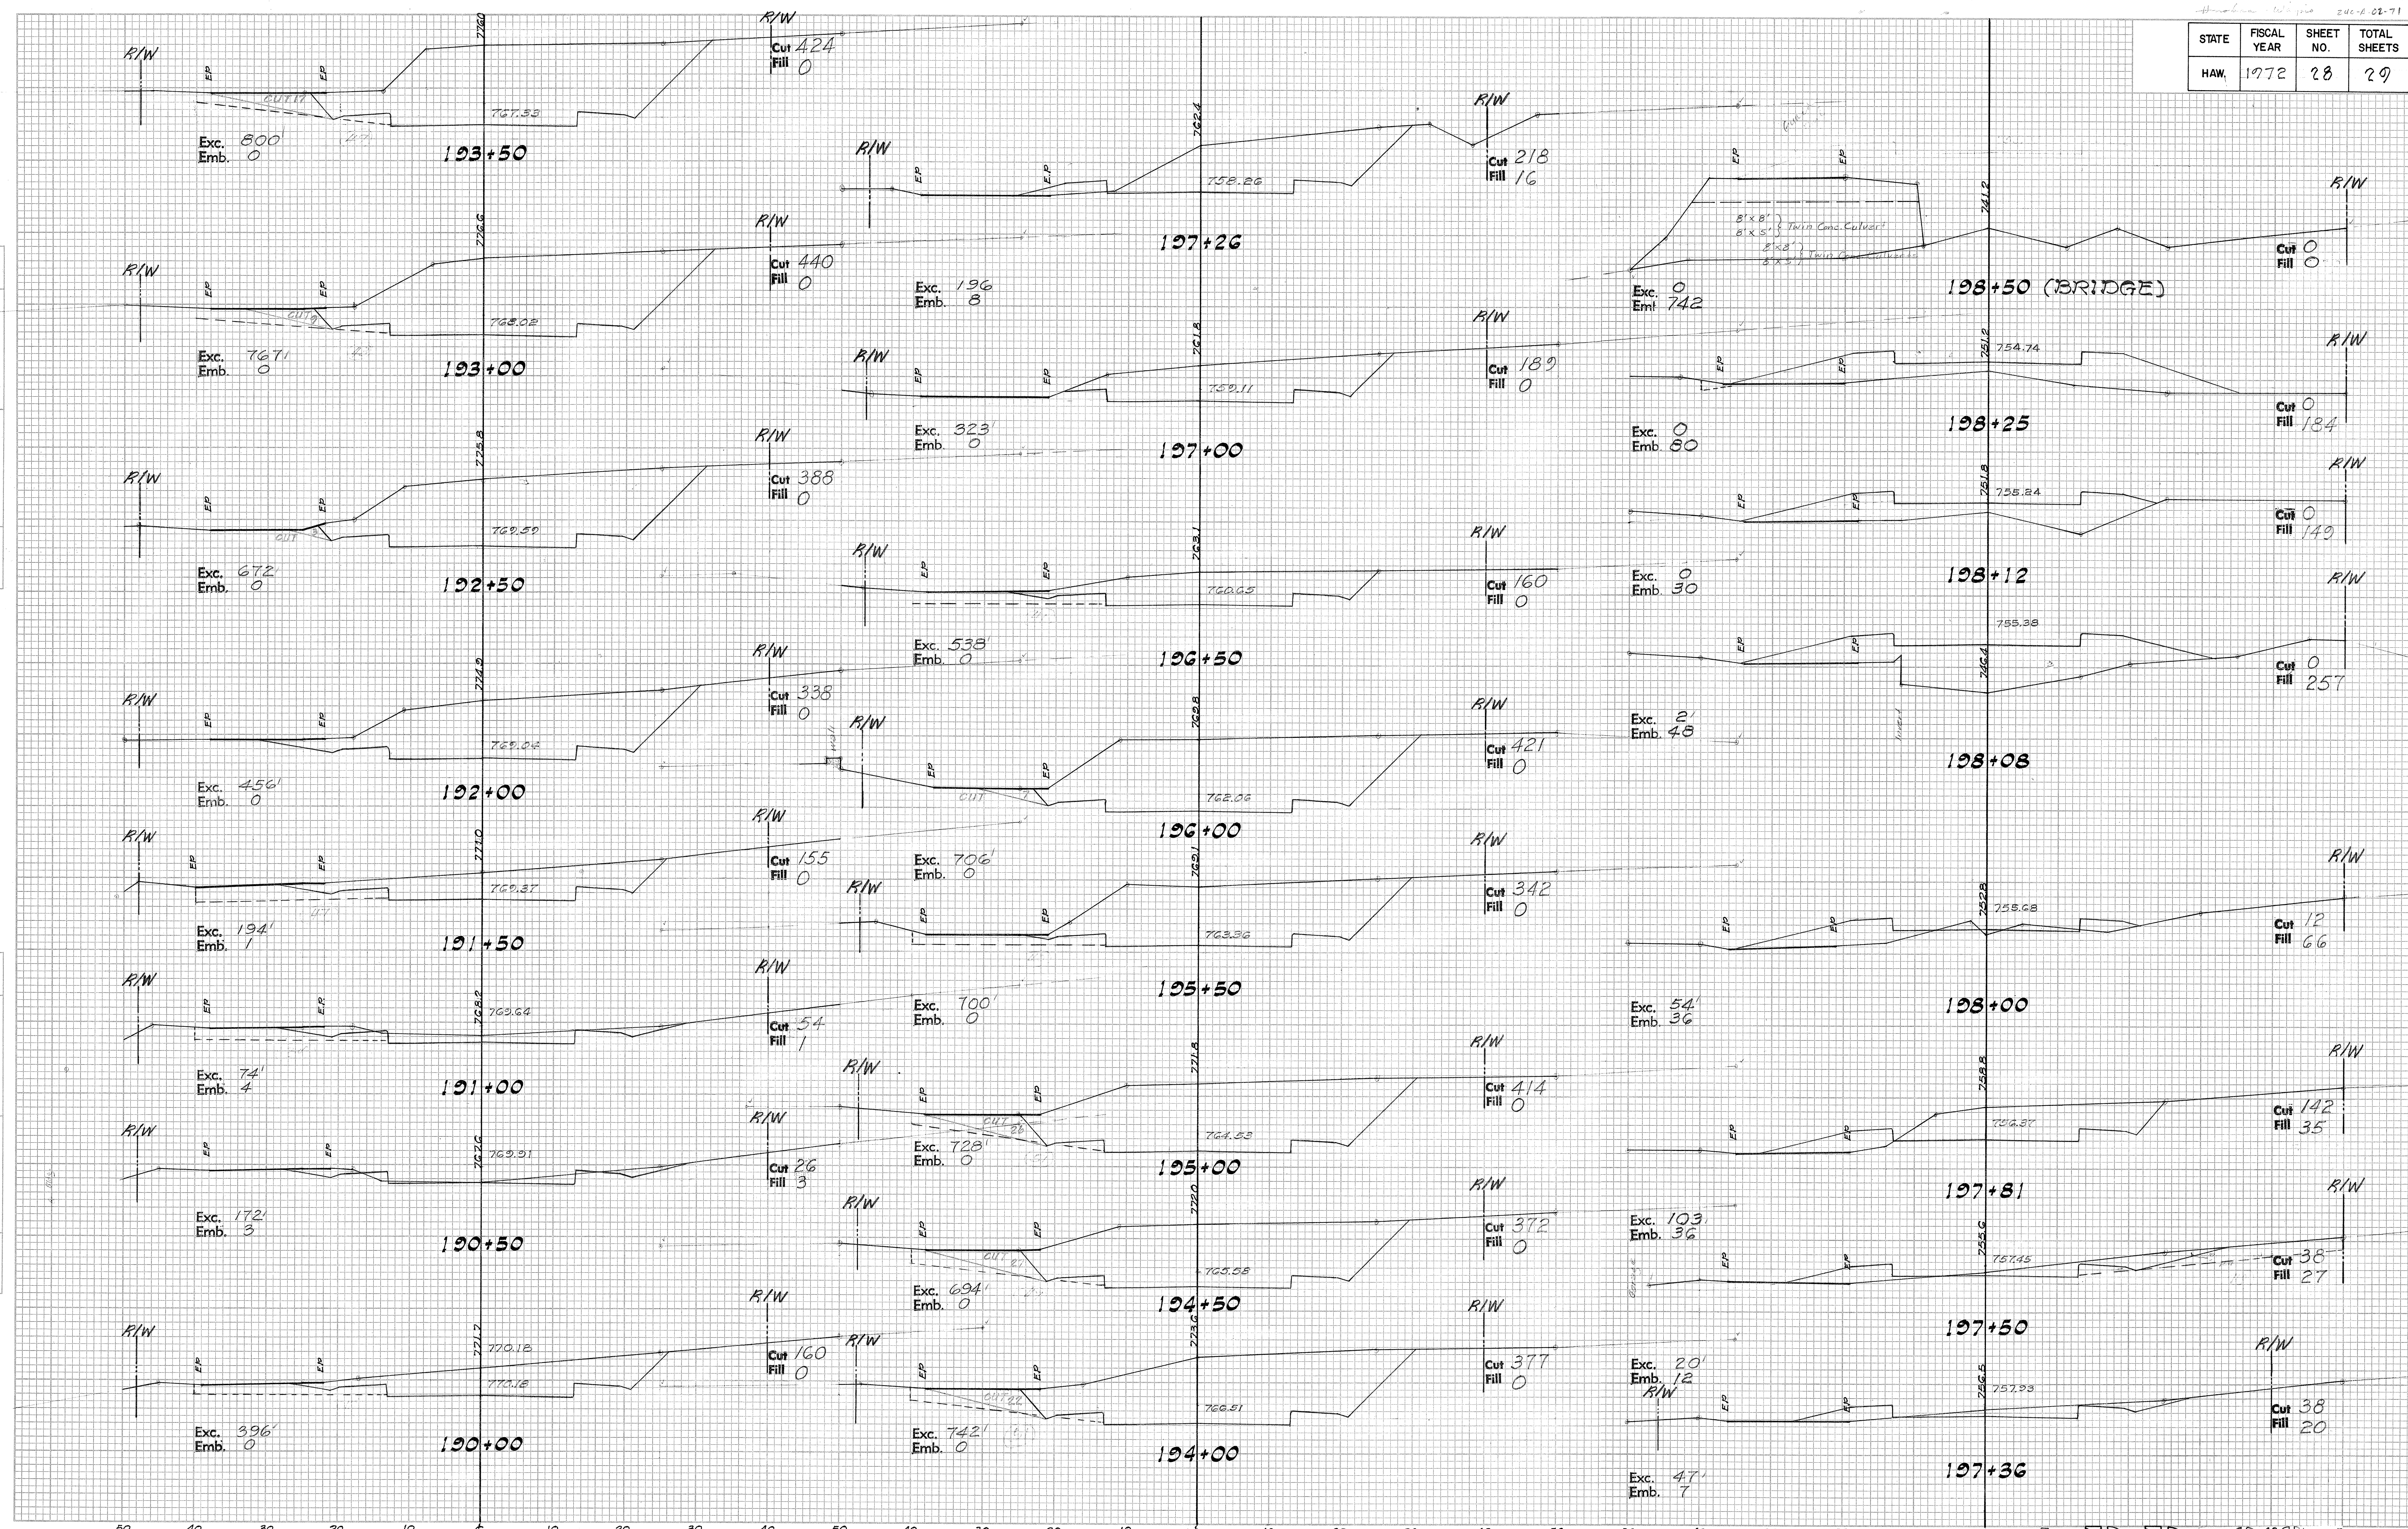

LATE 3 CRIBS SECTION
 100% RAD PAPER-MADE IN U.S.A.
 EUGENE DIETZEN CO.

Sept. 1, 1971
 A D D . 2 S

DATE 9/22/71
BY J. J. J.
FINAL SURVEY PLOTTED
NOTE BOOK TEMPLATE
NO. 202

DATE
BY
ORIGINAL SURVEY PLOTTED
NOTE BOOK TEMPLATE
NO. 202

STATE	FISCAL YEAR	SHEET NO.	TOTAL SHEETS
HAW.	1972	29	29

