


FED. ROAD DIST. NO.	STATE	PROJ. NO.	FISCAL YEAR	SHEET NO.	TOTAL SHEETS
HAWAII	HAW.	240A-02-71	1972	4	29

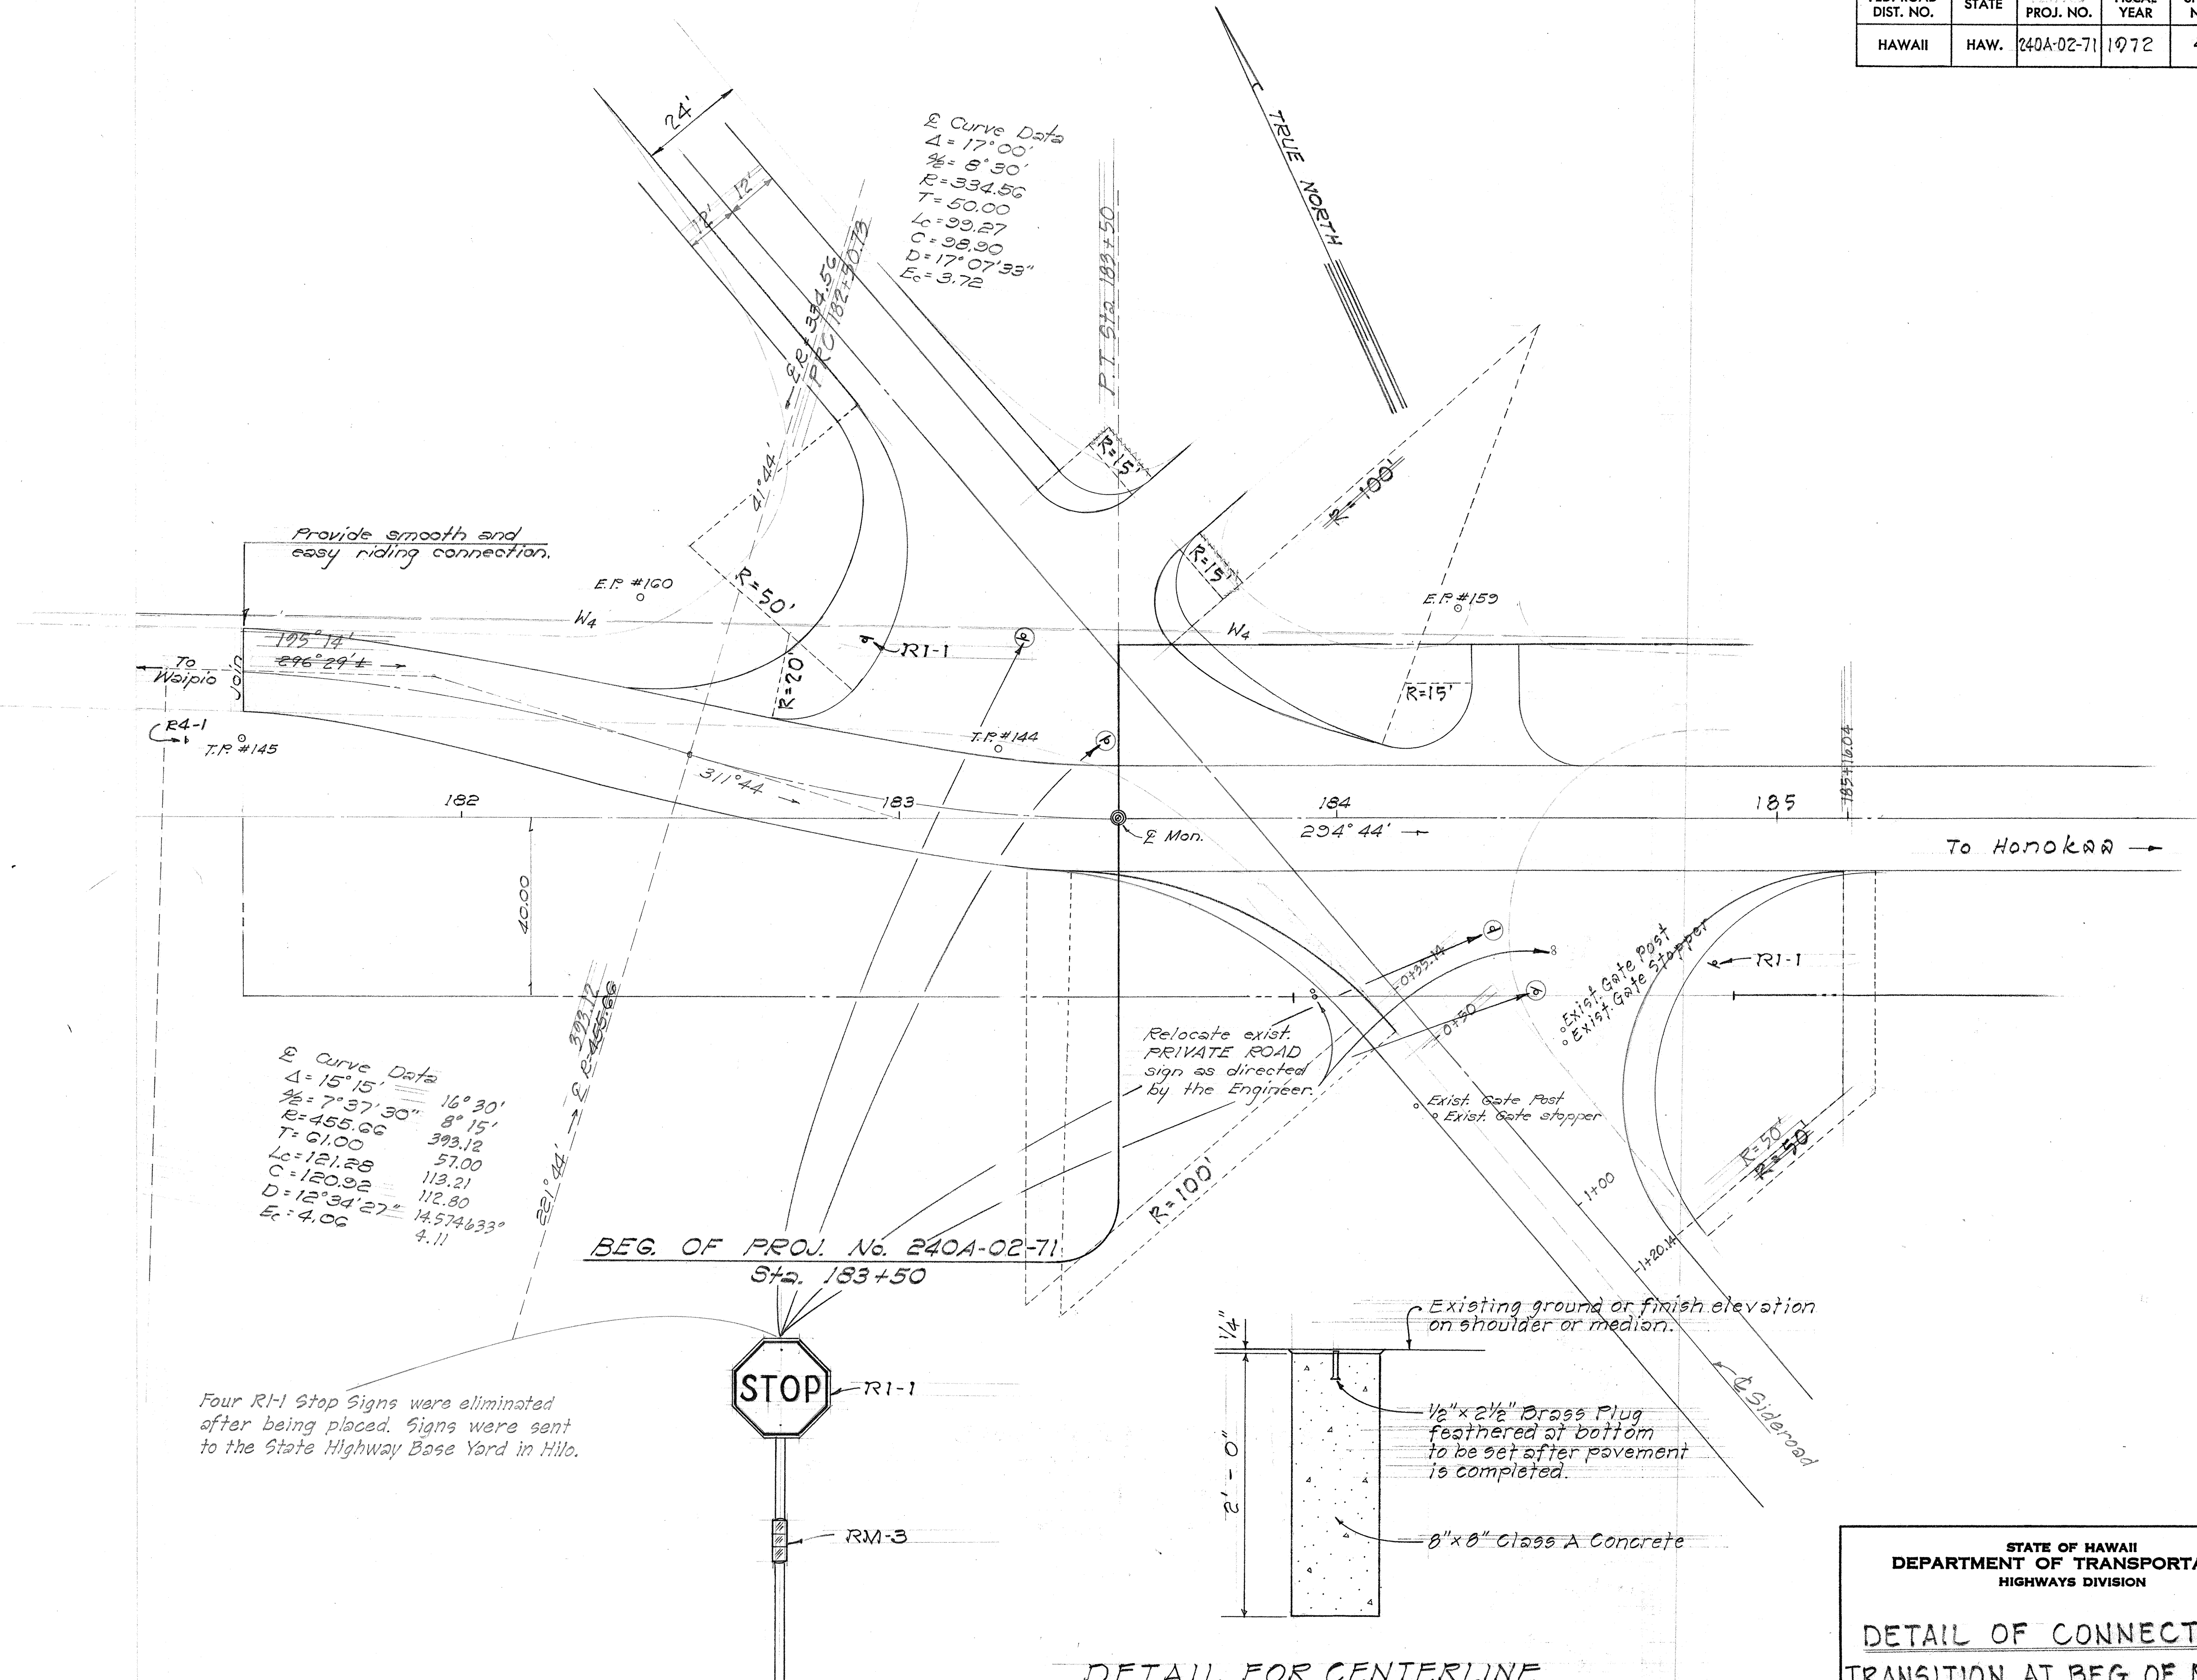

STATE OF HAWAII
DEPARTMENT OF TRANSPORTATION
HIGHWAYS DIVISION

DETAIL OF CONNECTION
TRANSITION AT BEG. OF PROJECT
Proj. No. 240A-02-71
scale: 1" = 20'
SHEET No. 1 OF 1 SHEETS

SURVEYED BY	DATE
DRAWN BY	
DESIGNED BY	
QUANTITIES BY	
CHECKED BY	
ORIGINAL PLAN	
NOTE BOOK	
No.	