



FED. ROAD DIST. NO.	STATE	PROJ. NO.	FISCAL YEAR	SHEET NO.	TOTAL SHEETS
HAWAII	HAW.	240A-02-71	1972	16	29

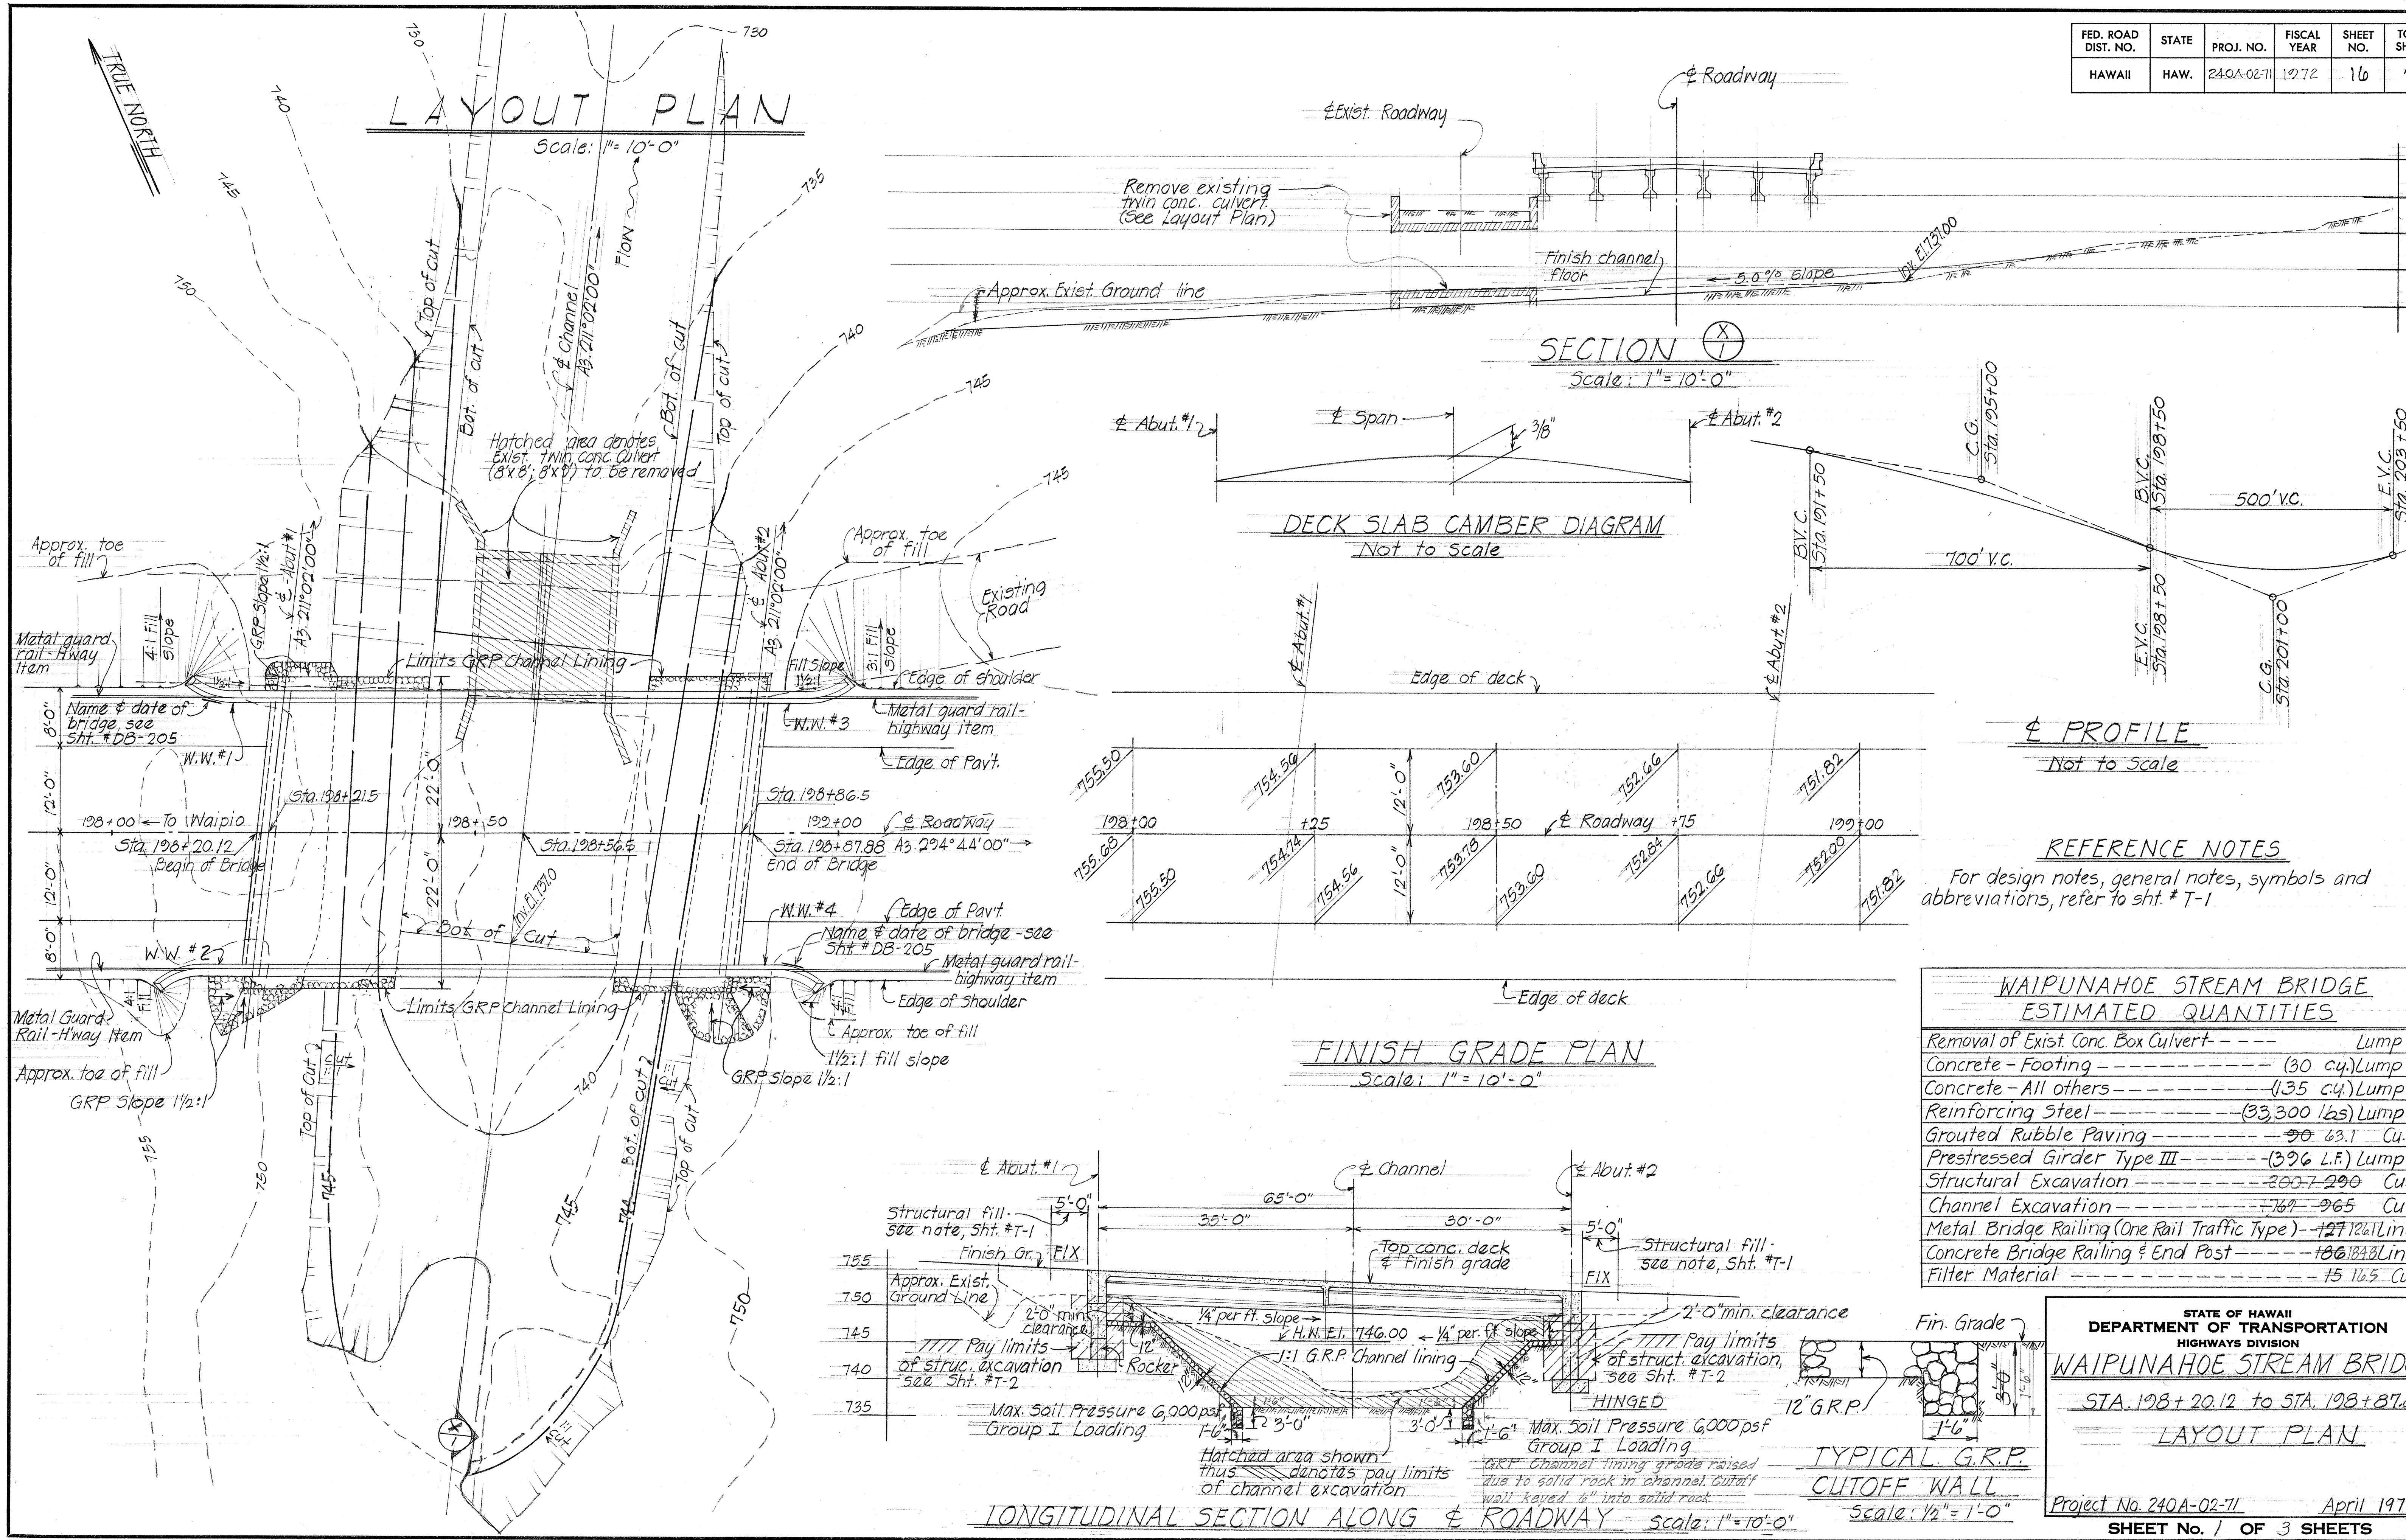


DATE	DESIGNED BY	CHECKED BY
PLAN	NOTED BY	QUANTITIES BY
NOTE BOOK	DESIGNED BY	CHECKED BY
NO.	DESIGNED BY	CHECKED BY


FED. ROAD DIST. NO.	STATE	PROJ. NO.	FISCAL YEAR	SHEET NO.	TOTAL SHEETS
HAWAII	HAW.	240A-02-71	1972	17	27

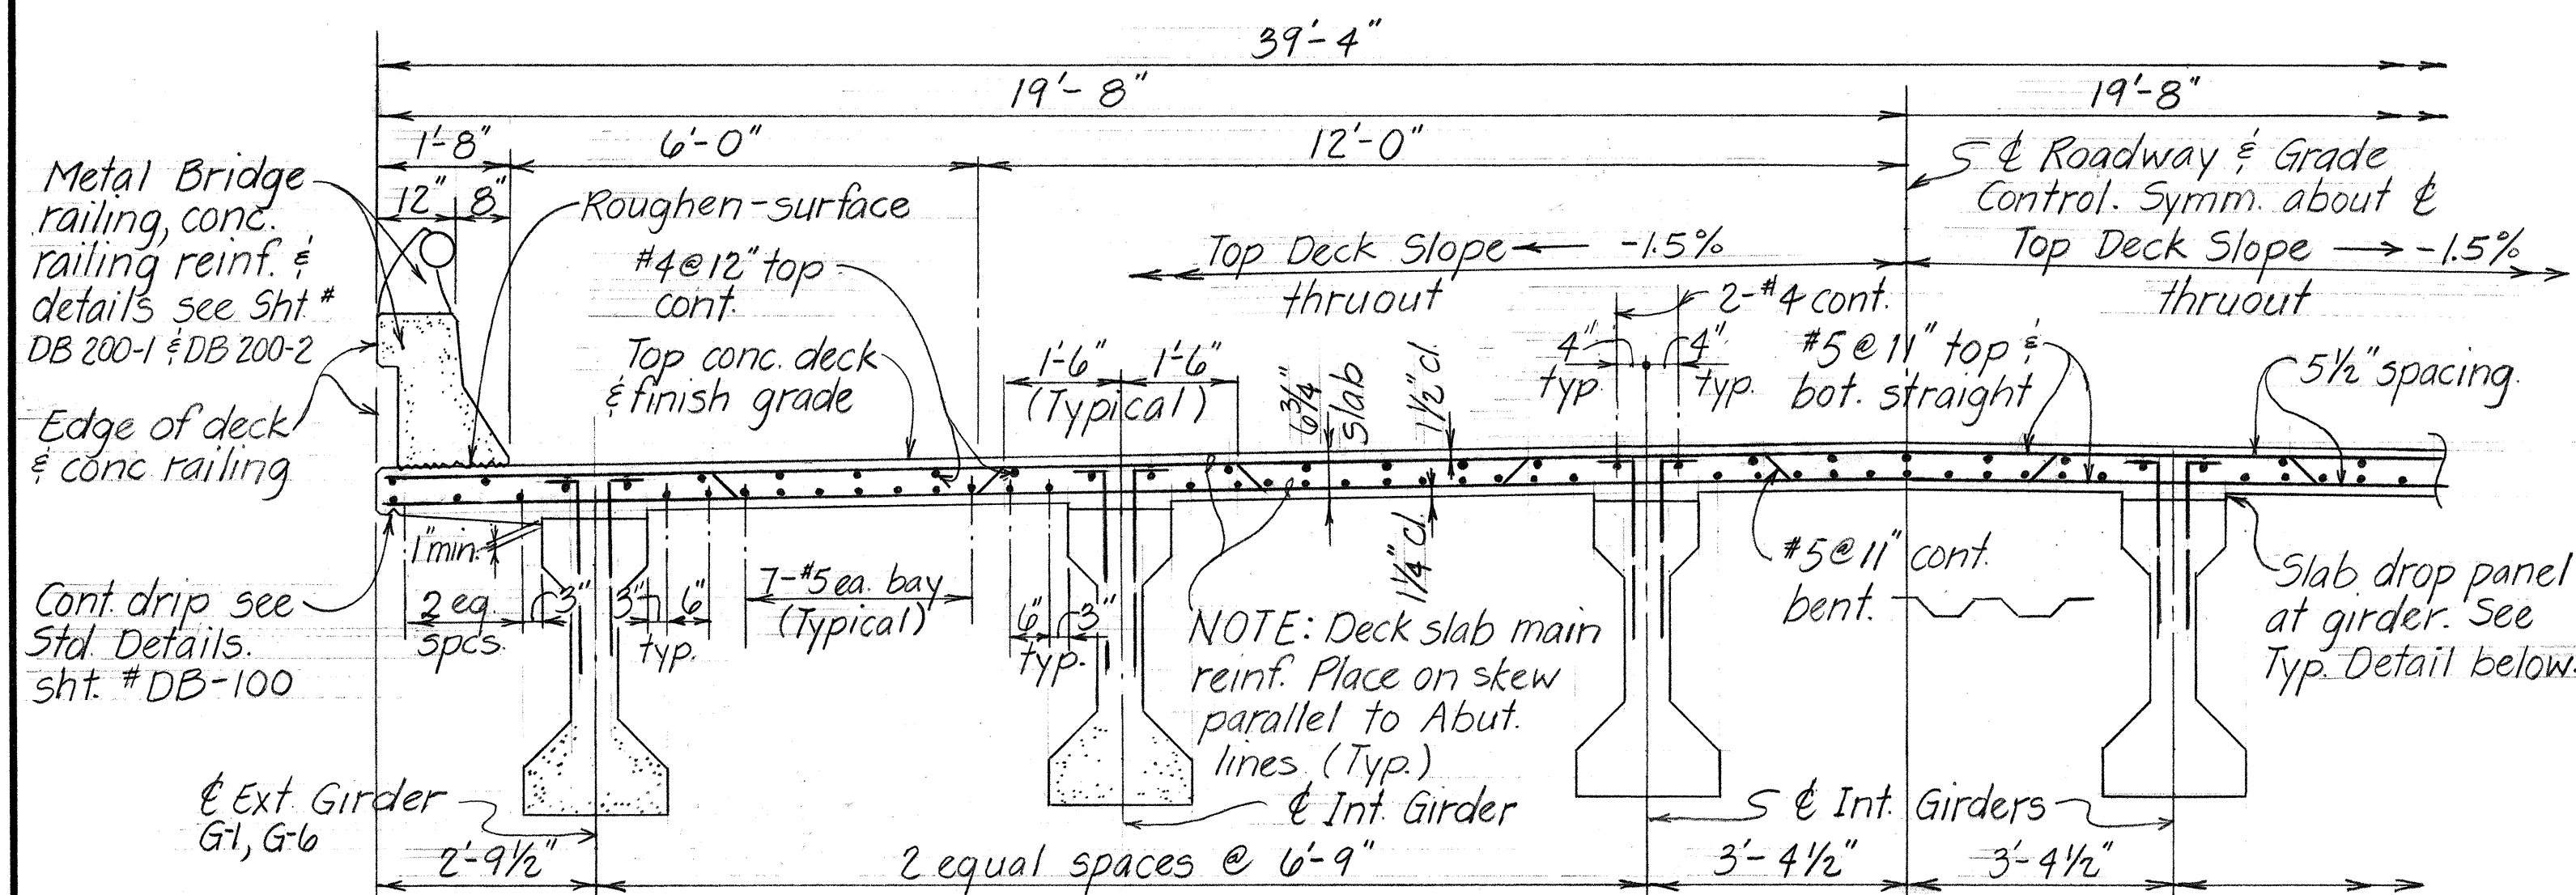


NORMAL DECK SECTION Scale: 1/2" = 1'-0"

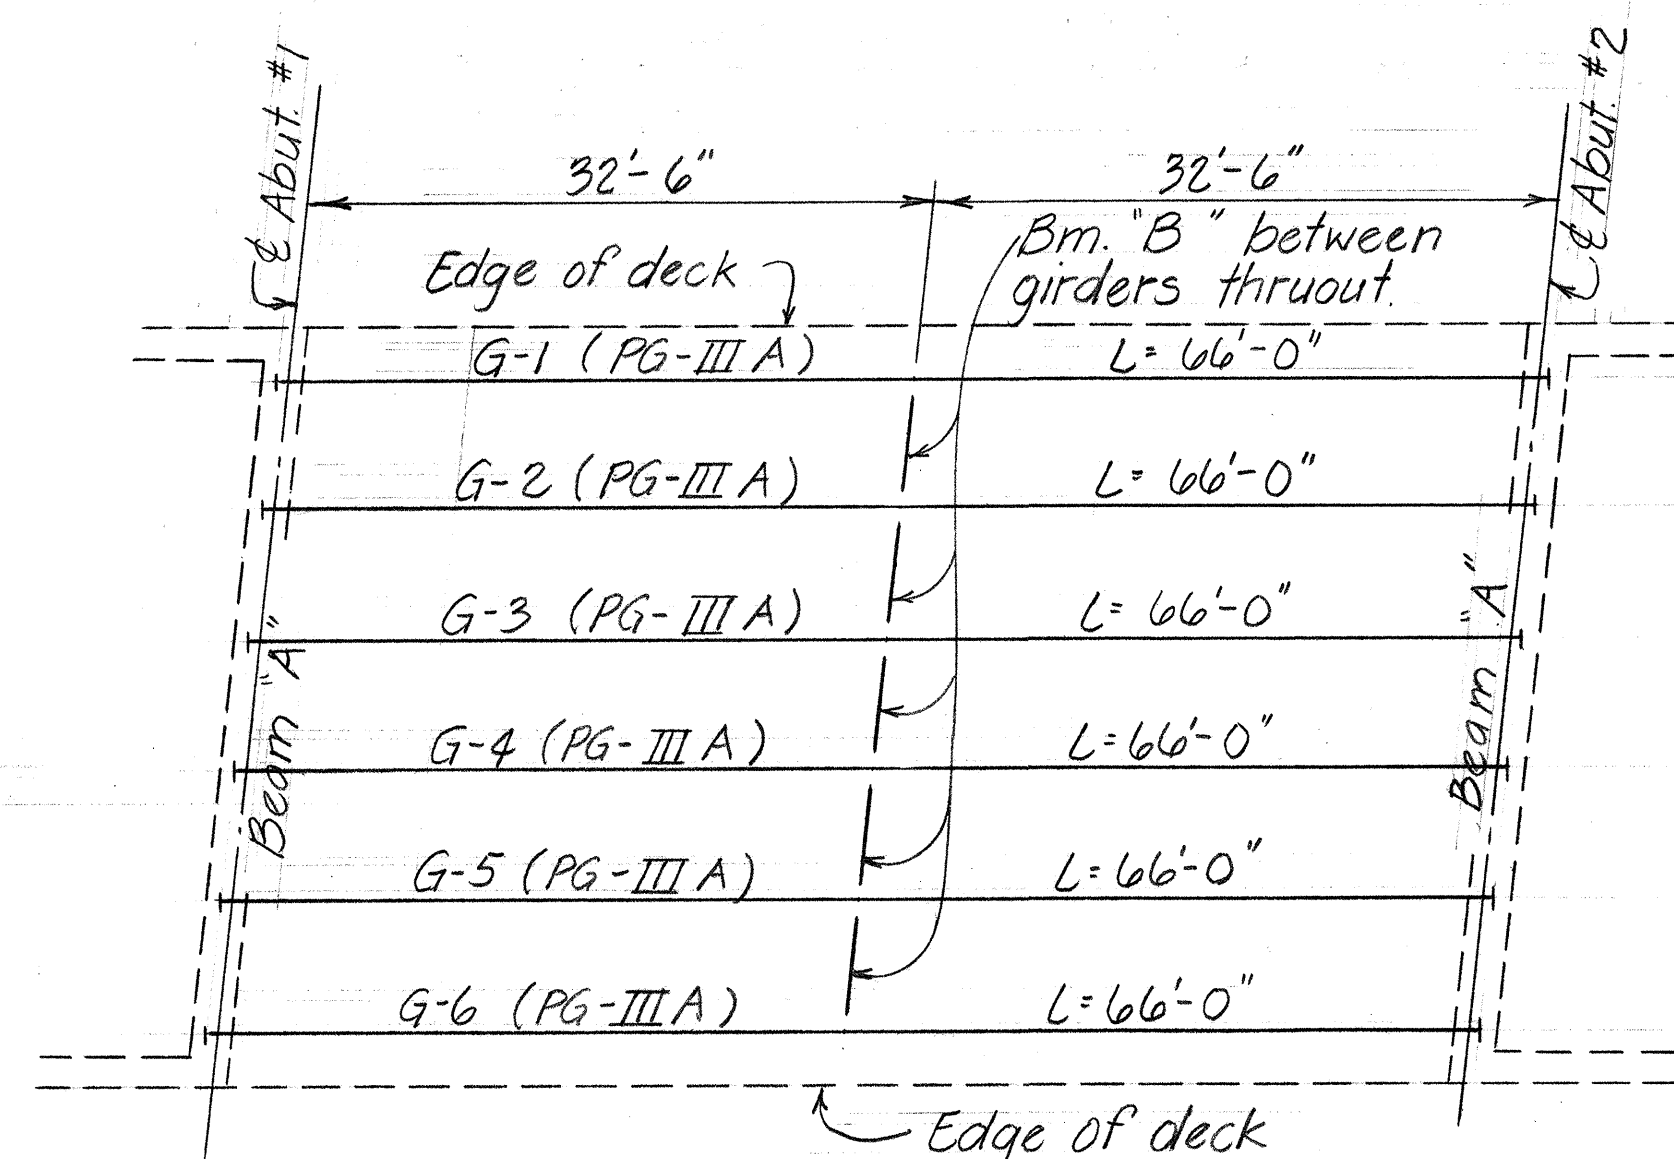


DECK FRAMING PLAN Not to Scale

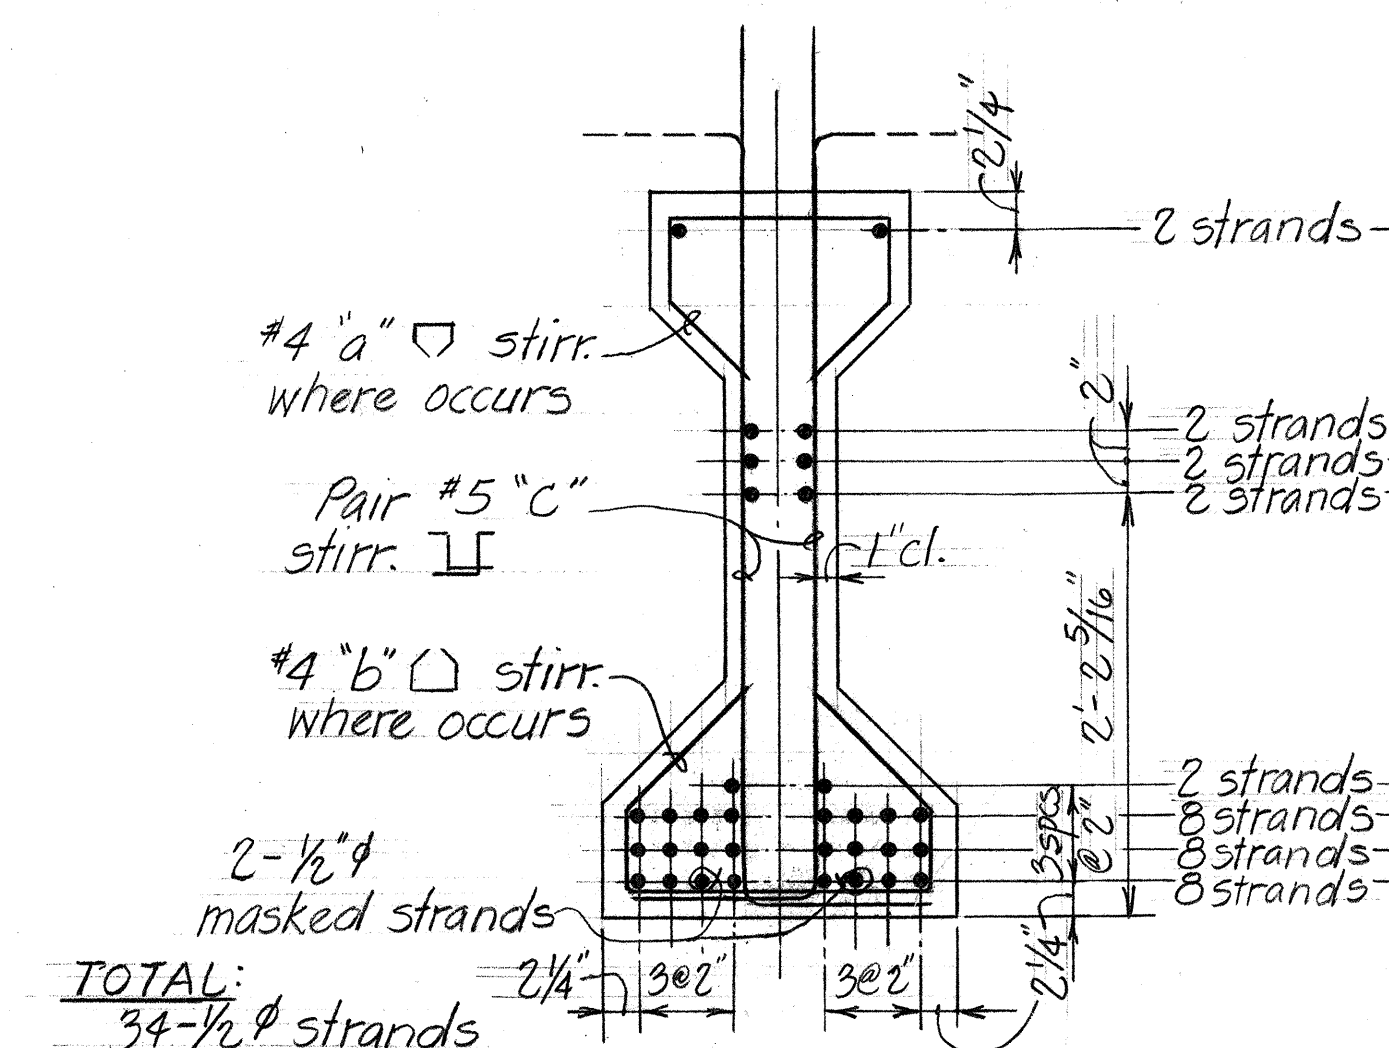

TYPICAL TYPE III-A GIRDER SECTION Scale: 1" = 1'-0"

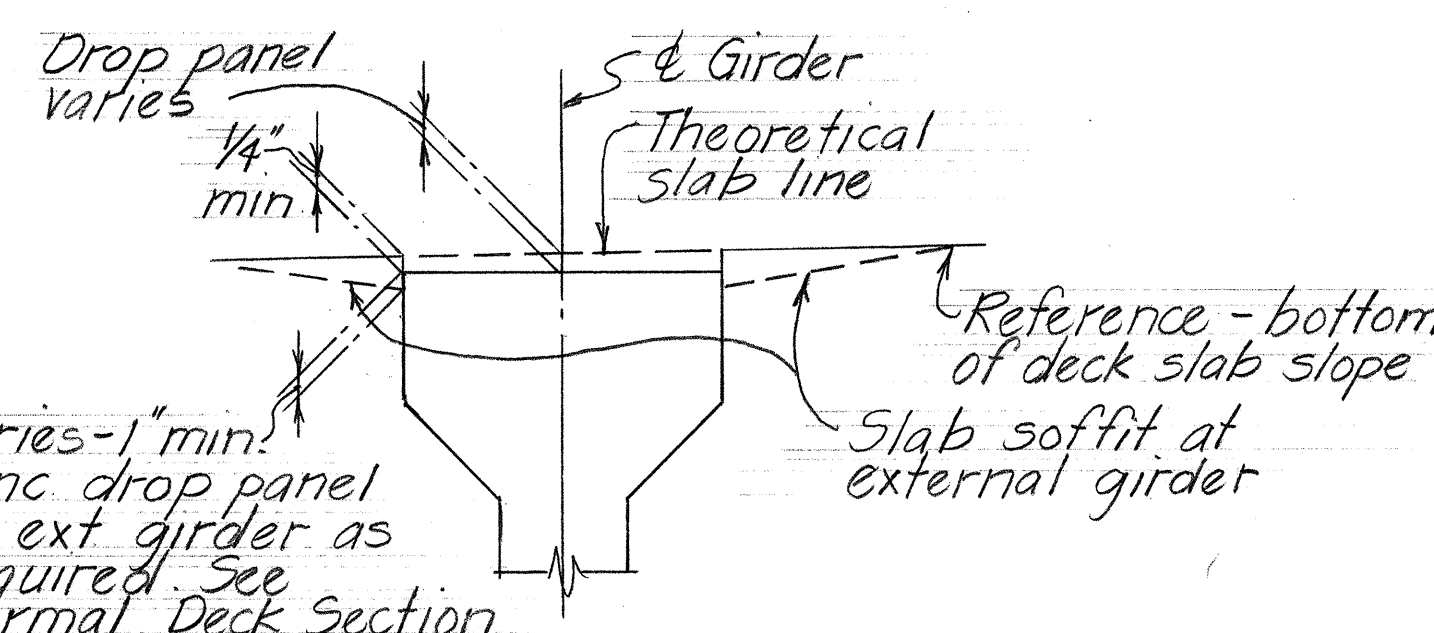


TYPICAL SLAB DROP PANEL DETAIL AT PRESTRESSED GIRDERS Not to Scale

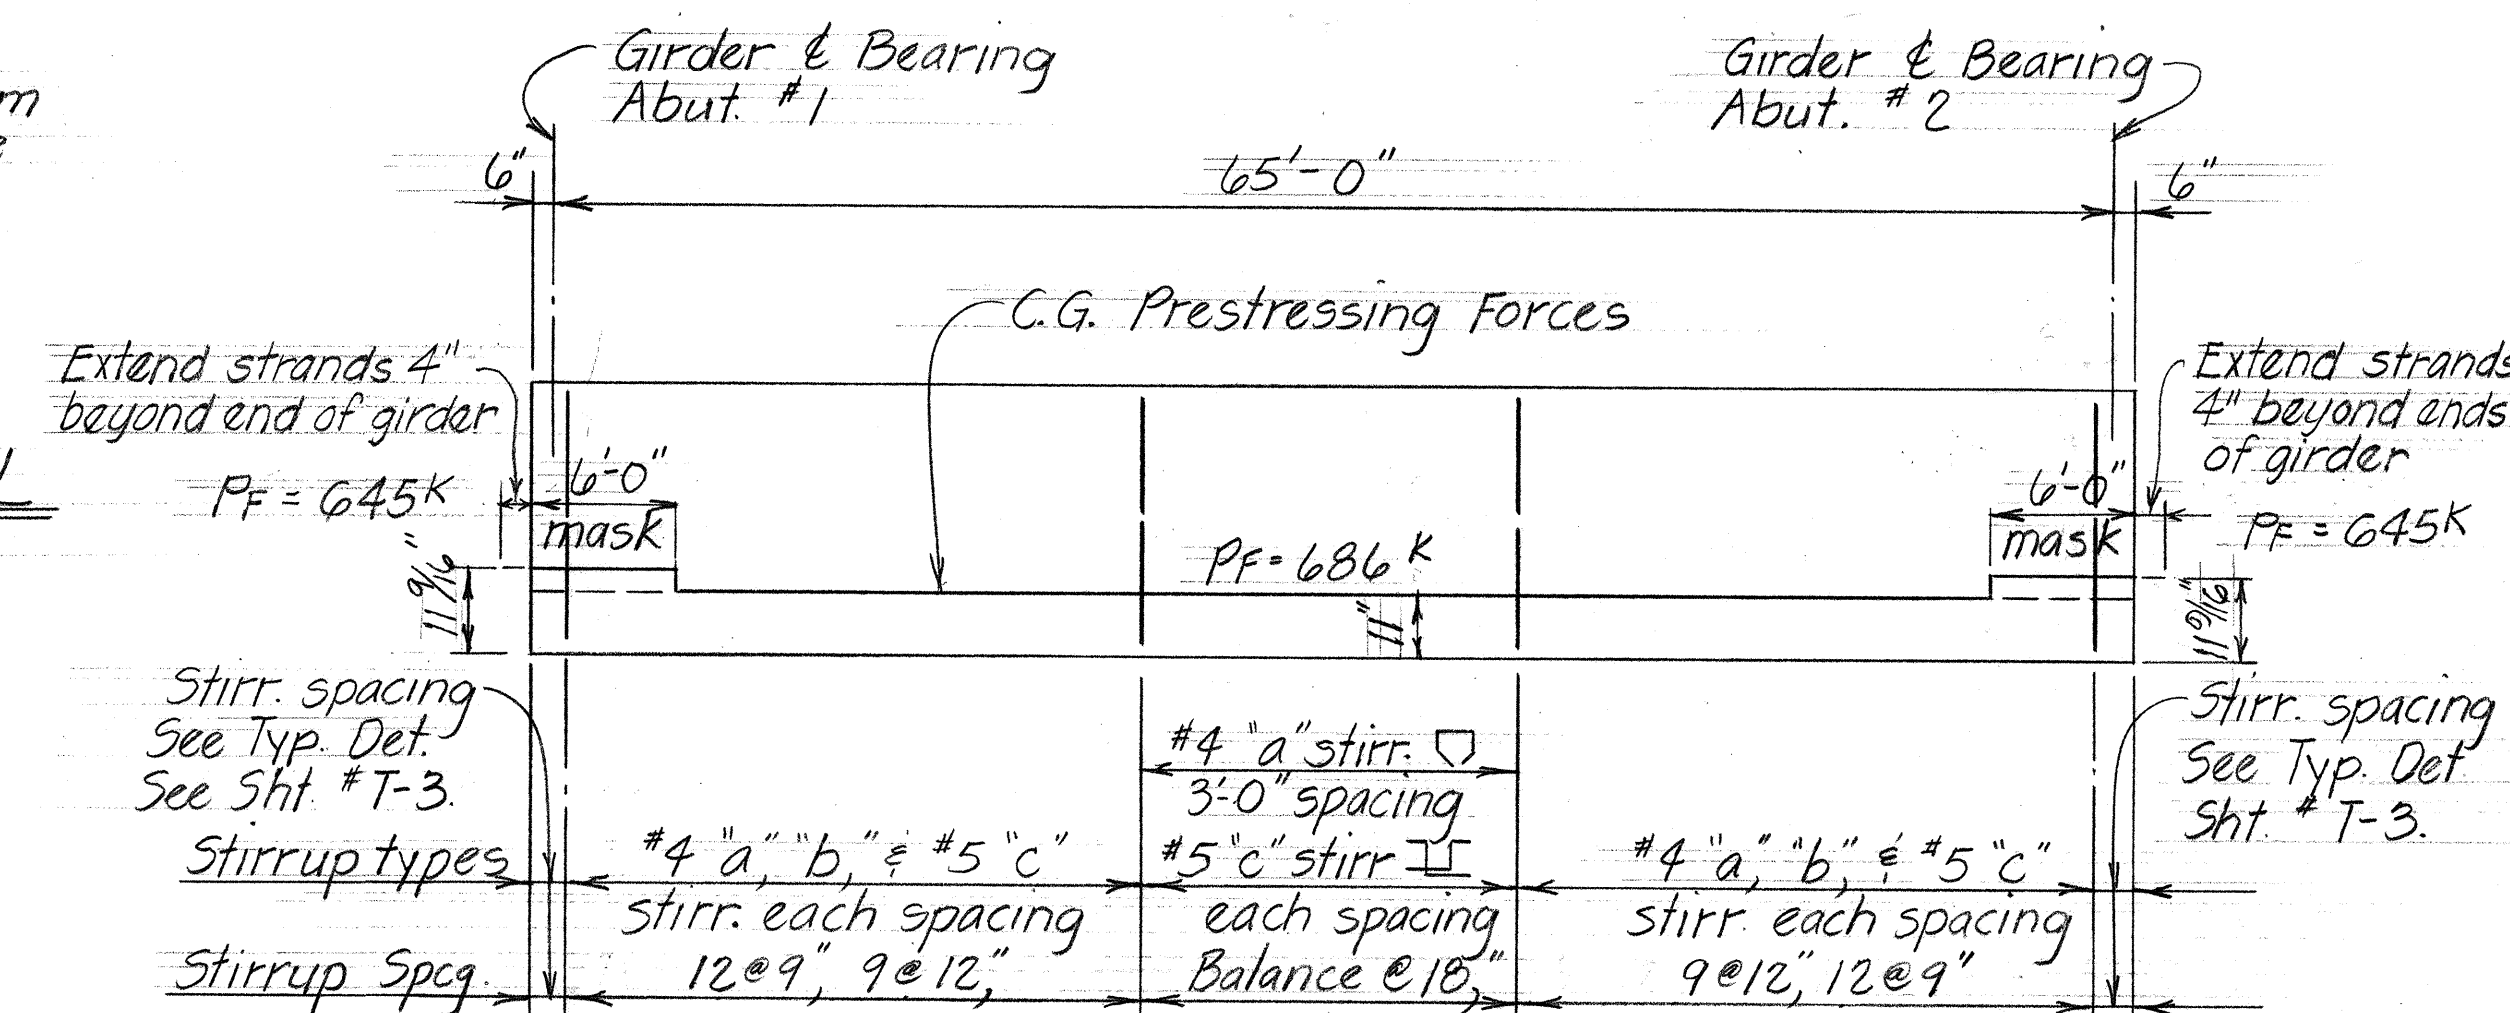


TYPICAL PRESTRESSED GIRDER PG III-A DETAILS Not to Scale

NOTE: Girder Dimension L = Horiz. measurement between each end of girder. The Contractor shall determine total slope length of girder. For additional End anchorage connectors in prestressed girders at Beams "A" and Beams "B" refer to corresponding drawings. For additional prestressed girder details not covered by this drawing refer to sht. # T-3.

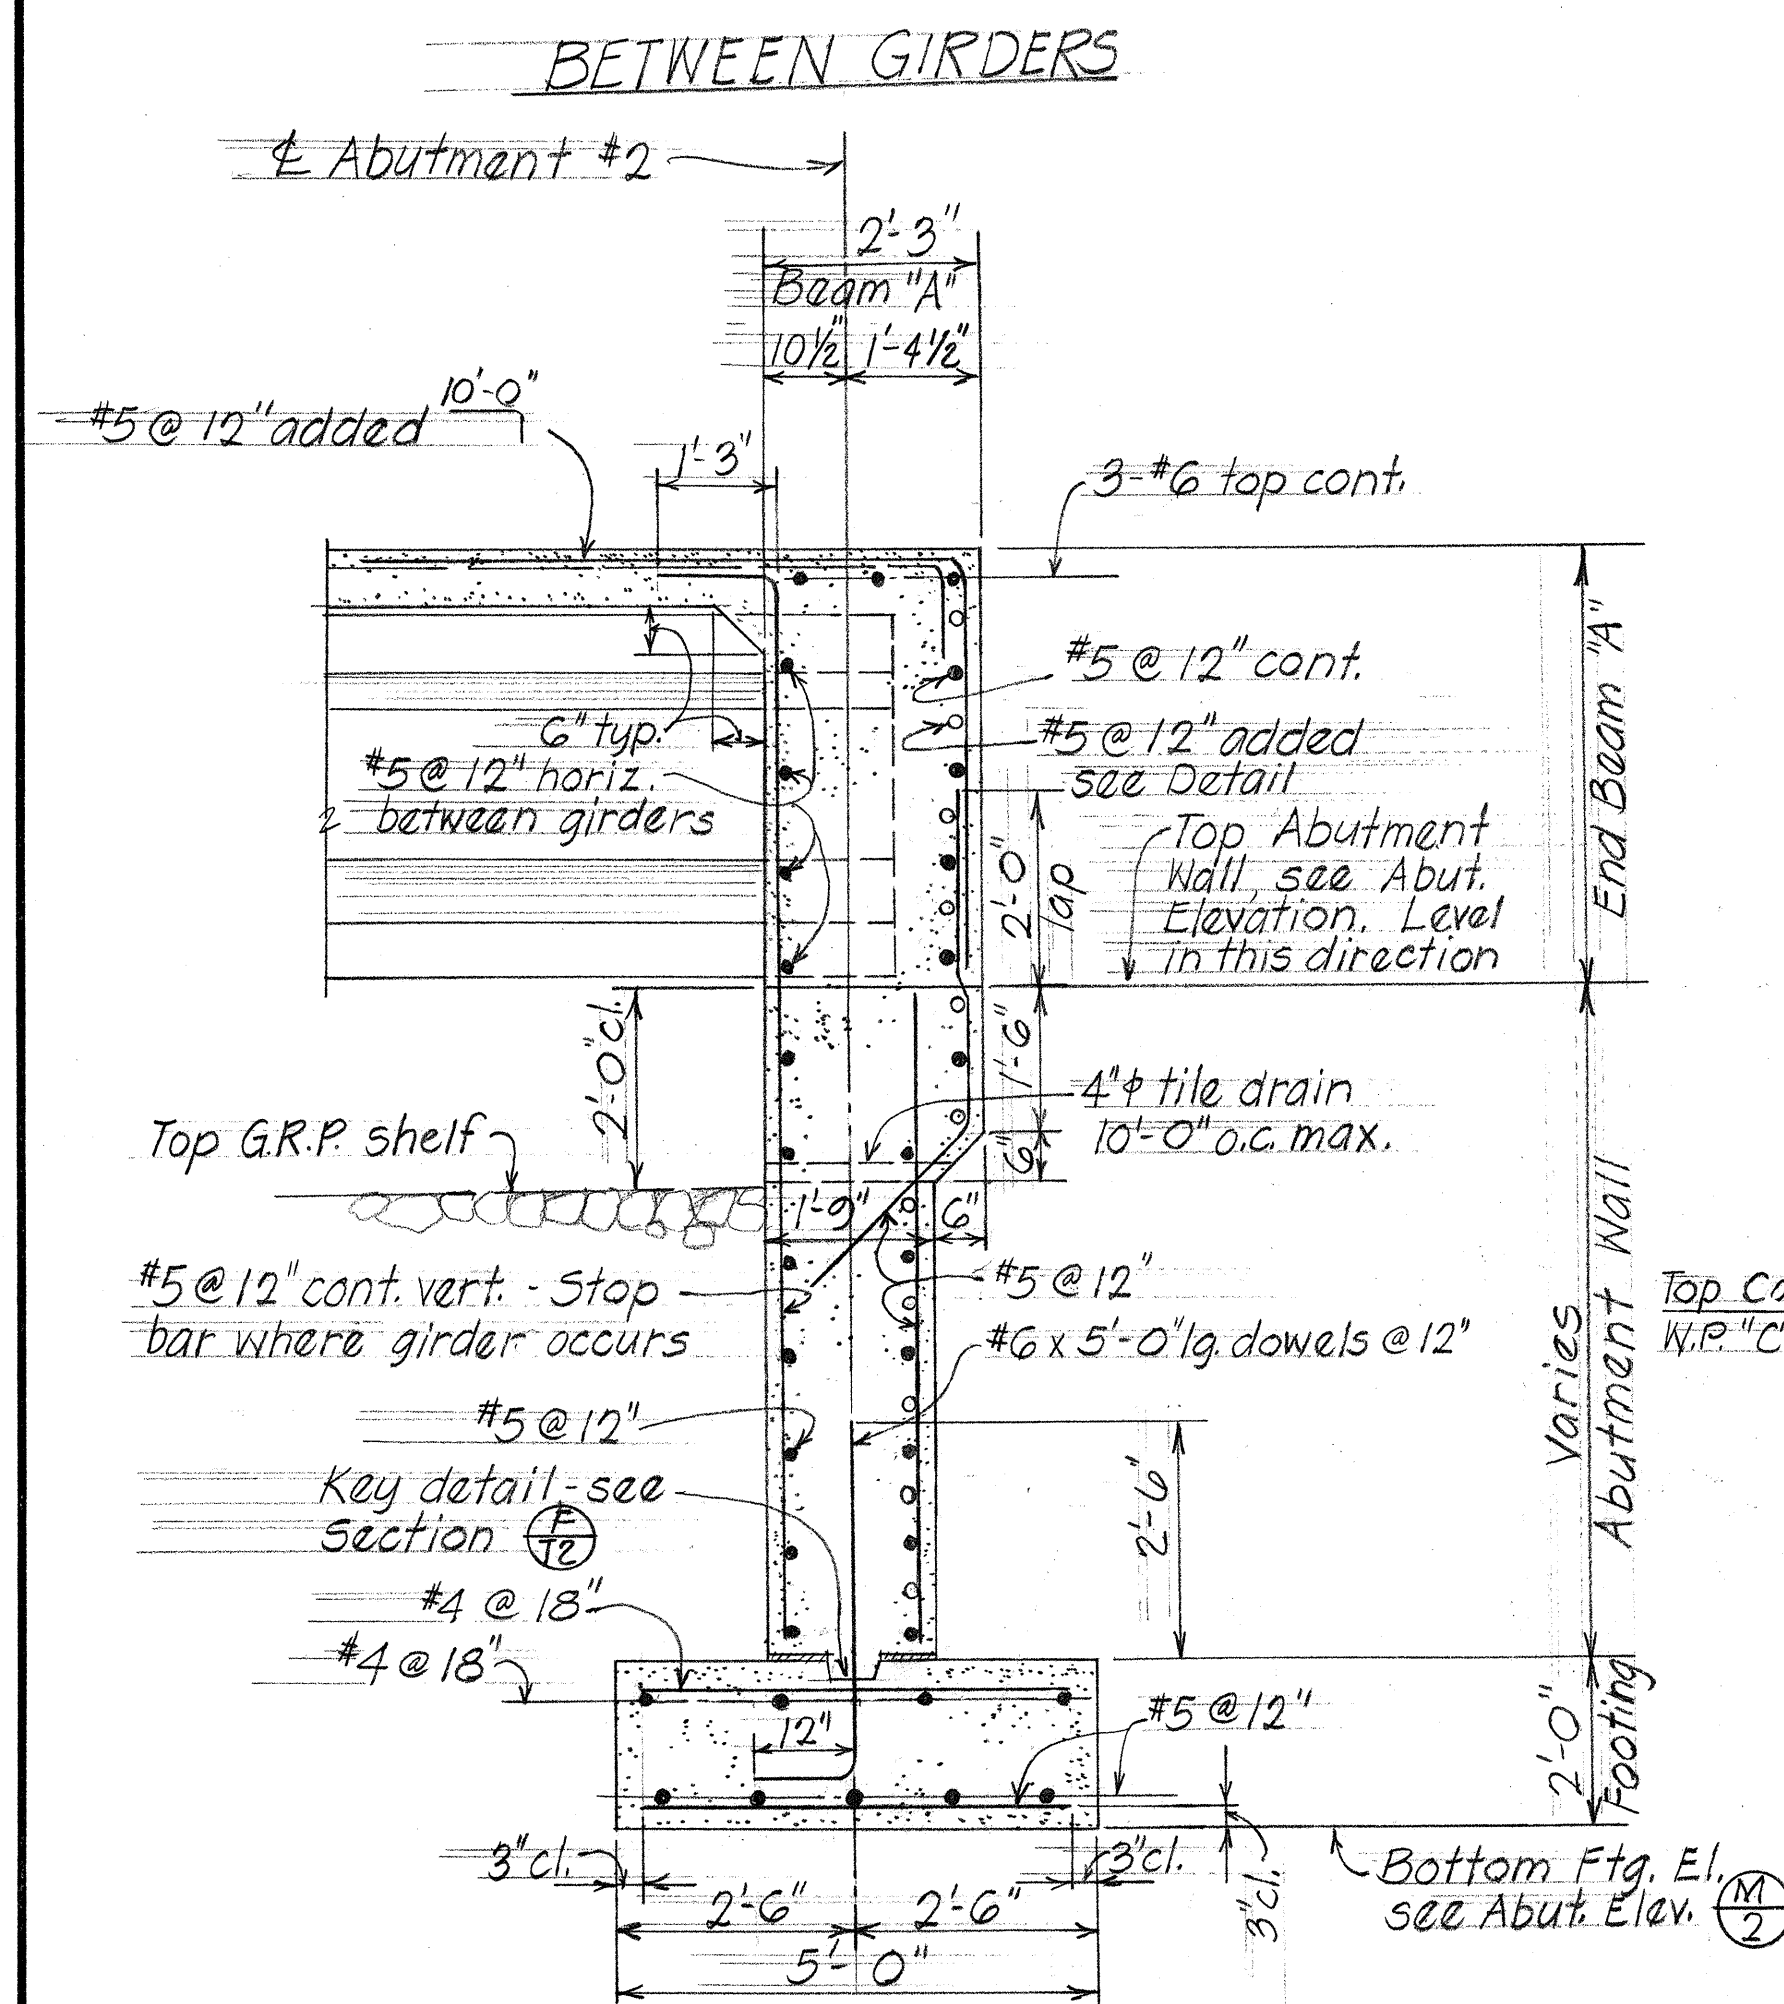










WALL TYPE AW-2 Scale: 1/2" = 1'-0"

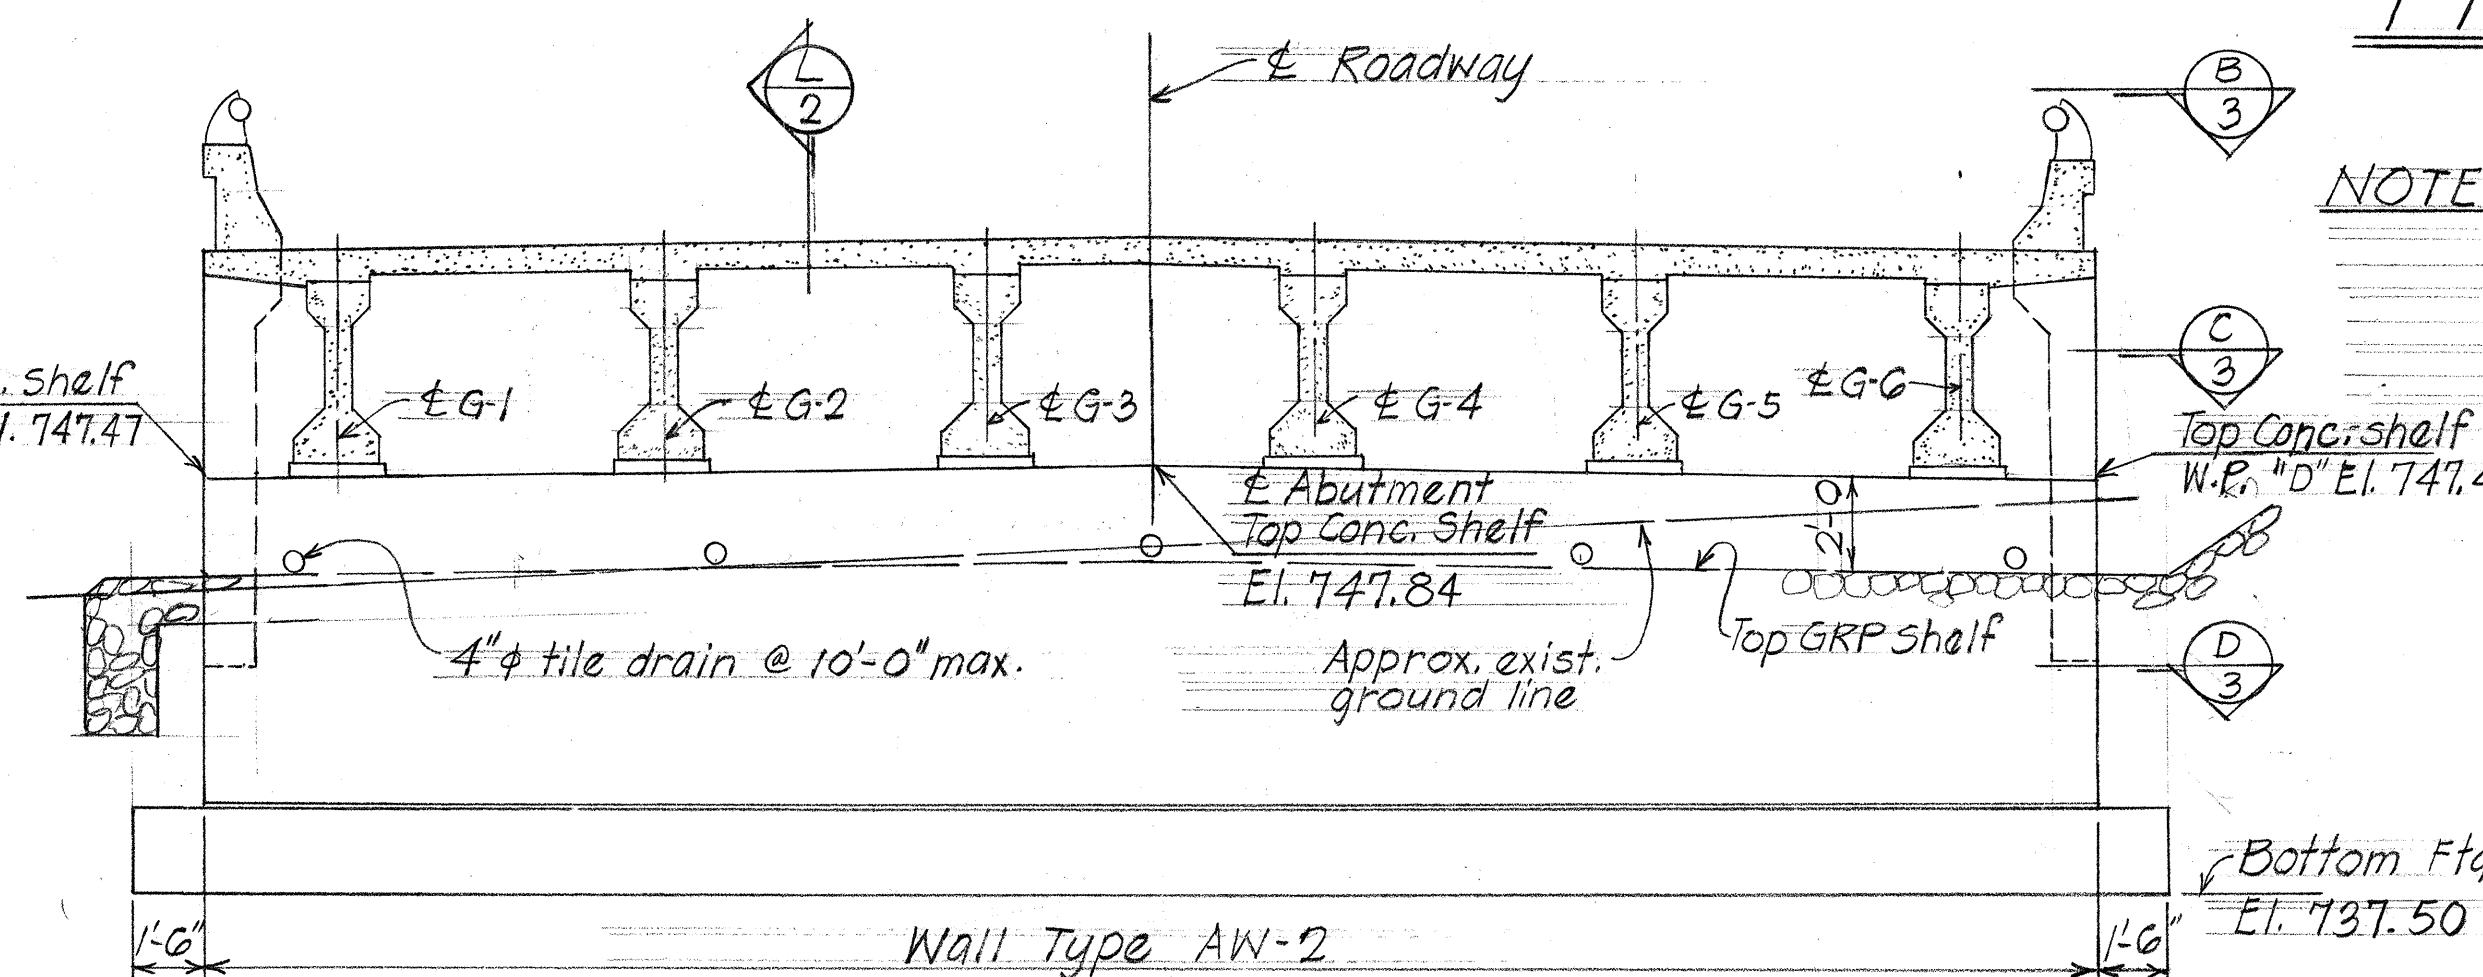

ELEVATION (M)-ABUTMENT #2 Scale: 1/4" = 1'-0"

STATE OF HAWAII
DEPARTMENT OF TRANSPORTATION
HIGHWAYS DIVISION
WAIPUNAHOE STREAM BRIDGE
DECK FRAMING PLAN & SECTIONS
Project No. 240A-02-71 April 1970
SHEET No. 2 OF 3 SHEETS

FED. ROAD DIST. NO.	STATE	PROJ. NO.	FISCAL YEAR	SHEET NO.	TOTAL SHEETS
HAWAII	HAW.	240A-02-71	1972	18	29

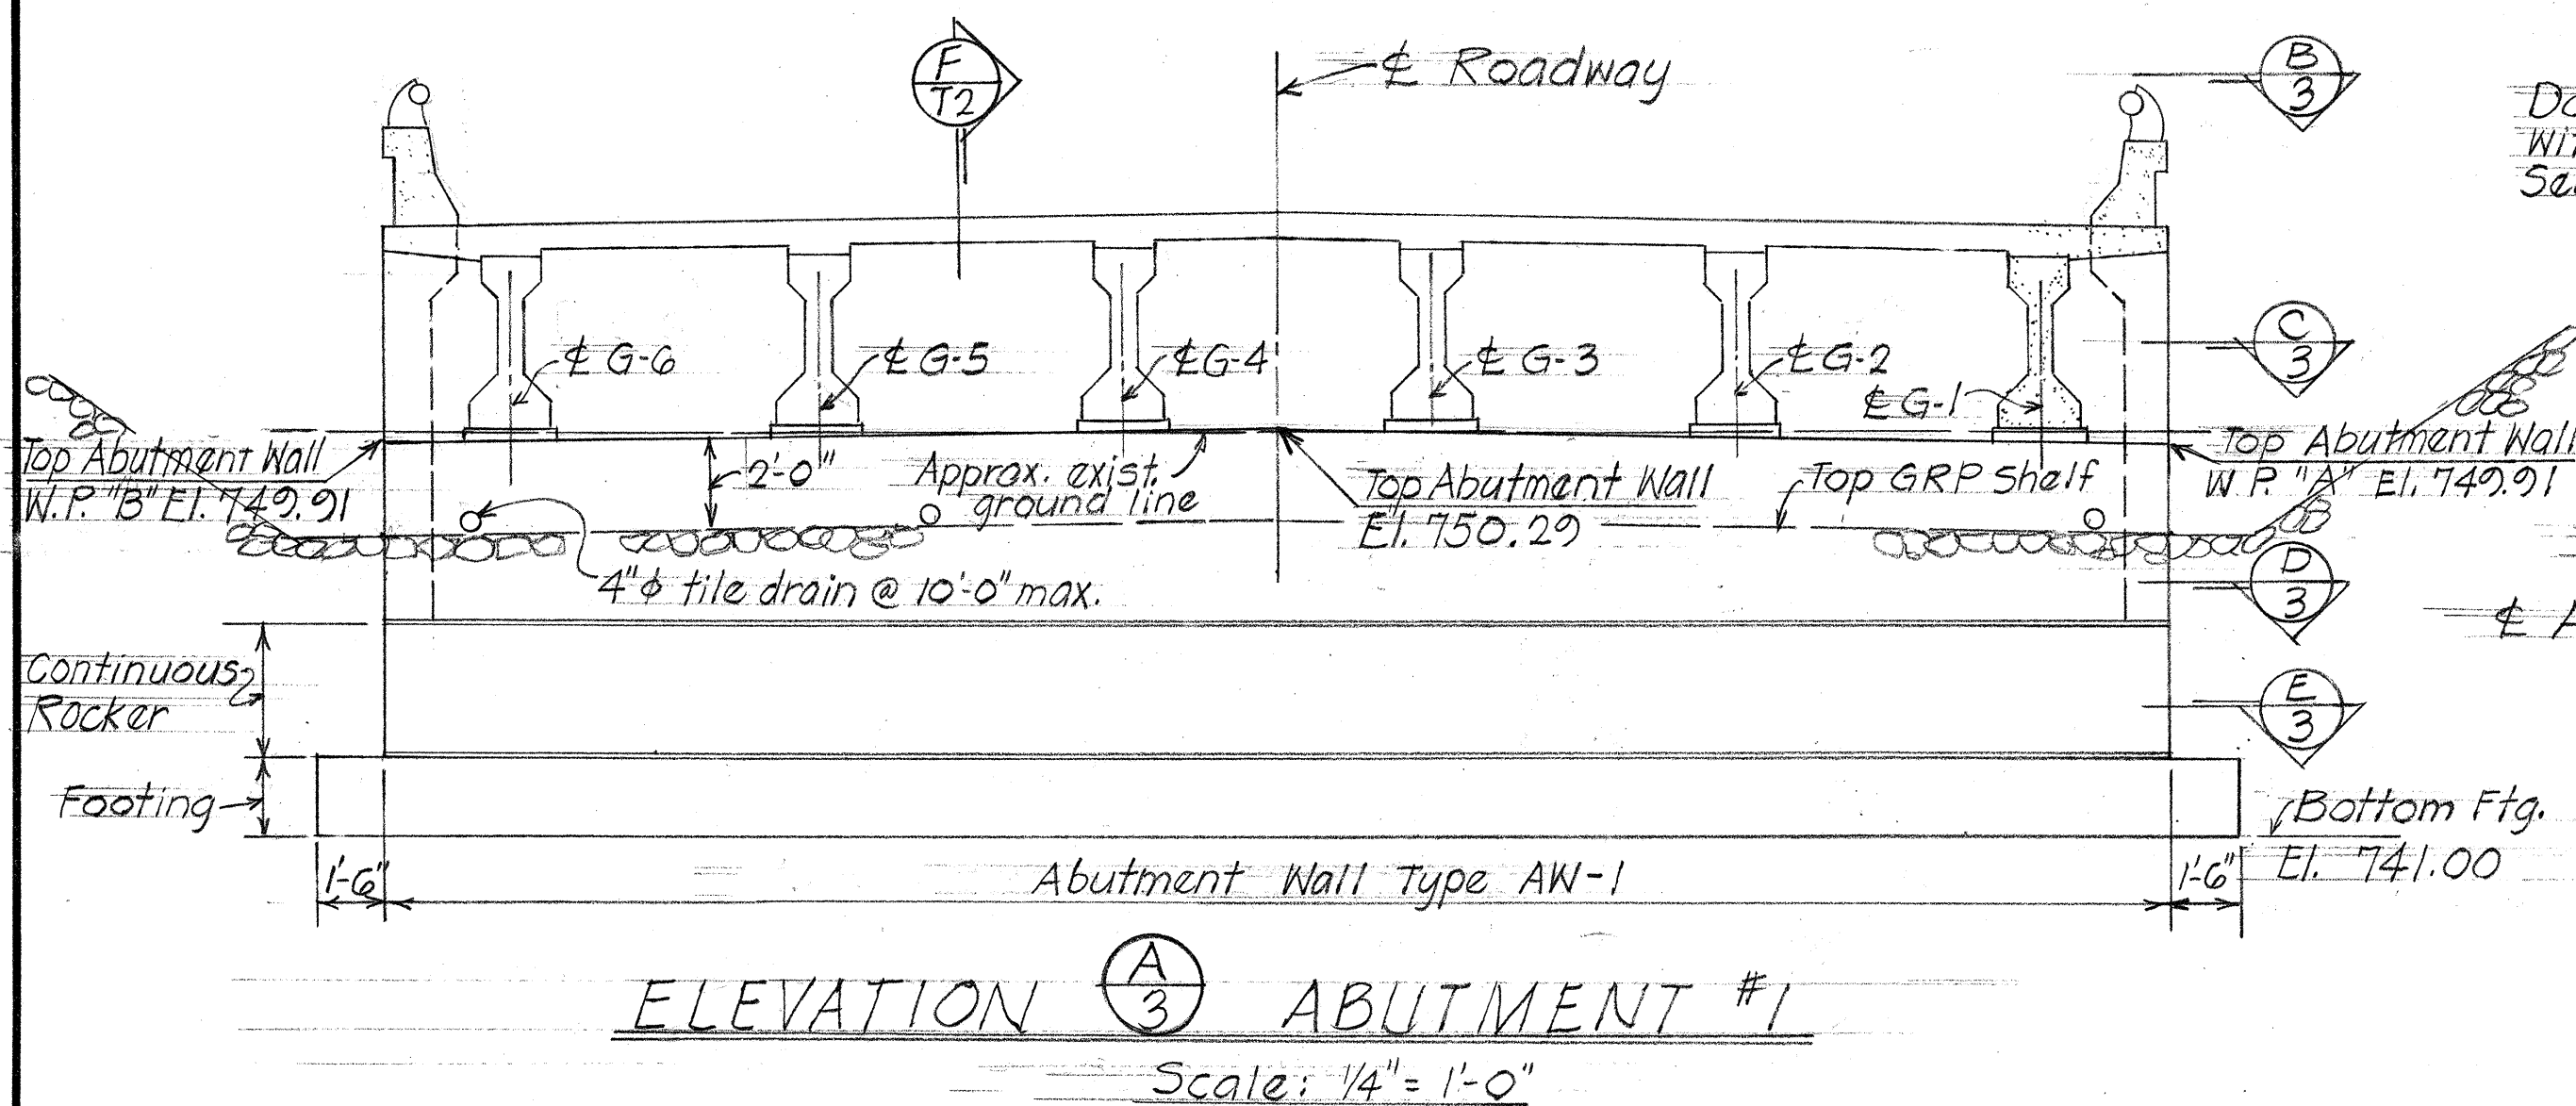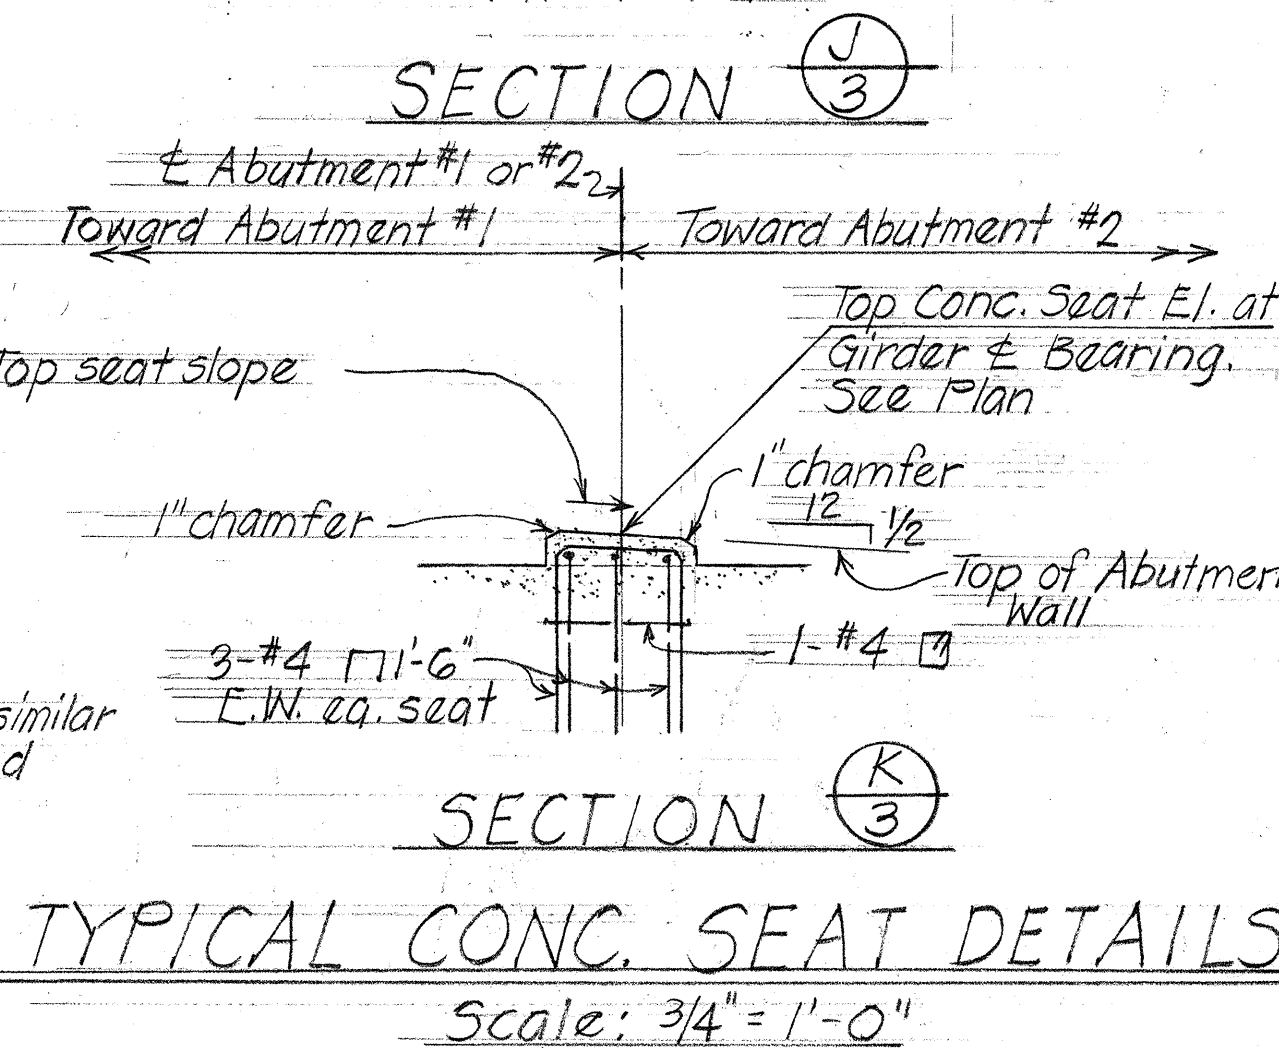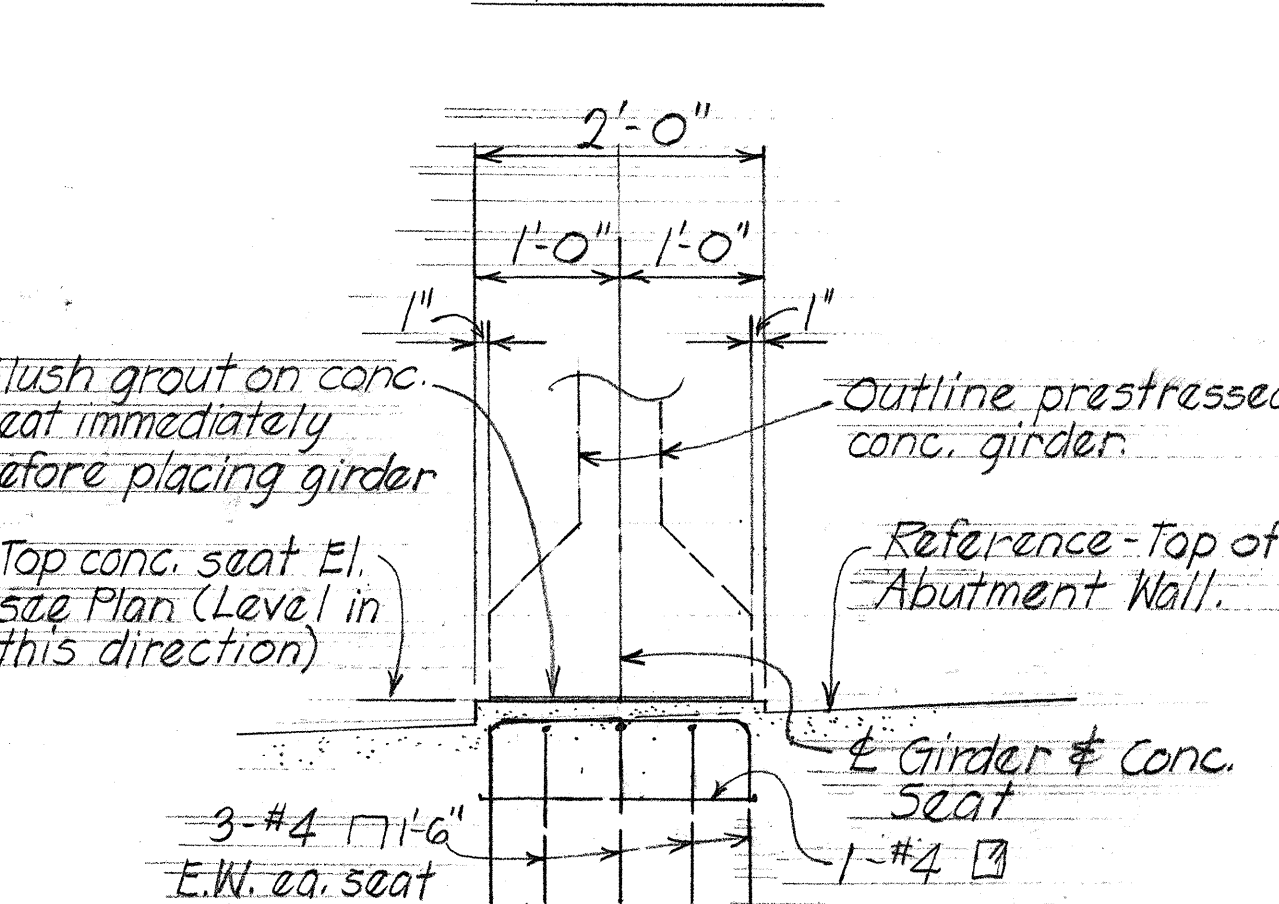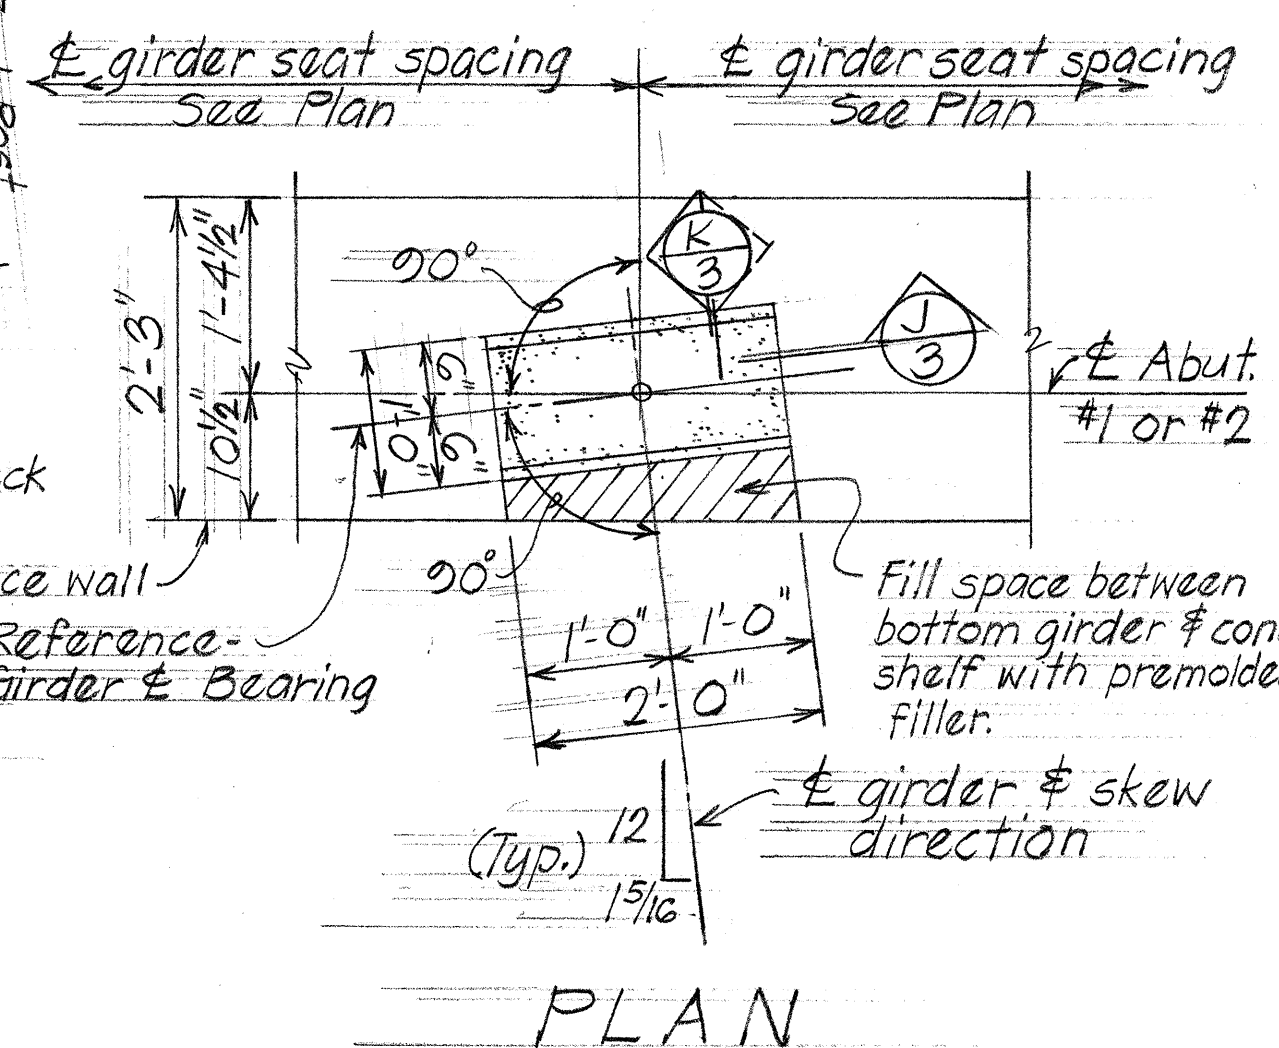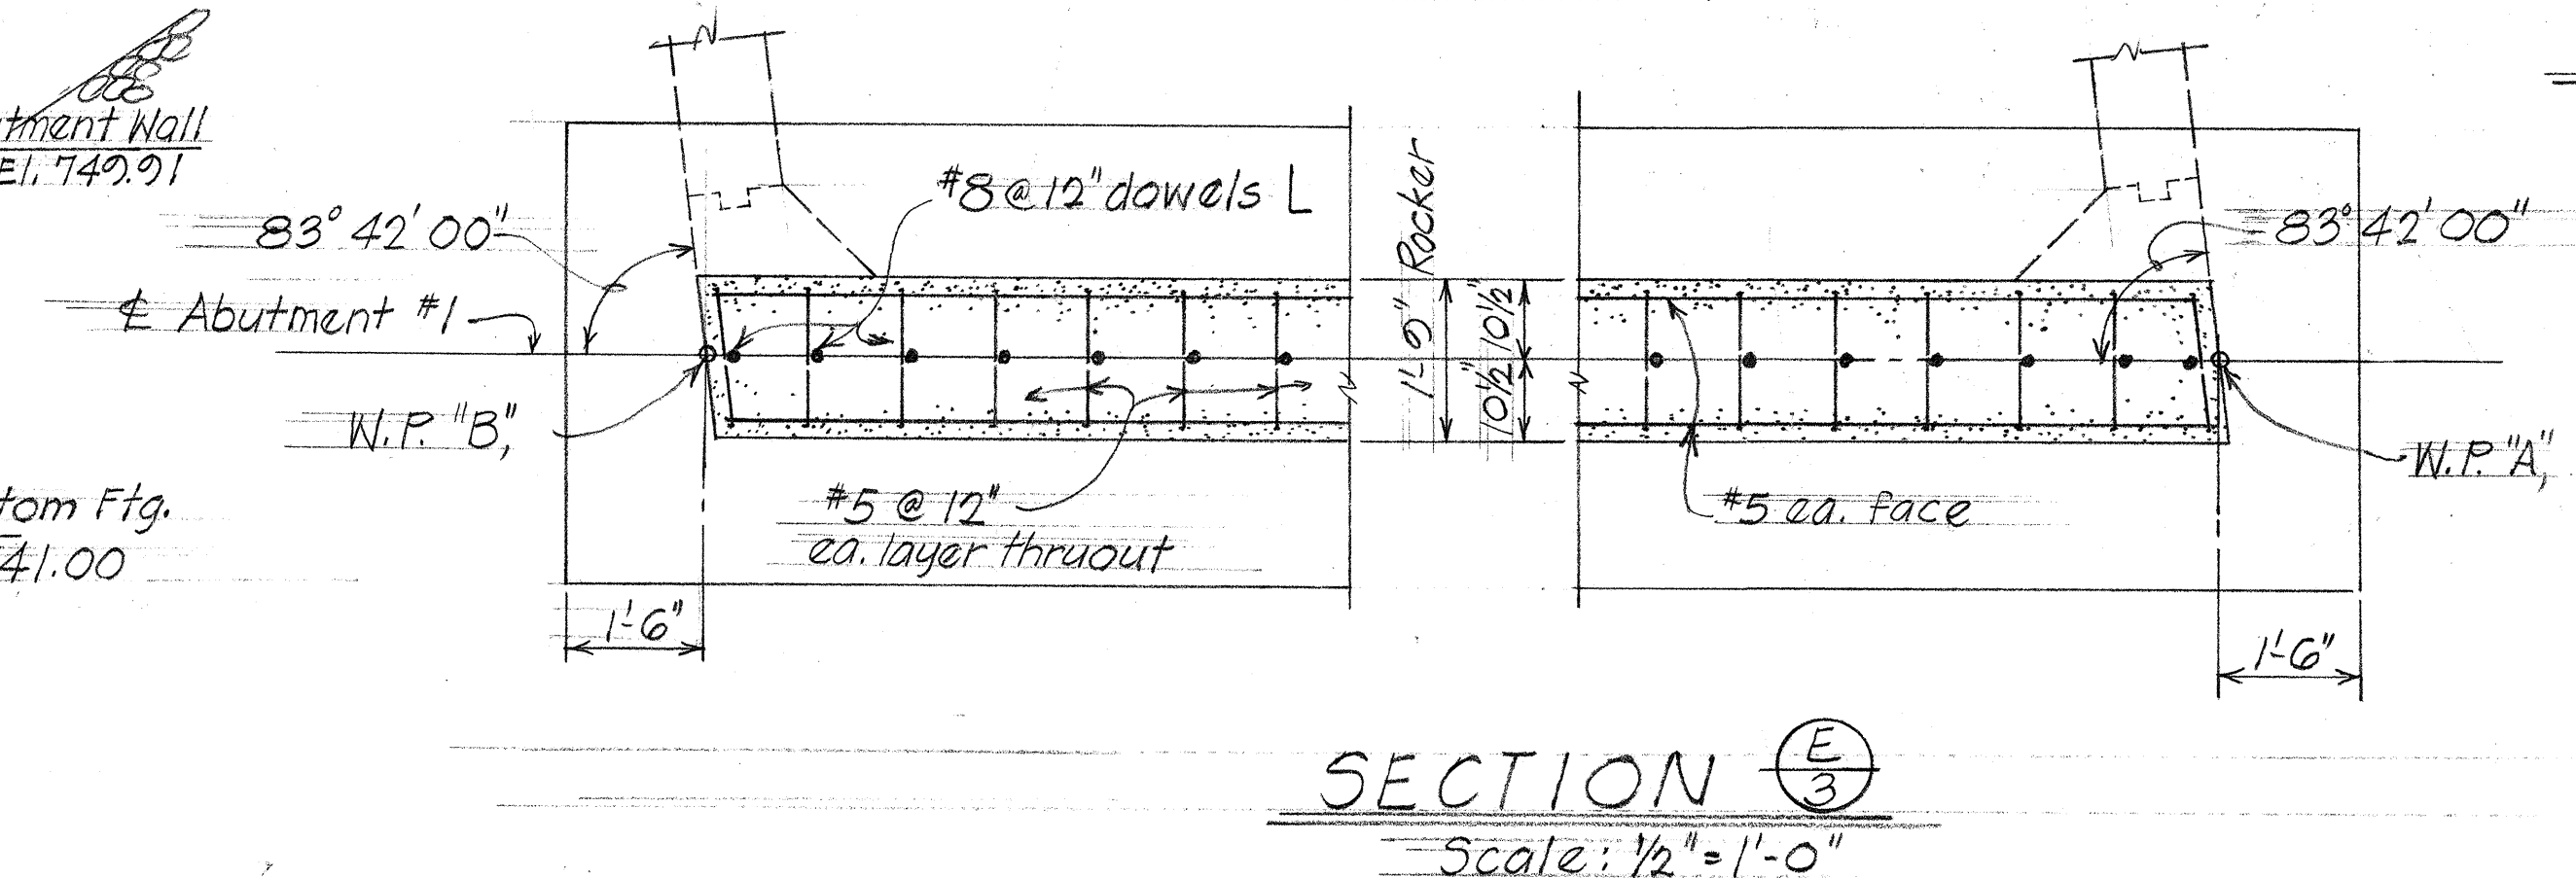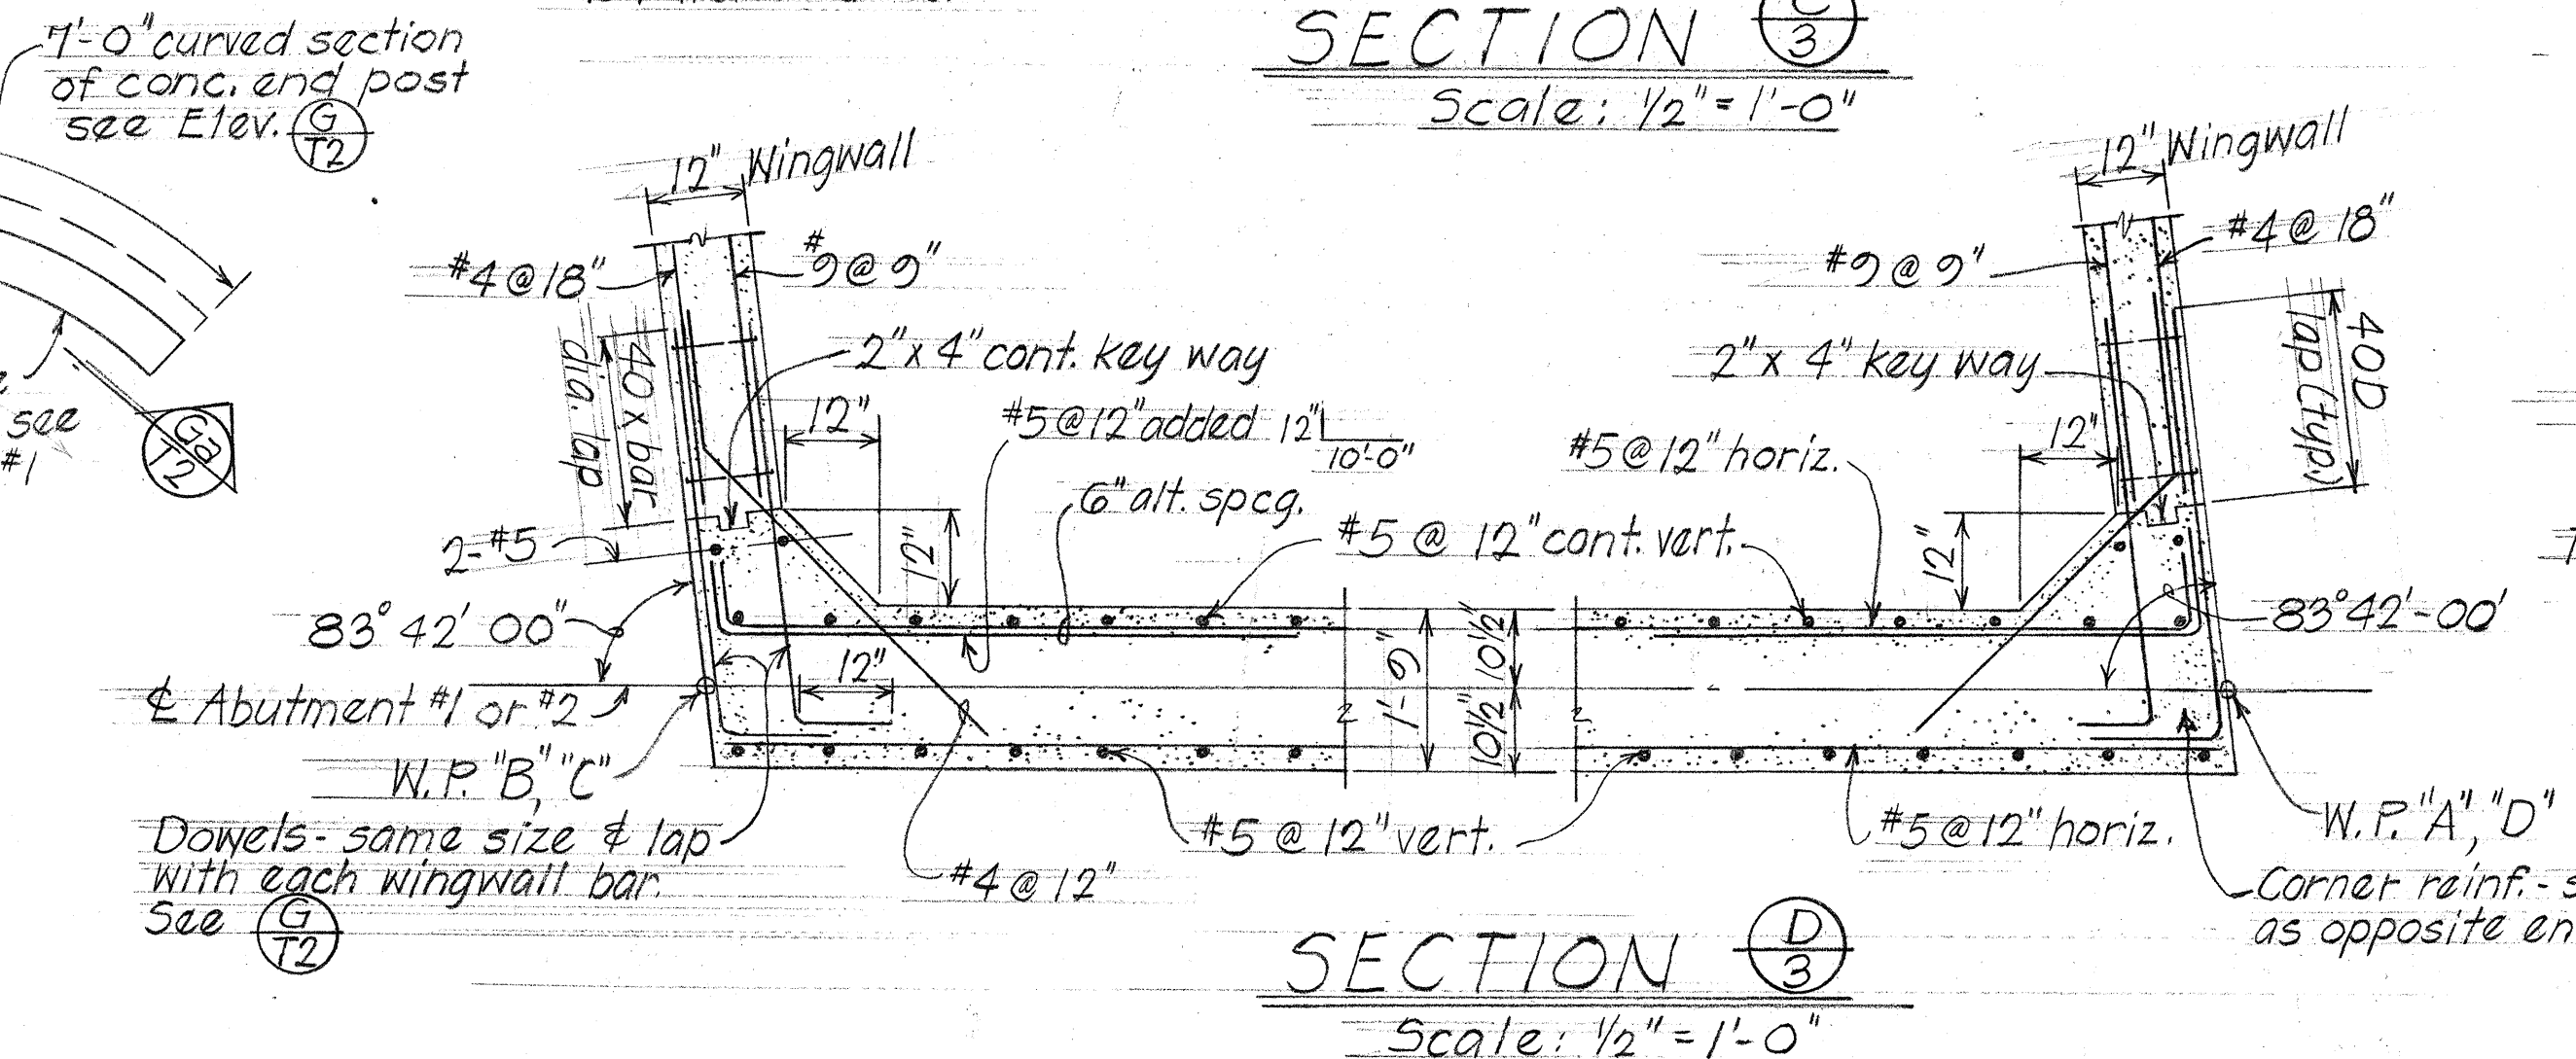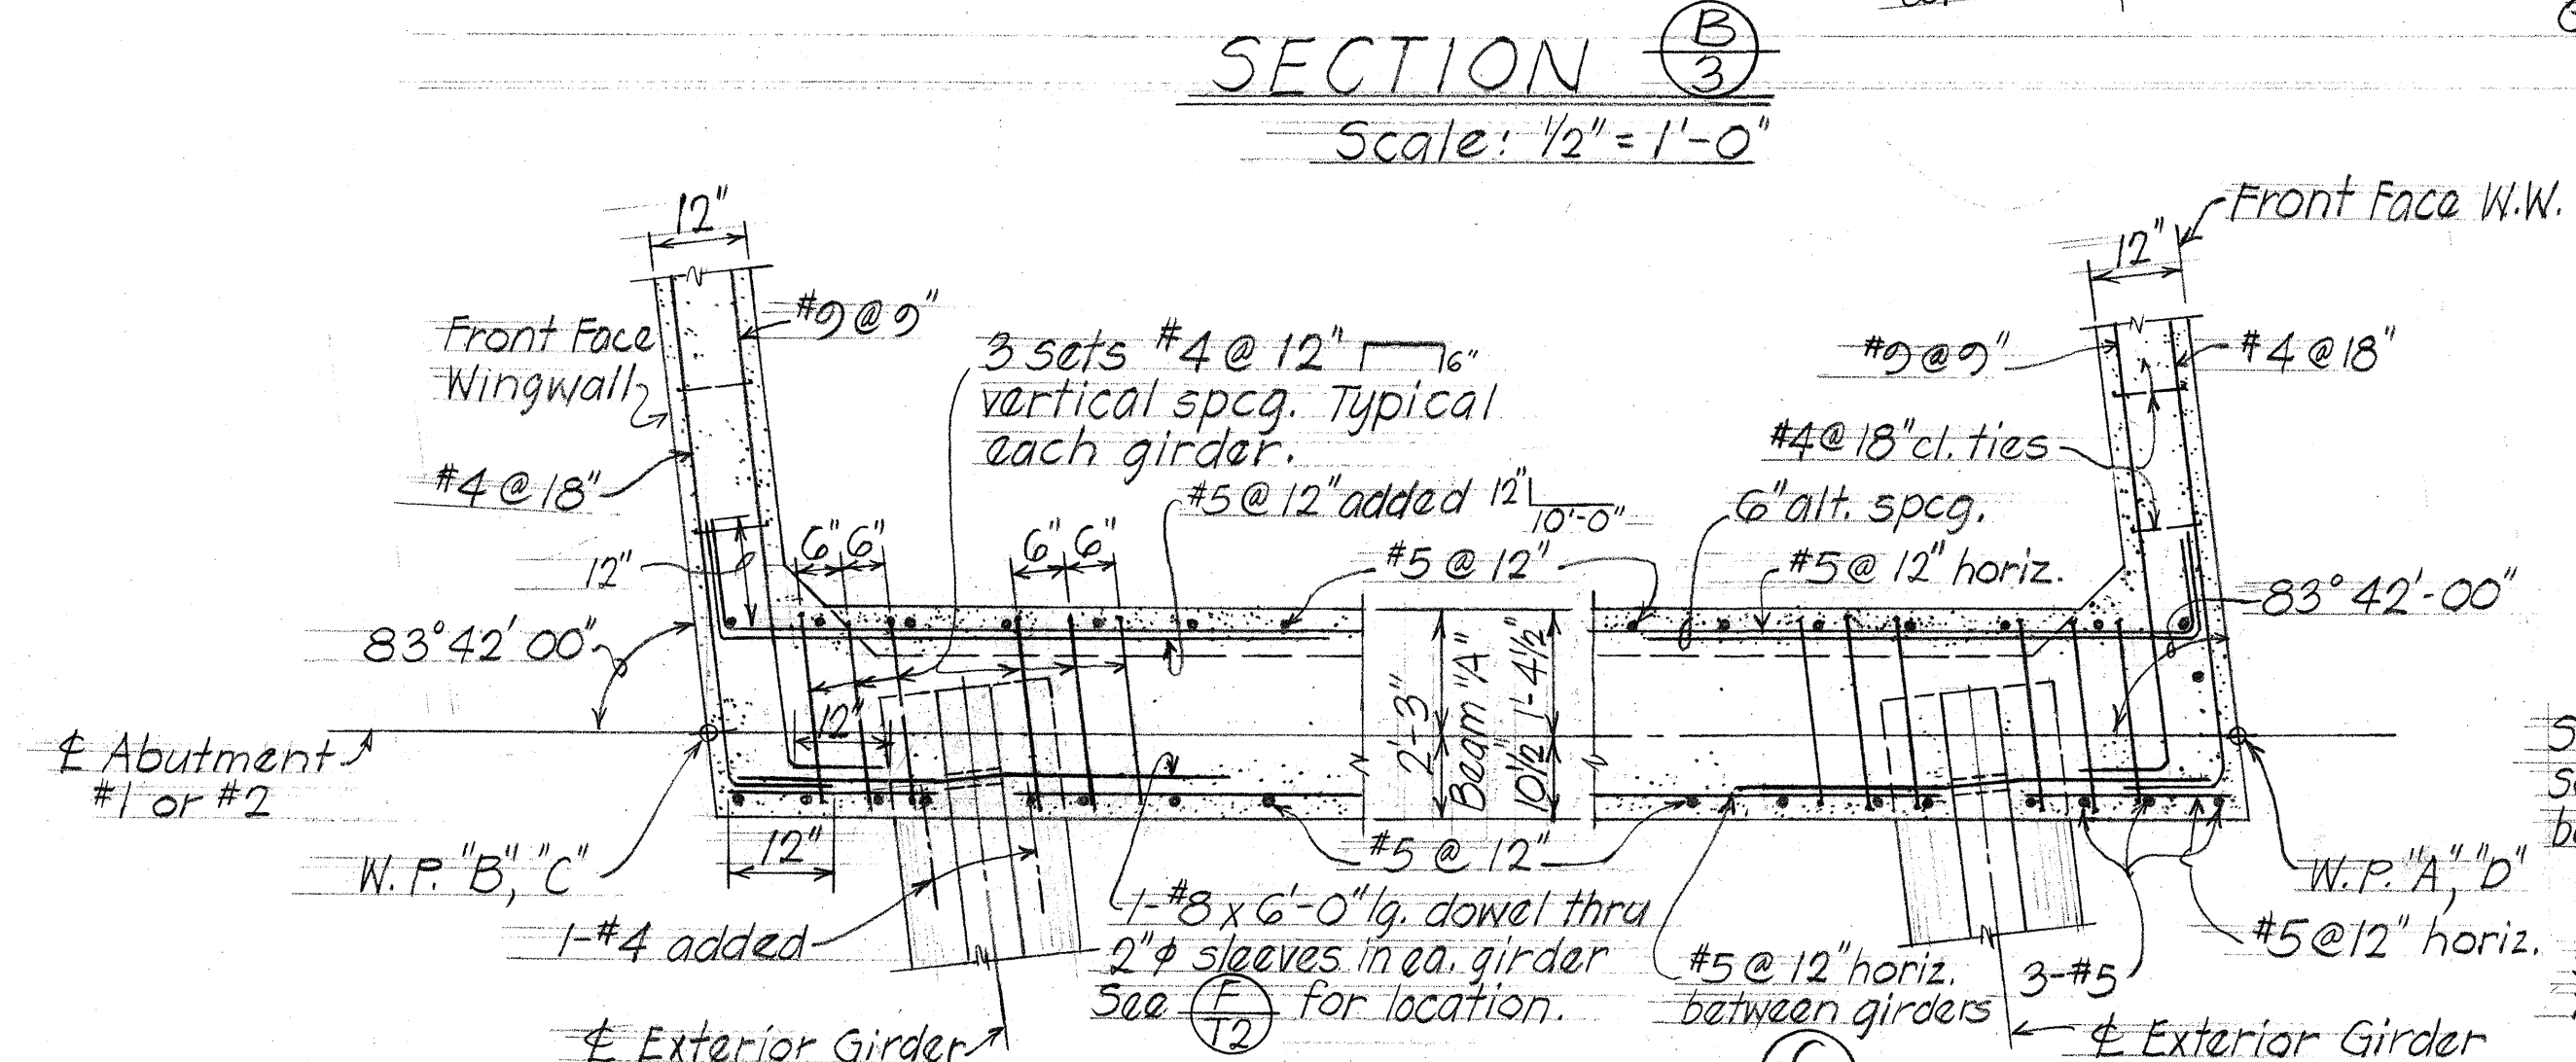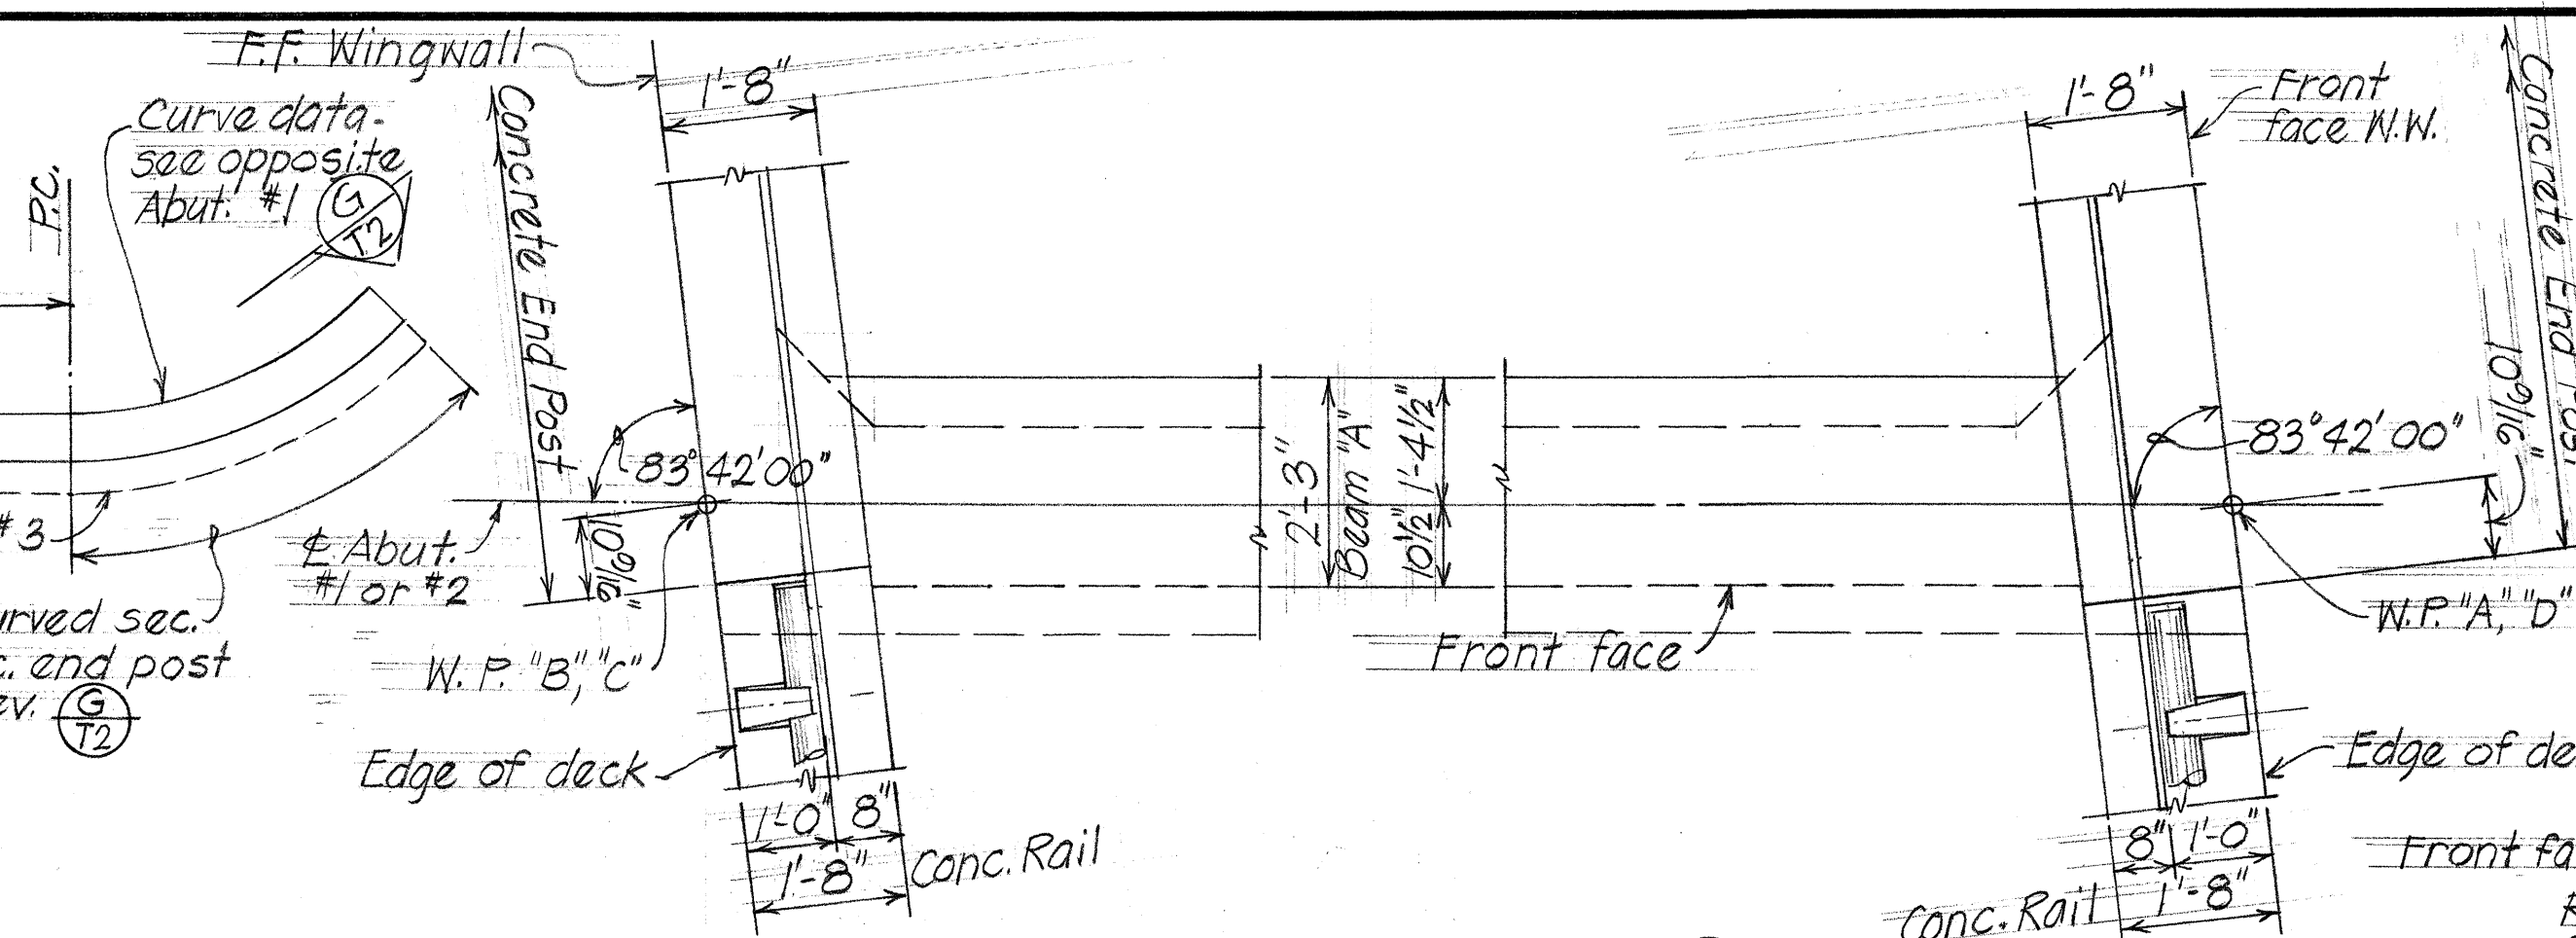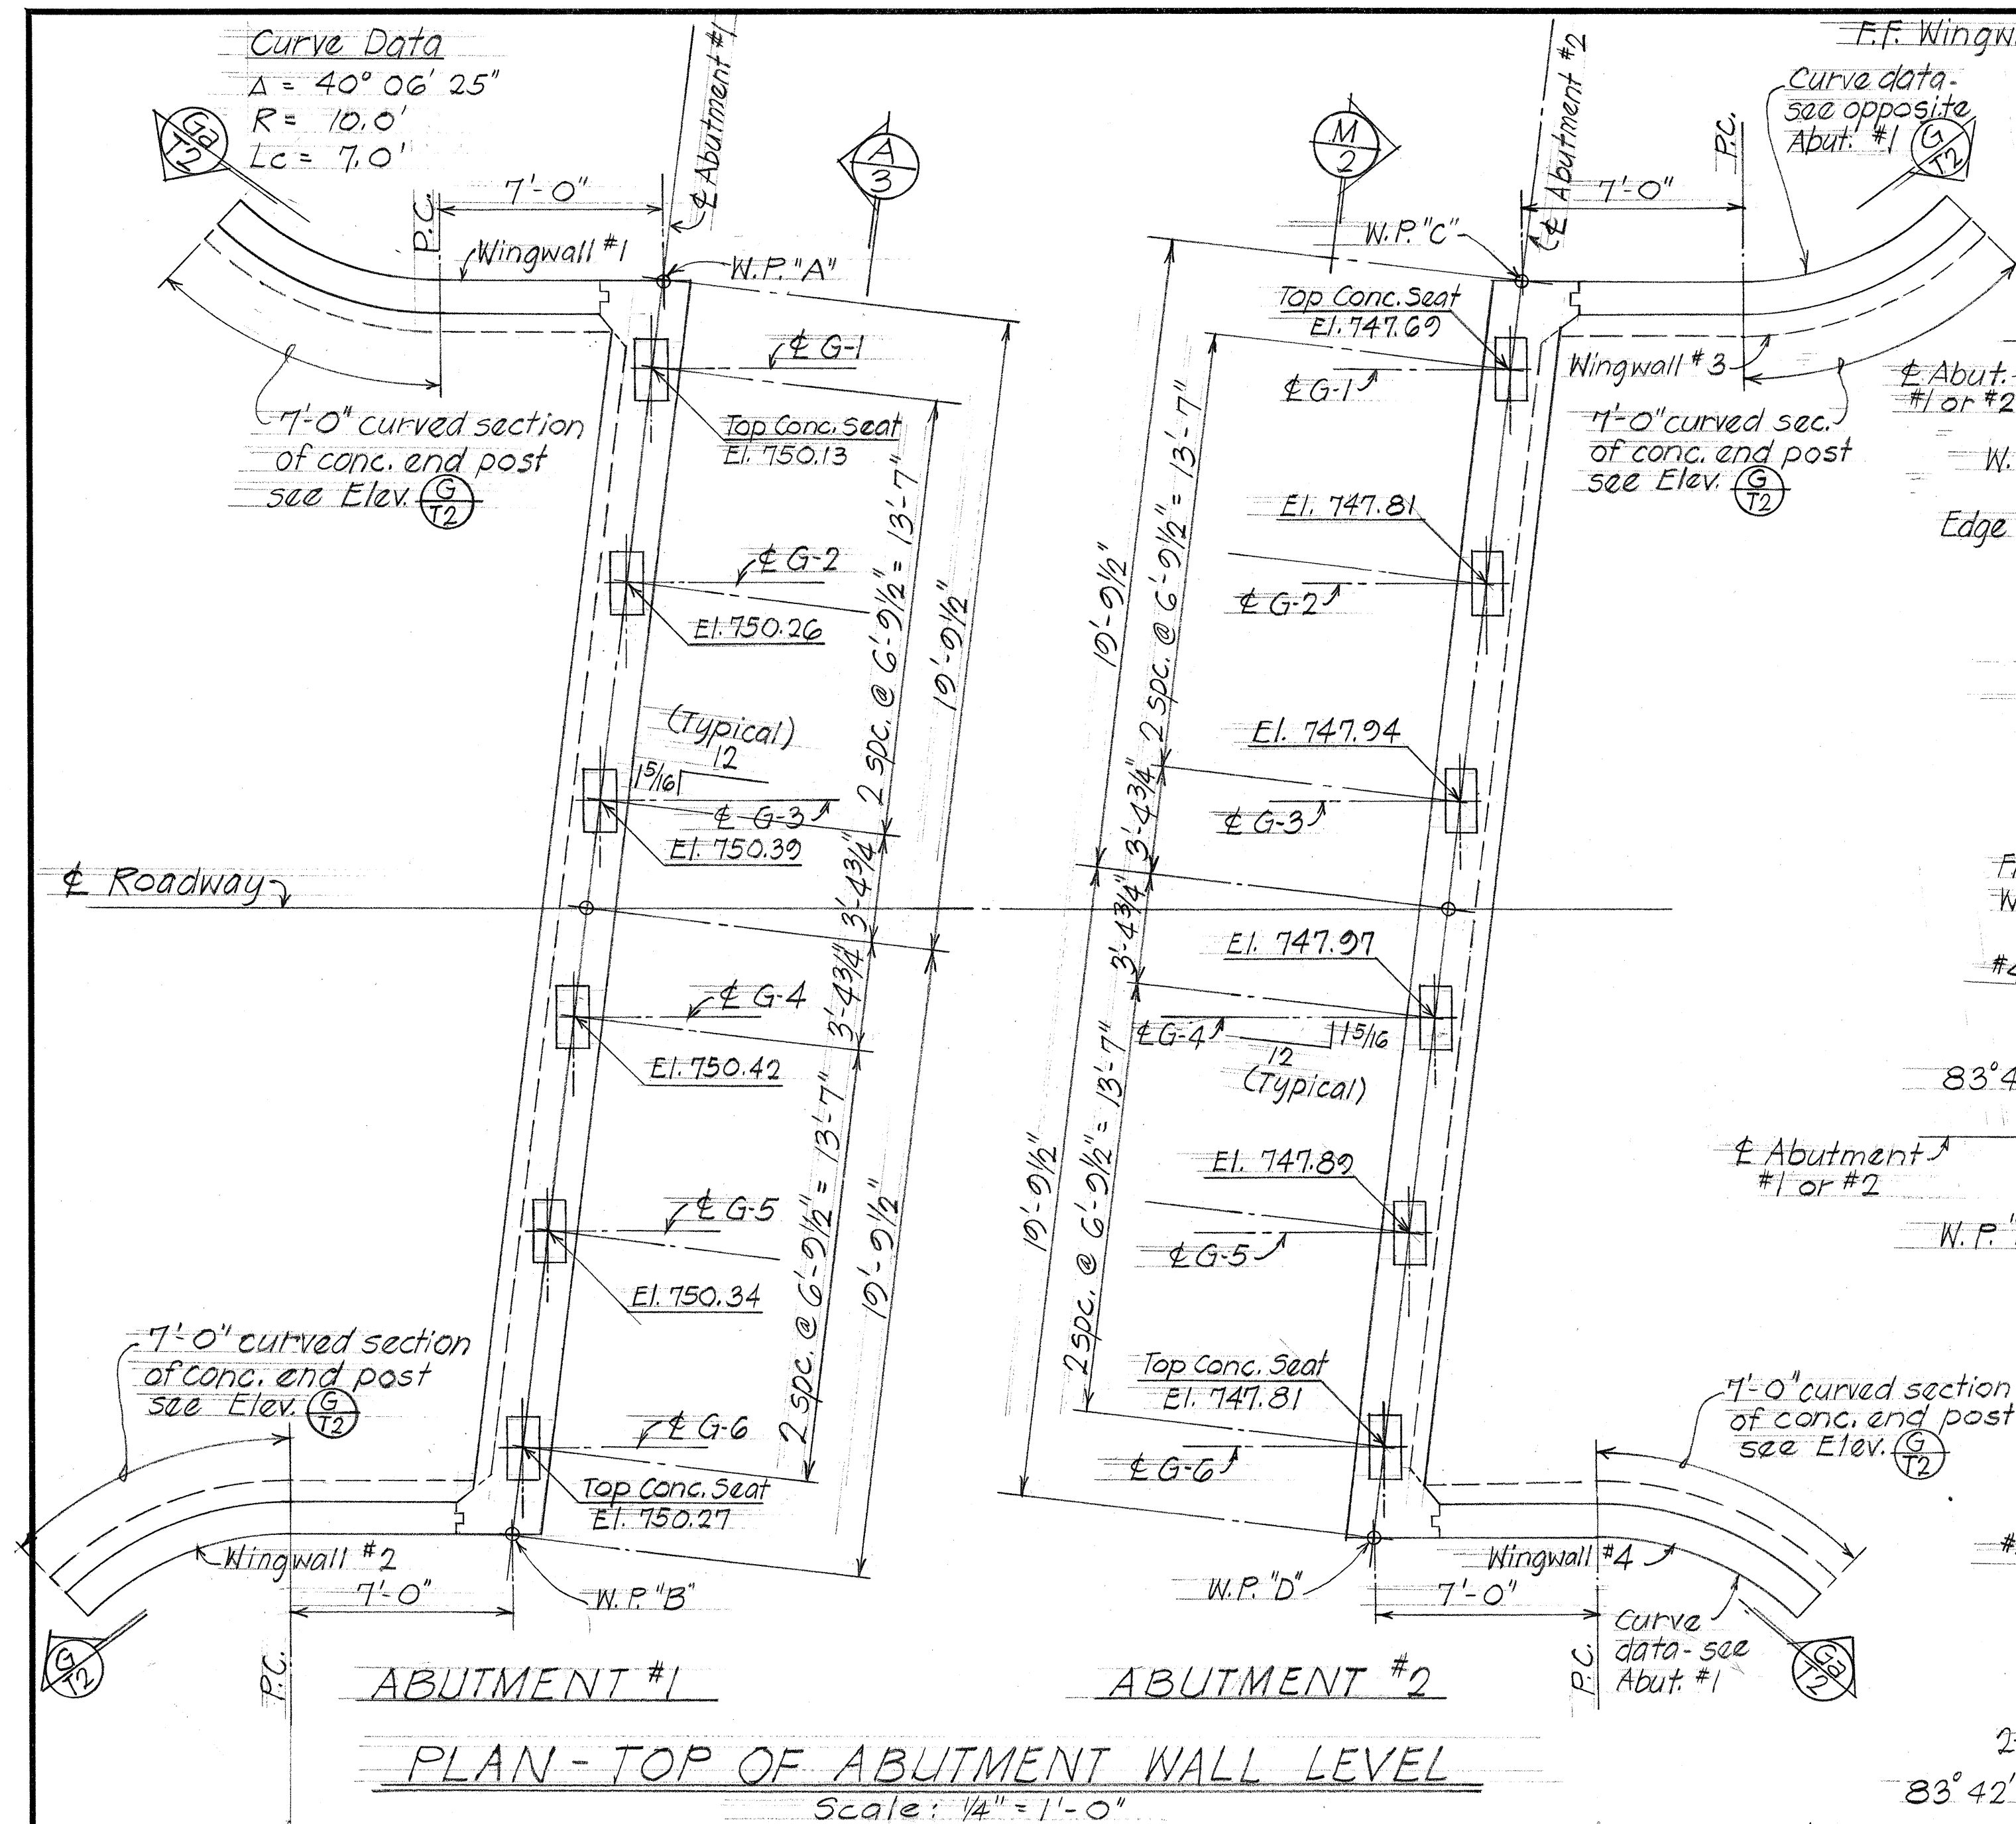

STATE OF HAWAII
 DEPARTMENT OF TRANSPORTATION
 HIGHWAYS DIVISION

WAIPIUNAHOE STREAM BRIDGE
 ABUTMENT DETAILS

Project No. 240A-02-71 April 1970
 SHEET No. 3 OF 3 SHEETS