
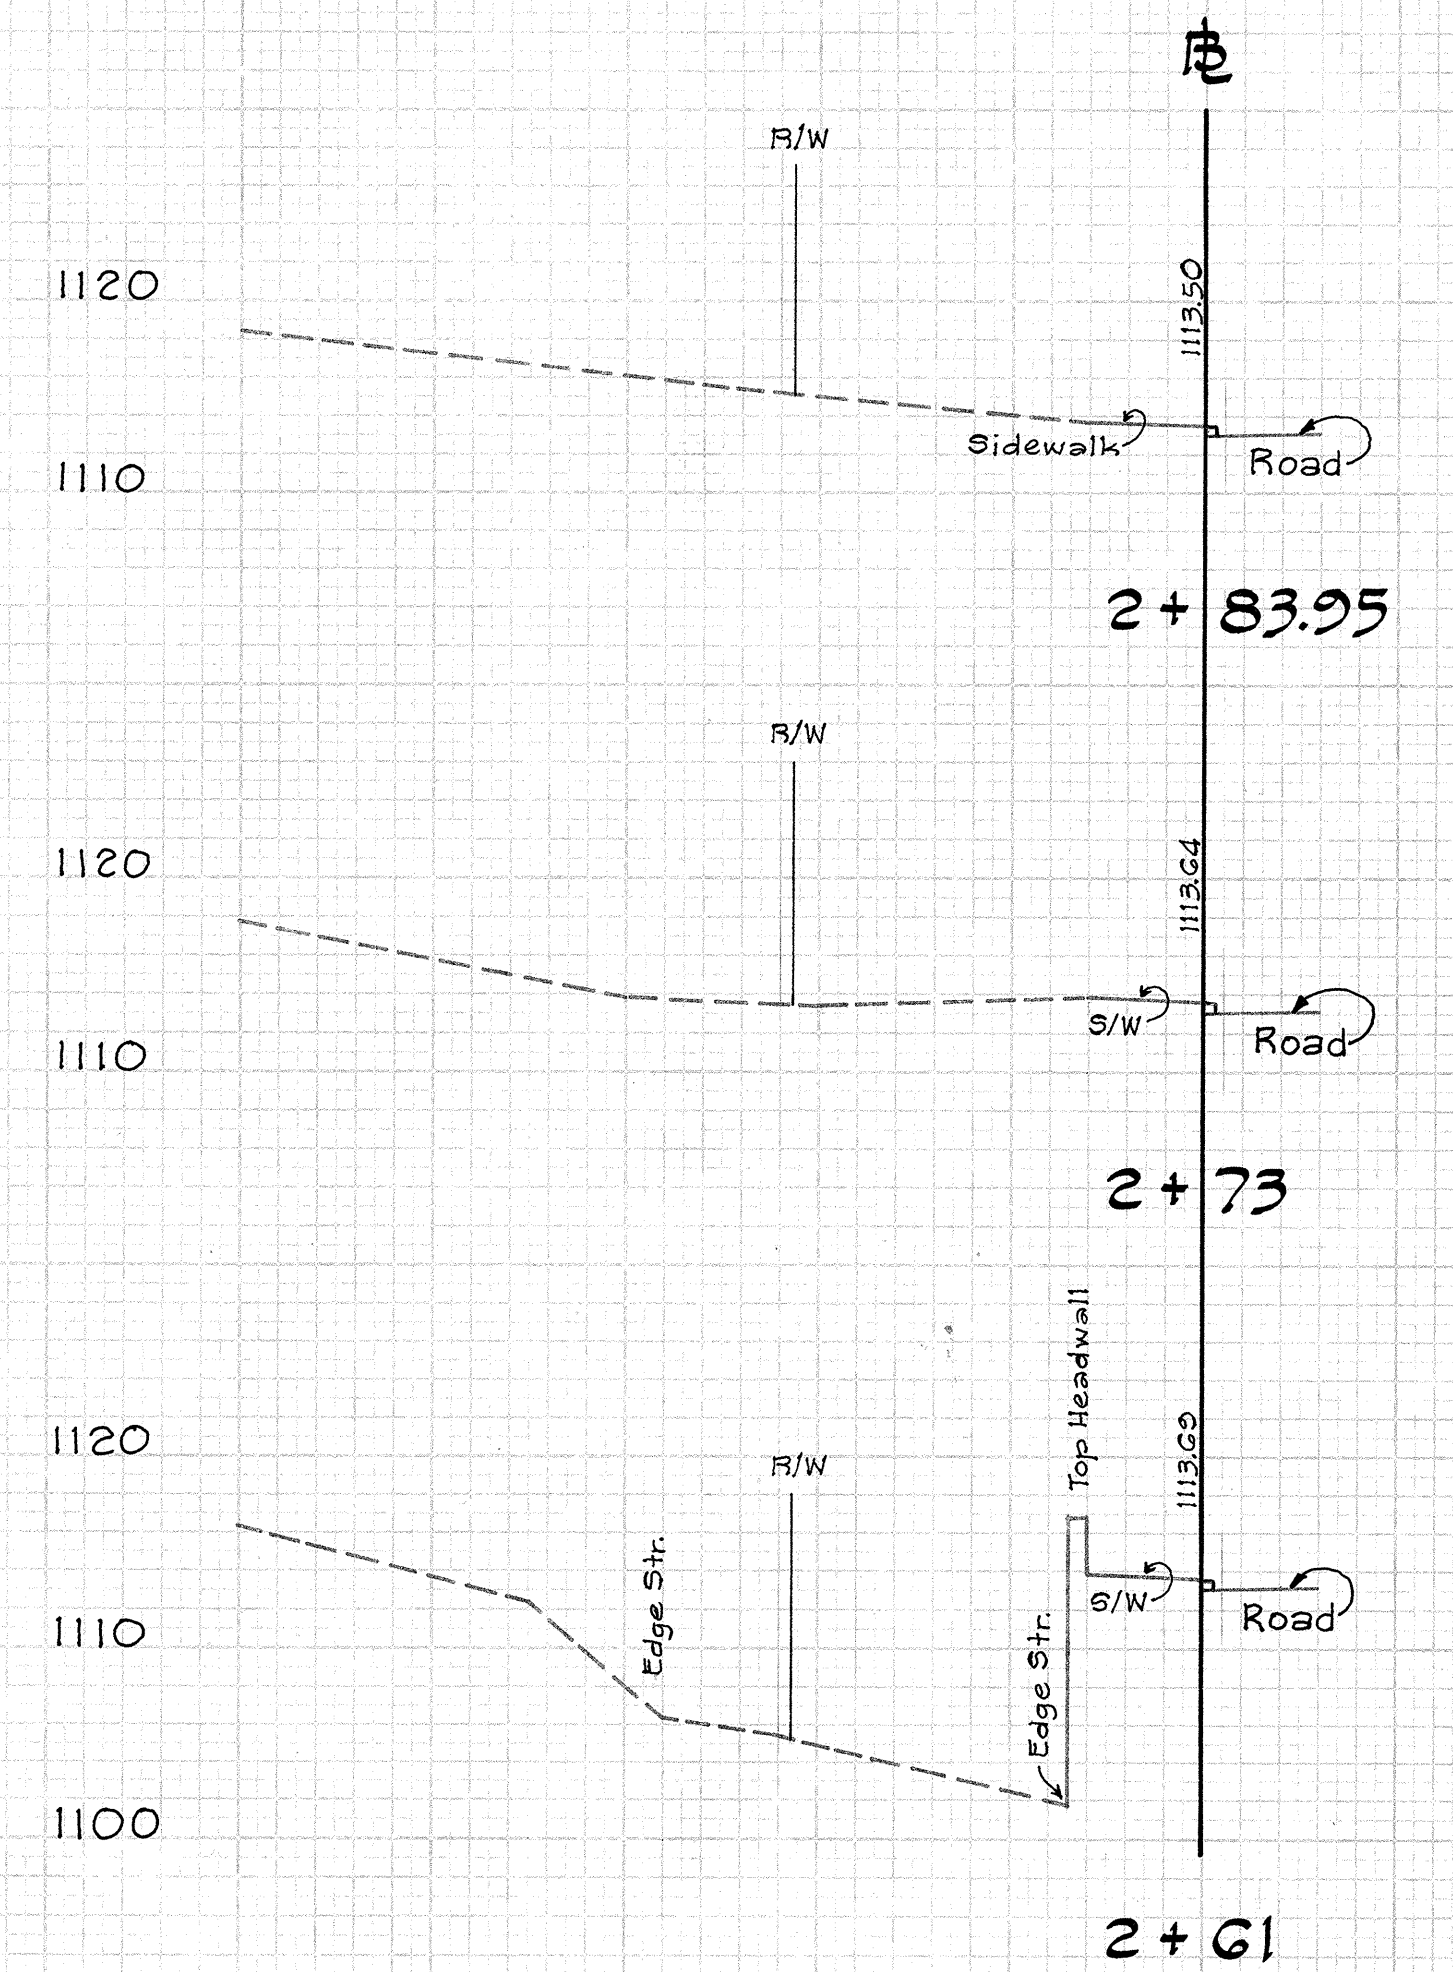
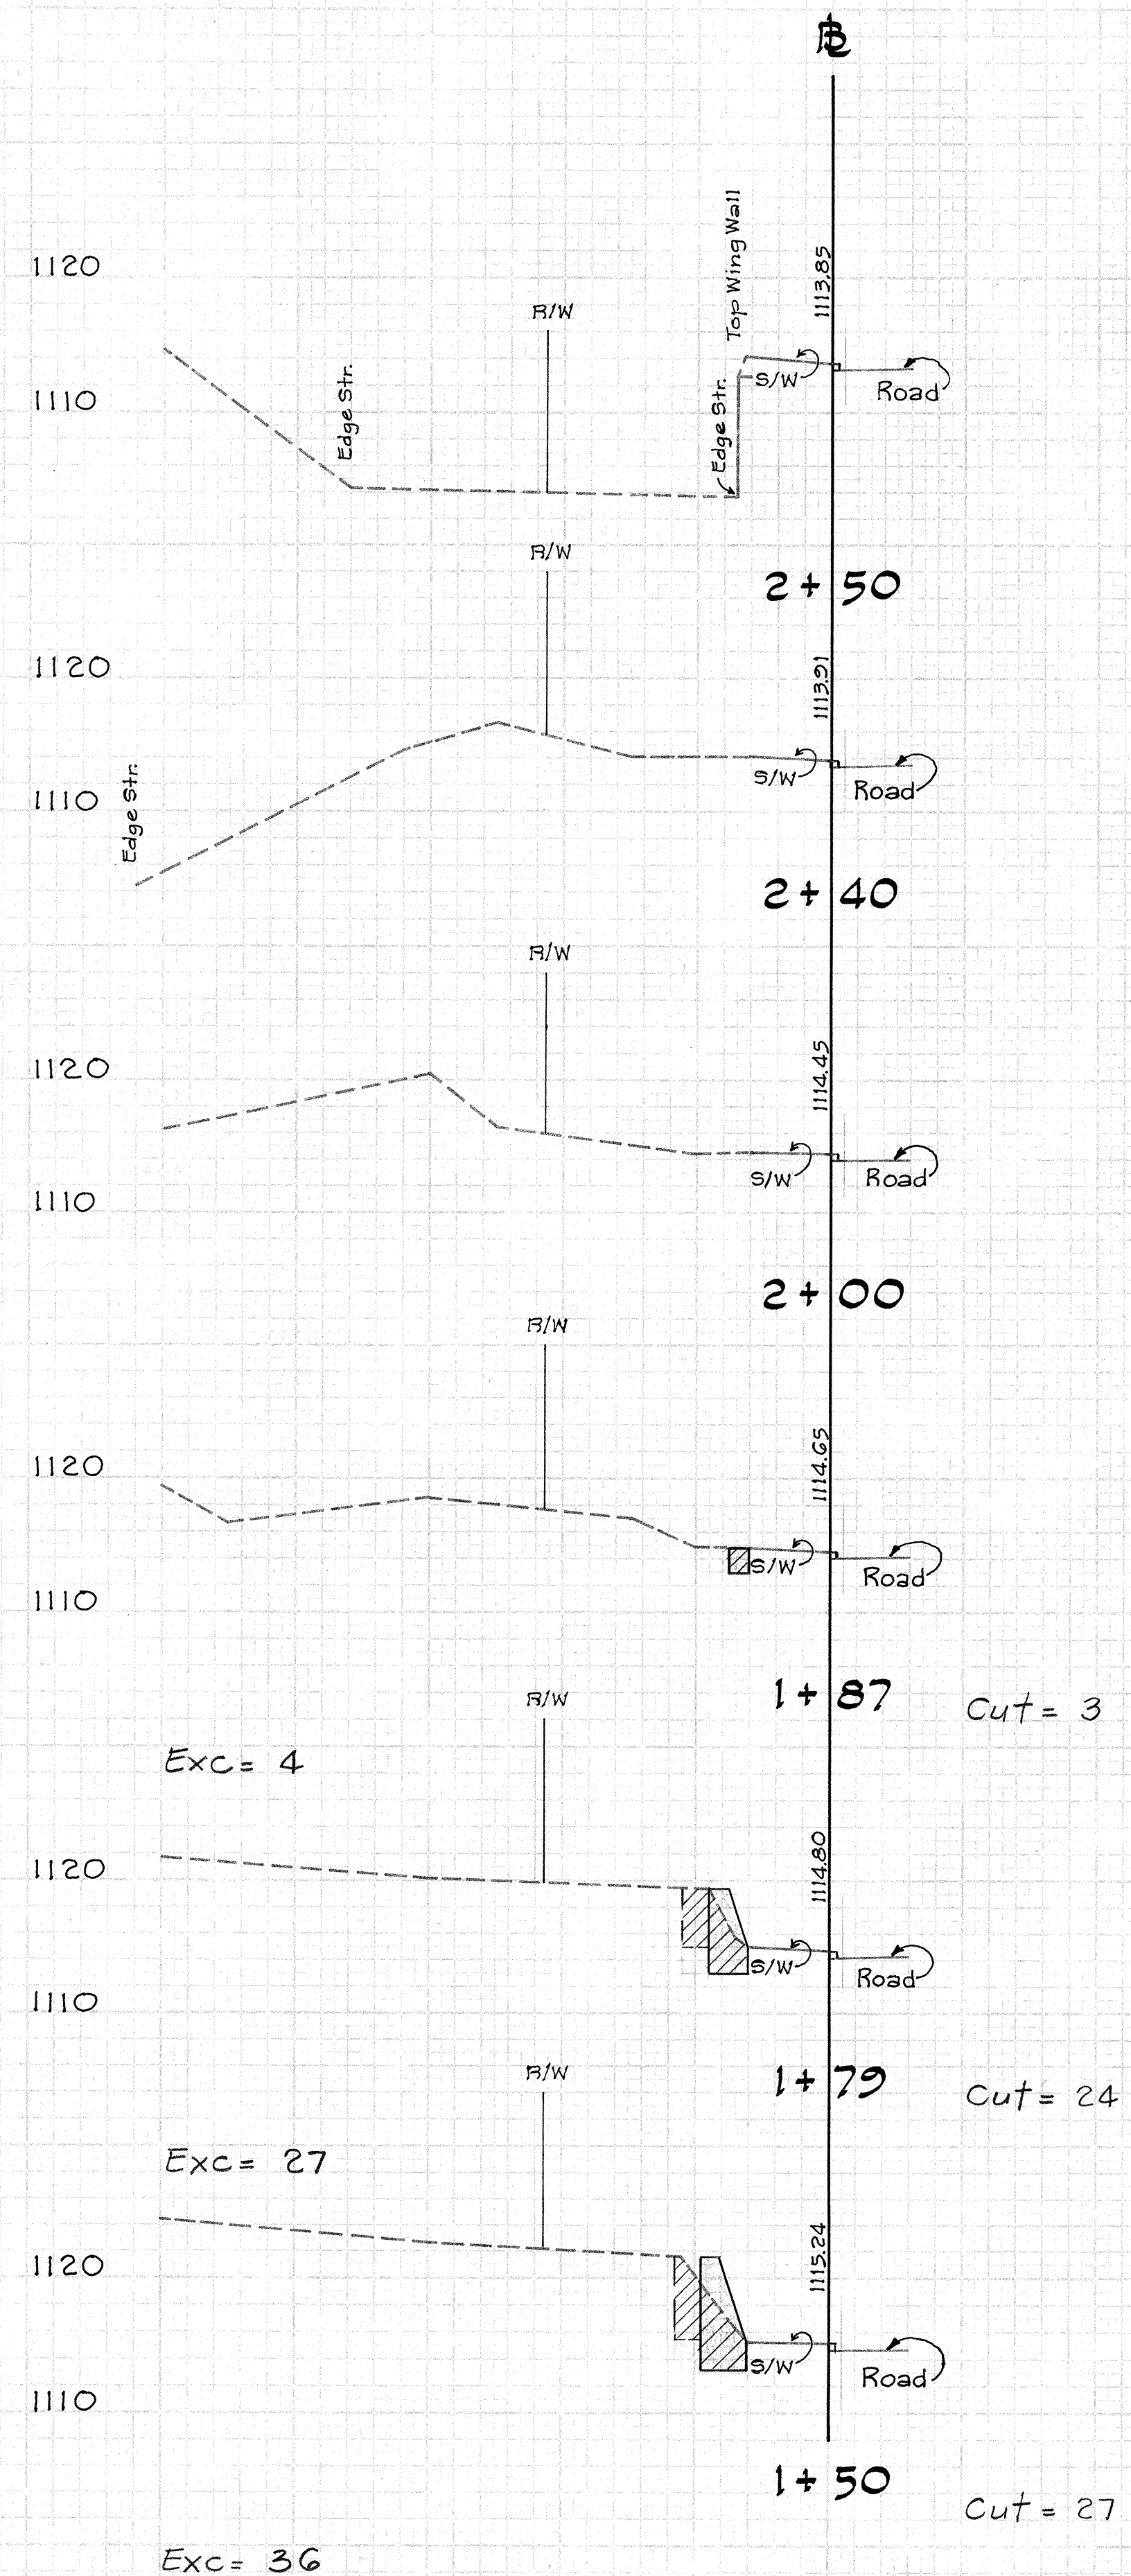


STATE	PROJ. NO.	FISCAL YEAR	SHEET NO.	TOTAL SHEETS
HAW.	240A-02-72 240A-01-T5	1975	4	7

DATE	BY	DATE	BY
9/74	9/74		
9/74	9/74		

DATE	BY	DATE	BY

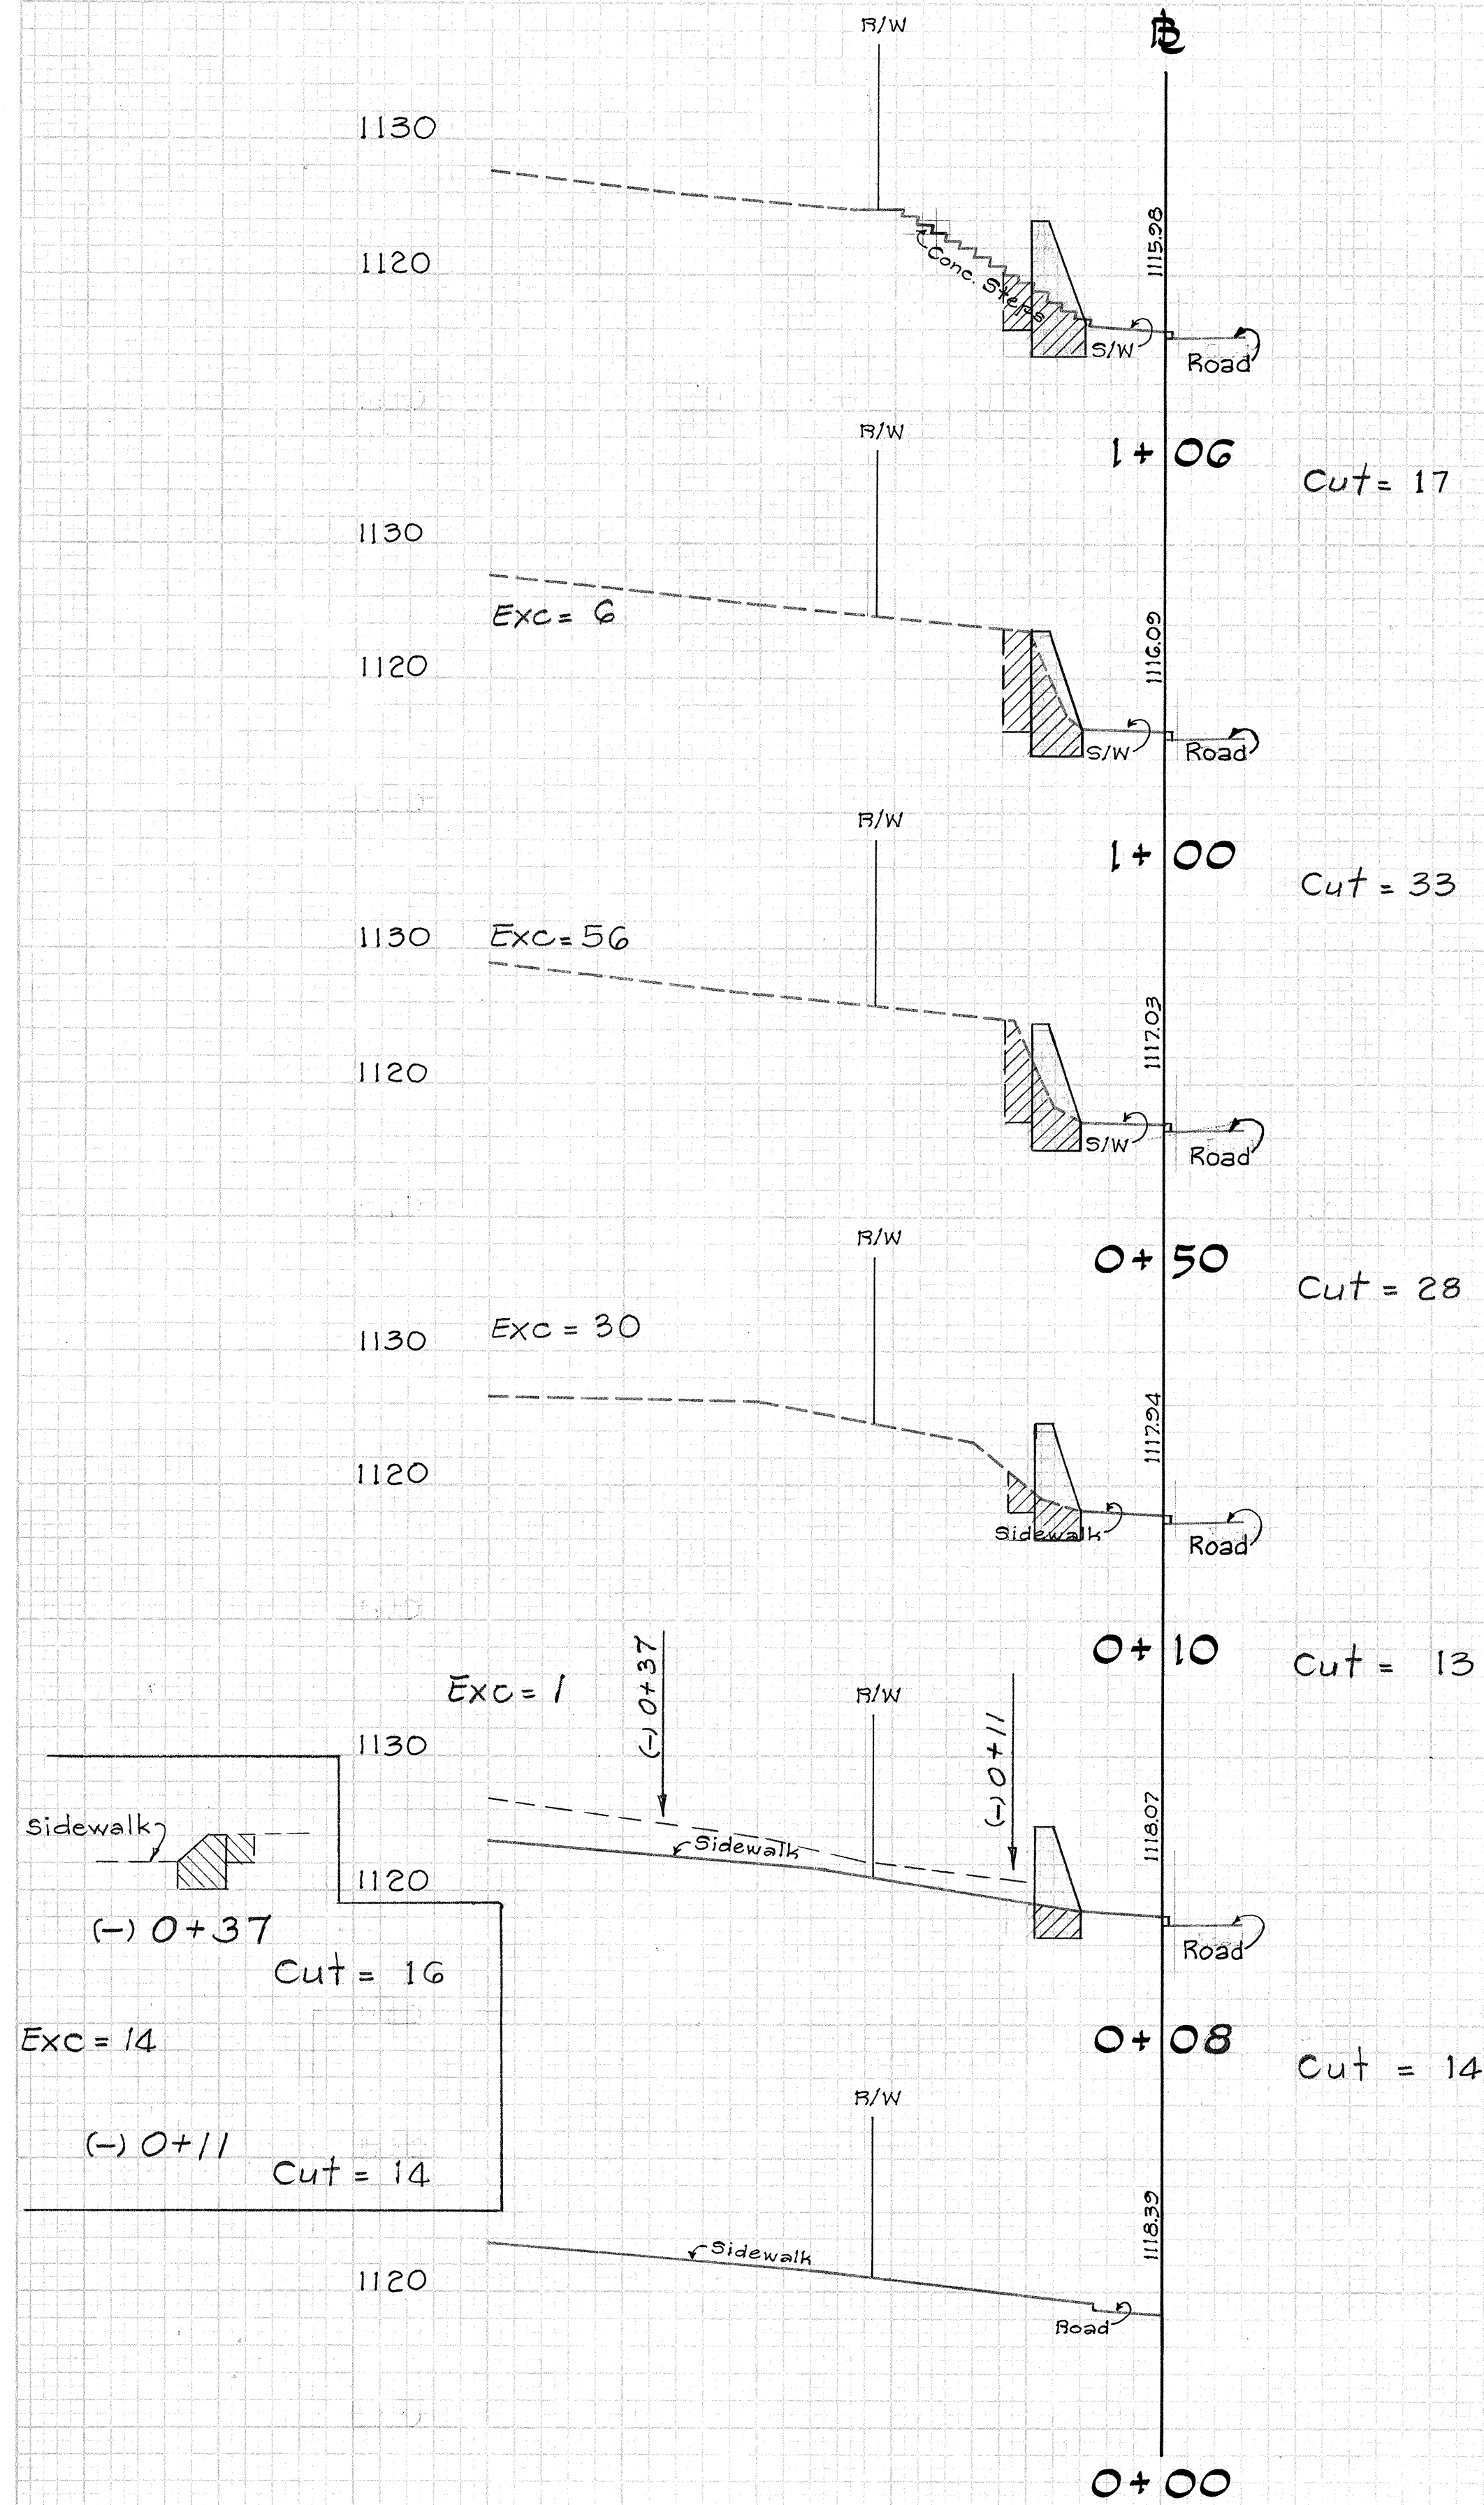

LOCATION "B"

Sheet No. 2 of 2 Sheets