
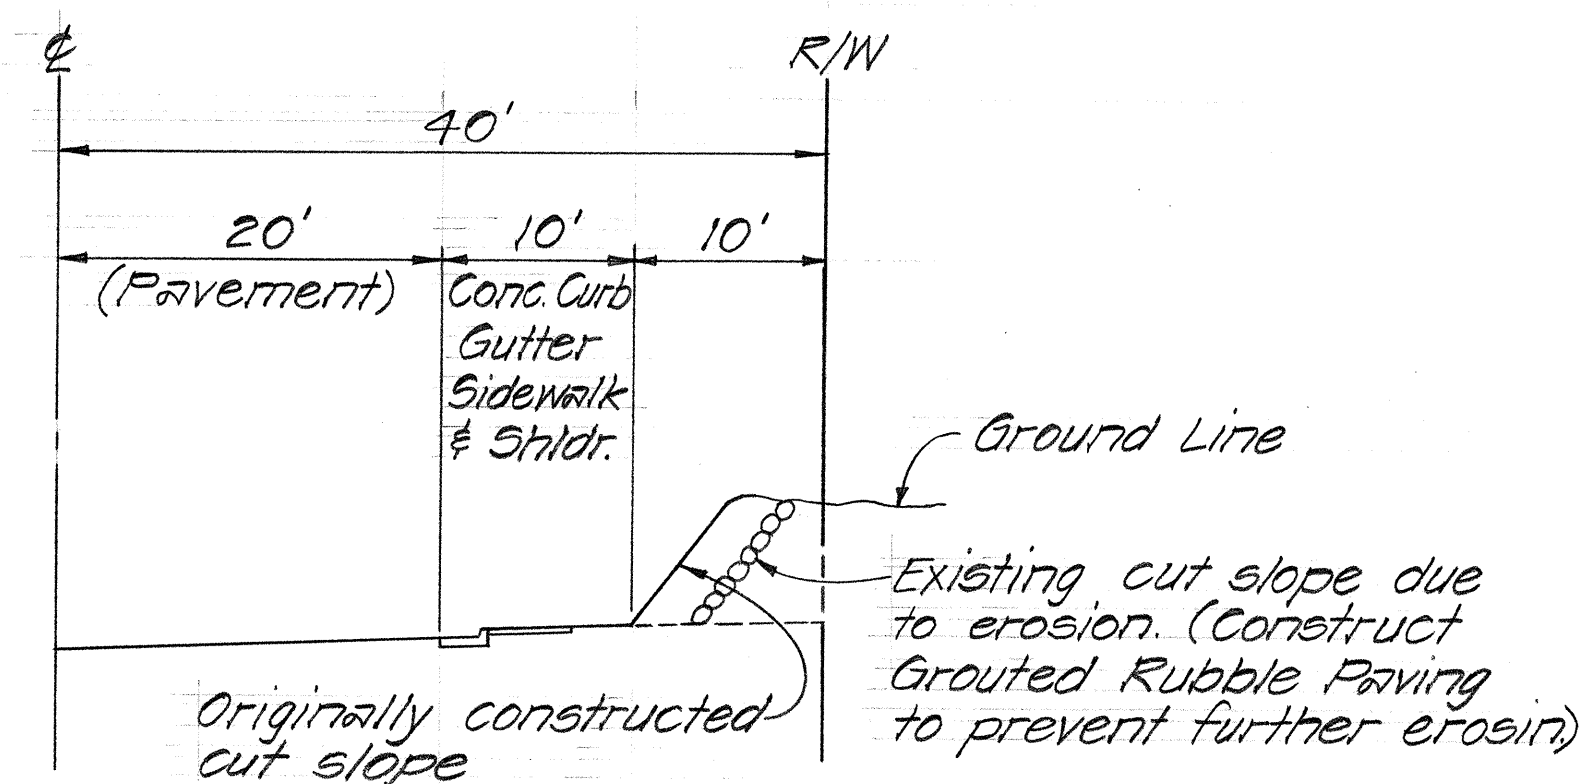


DIST. NO.	STATE	PROJ. NO.	FISCAL YEAR	SHEET NO.	TOTAL SHEETS
HAWAII	HAW.	240A-01-75	1975	C.O. 3 S-1	7

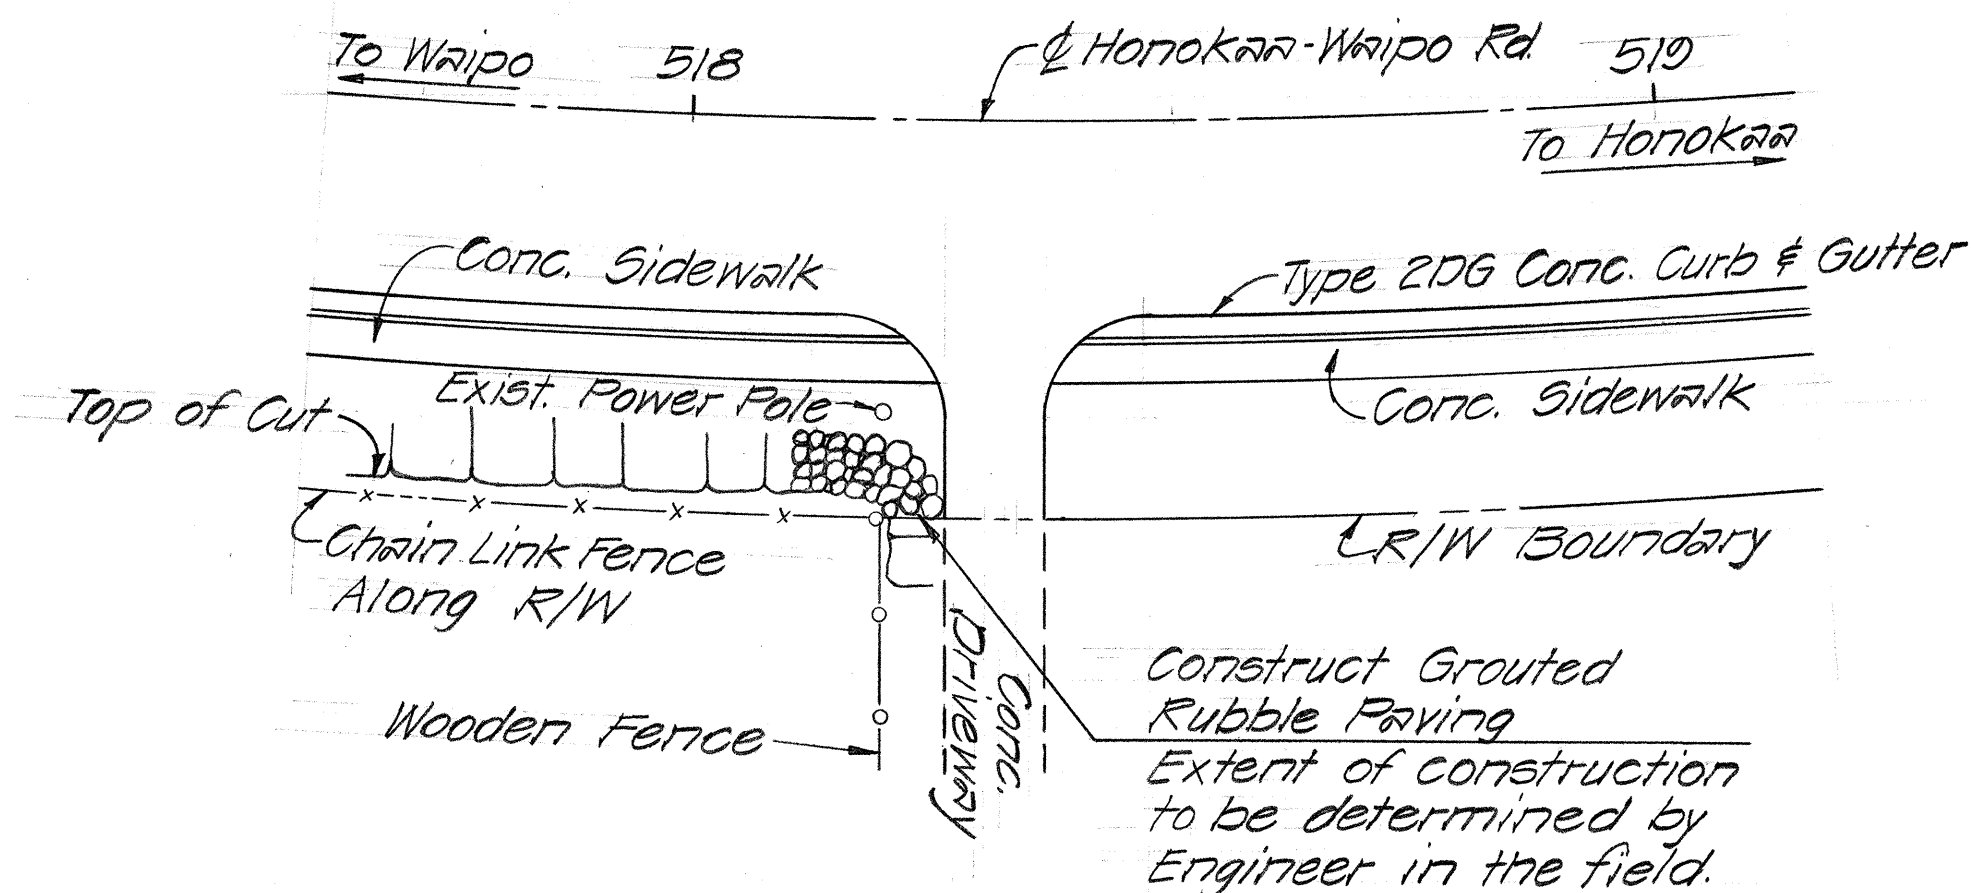

CONSTRUCTION OF GROUTED RUBBLE PAVING MAMANE ST. IMPROVEMENTS

PROJECT NO. 240A-01-75
TO ACCOMPANY C.C.O. NO. 1

STATE OF HAWAII DEPARTMENT OF TRANSPORTATION HIGHWAYS DIVISION	
PLAN & DETAIL OF GROUTED RUBBLE PAVING MAMANE ST. IMPROVEMENTS	
PROJECT NO. 240A-01-75	
Scale: As Noted	Date: Dec. 1975
SHEET NO. 1A OF 2 SHEETS	

C.O. 3 S-1

ORIGINAL PLAN	DATE
DESIGNED BY	
NOTED BY	
CHECKED BY	