
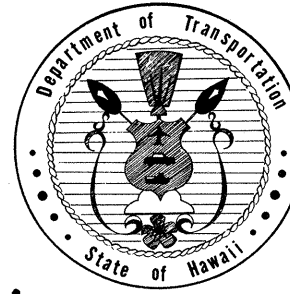


INDEX TO DRAWINGS	
SHEET NO.	DESCRIPTION
1	TITLE SHEET
2	PLAN-LOCATION "A"
3	PLAN-LOCATION "B"
4	CROSS SECTION - LOCATION "B"
5-7	STANDARD DETAILS
CO. 3 S-1	PLAN & DETAIL OF GROUTED RUBBLE PAVING (ADDED WORK)

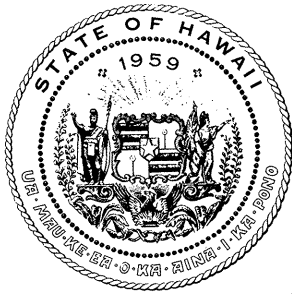

STATE OF HAWAII
DEPARTMENT OF TRANSPORTATION
HIGHWAYS DIVISION


"AS BUILT" PLANS FOR
MAMANE STREET
IMPROVEMENTS

PROJECT NOS. 240A-02-72 AND 240A-01-75

DISTRICT OF HAMAKUA
ISLAND OF HAWAII



GENERAL LOCATION PLAN
SCALE: 1" = 300'

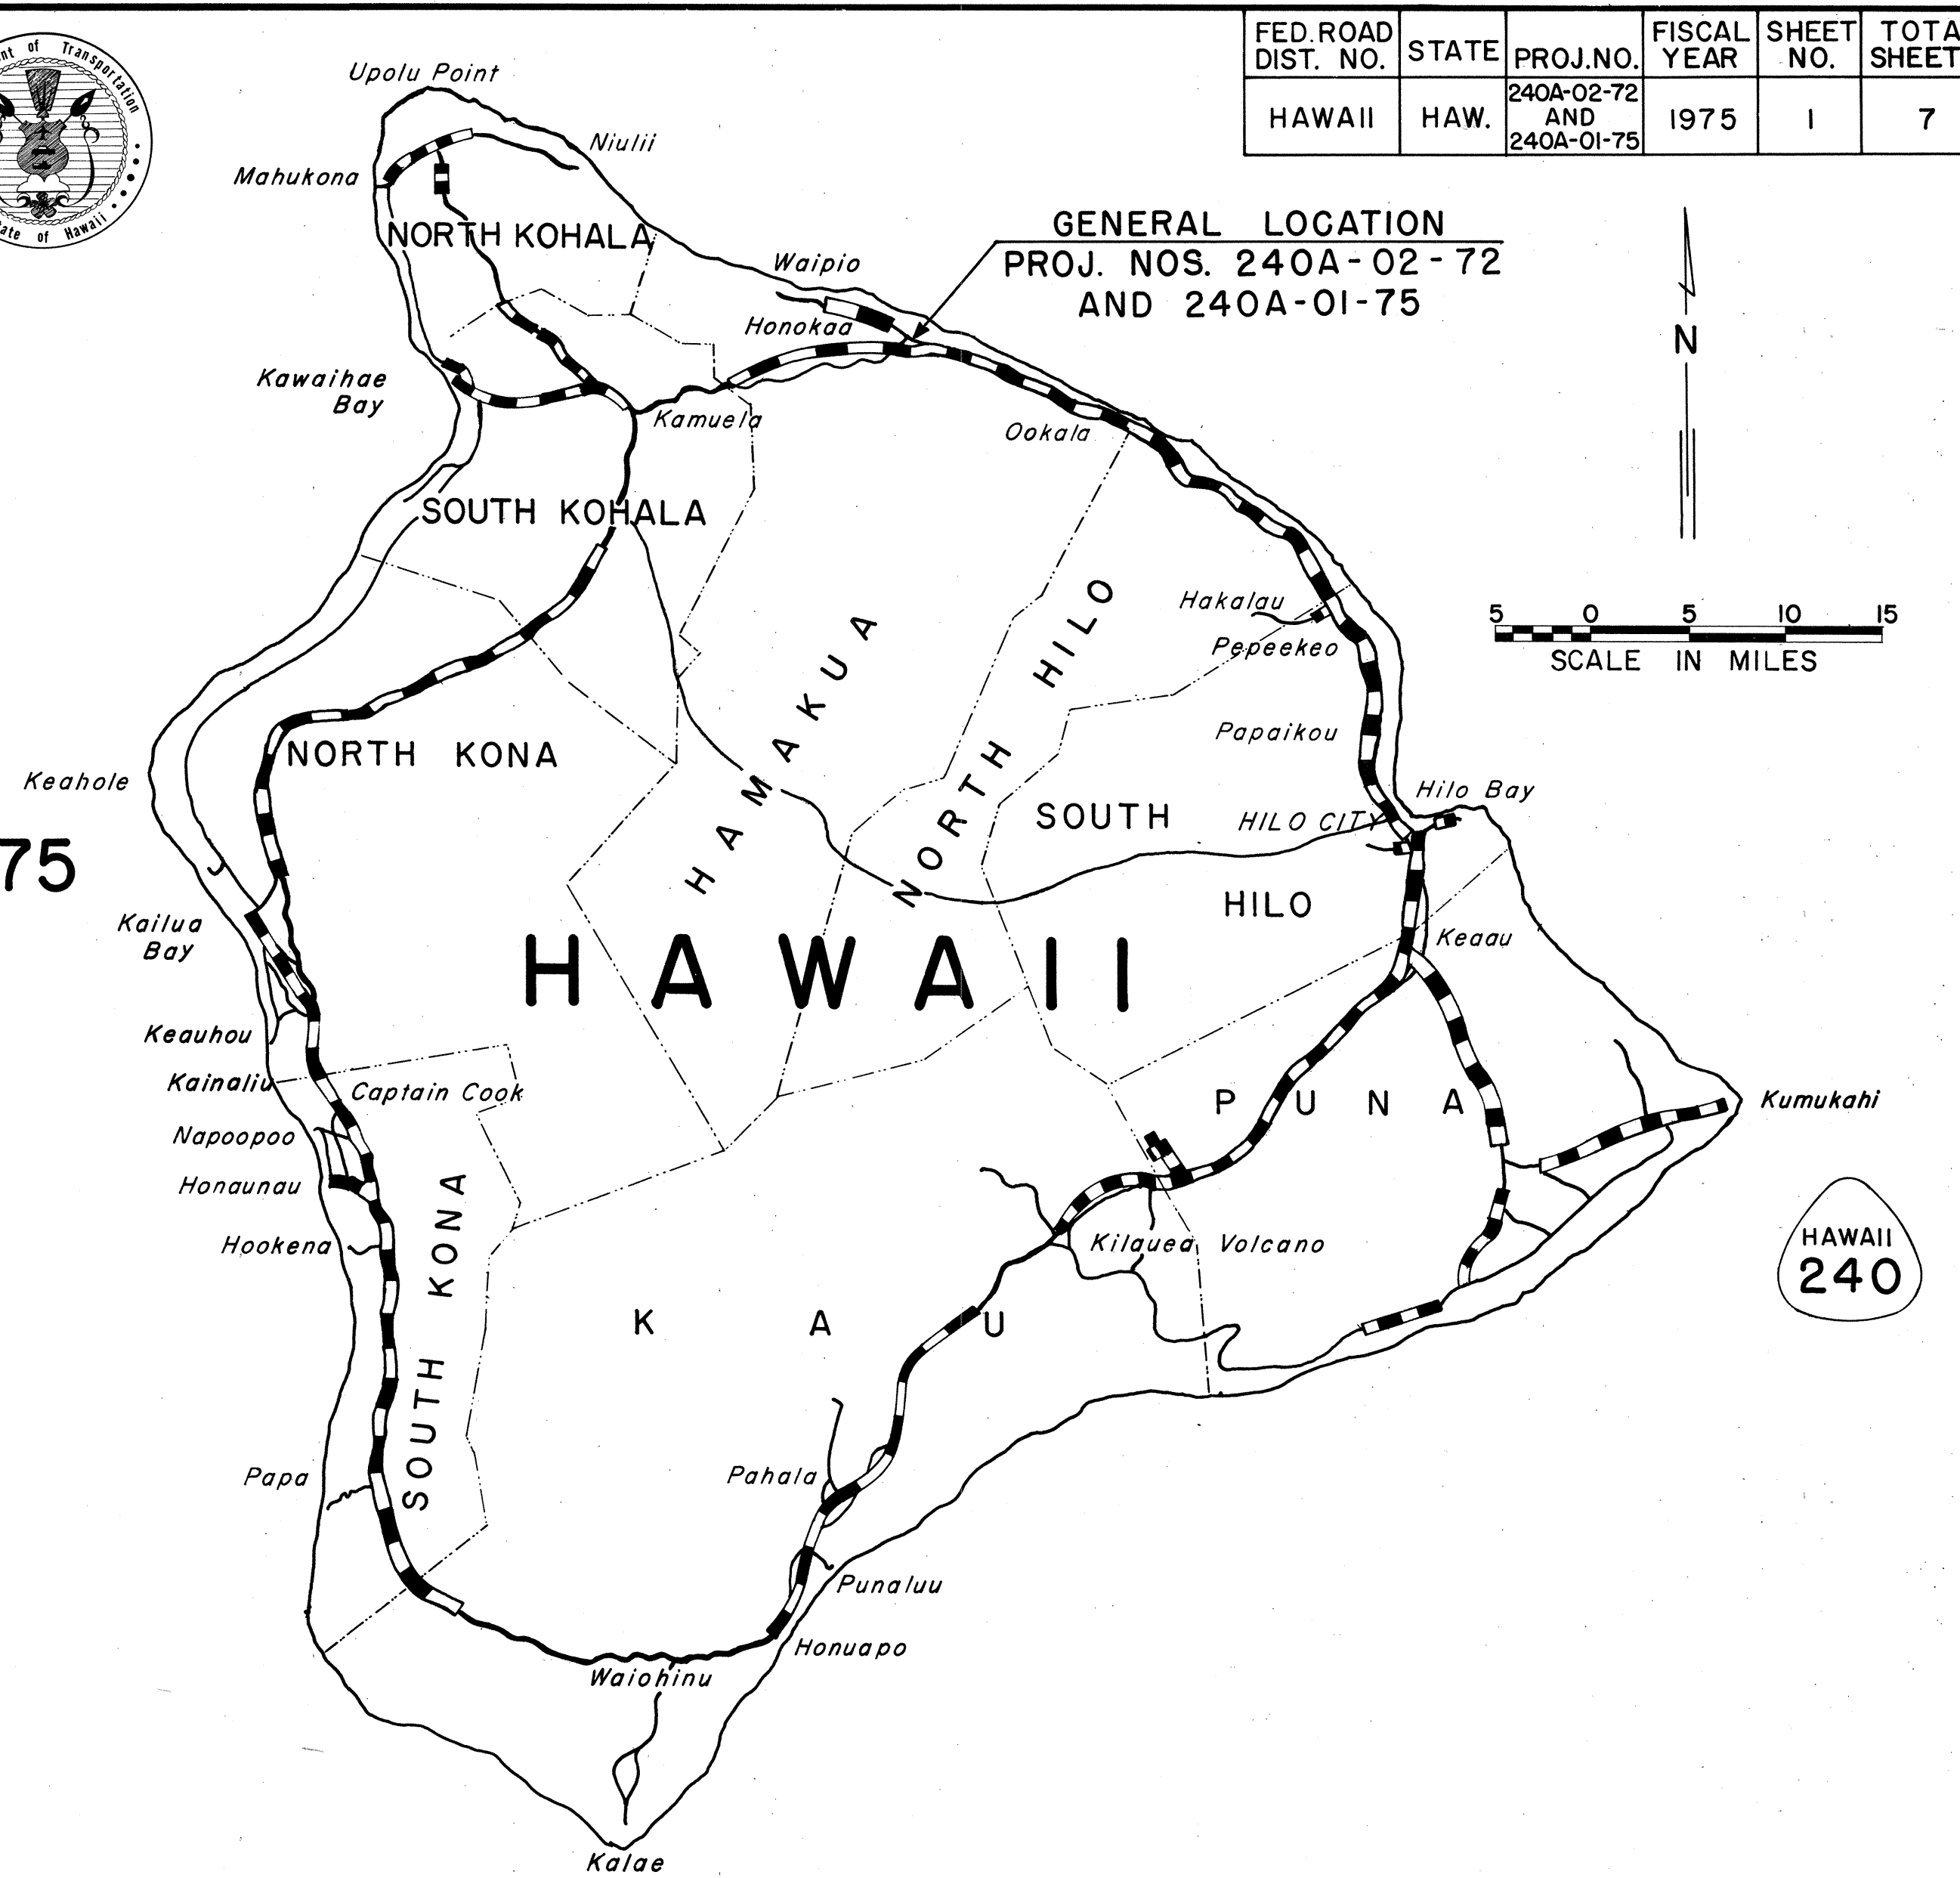

Federal Aid Projects Previously Constructed Or Under Construction

NOTE:
ALL CHANGES MADE DURING
CONSTRUCTION HAVE BEEN
INCORPORATED ON THESE PLANS
EXCEPT CHANGES IN THE THEORETICAL
QUANTITIES.

[Signature] 12-22-75
PROJECT ENGINEER DATE

DEPARTMENT OF TRANSPORTATION STATE OF HAWAII	
APPROVED:	
<i>E. Alvey Wright</i>	5/23/75
DIR. OF TRANSPORTATION	DATE

HAWAII DISTRICT
DESIGNED BY
Ronald F. Tsuzuki
P. S. & E. BY
548-2456
May, 1975
DATE