
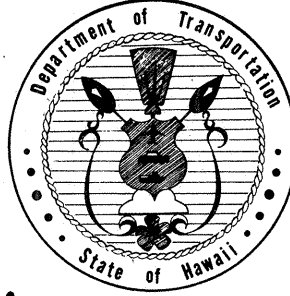


INDEX TO DRAWINGS	
SHEET NO.	DESCRIPTION
1	TITLE SHEET
2	PLAN, CROSS-SECTIONS & GRP WALL DETAIL

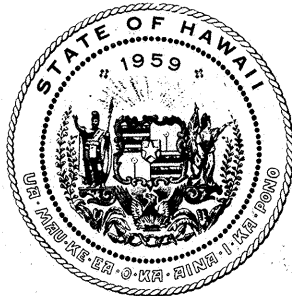


STATE OF HAWAII
DEPARTMENT OF TRANSPORTATION
HIGHWAYS DIVISION

"AS BUILT" PLANS FOR

HONOKAA - WAIPIO ROAD STABILIZATION AND SLOPE PROTECTION

PROJECT No. 240A-02-76
DISTRICT OF HAMAKUA
ISLAND OF HAWAII

FED. ROAD DIST. NO.	STATE	PROJ. NO.	FISCAL YEAR	SHEET NO.	TOTAL SHEETS
HAWAII	HAW.	240A-02-76	'76	1	2

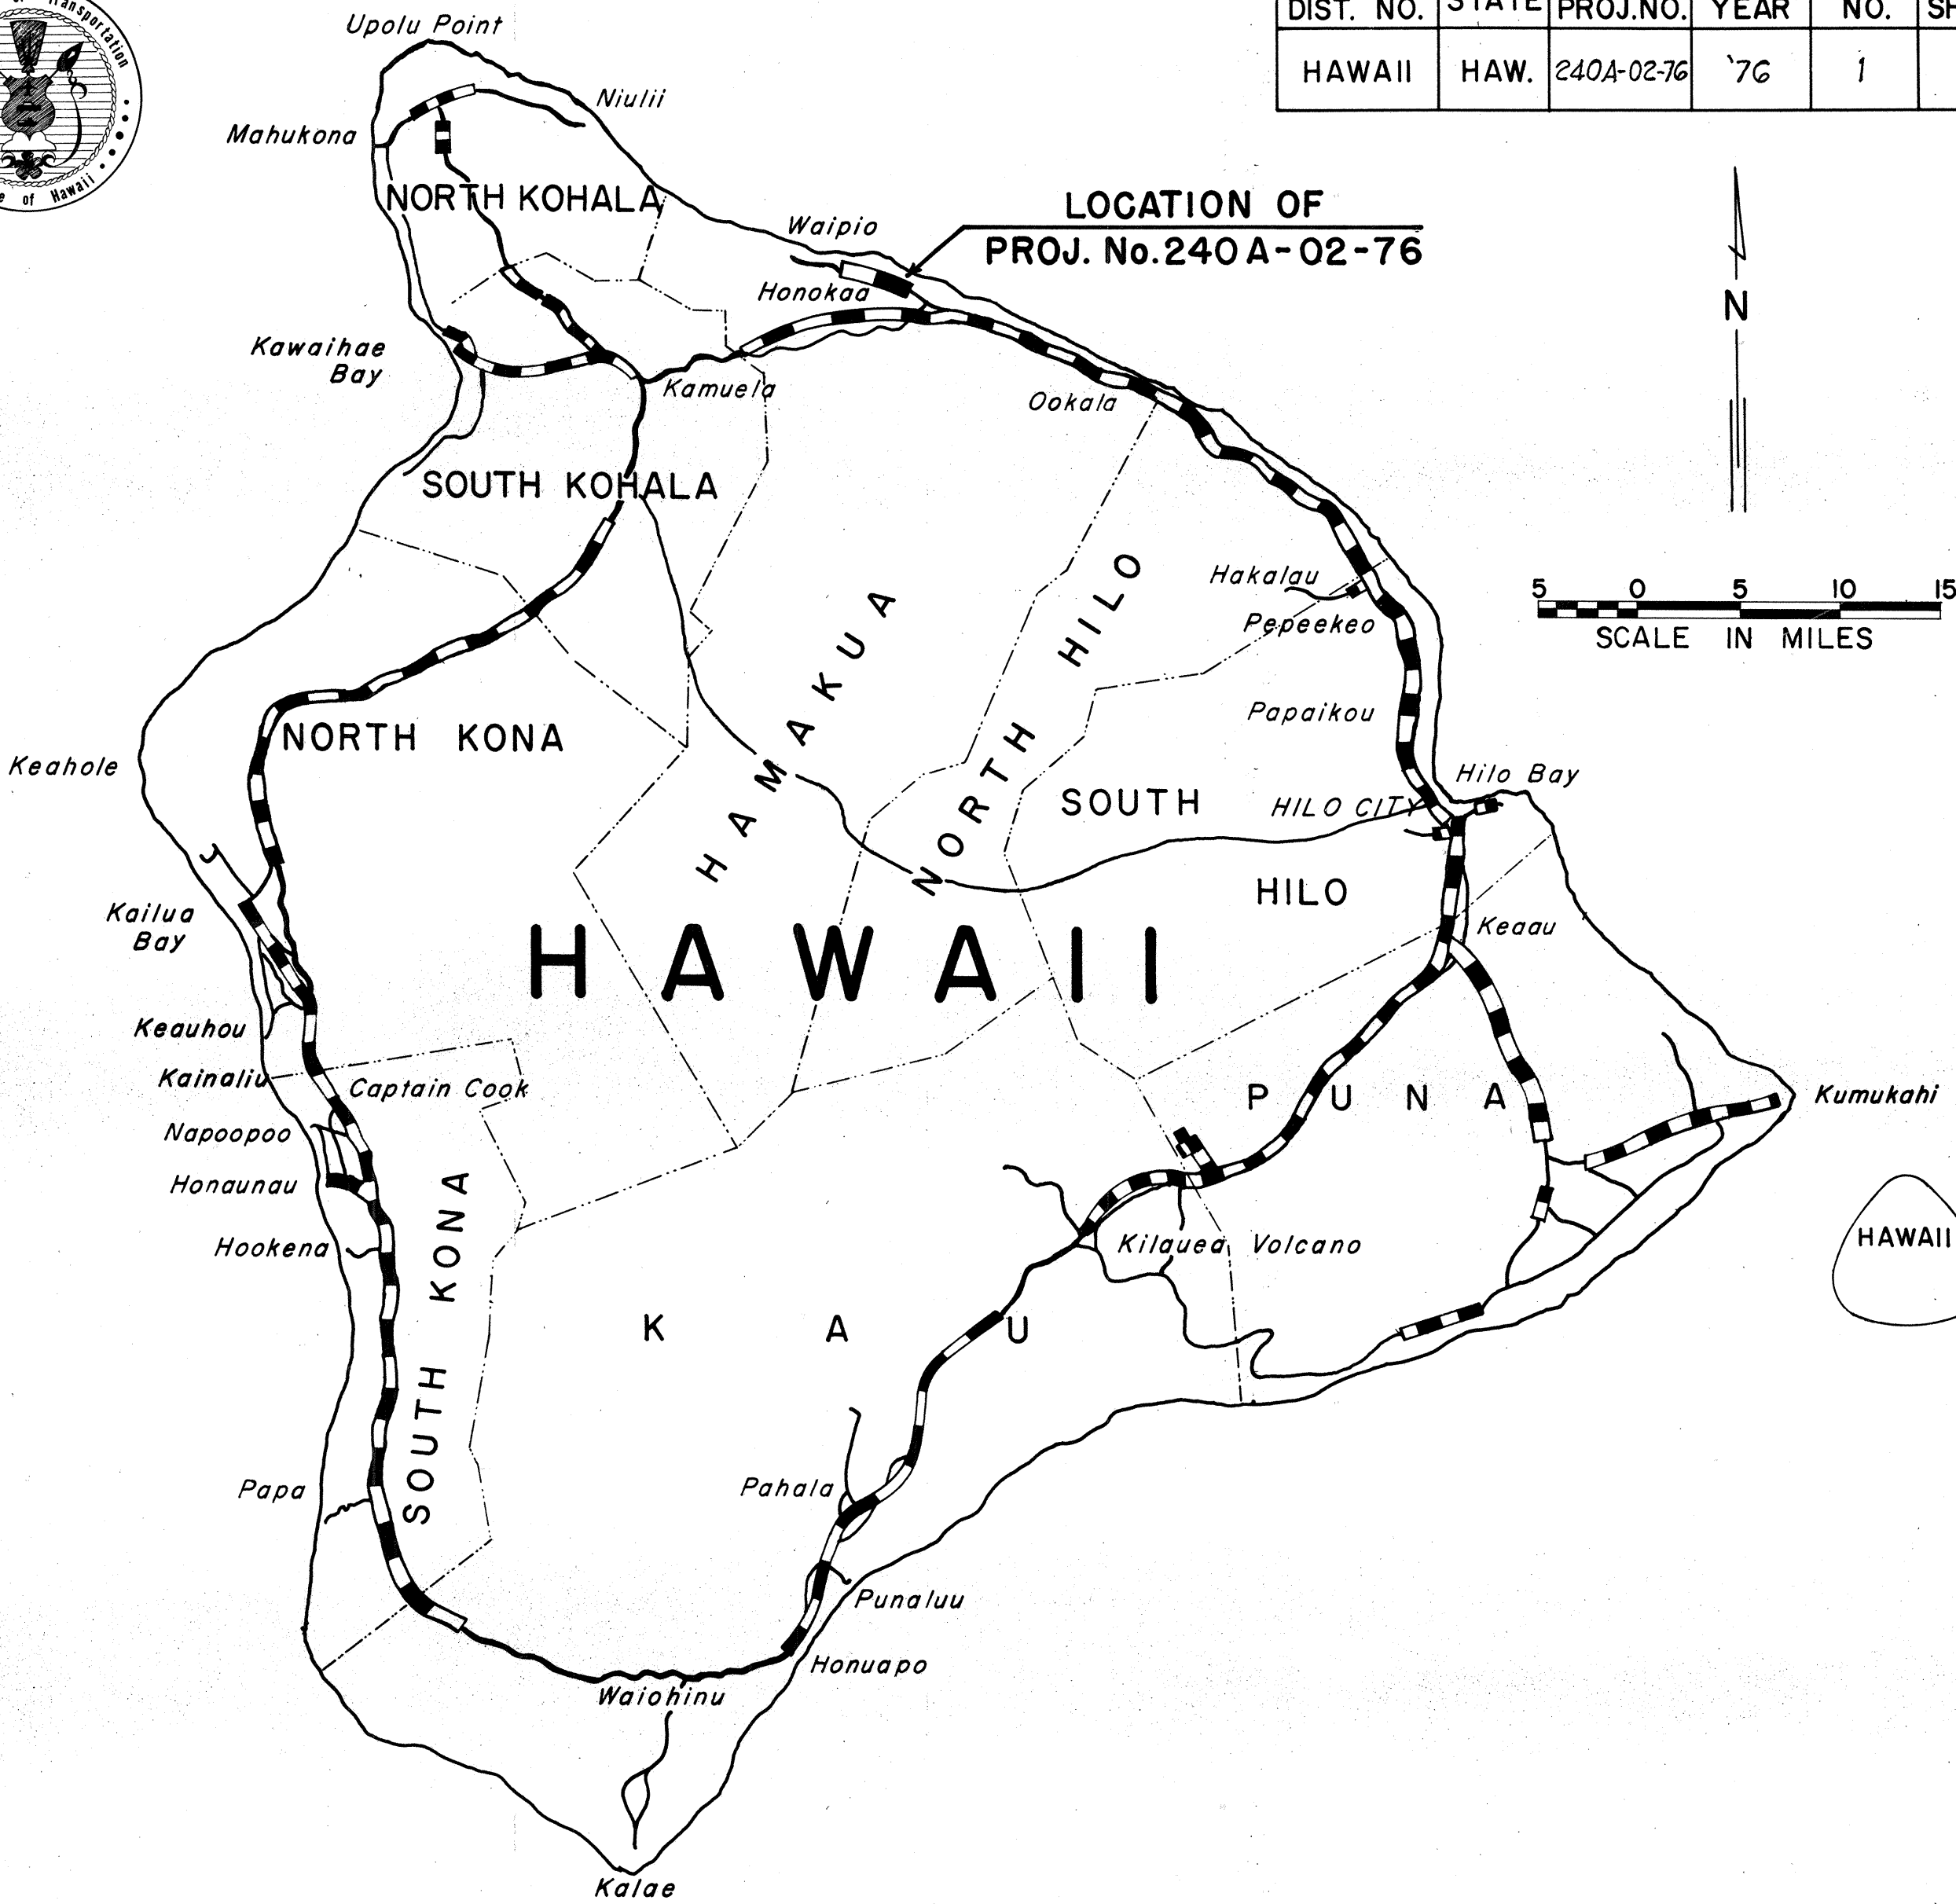

Federal Aid Projects Previously Constructed Or Under Construction

GENERAL LOCATION MAP

NO CHANGES WERE MADE DURING CONSTRUCTION ON THESE PLANS EXCEPT CHANGES IN THE ORIGINAL THEORETICAL QUANTITIES. FOR ACTUAL QUANTITIES, REFER TO PROJECT LEDGER AND/OR COMPUTATION BOOK.

Benge Kridani
RESIDENT ENGINEER

4-28-82
DATE

DEPARTMENT OF TRANSPORTATION
STATE OF HAWAII


APPROVED:

R. Higashimura

4/13/76

for DIR. OF TRANSPORTATION

DATE

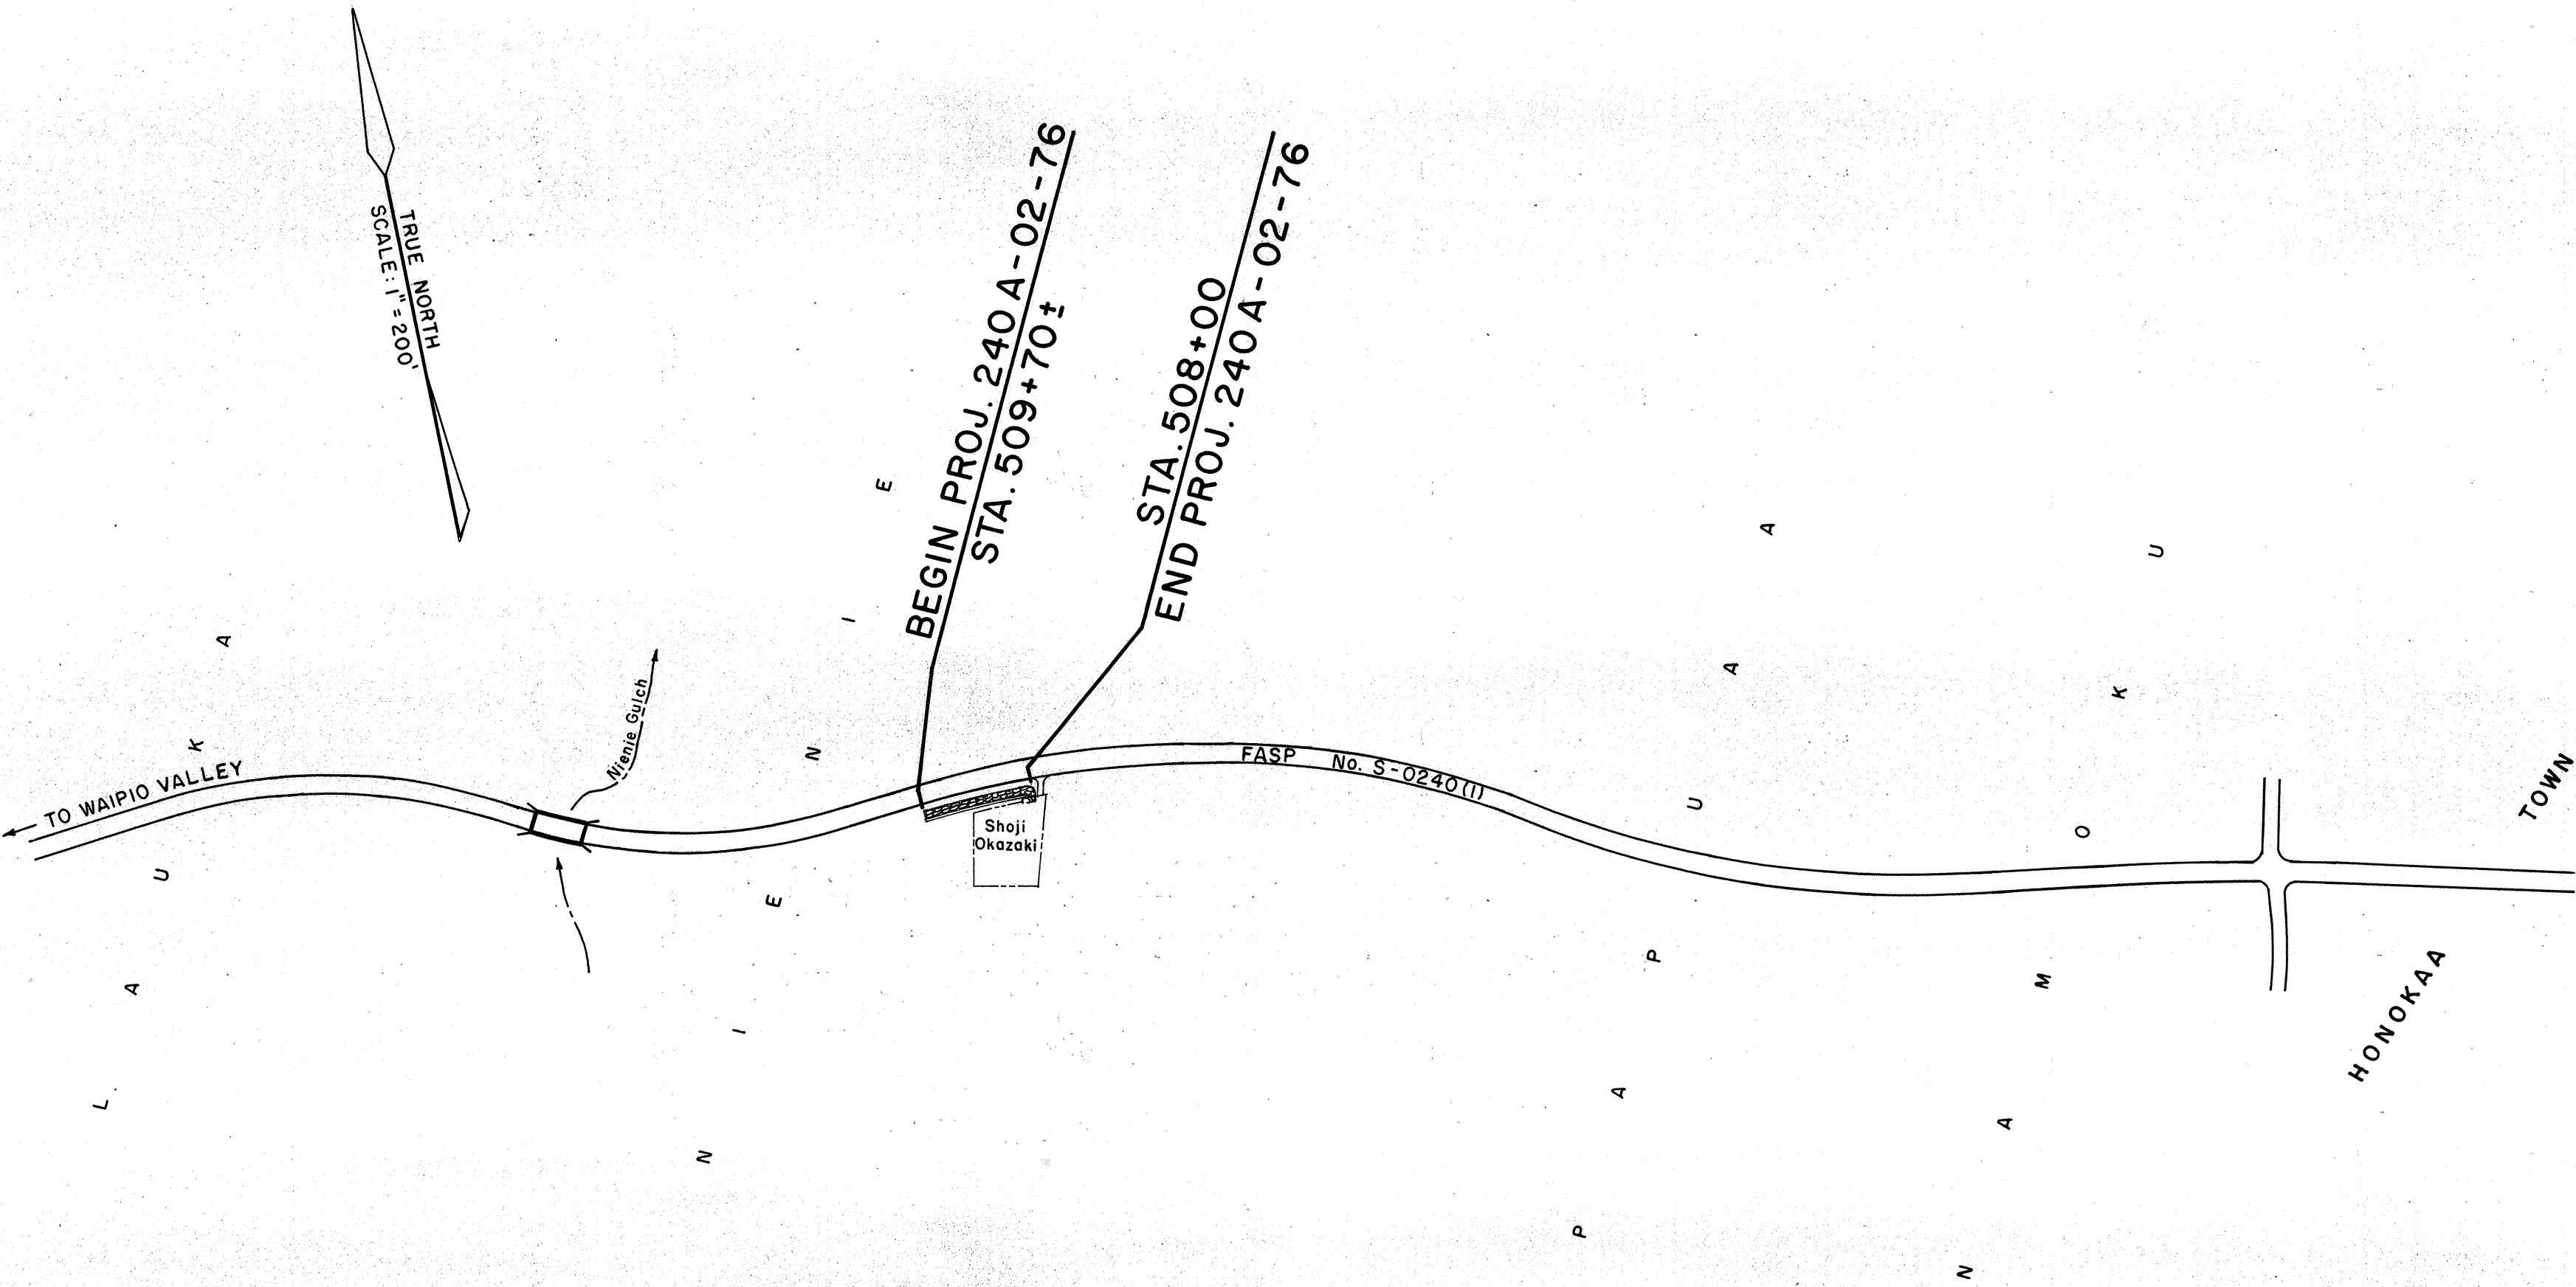

LOCATION PLAN
SCALE: 1" = 200'

HAWAII DISTRICT DESIGNED BY *R. Tezuka* 548-2456 Mar. 1976
P. S. & E. BY PHONE DATE