



FED. ROAD DIST. NO.	STATE	PROJ. NO.	FISCAL YEAR	SHEET NO.	TOTAL SHEETS
HAWAII	HAW.	240A-01-71 UNIT 1	1977	31	55

Exc. 334
Emb. 0

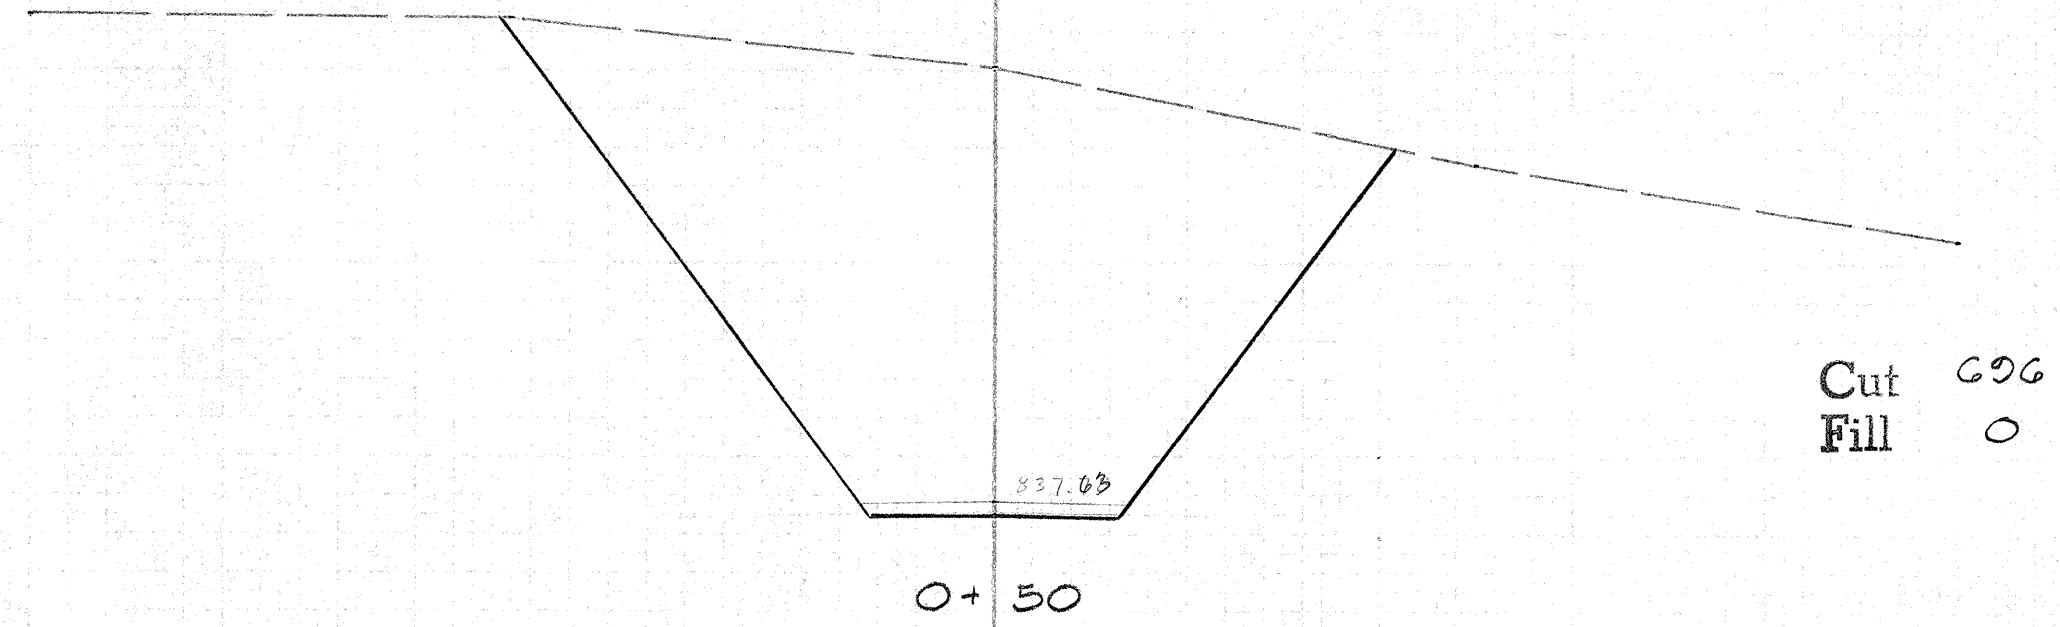


Cut 606
Fill 0

Exc. 18
Emb. 0

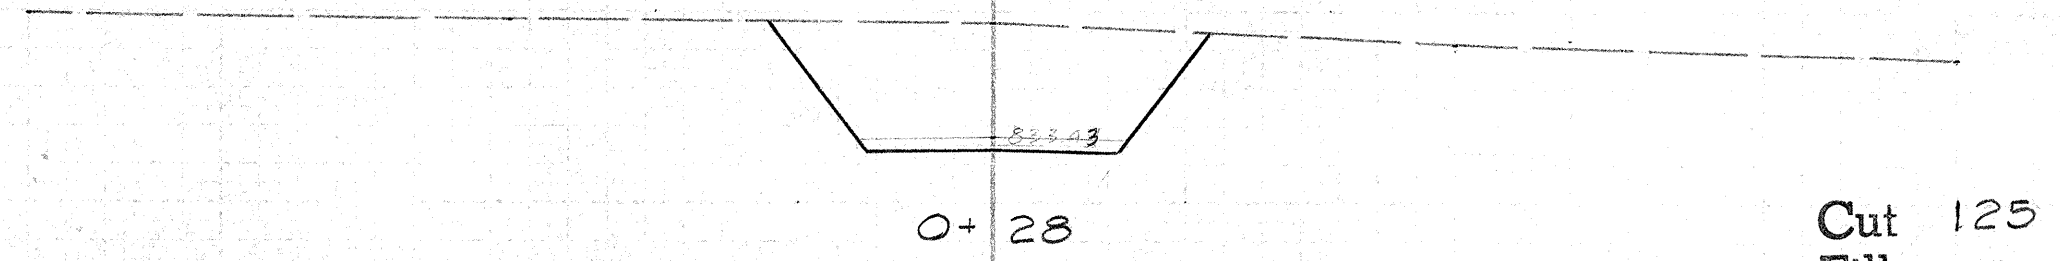


Cut 125
Fill 0

Exc. 1
Emb. 0

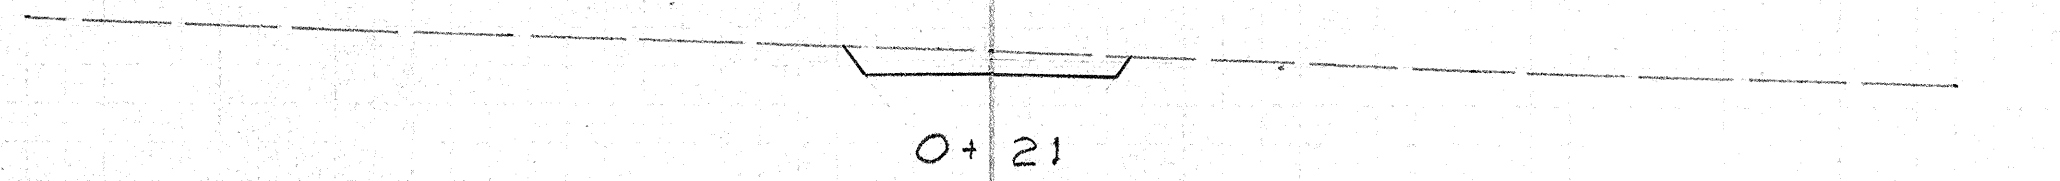


Cut 14
Fill 0

Exc. 2
Emb. 0

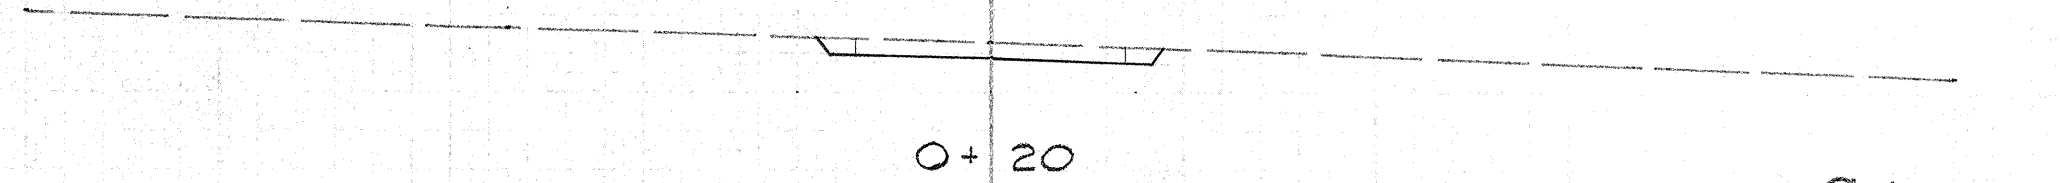


Cut 15
Fill 0

Exc. 5
Emb. 0

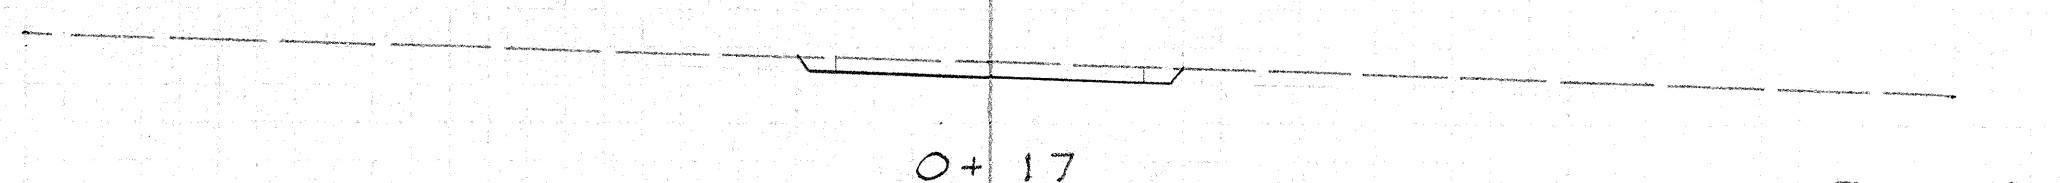

Cut 18
Fill 0


Exc. 0
Emb. 0

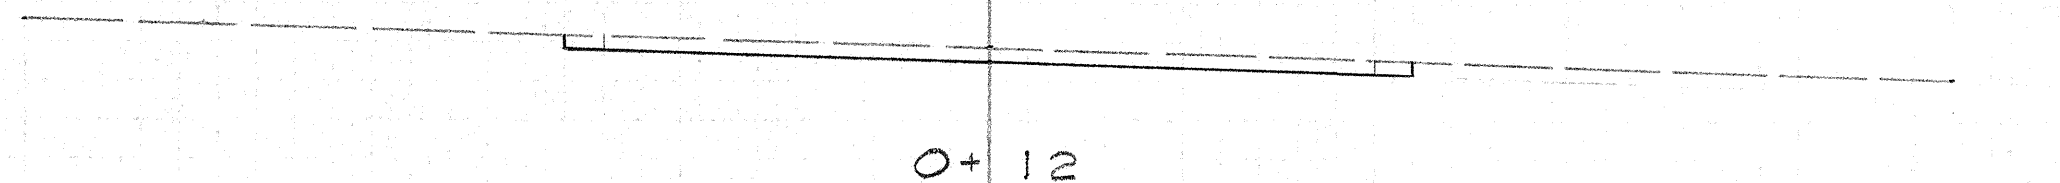

Cut 37
Fill 0


0+00

Exc. 7
Emb. 0

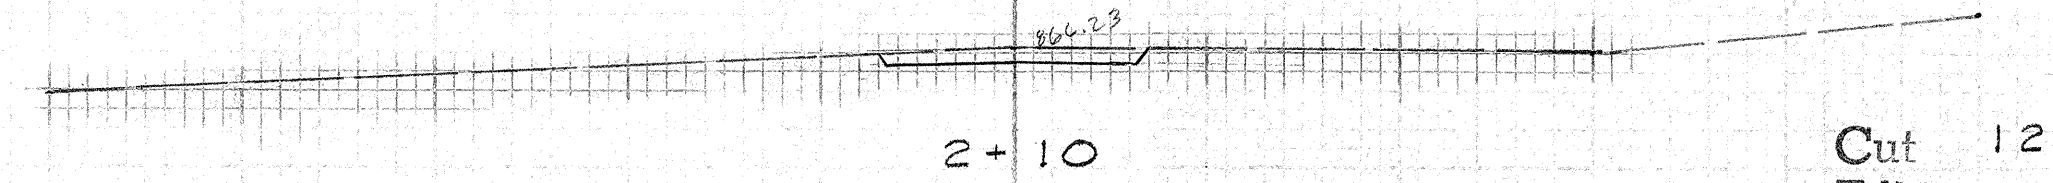


Cut 12
Fill 0

Exc. 223
Emb. 0

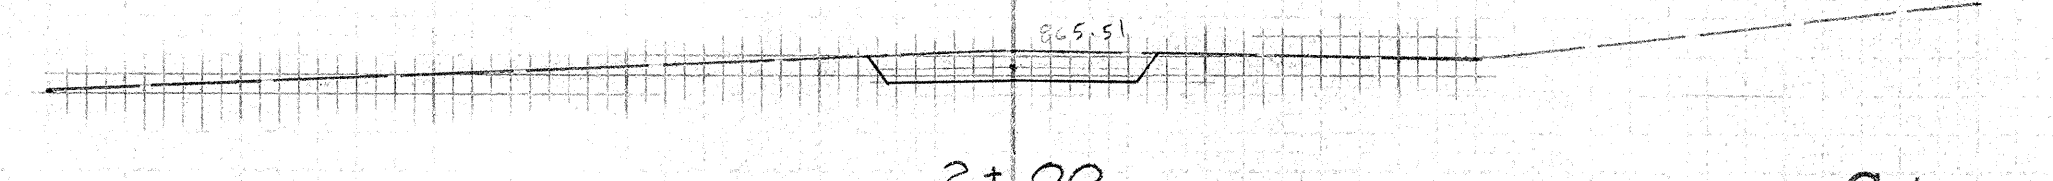


Cut 24
Fill 0

Exc. 604
Emb. 0

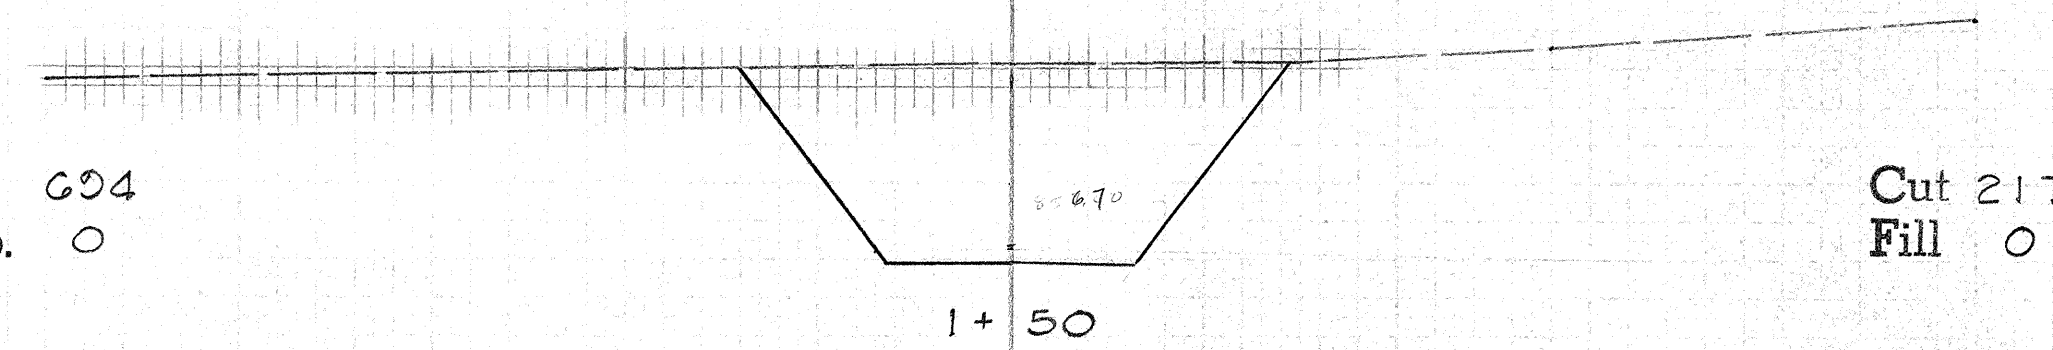


Cut 217
Fill 0

Exc. 213
Emb. 0

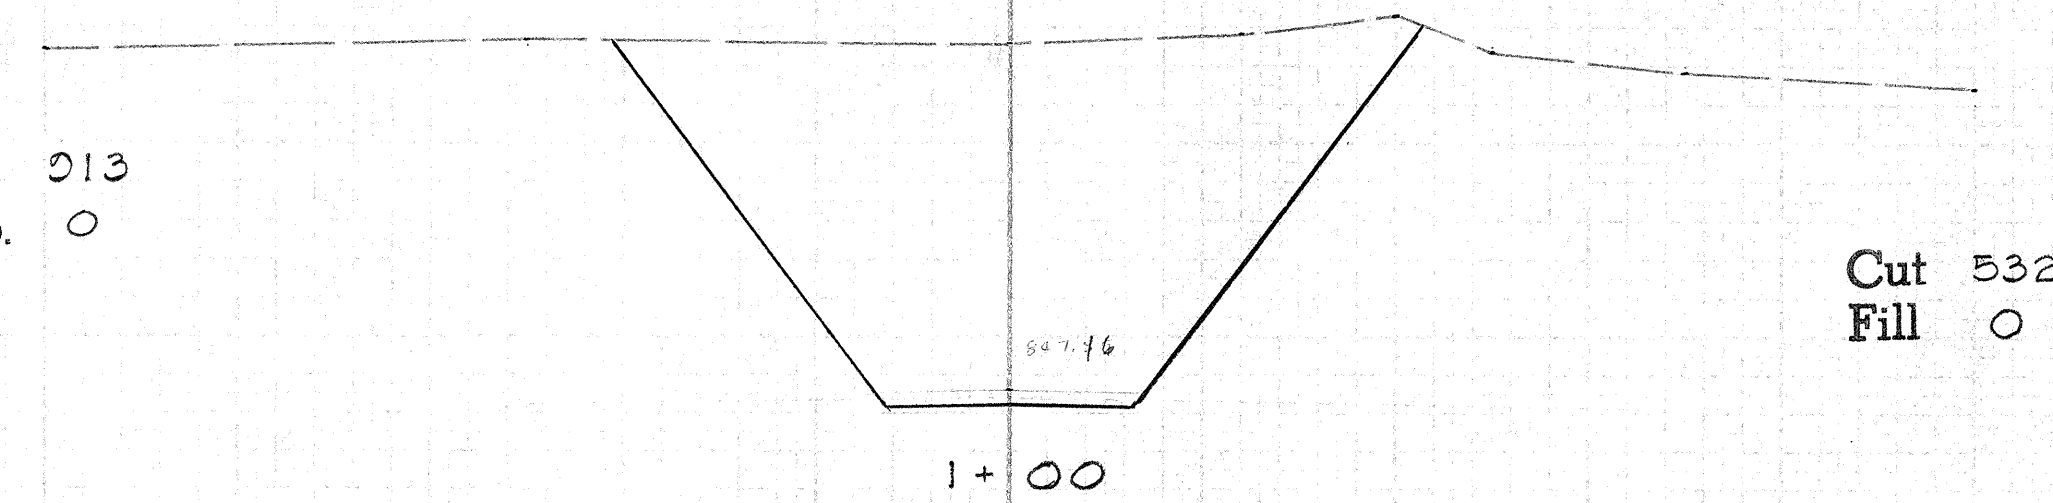

Cut 532
Fill 0

Exc. 250
Emb. 0

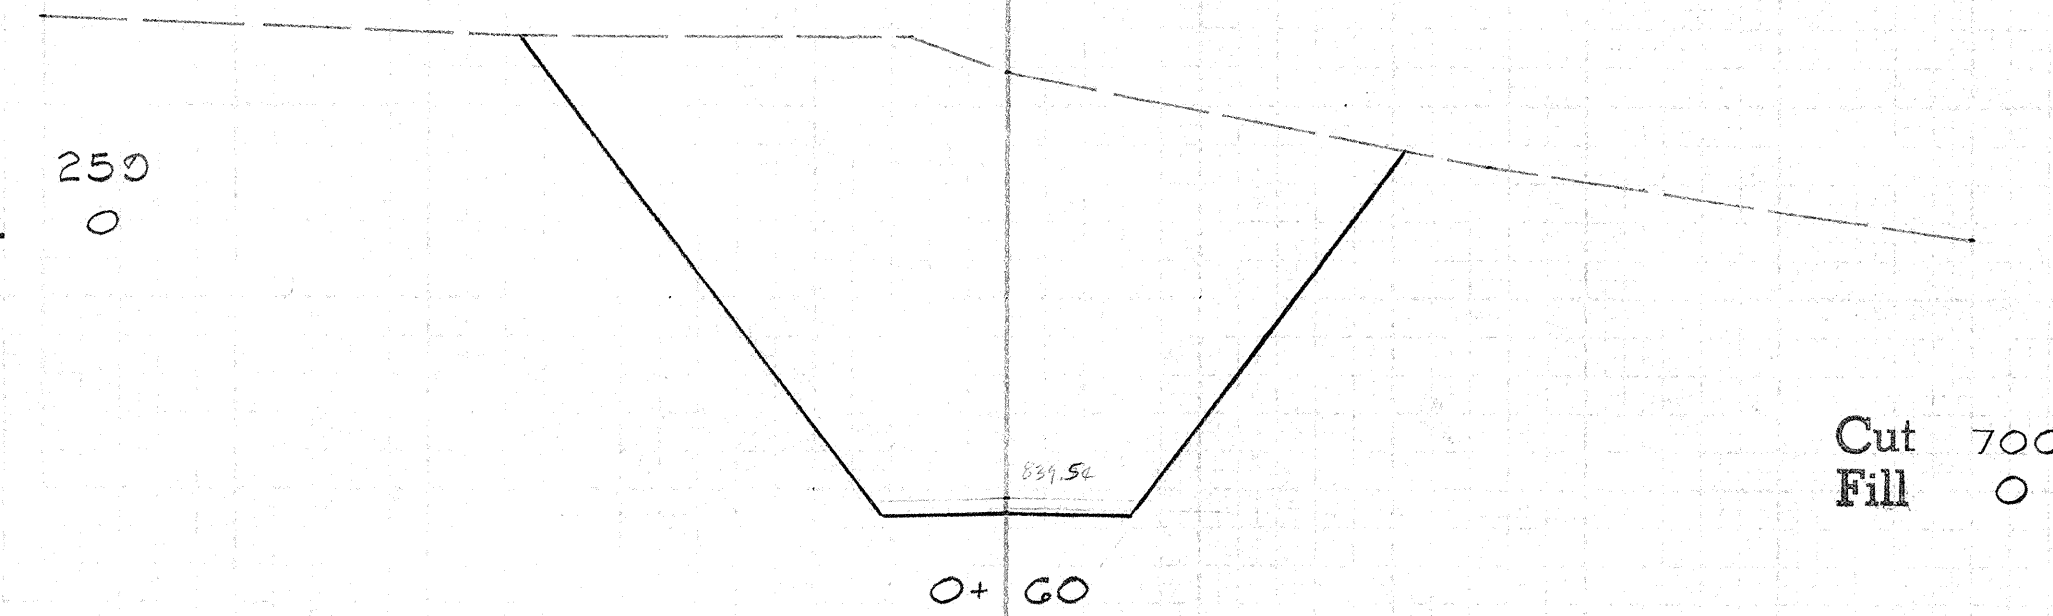

Cut 700
Fill 0

DRIVEWAY FOR DAISY ROSEHILL
STA. 270+04.69 LEFT
PROJ. NO. 240A-01-67