
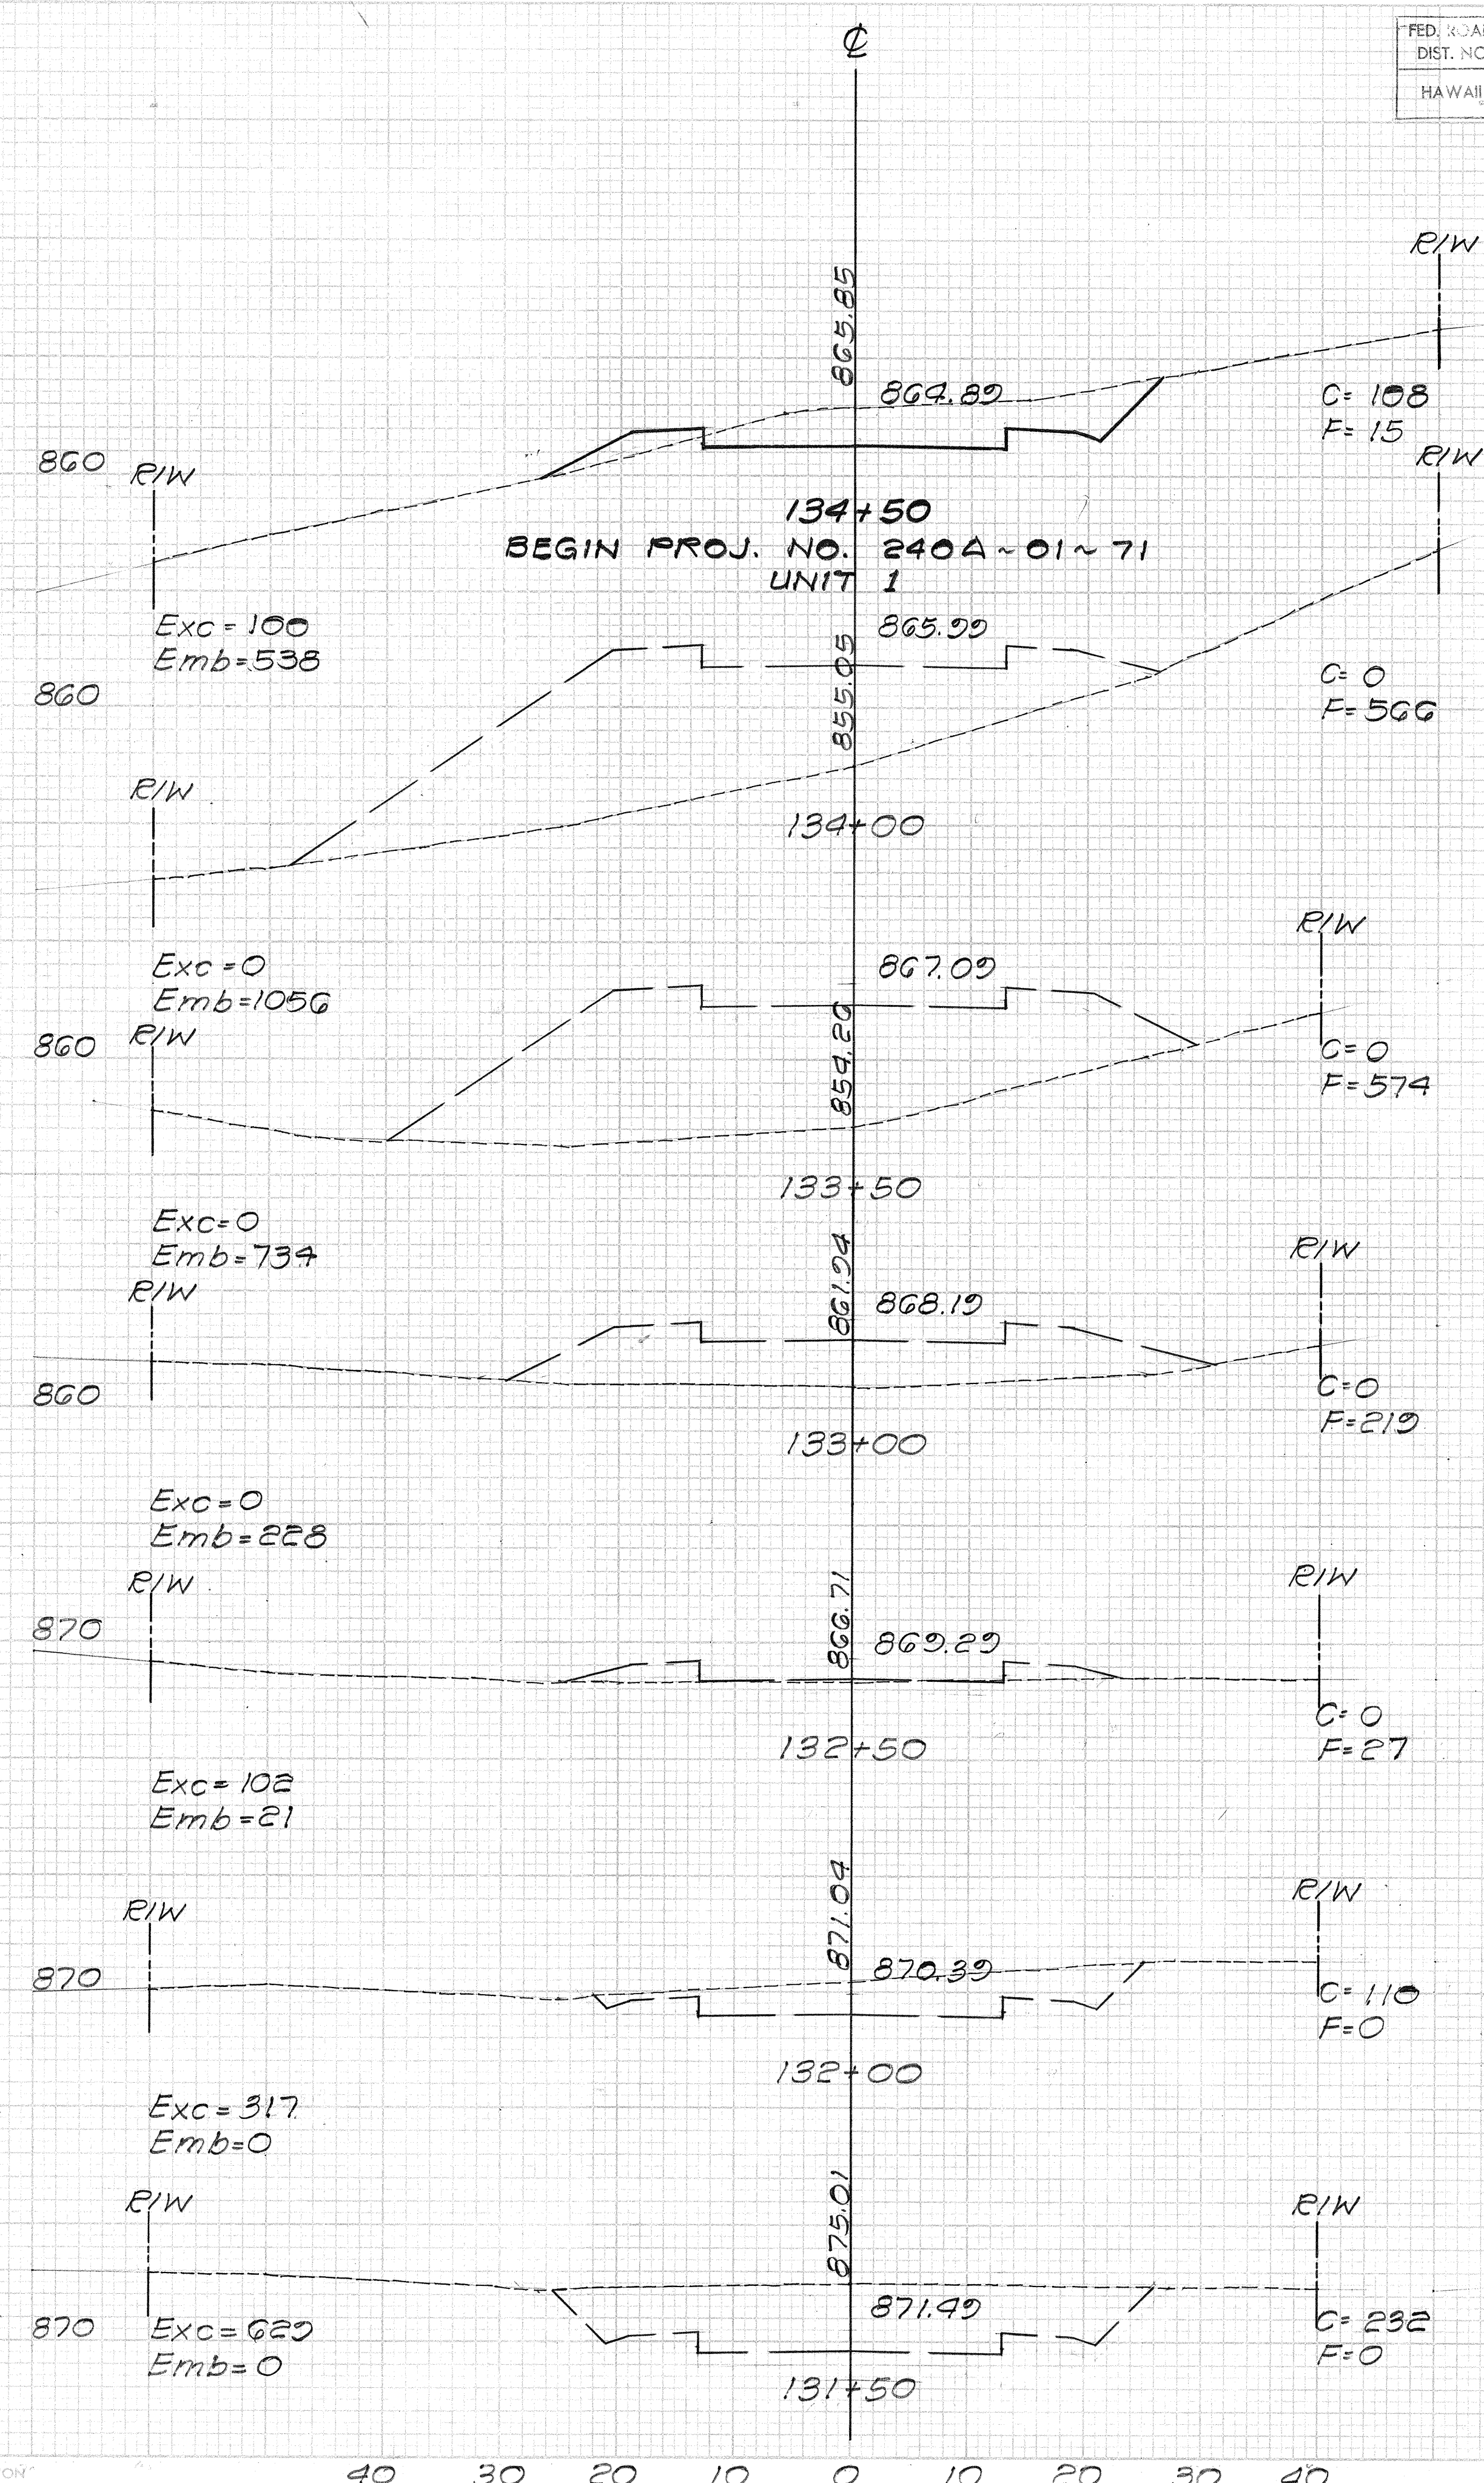


FED. ROAD DIST. NO.	STATE	PROJ. NO.	FISCAL YEAR	SHEET NO.	TOTAL SHEETS
HAWAII	HAW.	240A-01-71 UNIT 1	1977	16	55

DATE	BY	NO.
FINAL SURVEY	SURVEYED	PLOTTED
NOTE BOOK	TEMPLATE	AREAS CHECKED


DATE	BY	NO.
ORIGINAL SURVEY	SURVEYED	PLOTTED
NOTE BOOK	TEMPLATE	AREAS CHECKED

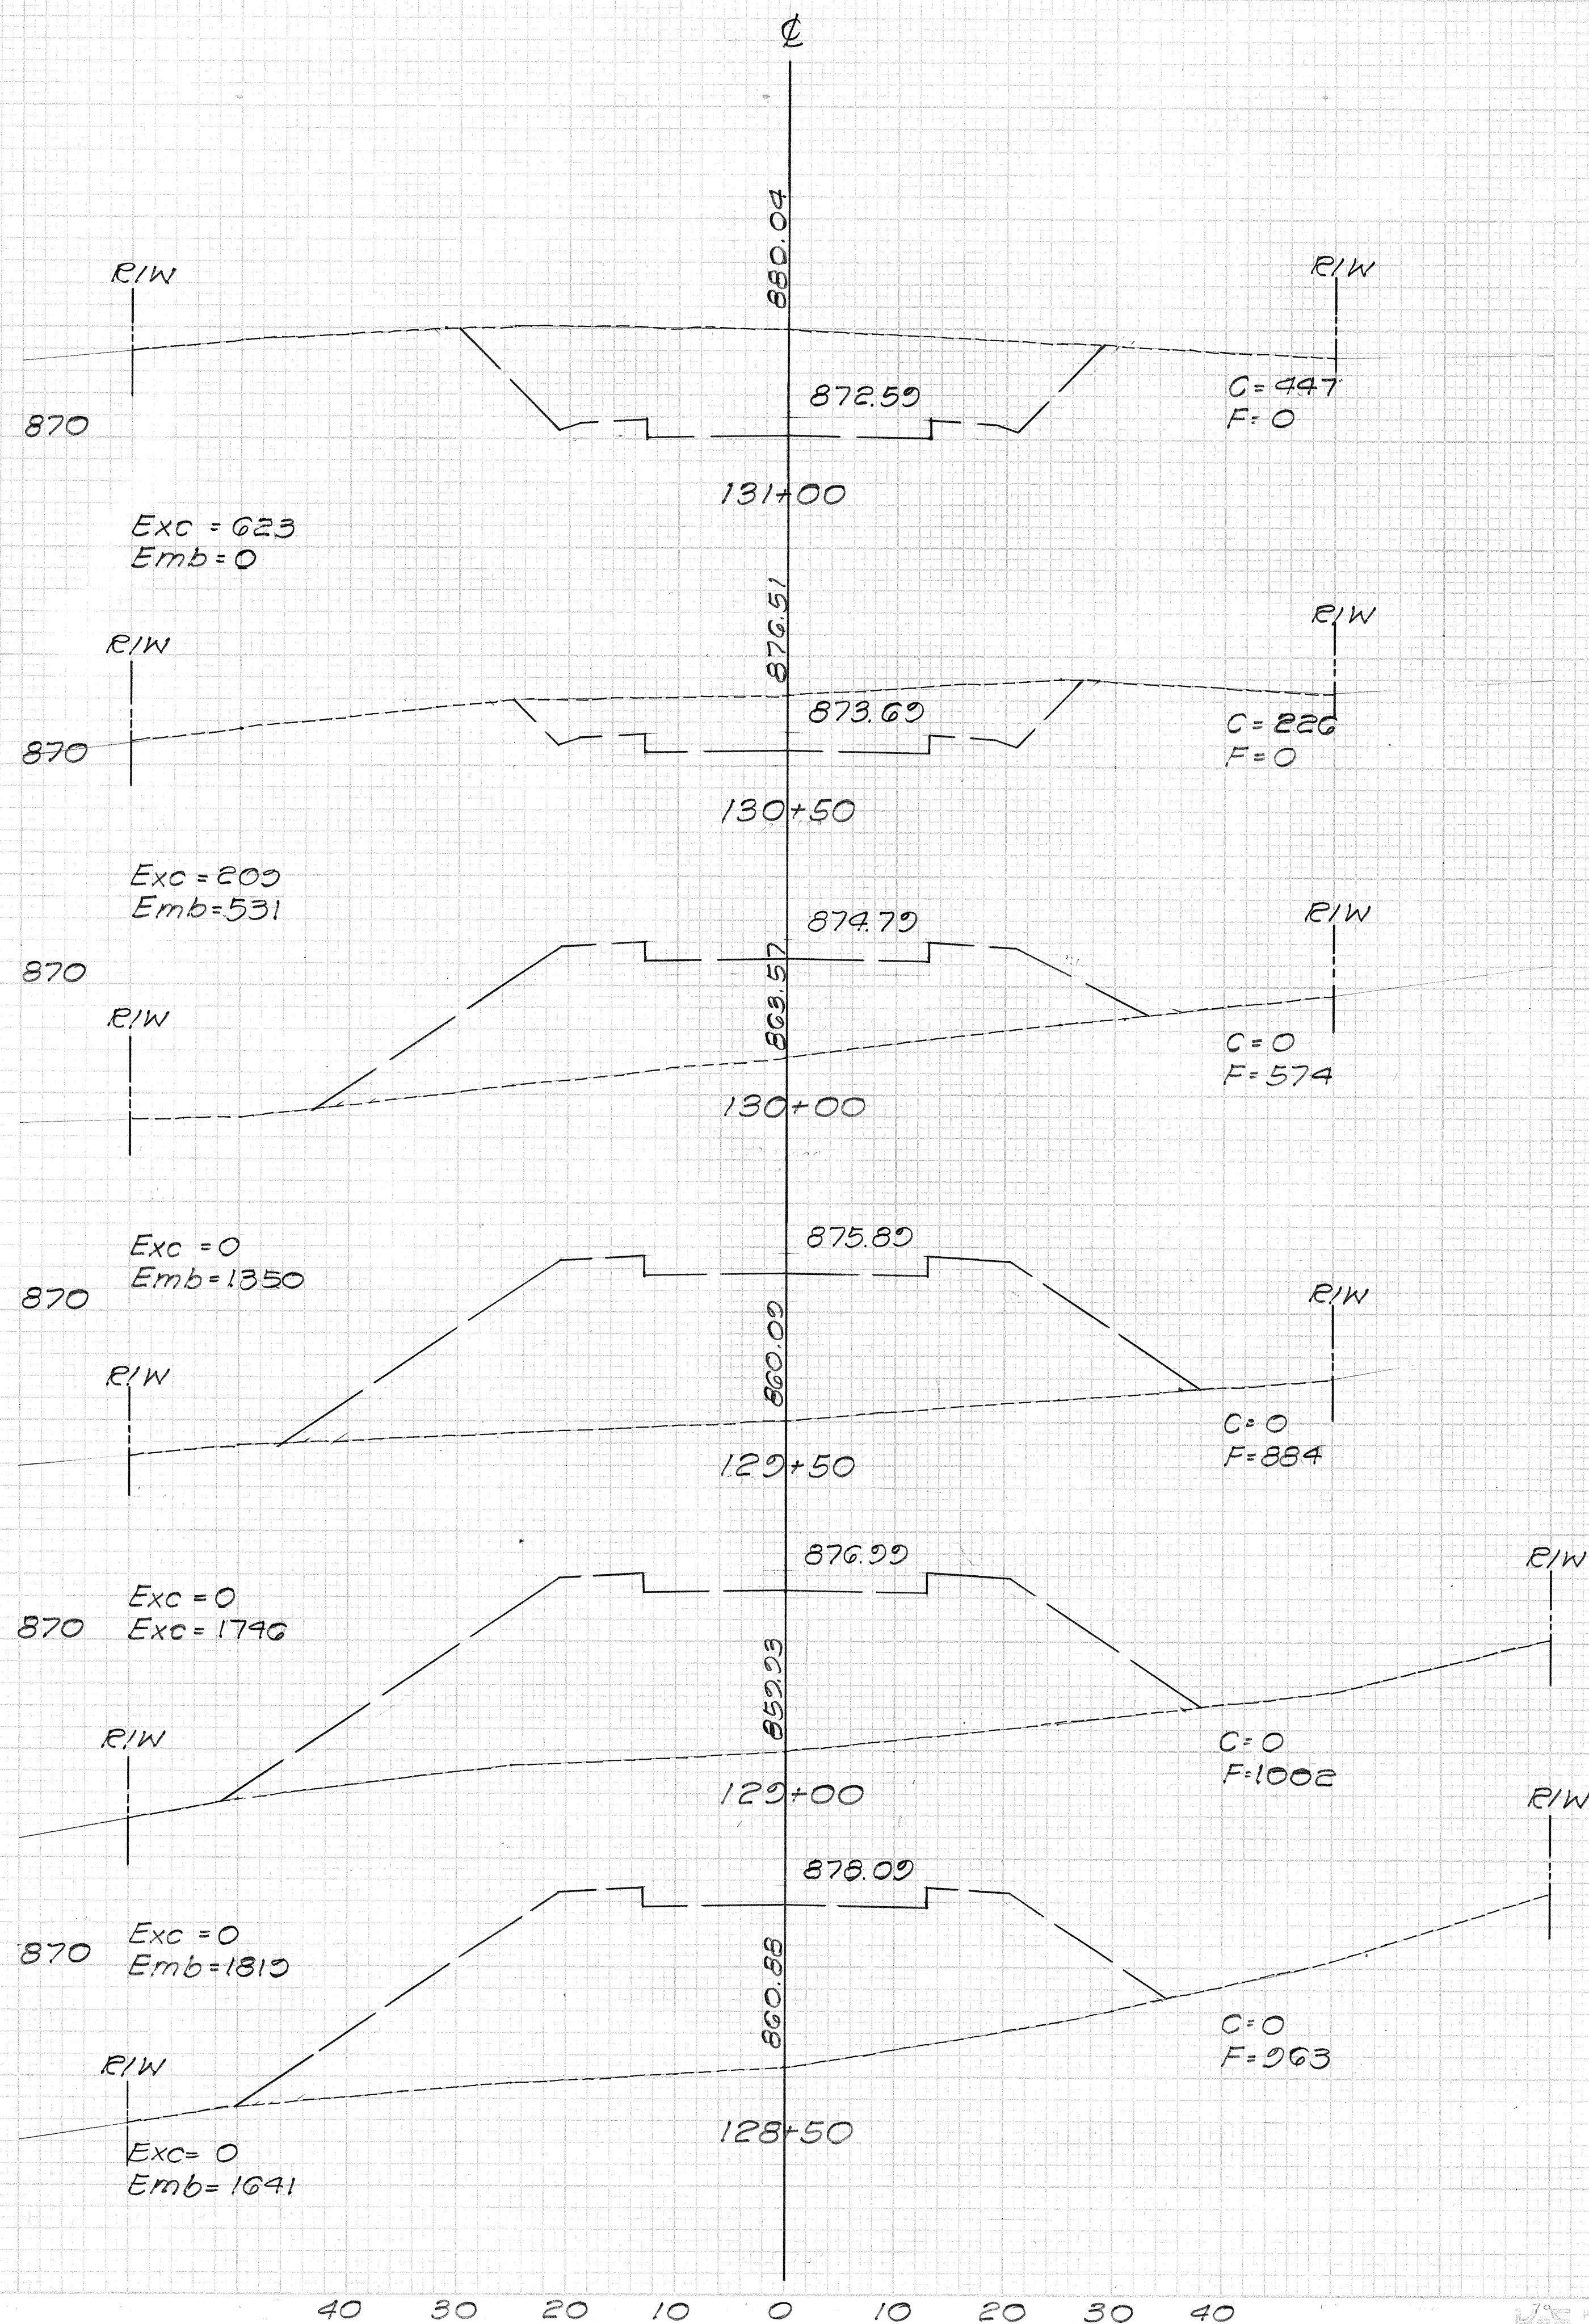


DATE	BY	FINAL SURVEY	PLOTTED	DATE	NO.

DATE	BY	ORIGINAL SURVEY	PLOTTED	DATE	NO.

FED. ROAD DIST. NO.	STATE	PROJ. NO.	FISCAL YEAR	SHEET NO.	TOTAL SHEETS
HAWAII	HAW.	240A-01-71 UNIT 1	1977	17	55

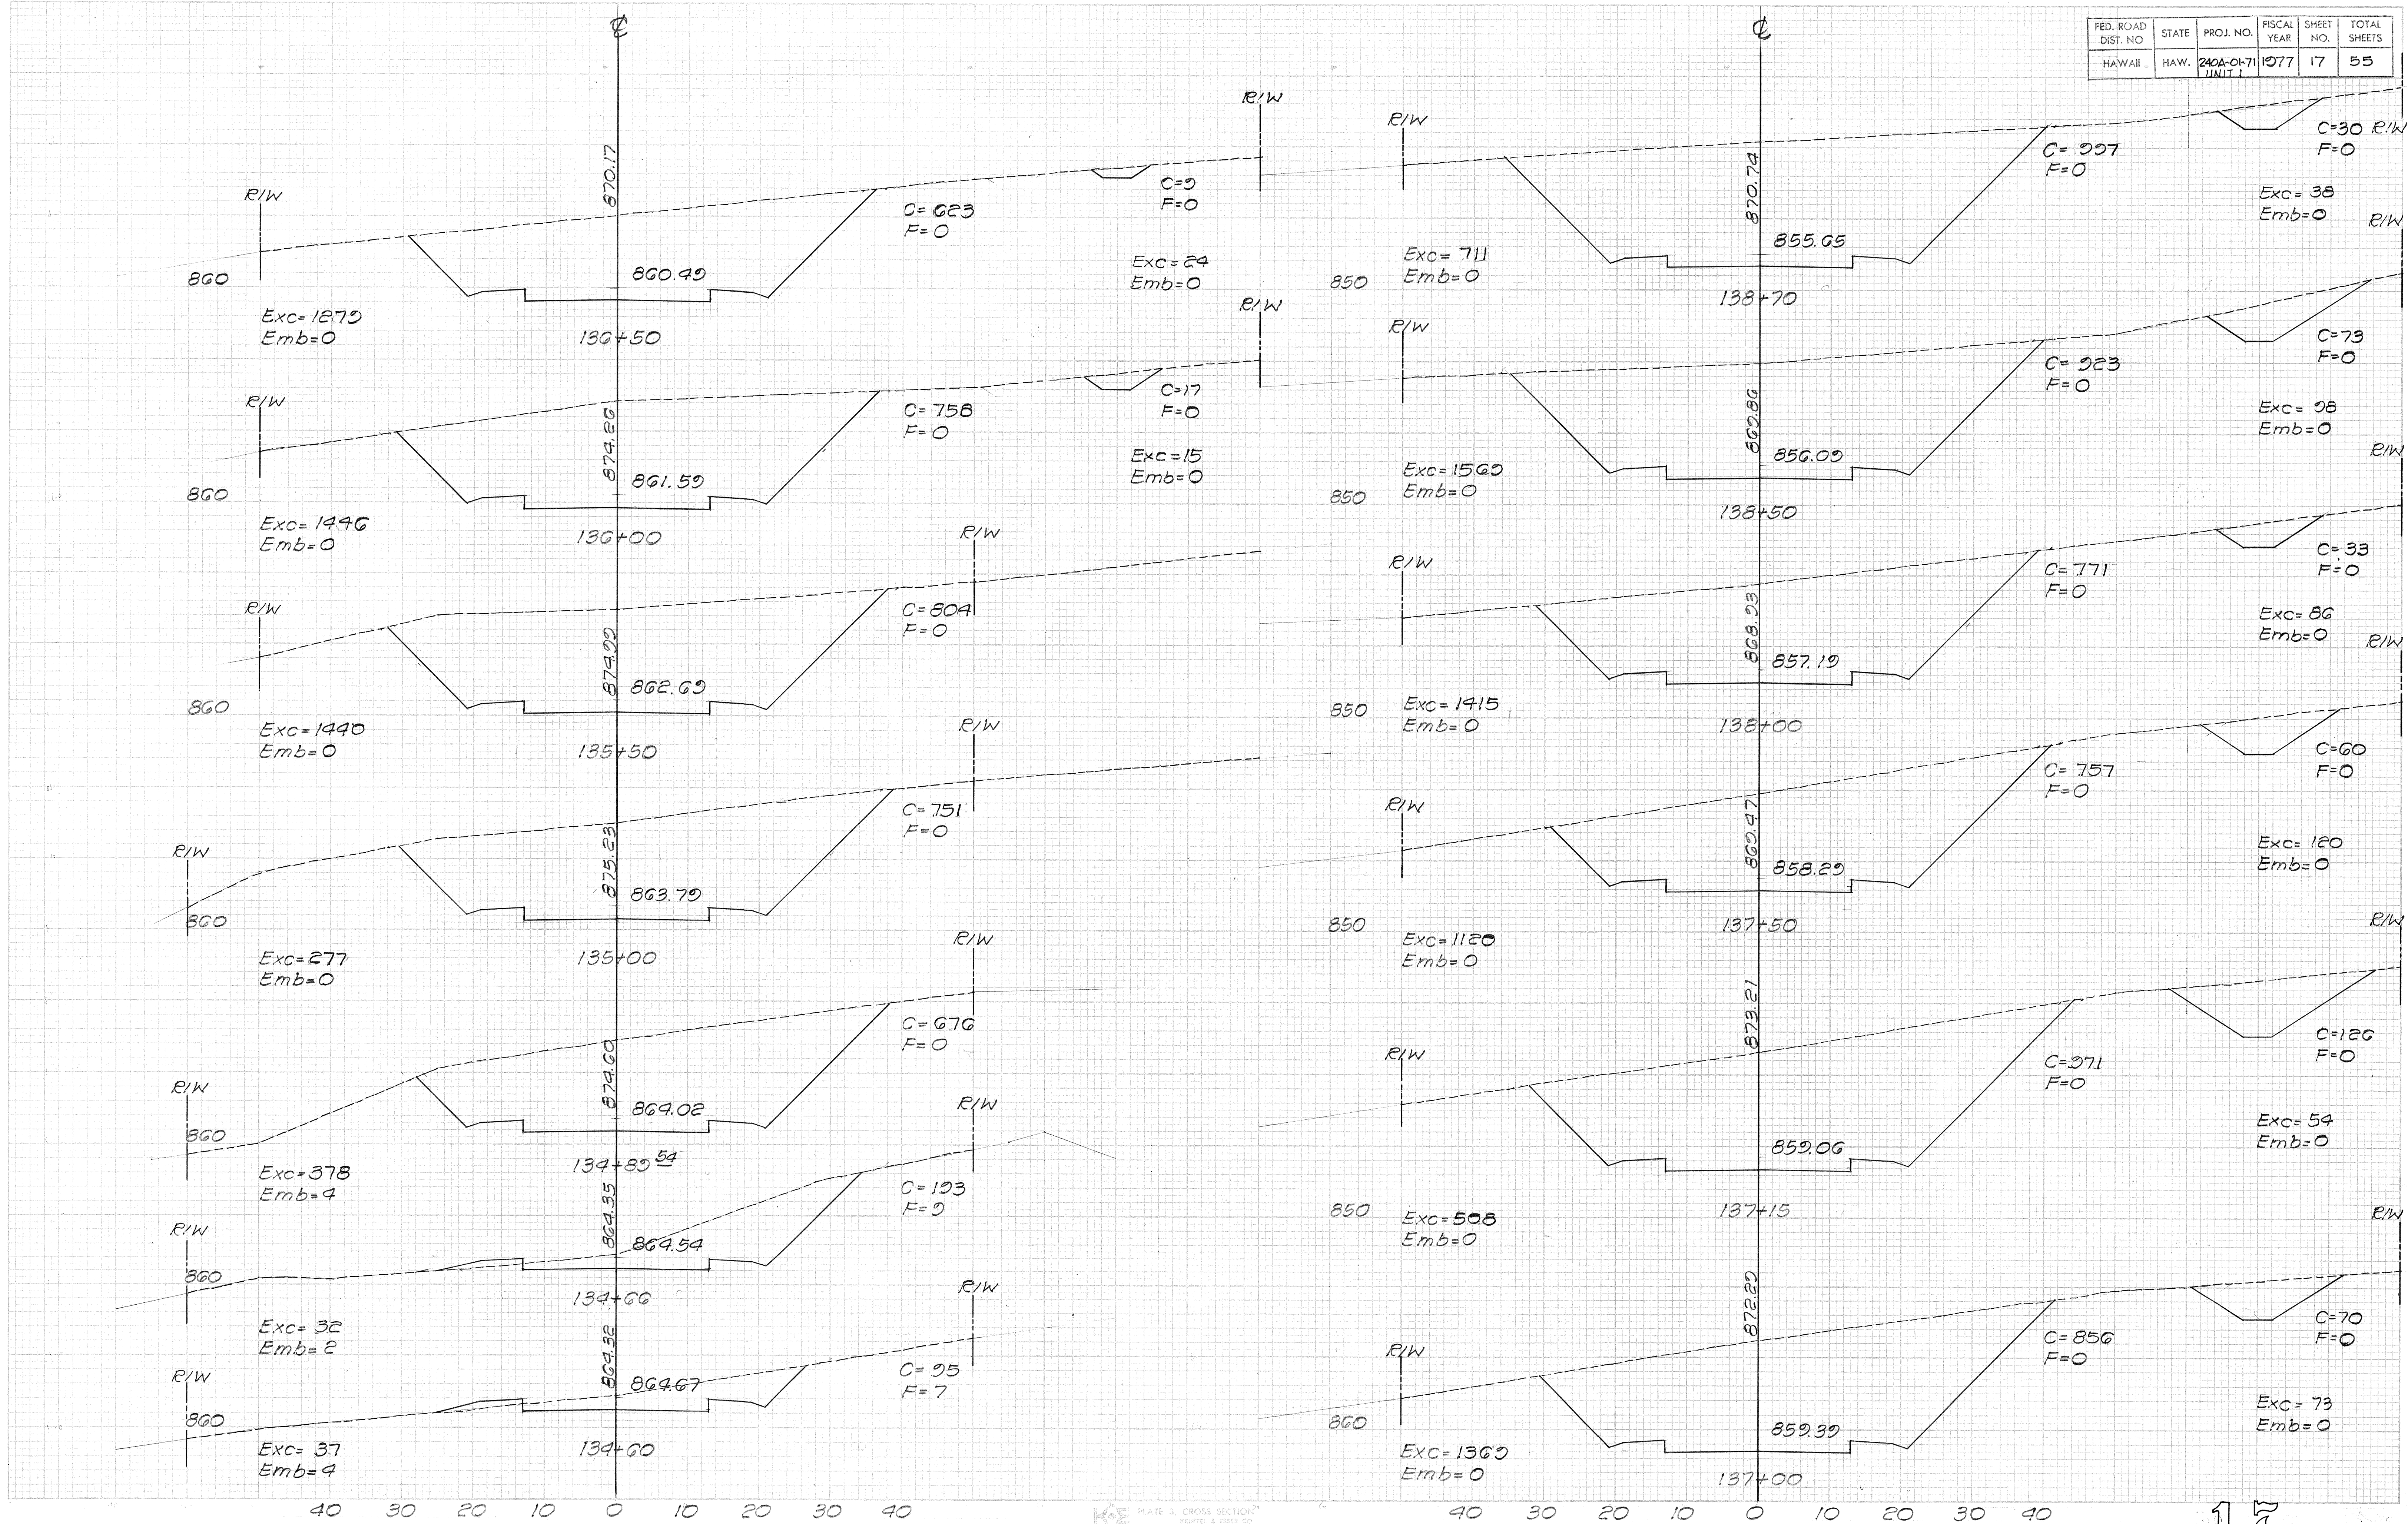



FED. ROAD DIST. NO.	STATE	PROJ. NO.	FISCAL YEAR	SHEET NO.	TOTAL SHEETS
HAWAII	HAW.	240A-01-71 UNIT 1	1977	18	55

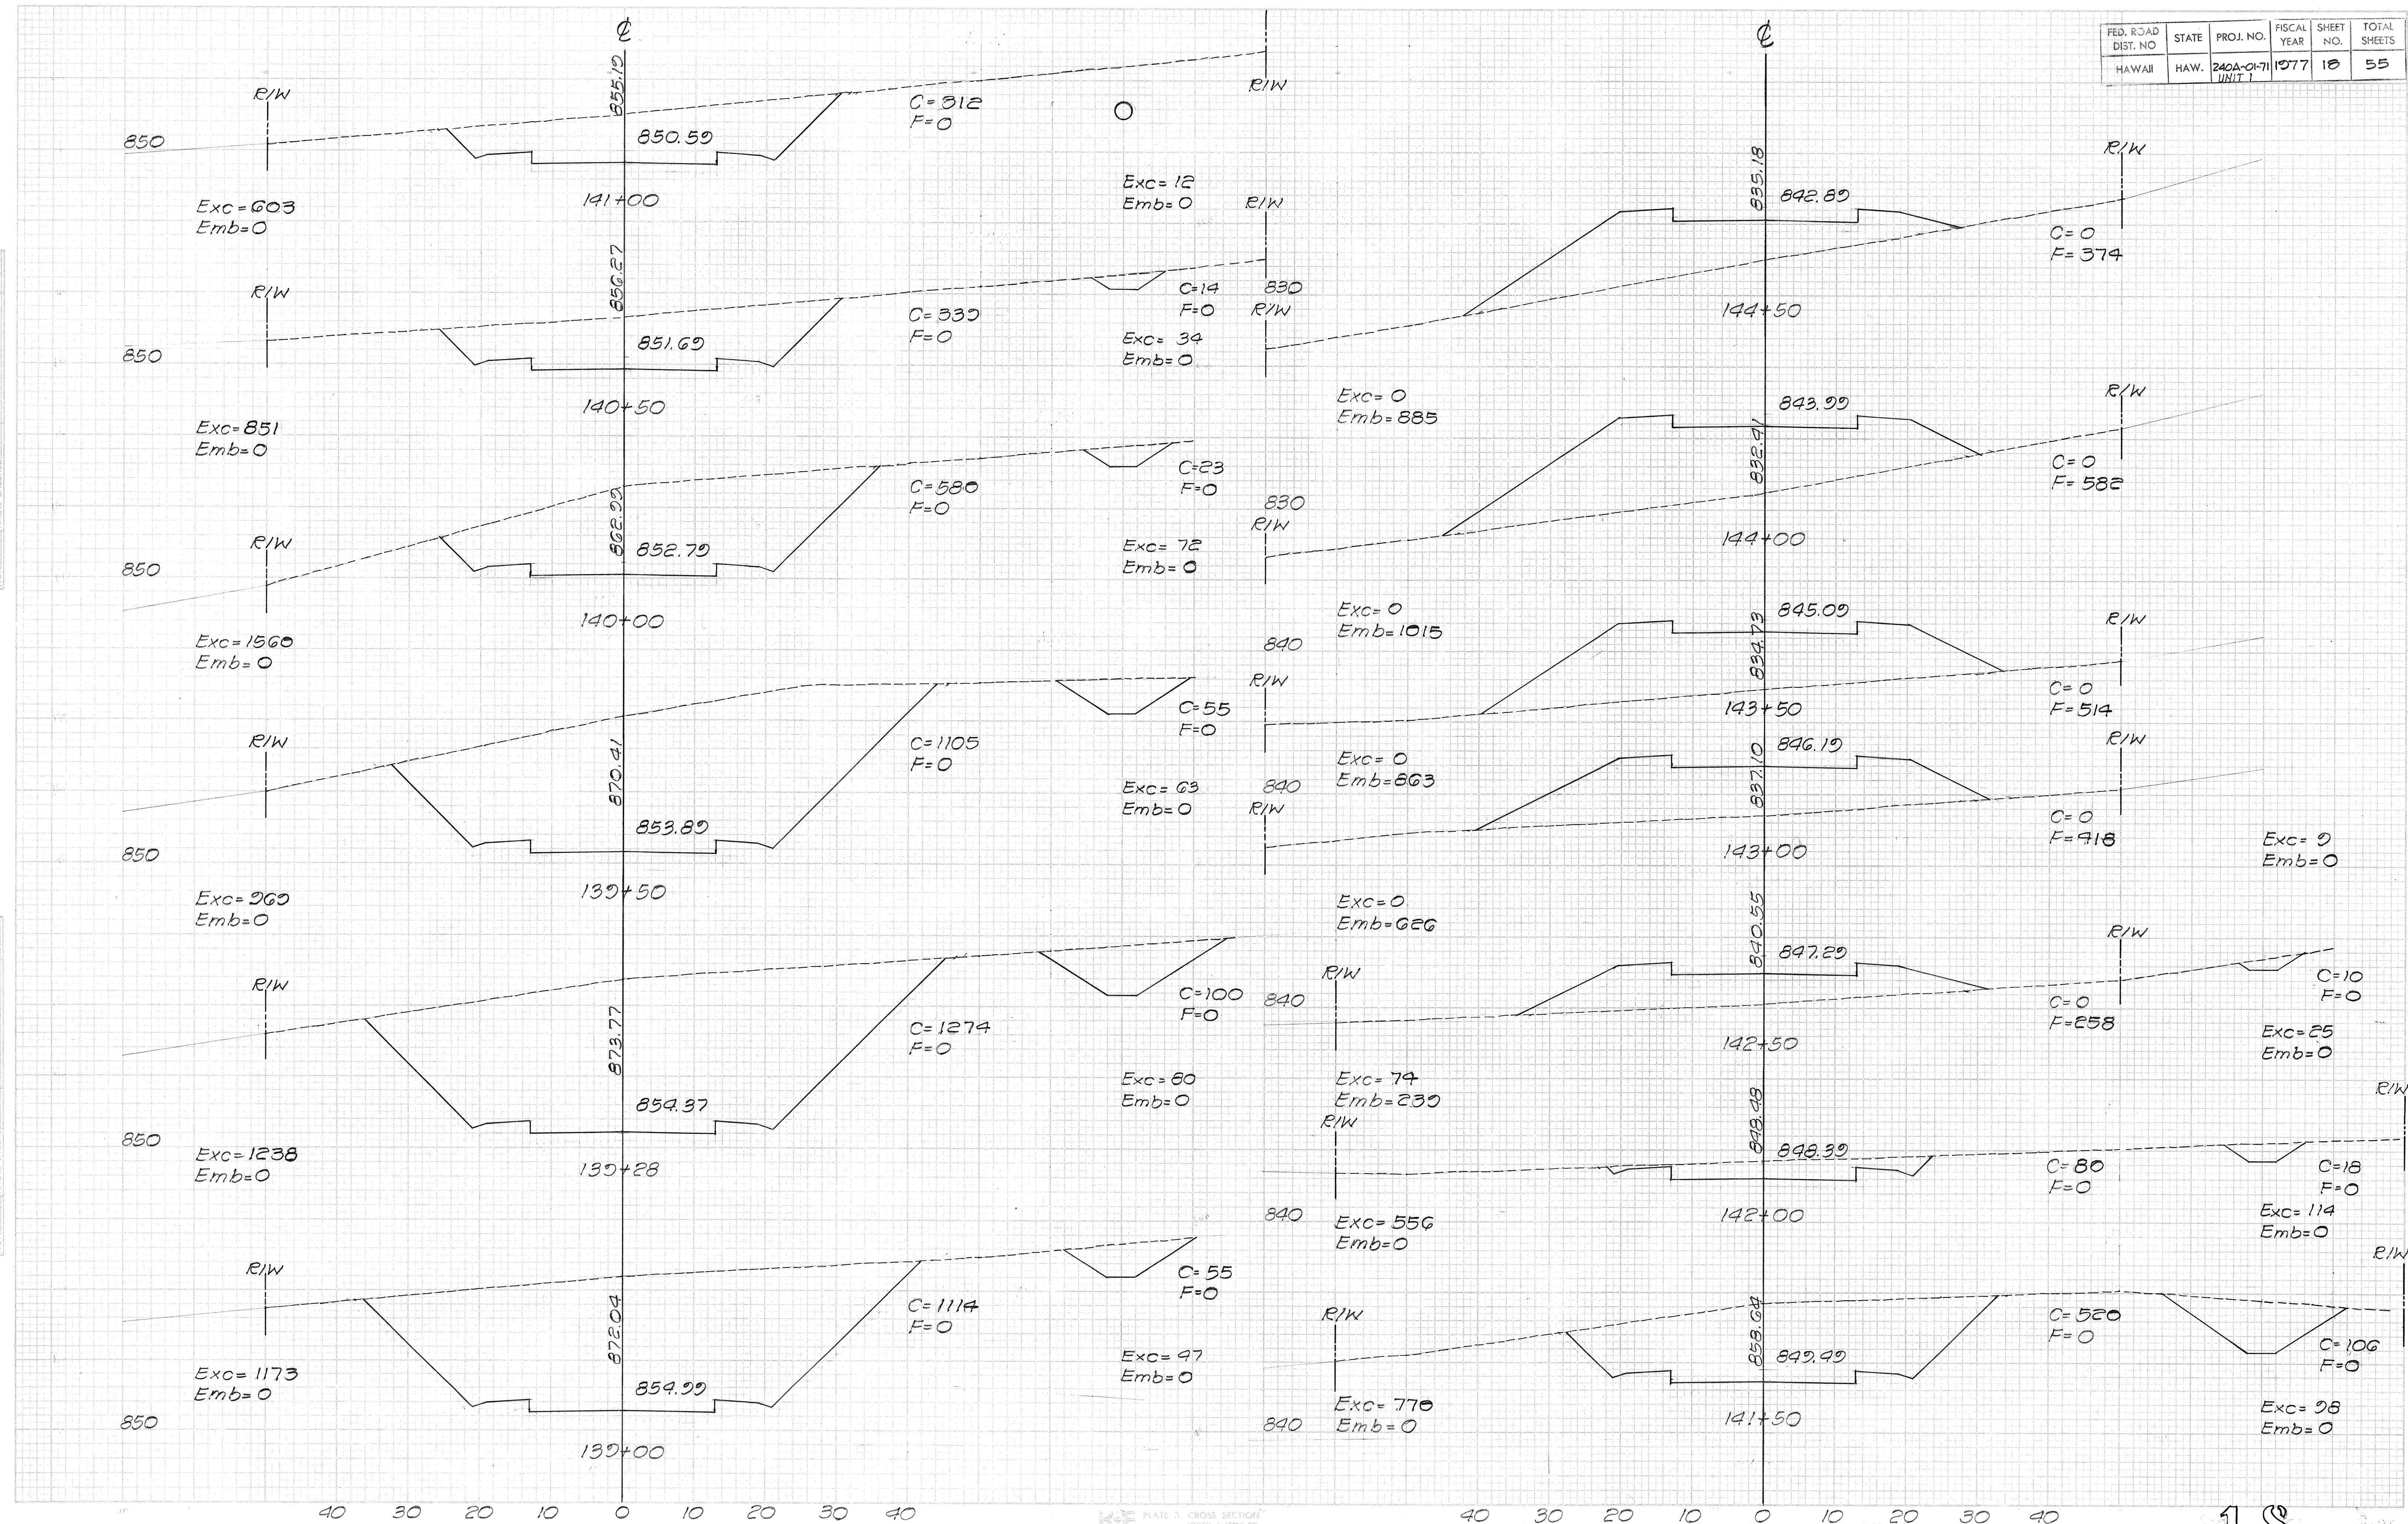

DATE	BY	FINAL SURVEY	PLOTTED	TEMP	NO. 1
		NOTE BOOK	TEMP	NO. 2	
		AREAS CHECKED			

DATE	BY	ORIGINAL SURVEY	PLOTTED	TEMP	NO. 1
		NOTE BOOK	TEMP	NO. 2	
		AREAS CHECKED			


FED. ROAD DIST. NO.	STATE	PROJ. NO.	FISCAL YEAR	SHEET NO.	TOTAL SHEETS
HAWAII	HAW.	240A-01-71 UNIT 1	1977	19	55

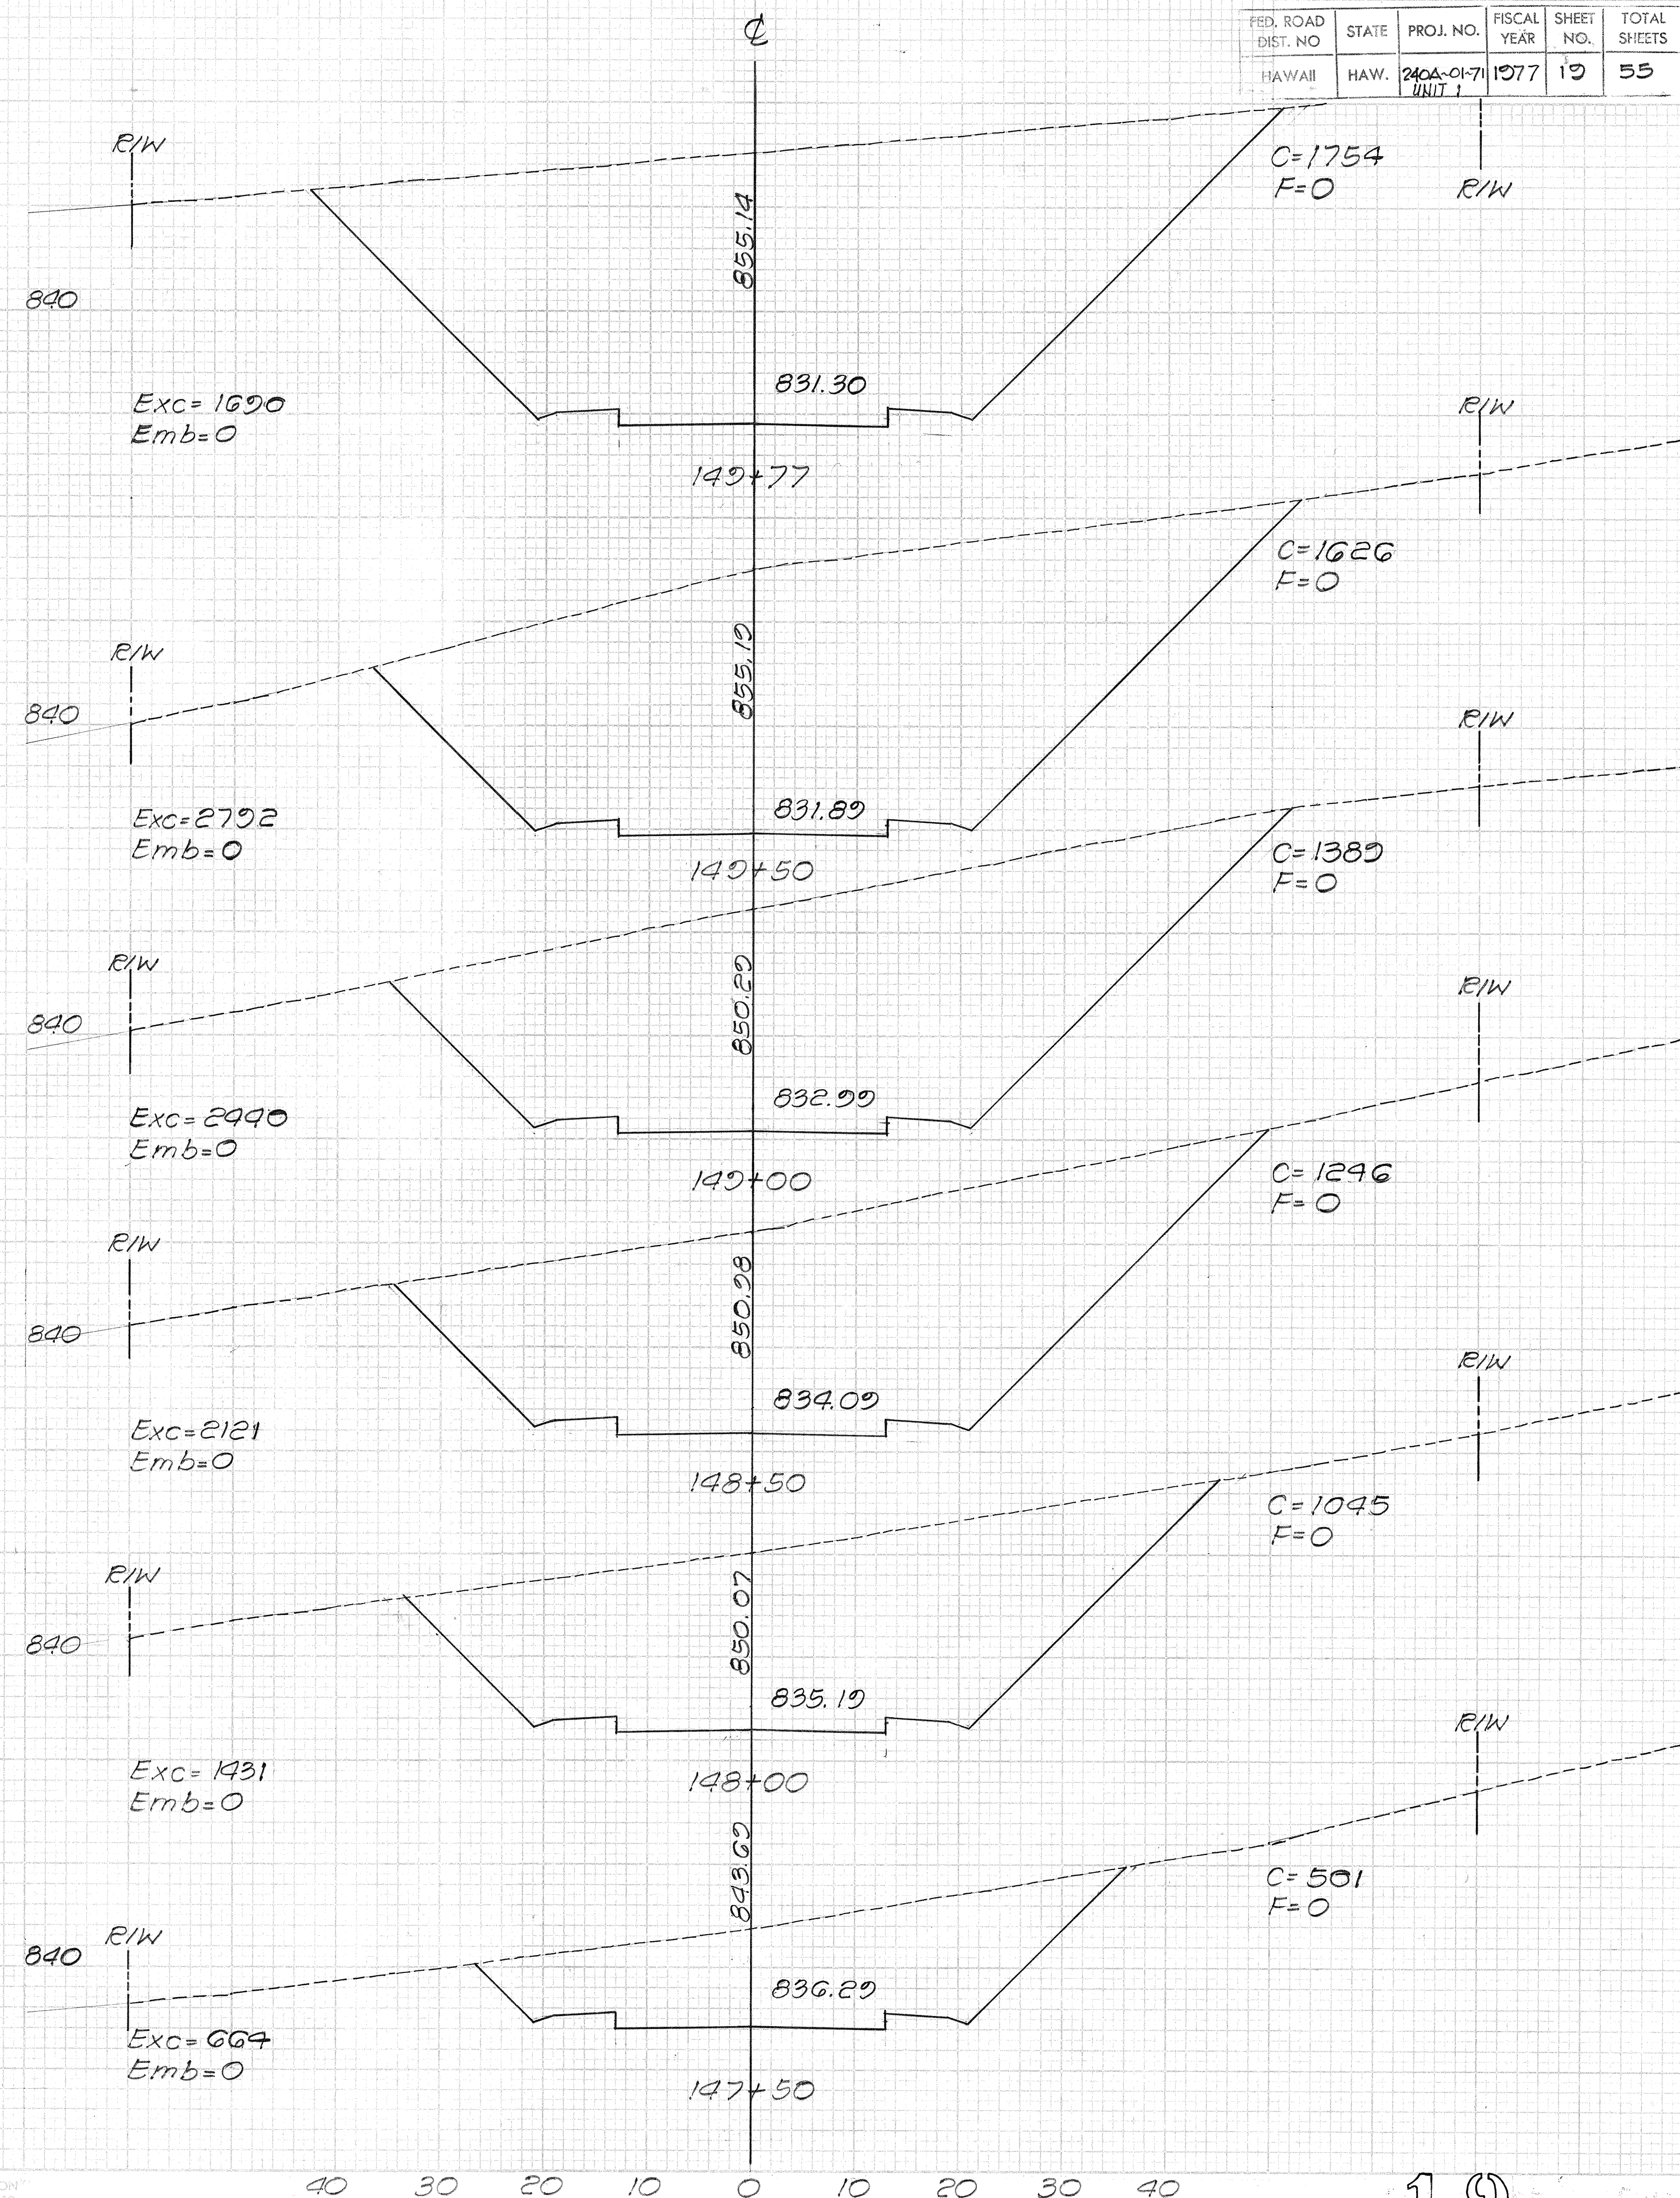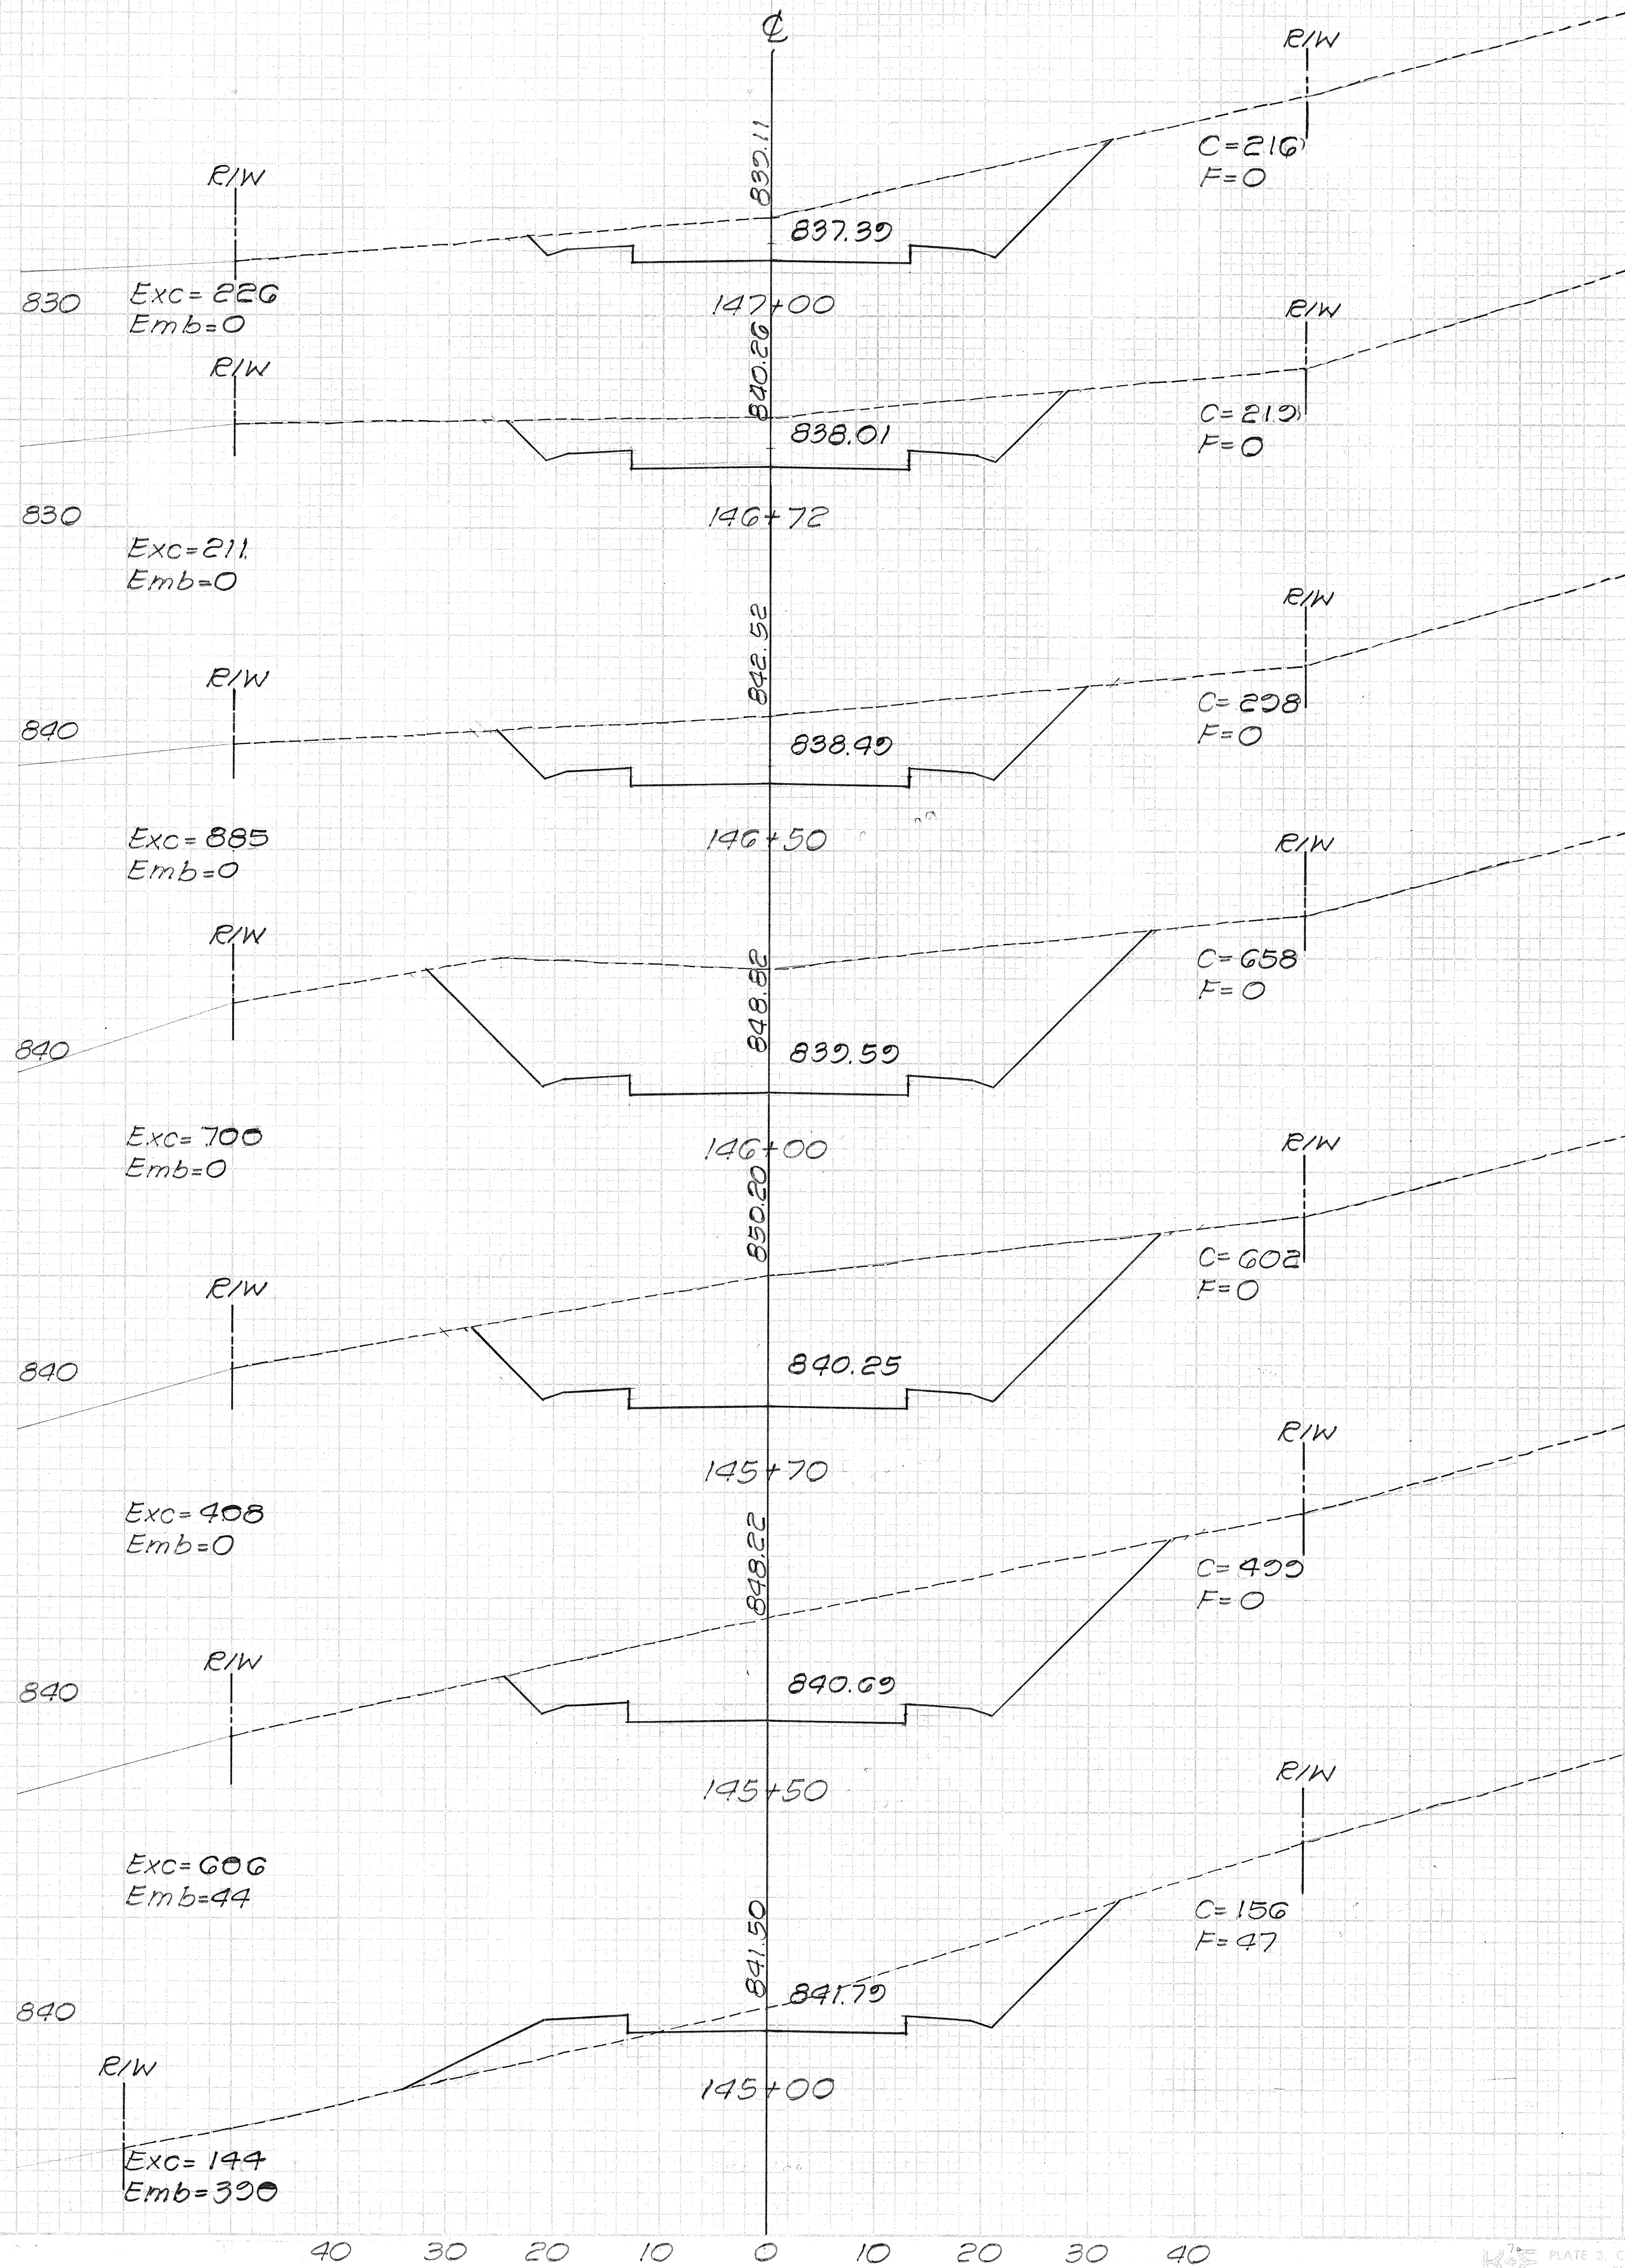

FED. ROAD DIST. NO.	STATE	PROJ. NO.	FISCAL YEAR	SHEET NO.	TOTAL SHEETS
HAWAII	HAW.	240A-01-71 UNIT 1	1977	20	55

FINAL SURVEY	DATE
SURVEYED	
PLOTTED	
CHECKED	
REVISIONS	
NO.	


ORIGINAL SURVEY	DATE
SURVEYED	
PLOTTED	
CHECKED	
REVISIONS	
NO.	

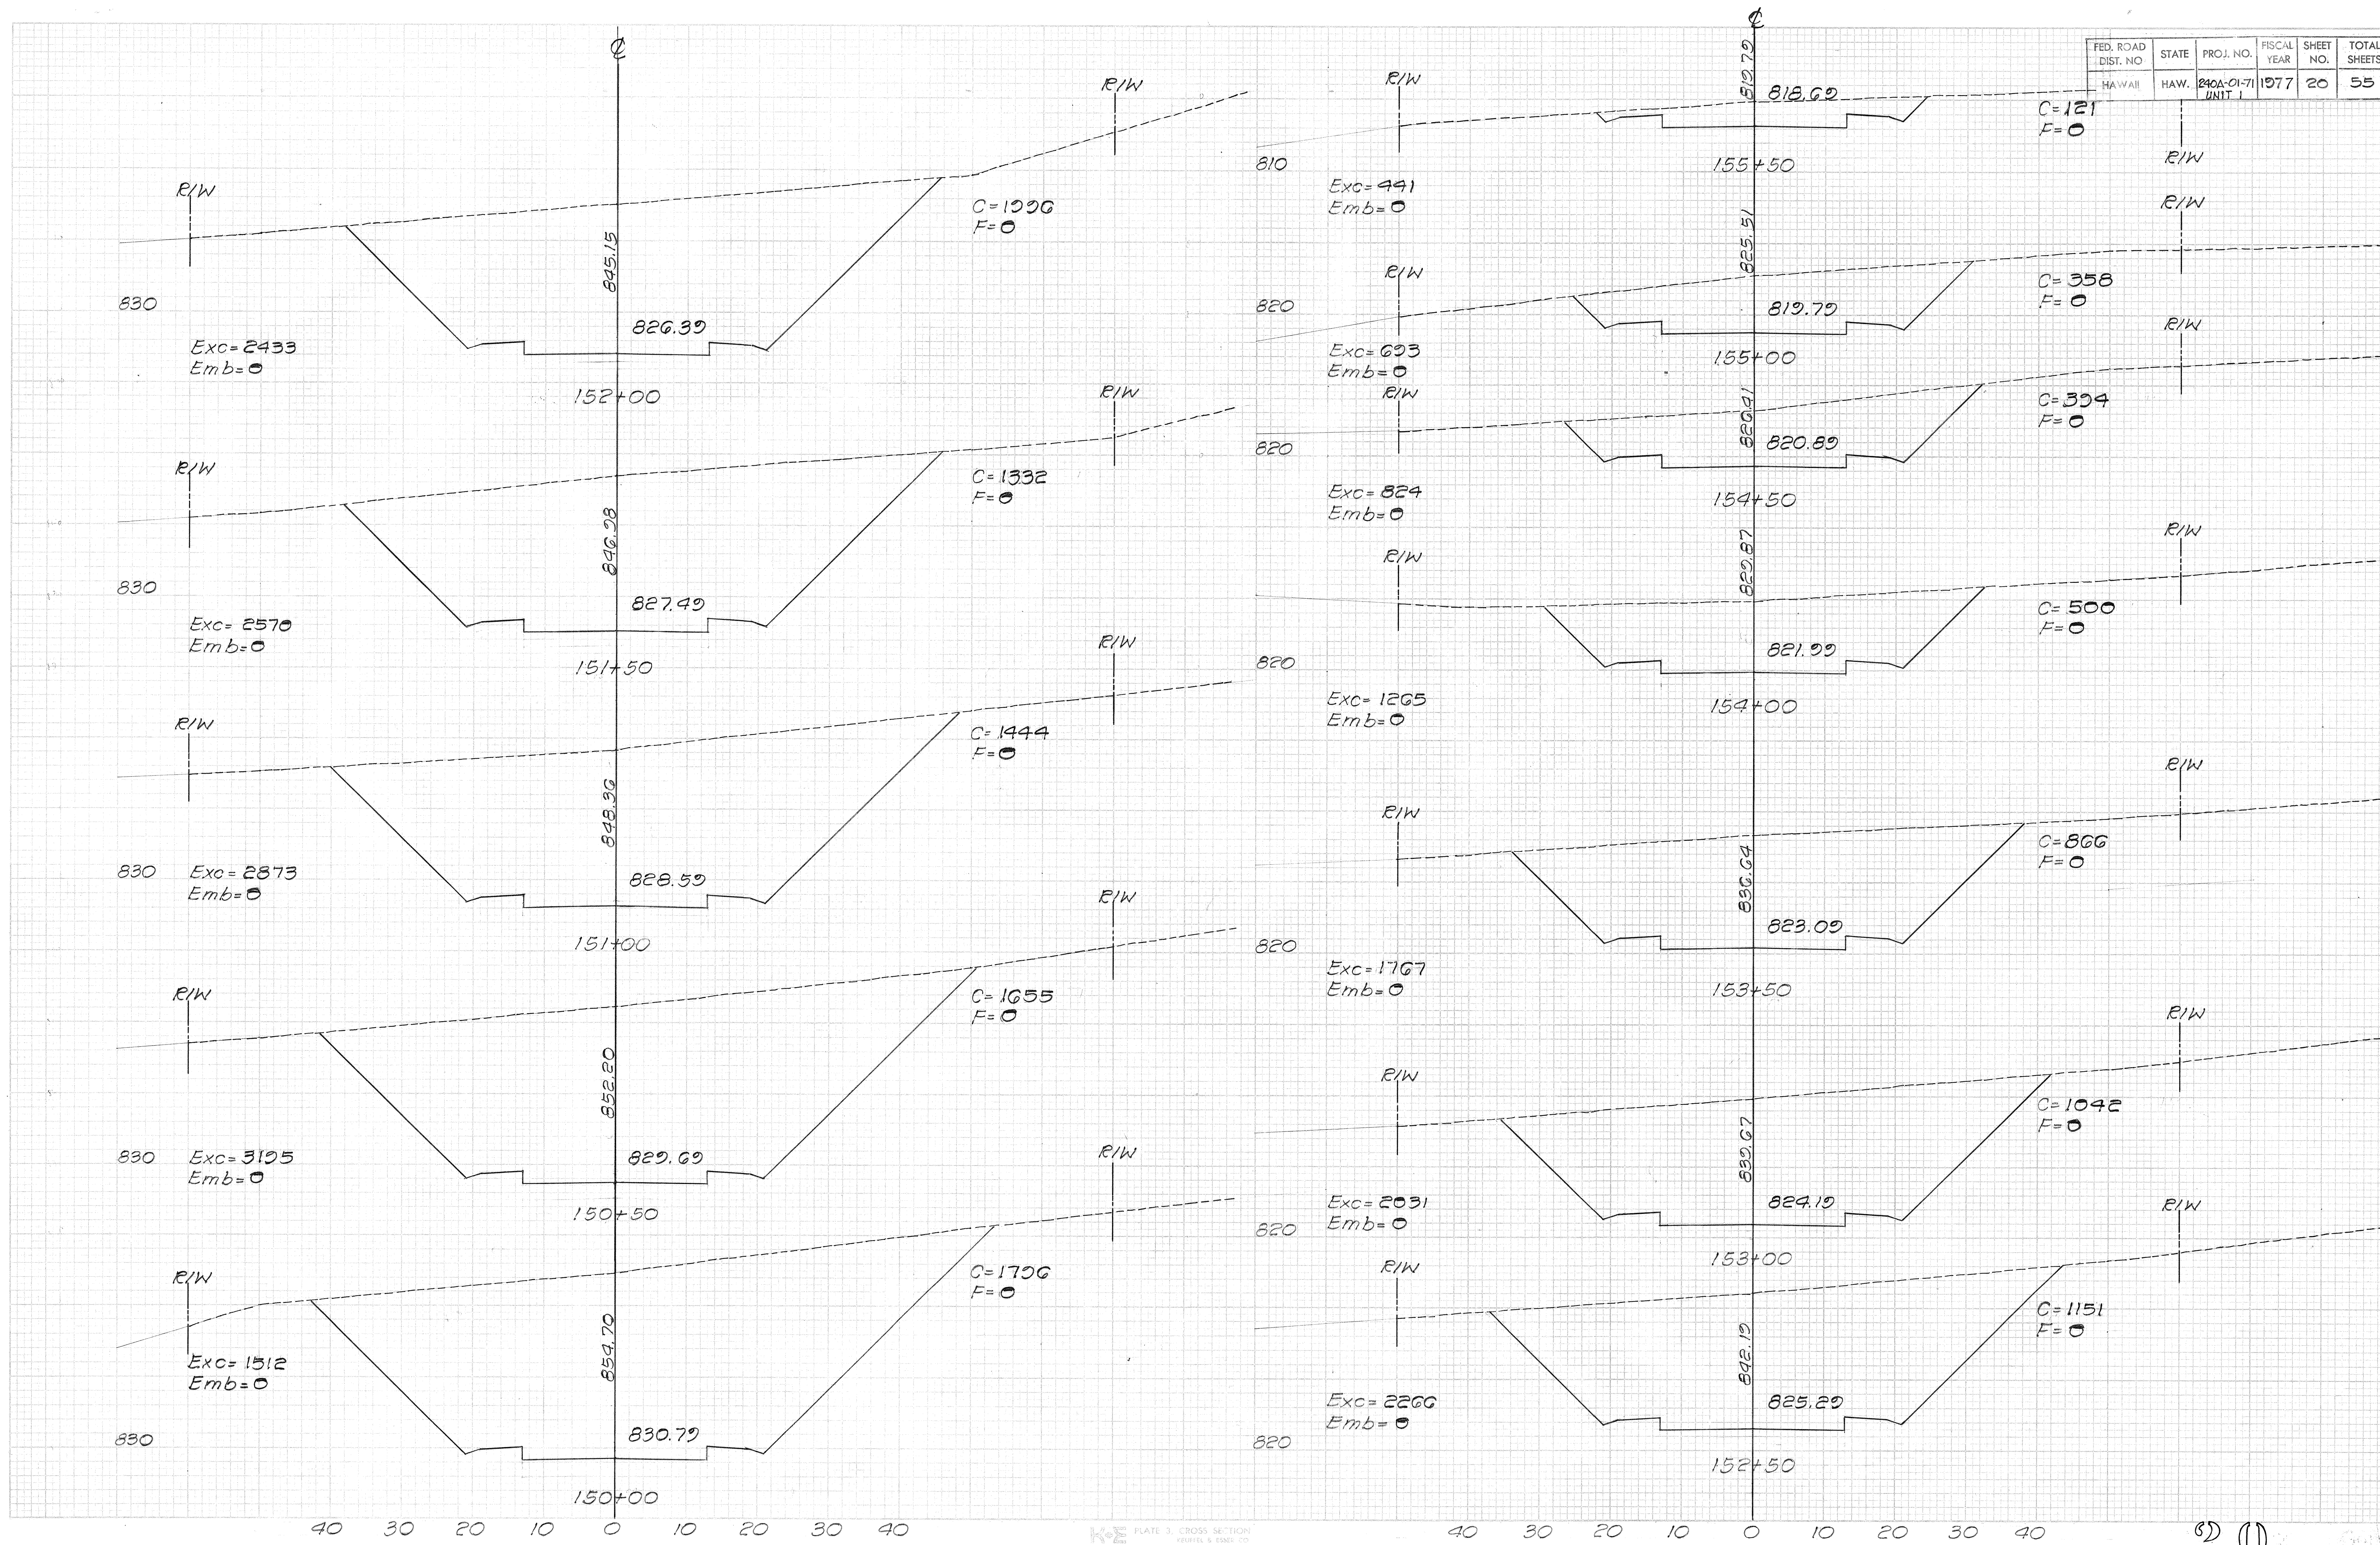

DATE	BY
FINAL SURVEY	SURVEY
NOTE BOOK	PLATE
NO.	AREAS CHECKED

DATE	BY
ORIGINAL SURVEY	SURVEY
NOTE BOOK	PLATE
NO.	AREAS CHECKED



FED. ROAD DIST. NO.	STATE	PROJ. NO.	FISCAL YEAR	SHEET NO.	TOTAL SHEETS
HAWAII	HAW.	240A-01-71 UNIT 1	1977	21	55

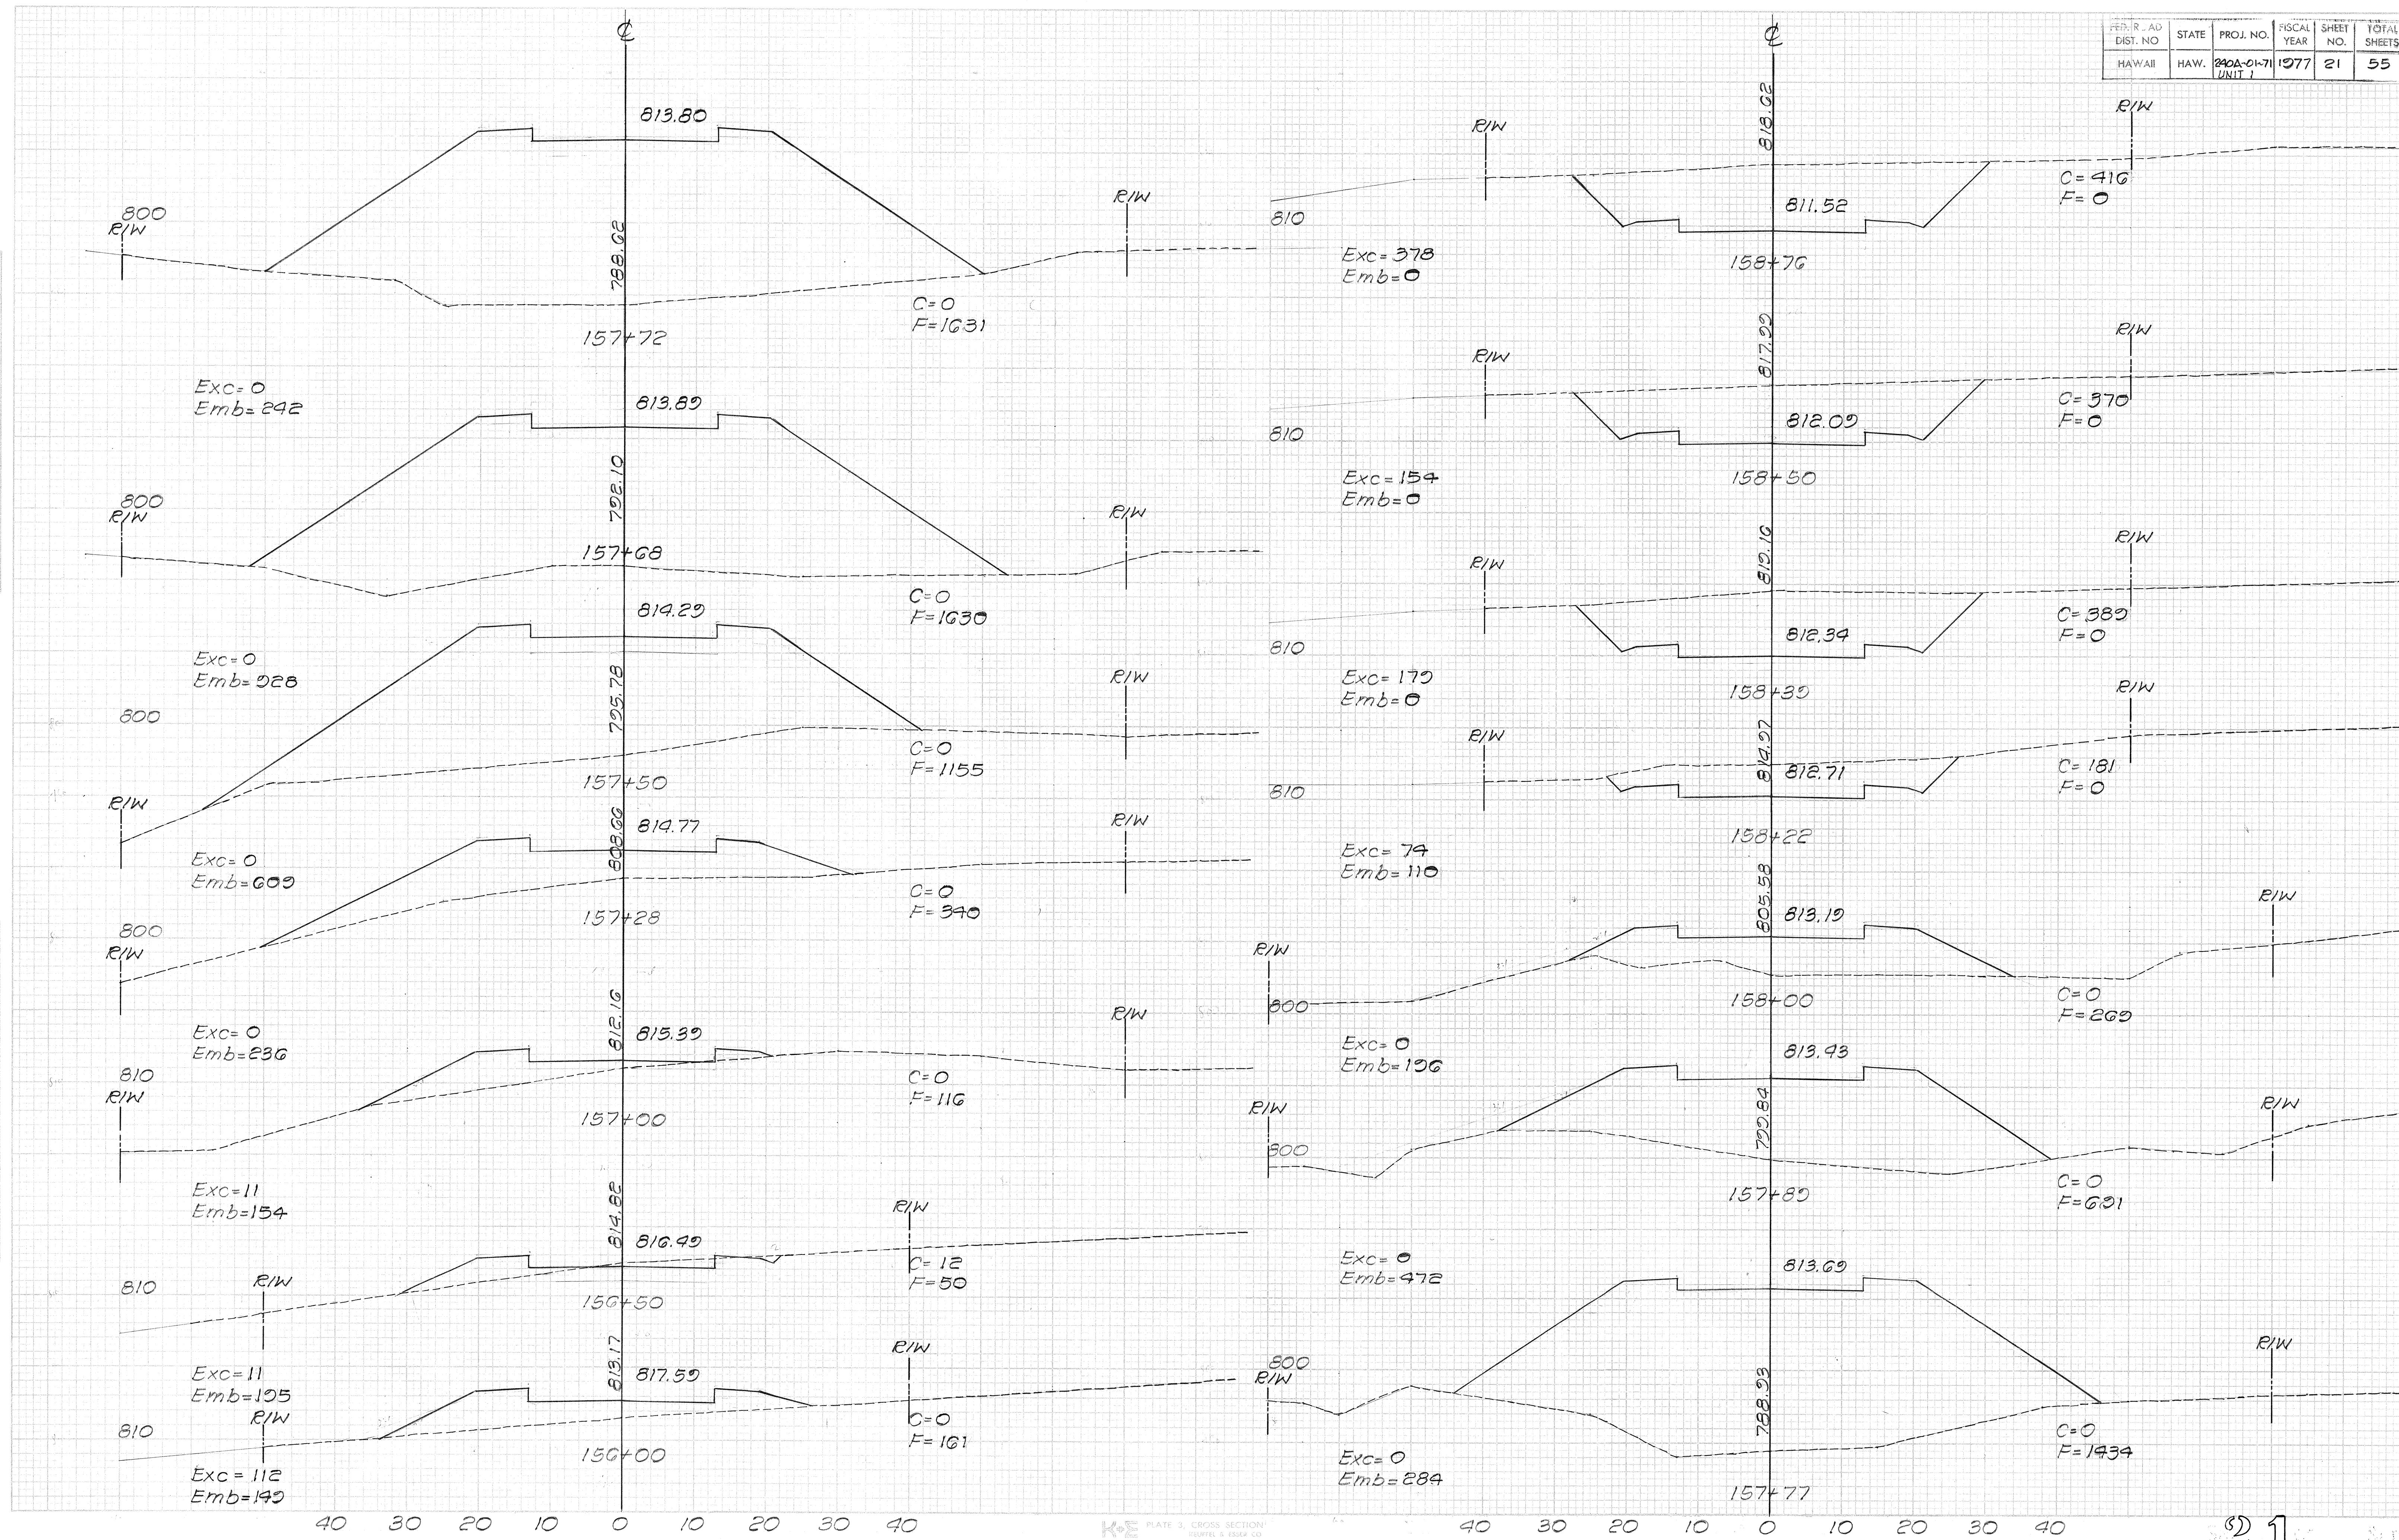



FED. ROAD DIST. NO.	STATE	PROJ. NO.	FISCAL YEAR	SHEET NO.	TOTAL SHEETS
HAWAII	HAW.	242A-01-71 UNIT 1	1977	22	55

DATE	BY	FINAL SURVEY	PLOTTED	DATE	NO.

DATE	BY	ORIGINAL SURVEY	PLOTTED	DATE	NO.

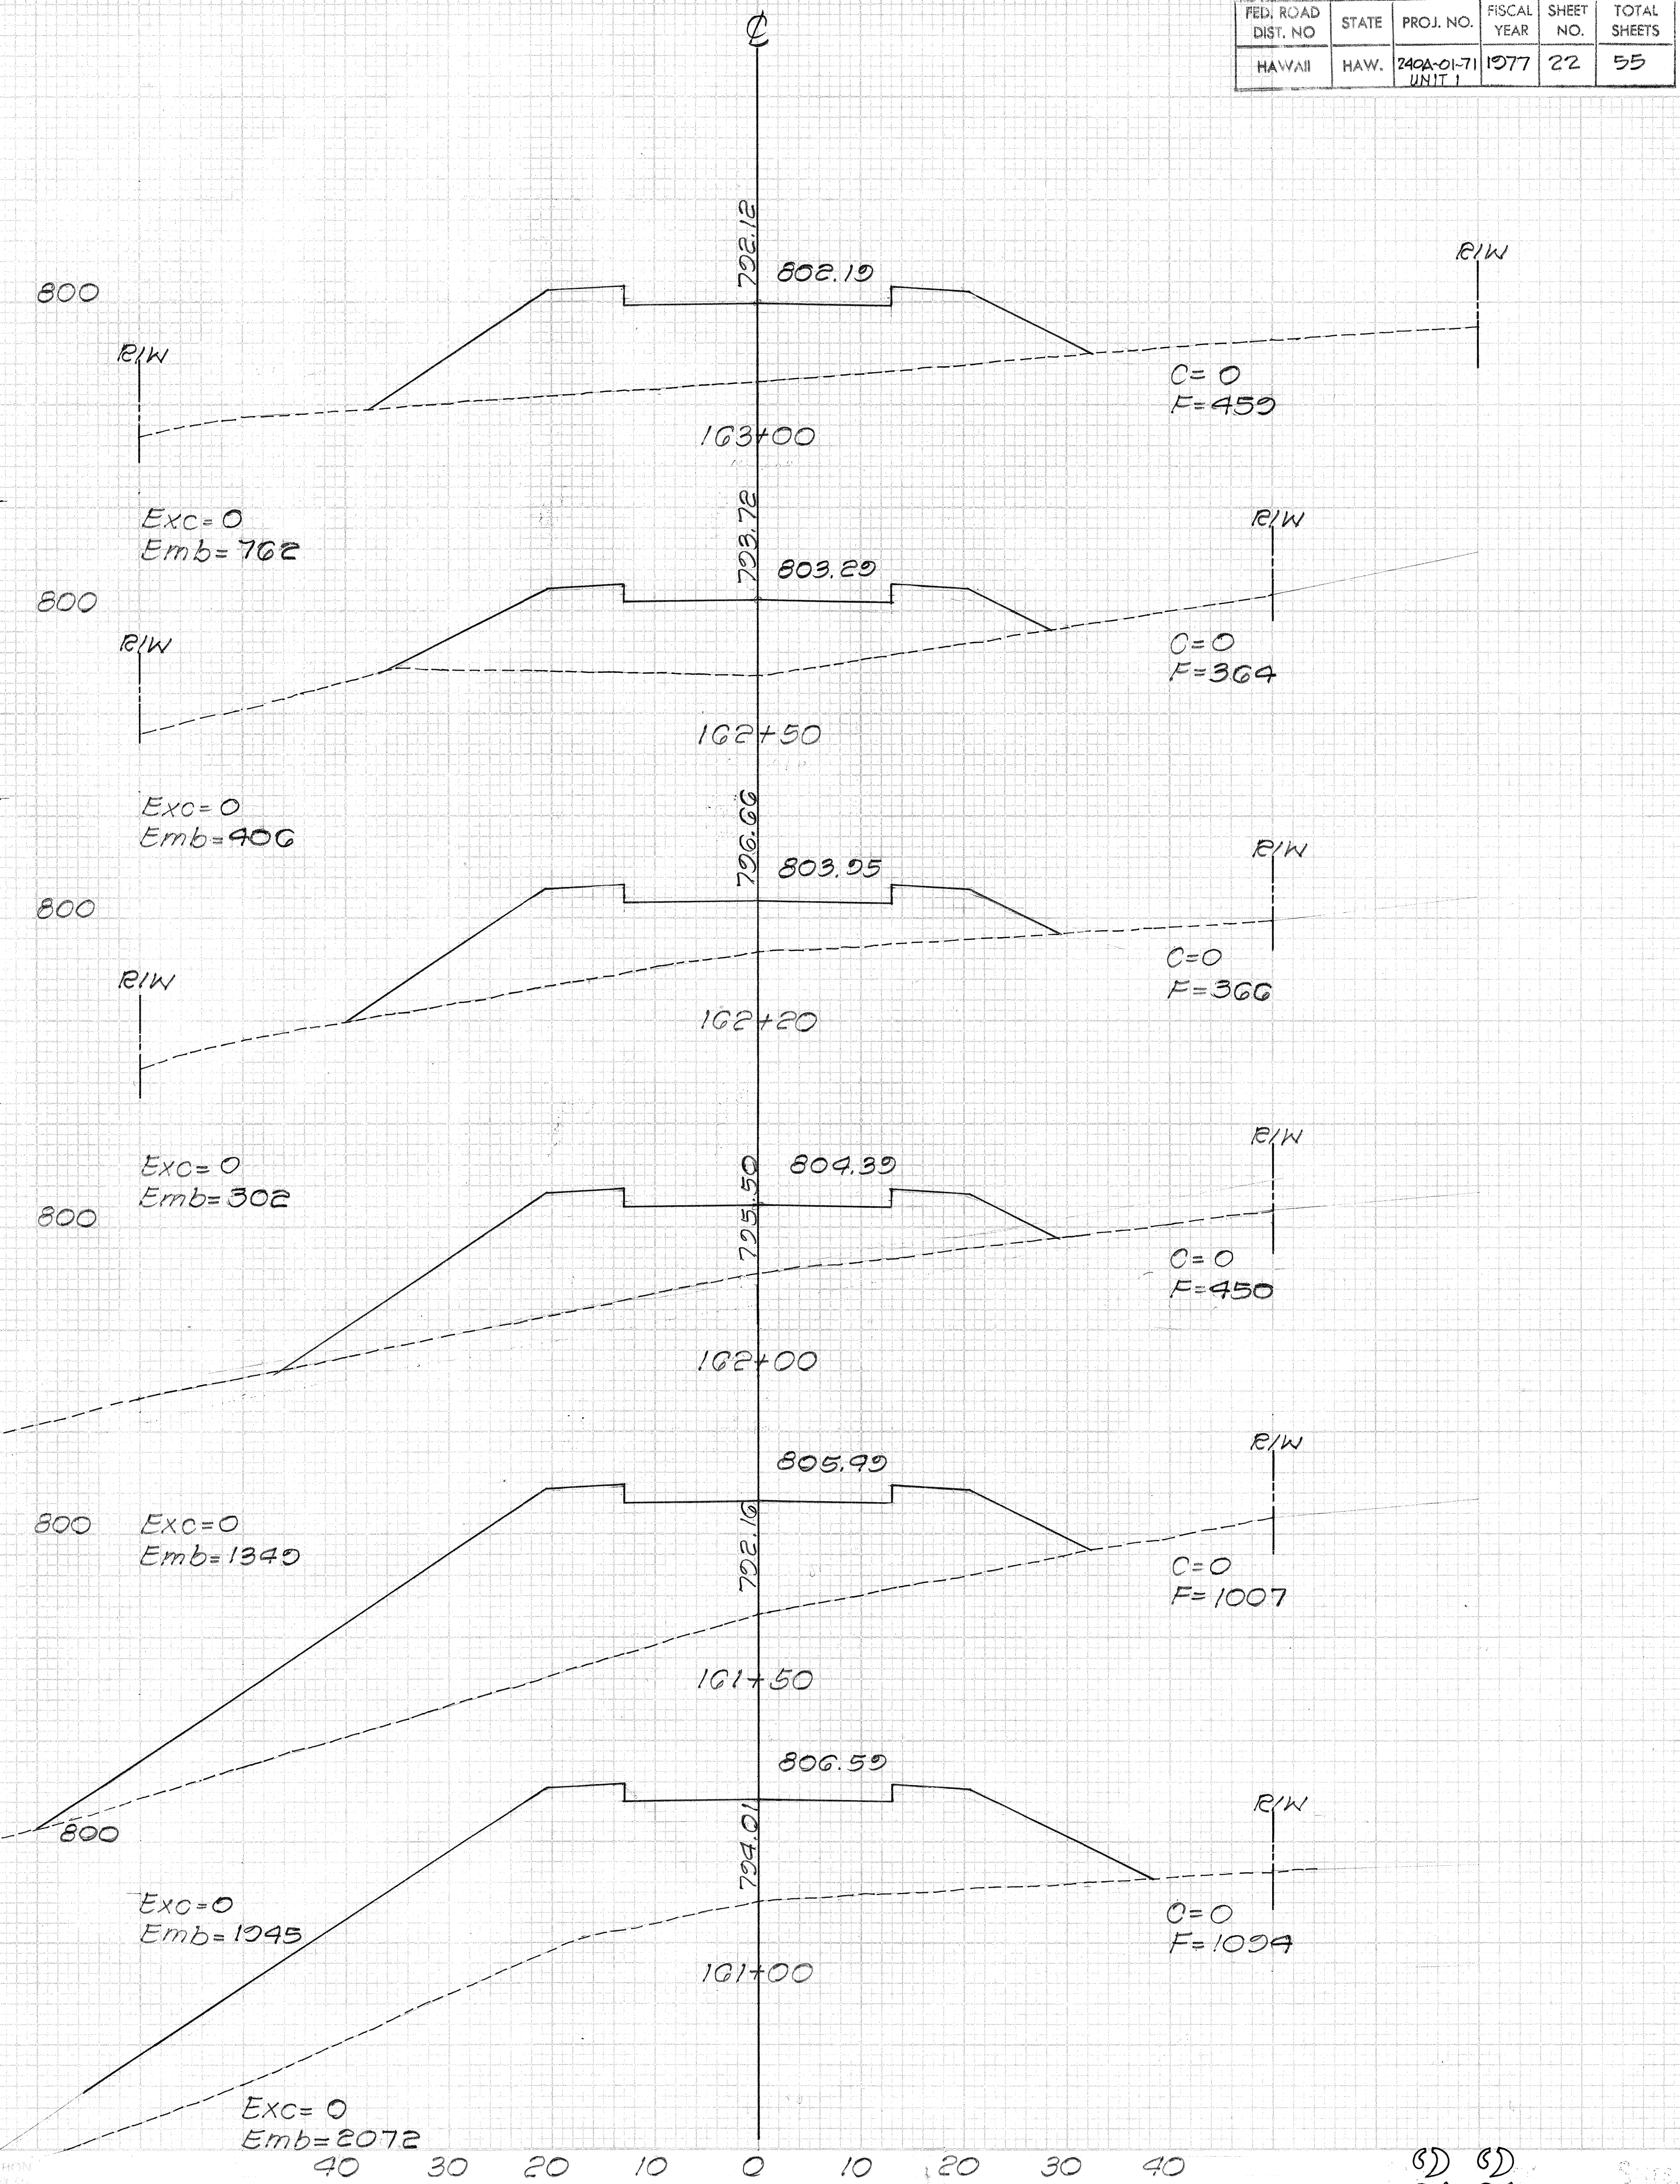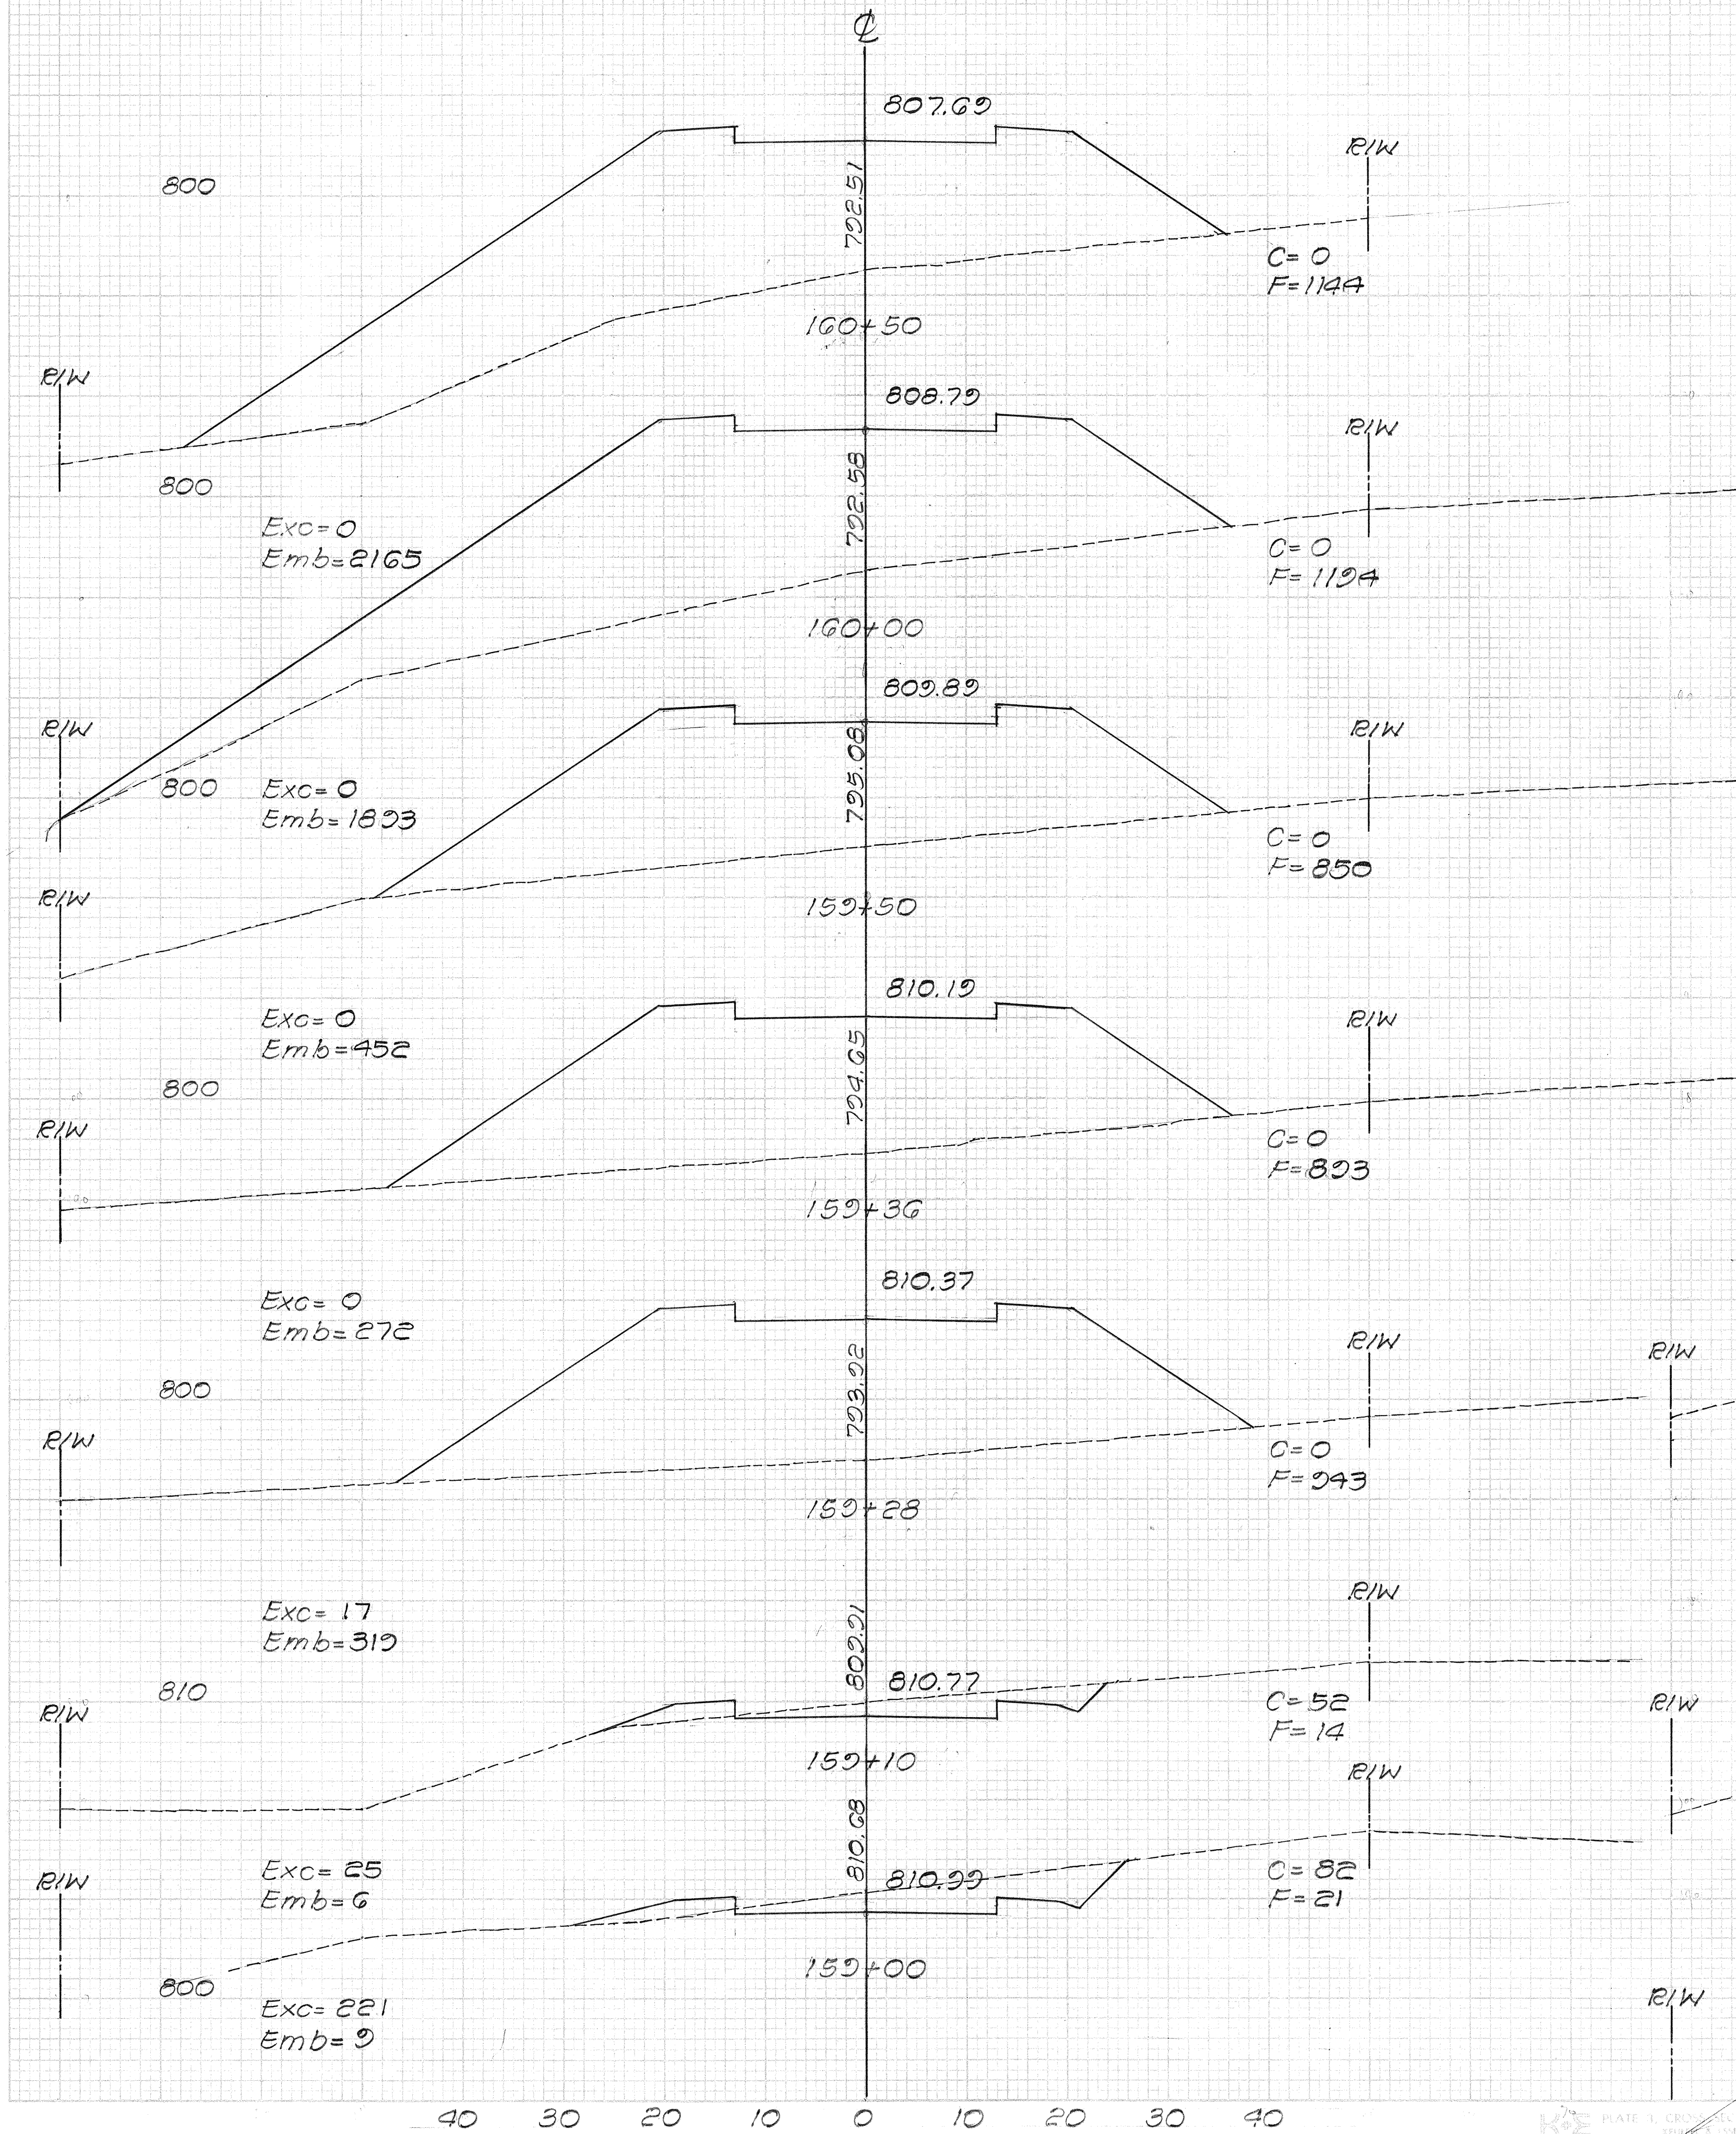

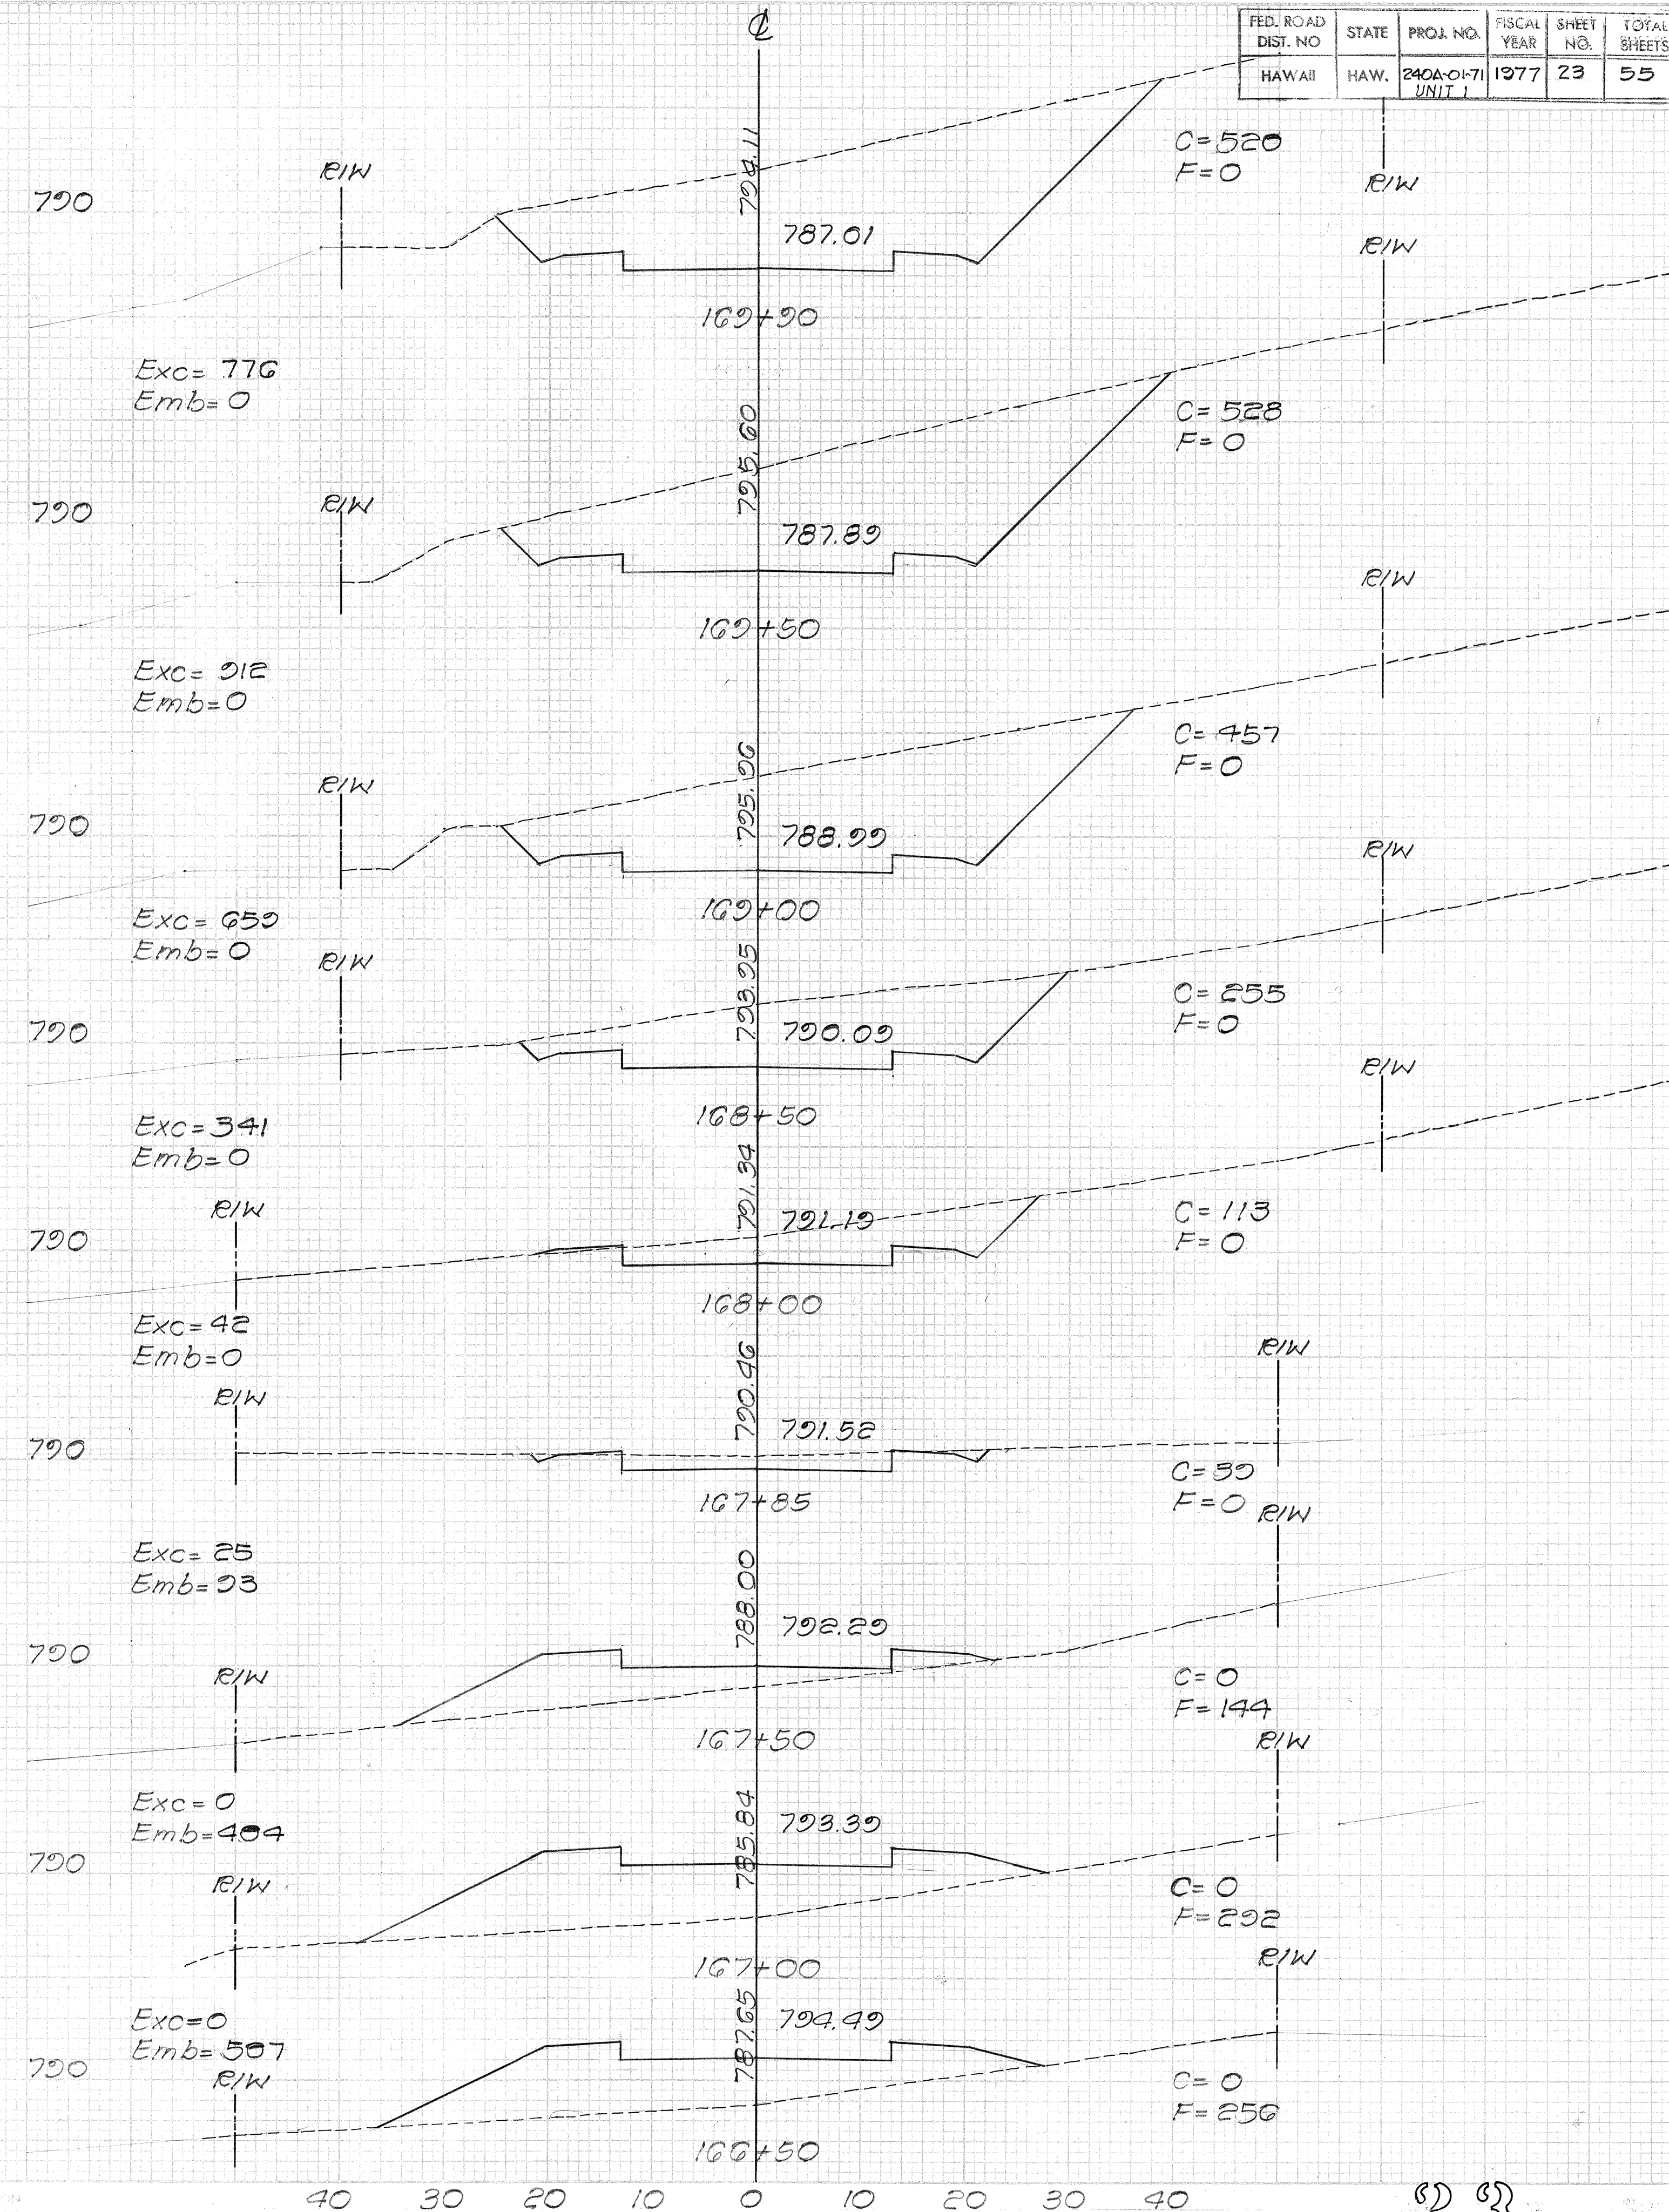


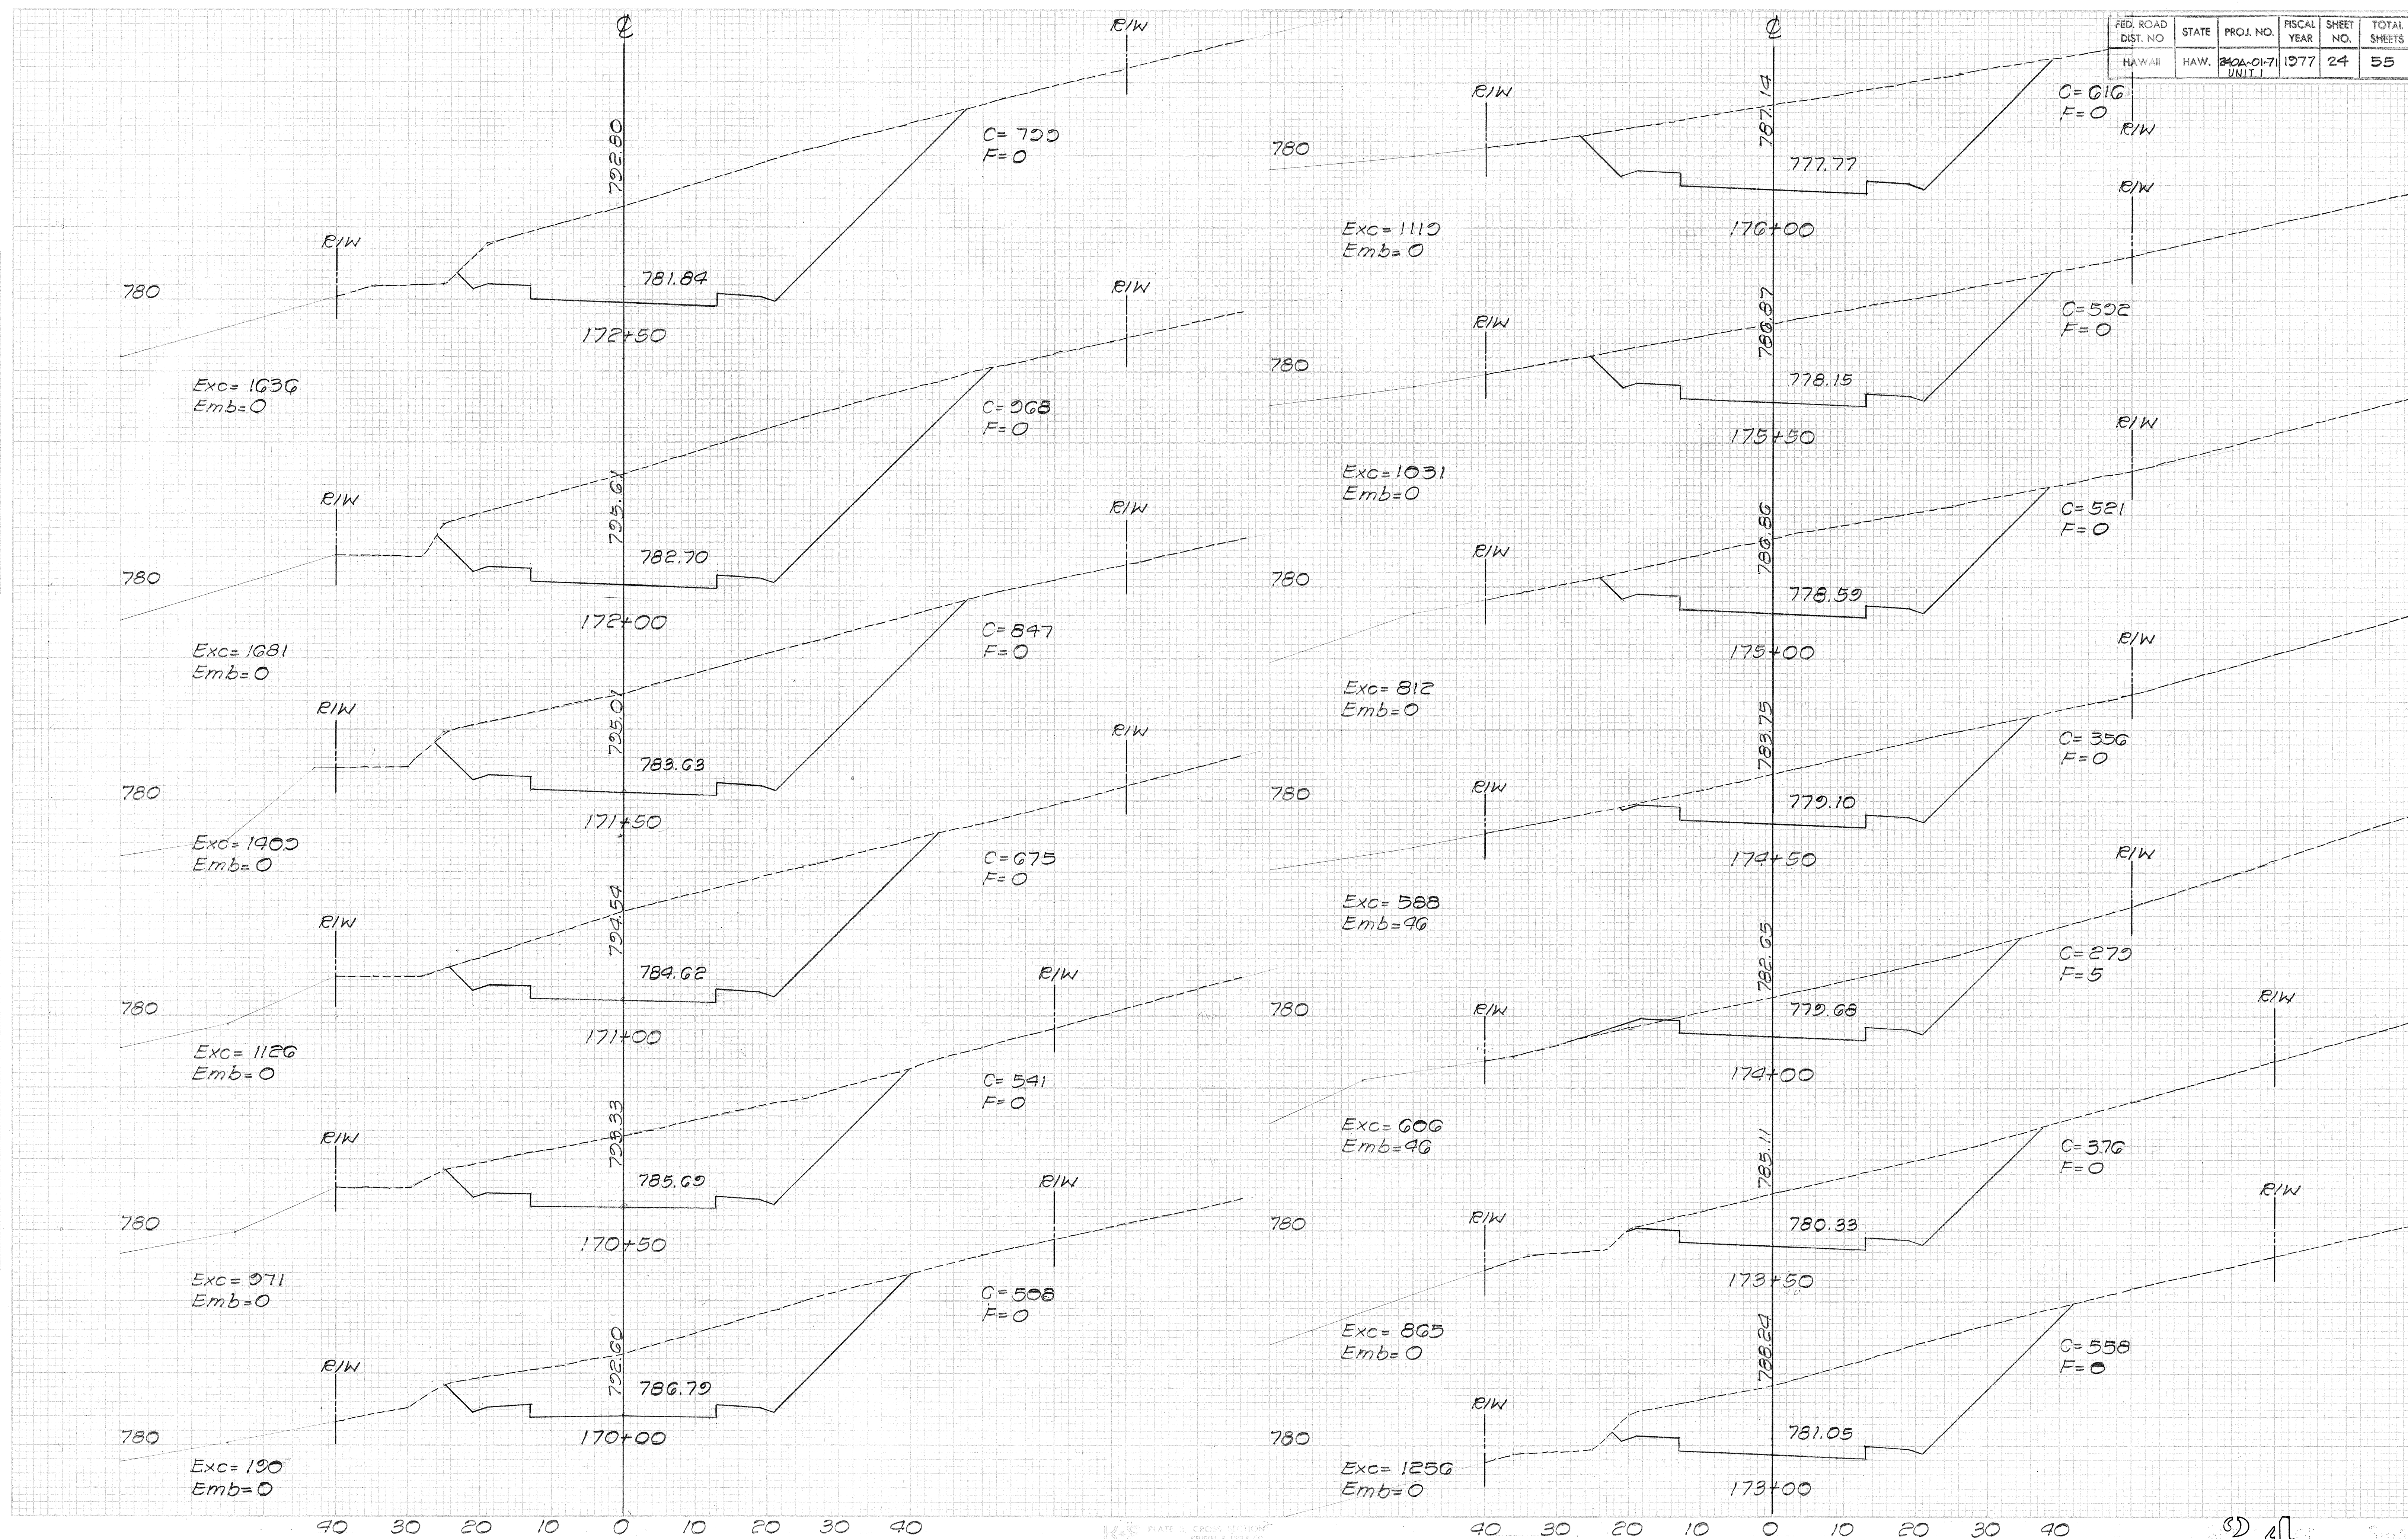

FINAL	DATE	BY
SURVEY		
NOTED		
BOOK		
NO.		

ORIGINAL	DATE	BY
SURVEY		
NOTED		
BOOK		
NO.		

FED. ROAD DIST. NO.	STATE	PROJ. NO.	FISCAL YEAR	SHEET NO.	TOTAL SHEETS
HAWAII	HAW.	240A-01-71 UNIT 1	1977	25	55

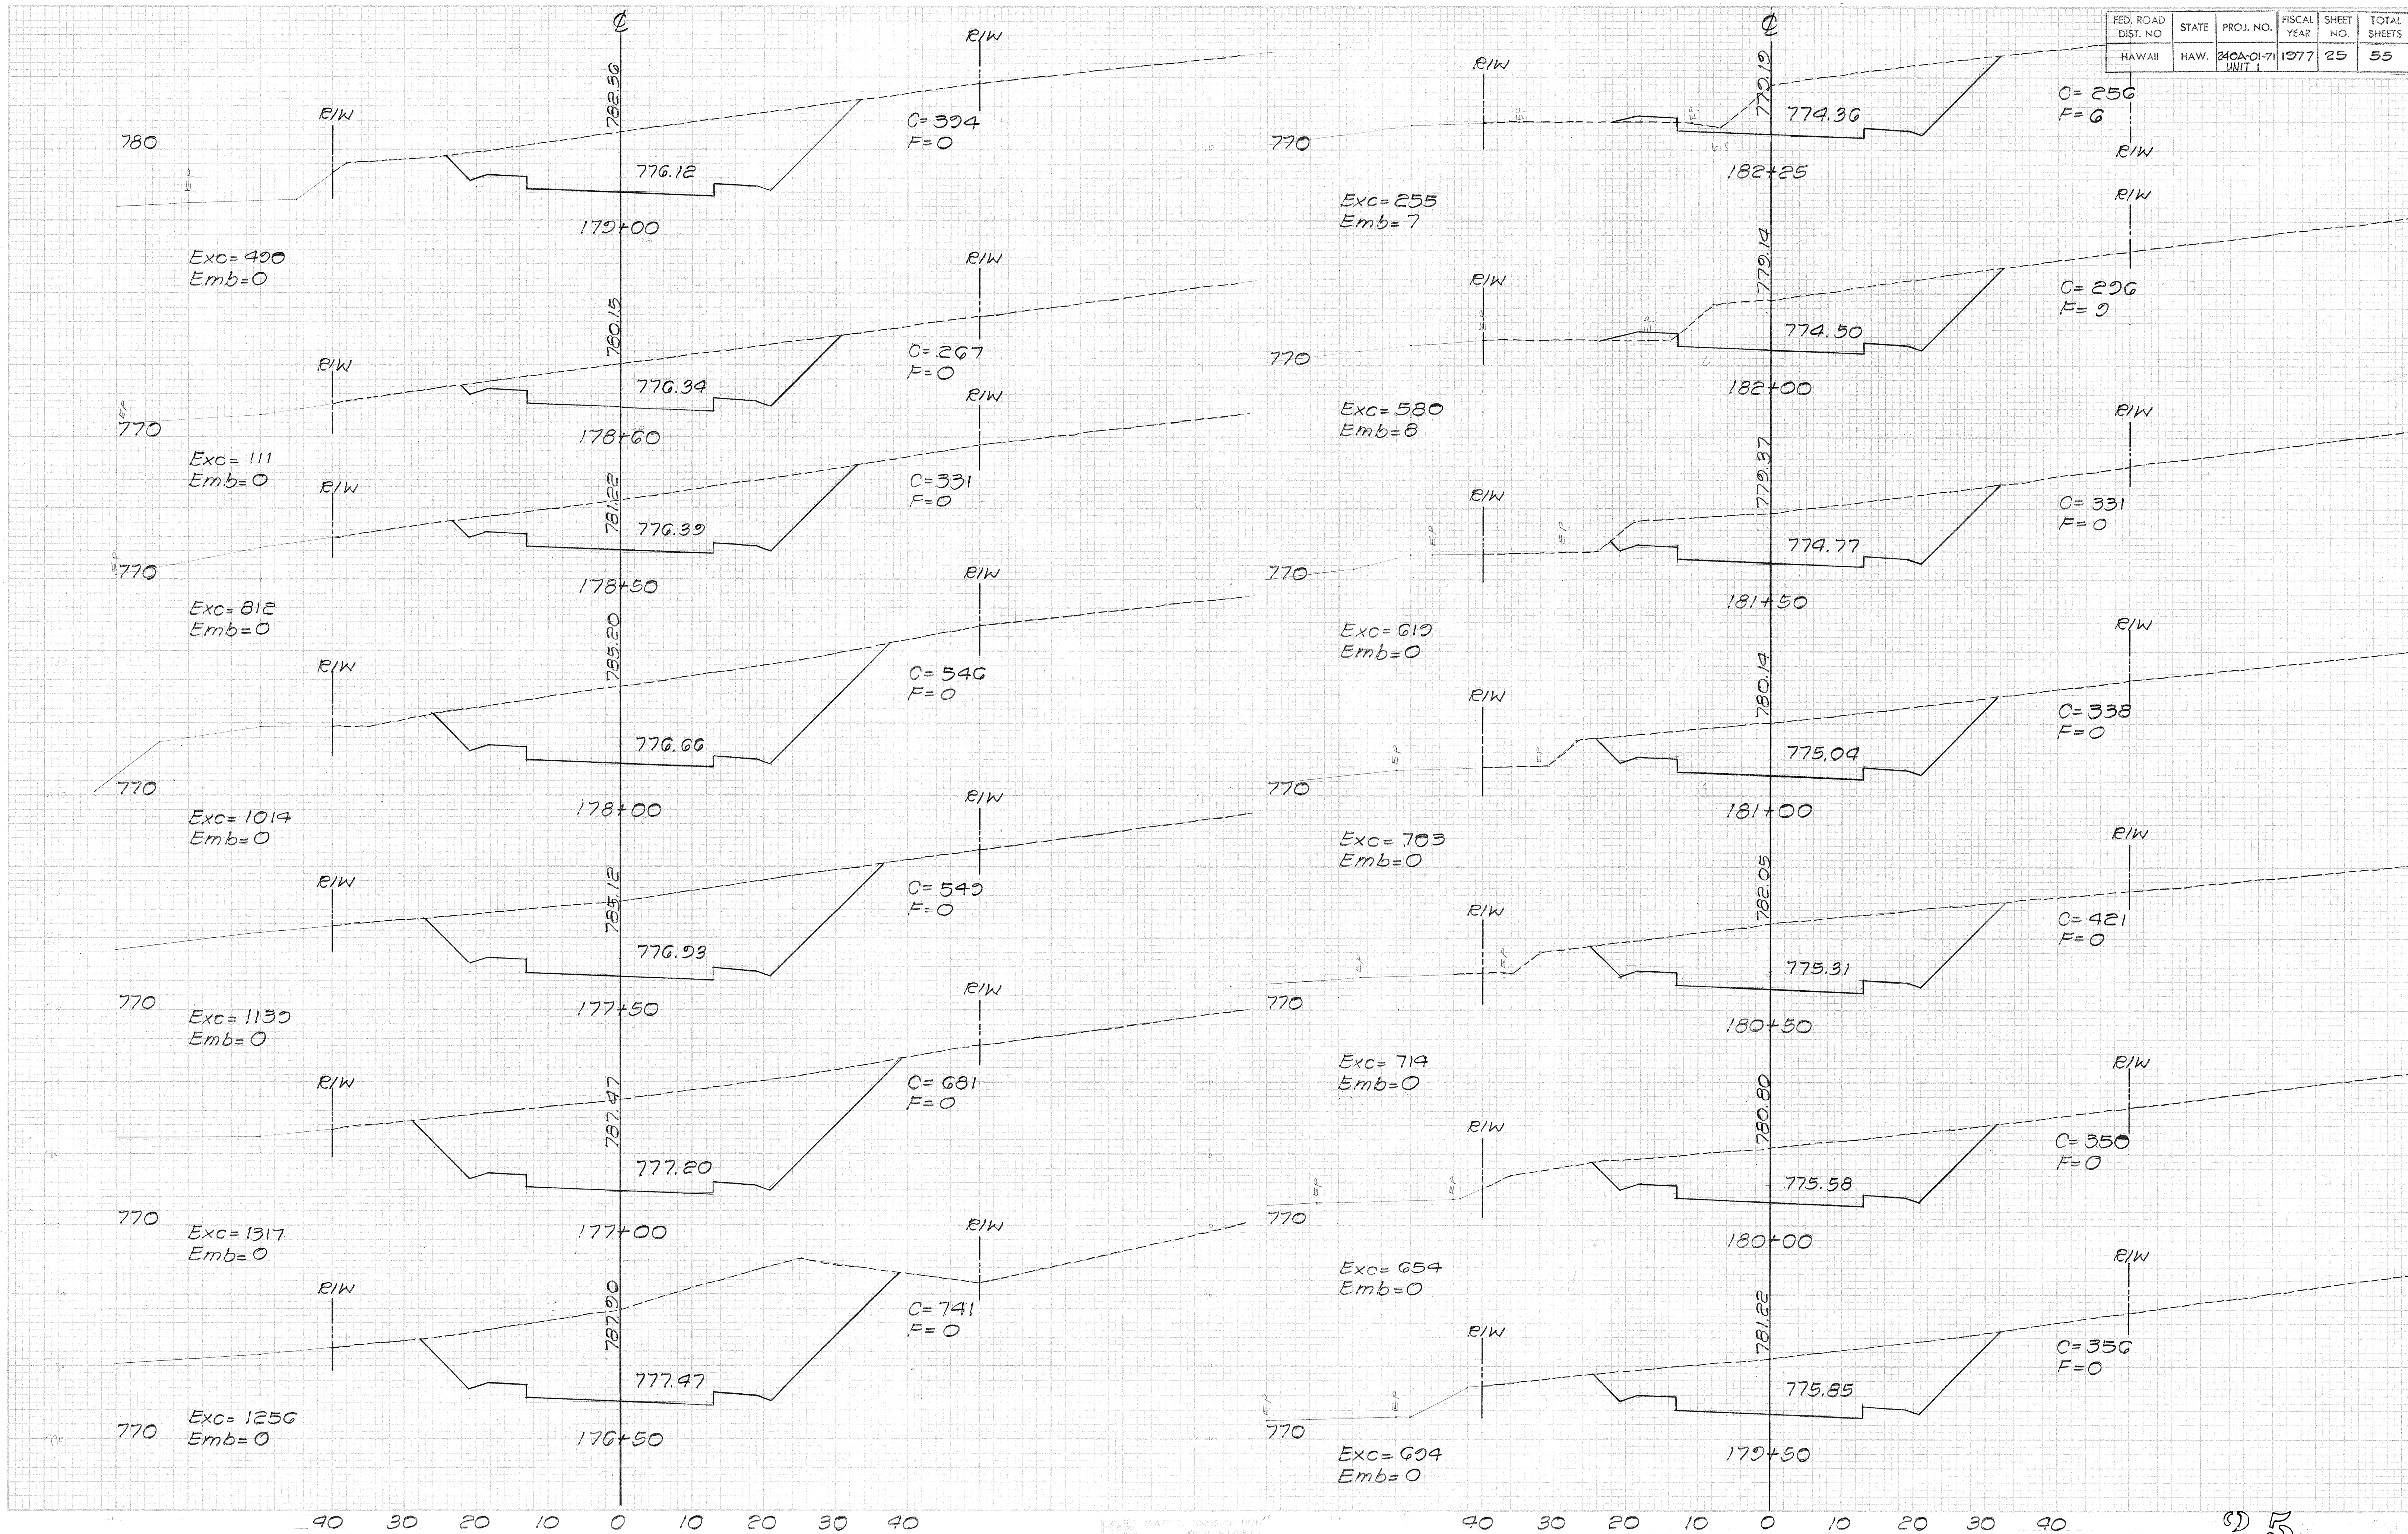

FED. ROAD DIST. NO.	STATE	PROJ. NO.	FISCAL YEAR	SHEET NO.	TOTAL SHEETS
HAWAII	HAW.	240A-01-71 UNIT 1	1977	26	55

FINAL SURVEY	DATE
SWAYED	BY
PLOTTED	
NOTE BOOK	
NO.	
AREAS CHECKED	

ORIGINAL SURVEY	DATE
SWAYED	BY
PLOTTED	
NOTE BOOK	
NO.	
AREAS CHECKED	

