




FED. ROAD DIST. NO.	STATE	PROJ. NO.	FISCAL YEAR	SHEET NO.	TOTAL SHEETS
HAWAII	HAW.	240A-01-71 UNIT 1	1977	13	55

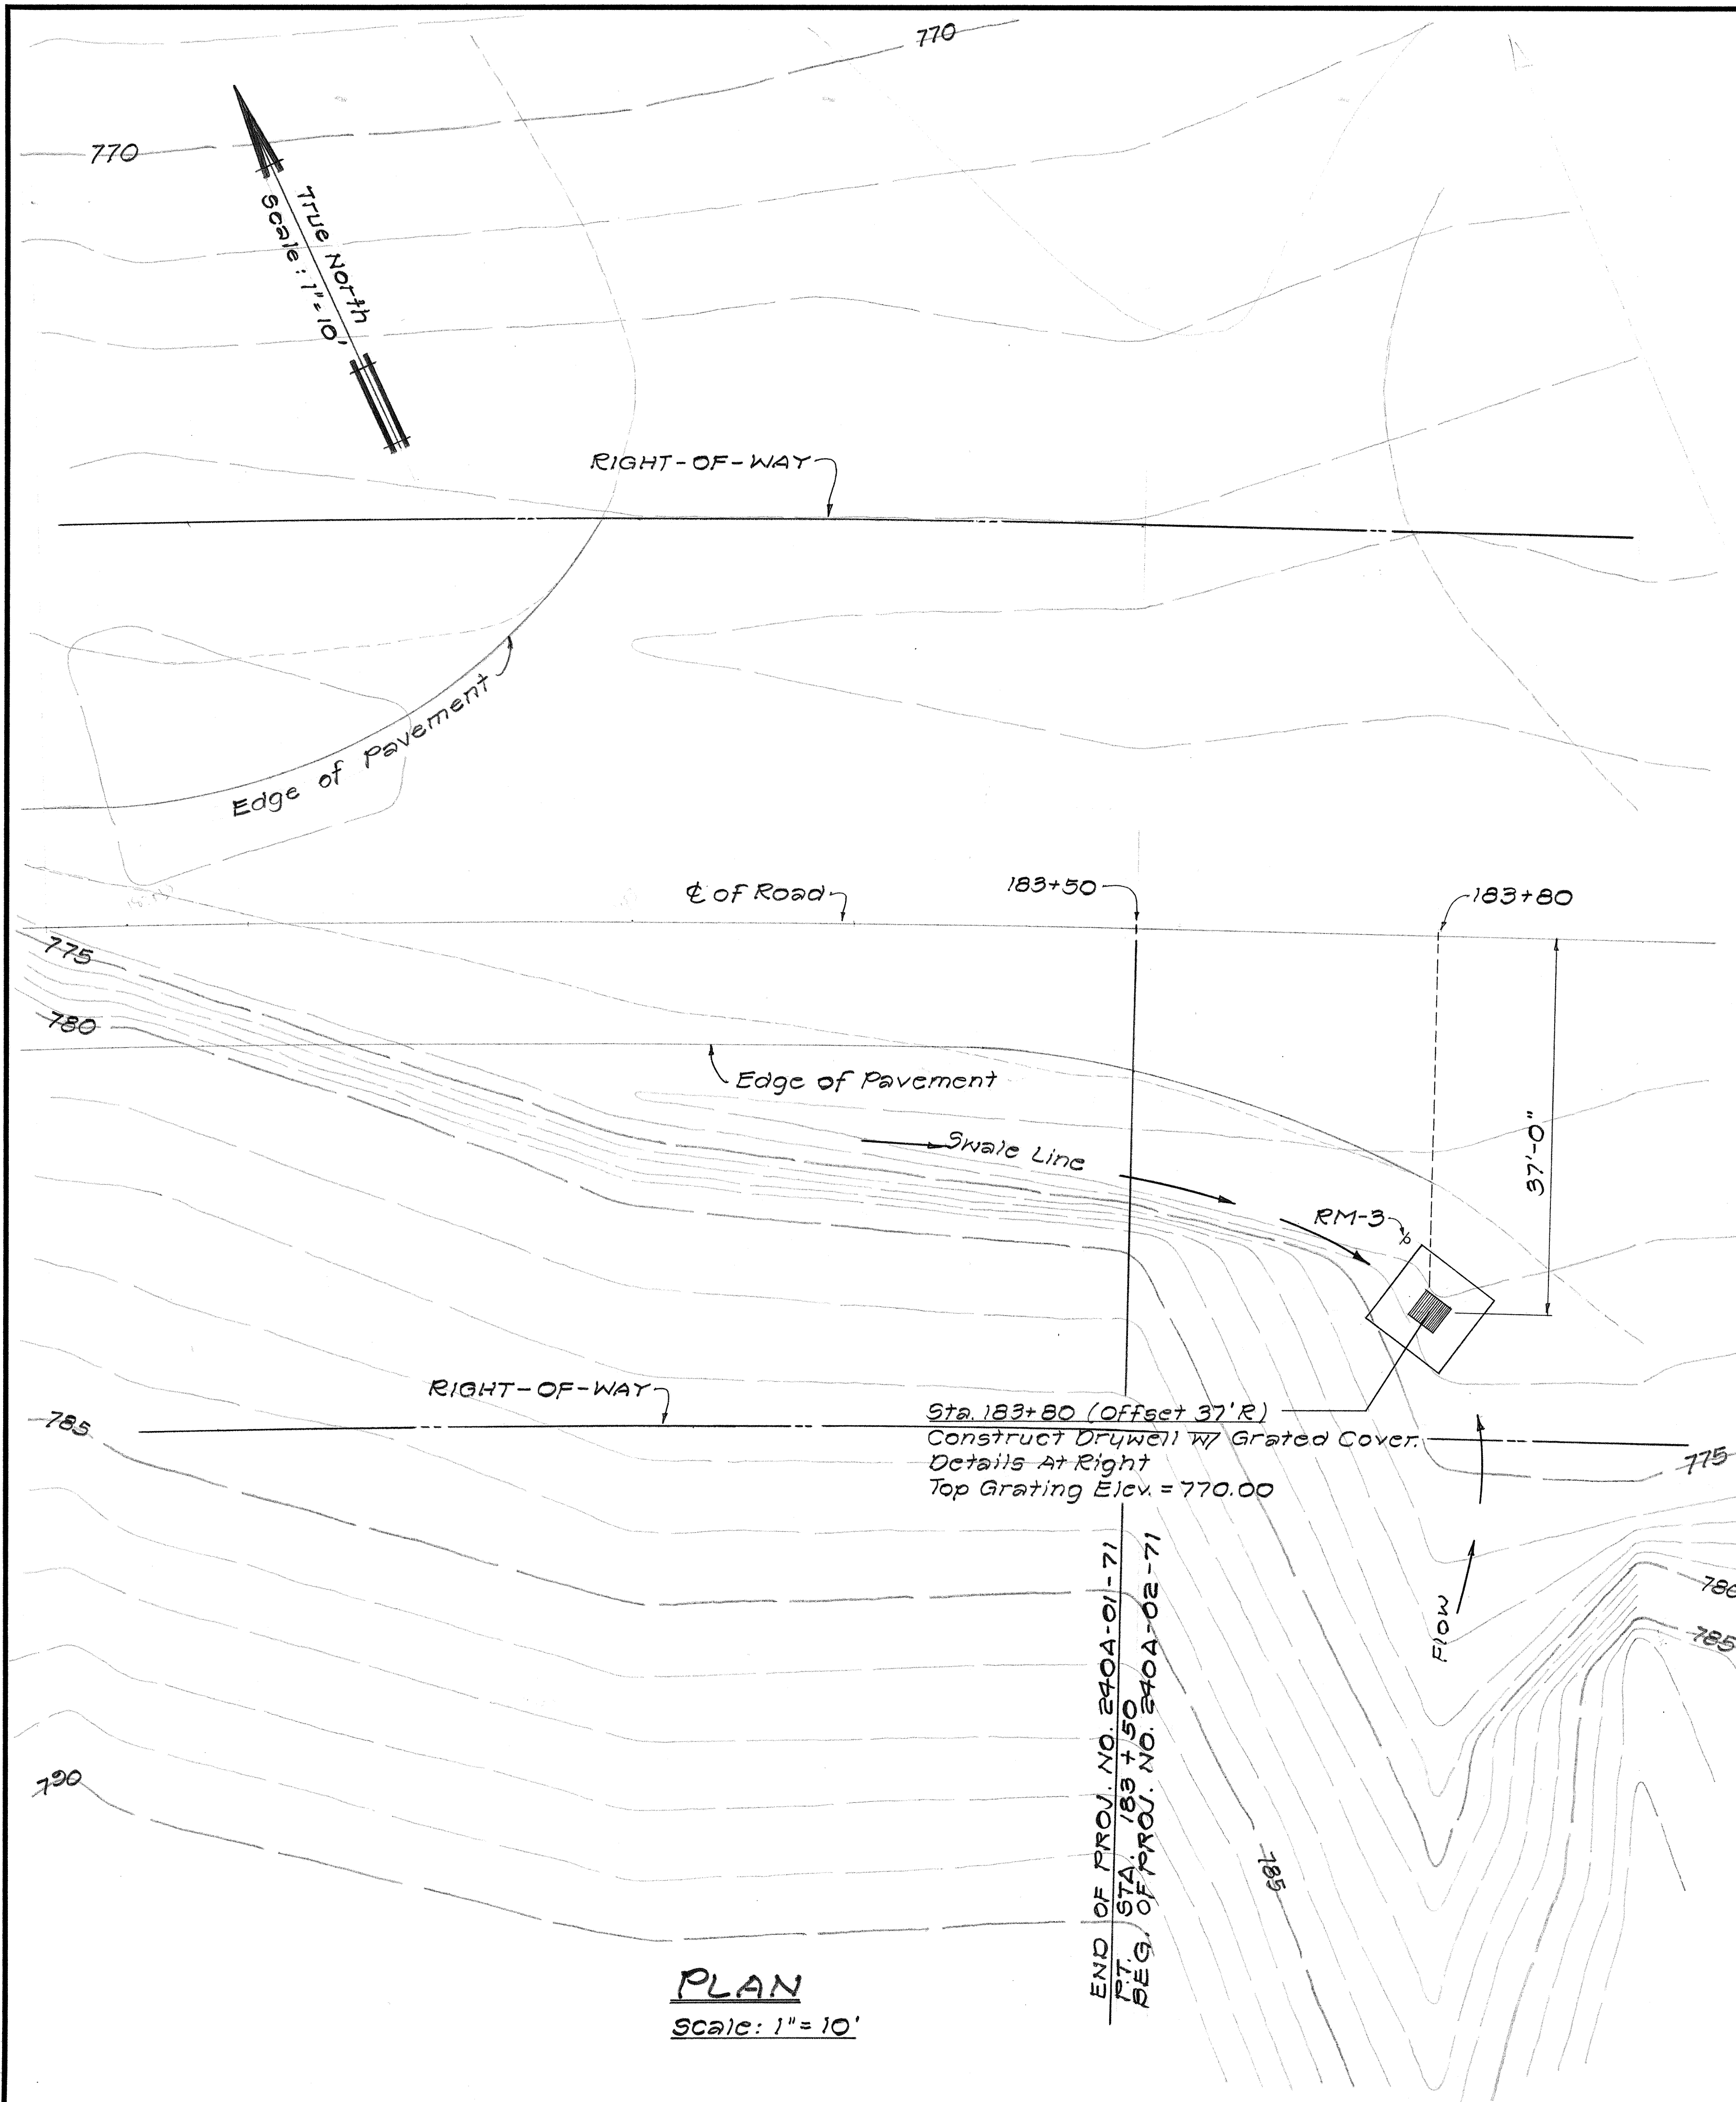

PLAN
Scale: 1" = 10'

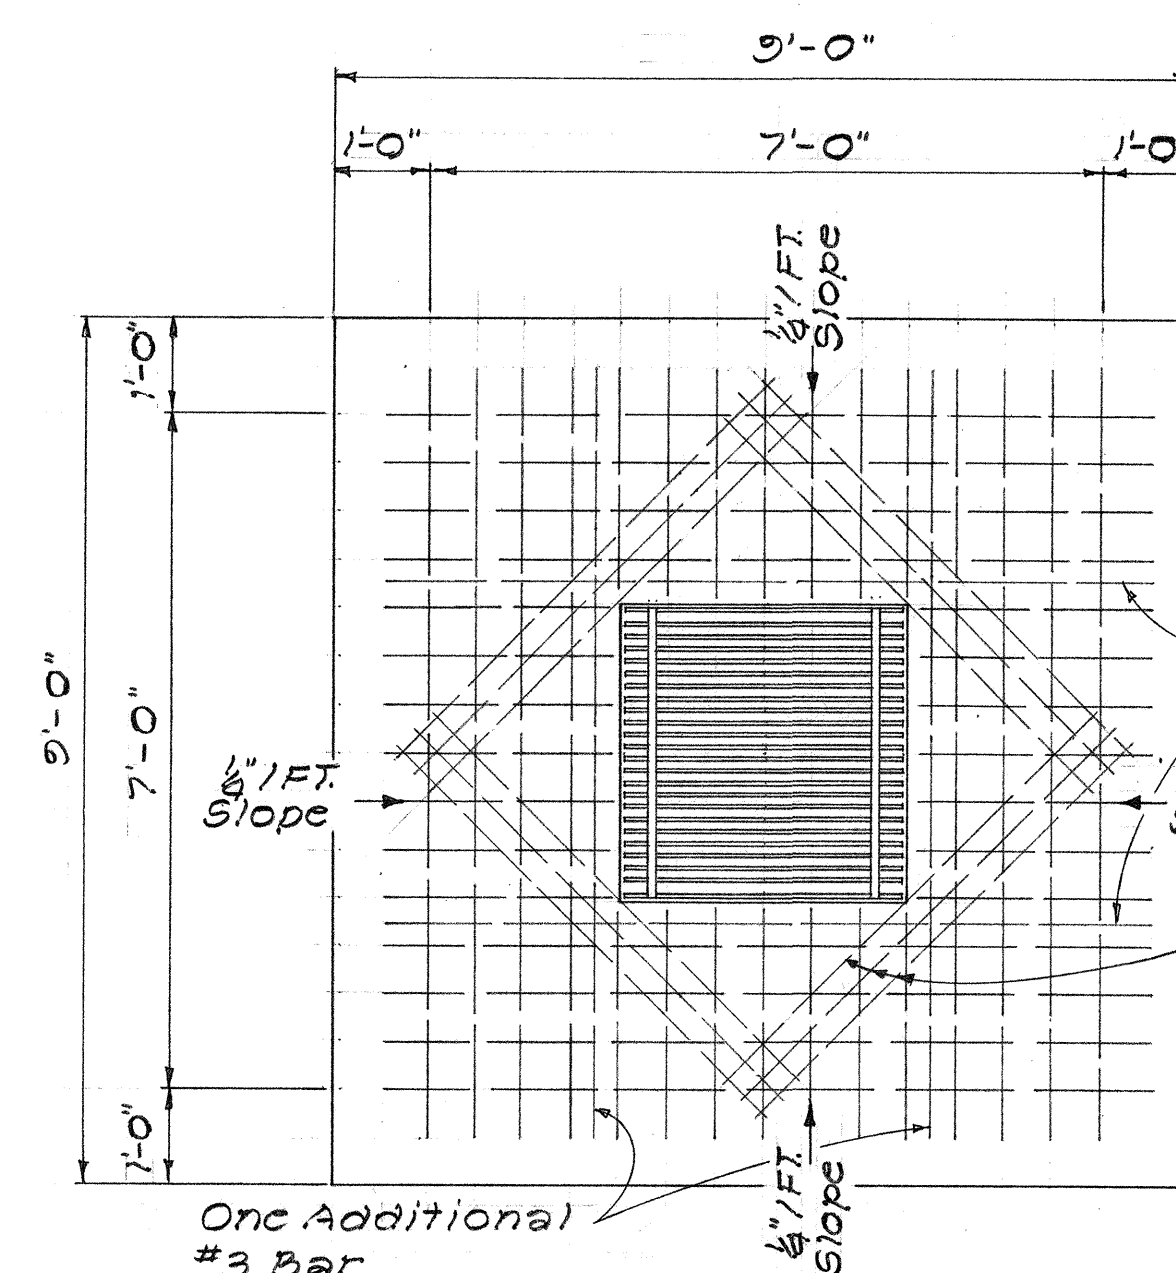


PLAN
Scale: 1/2" = 1'-0"

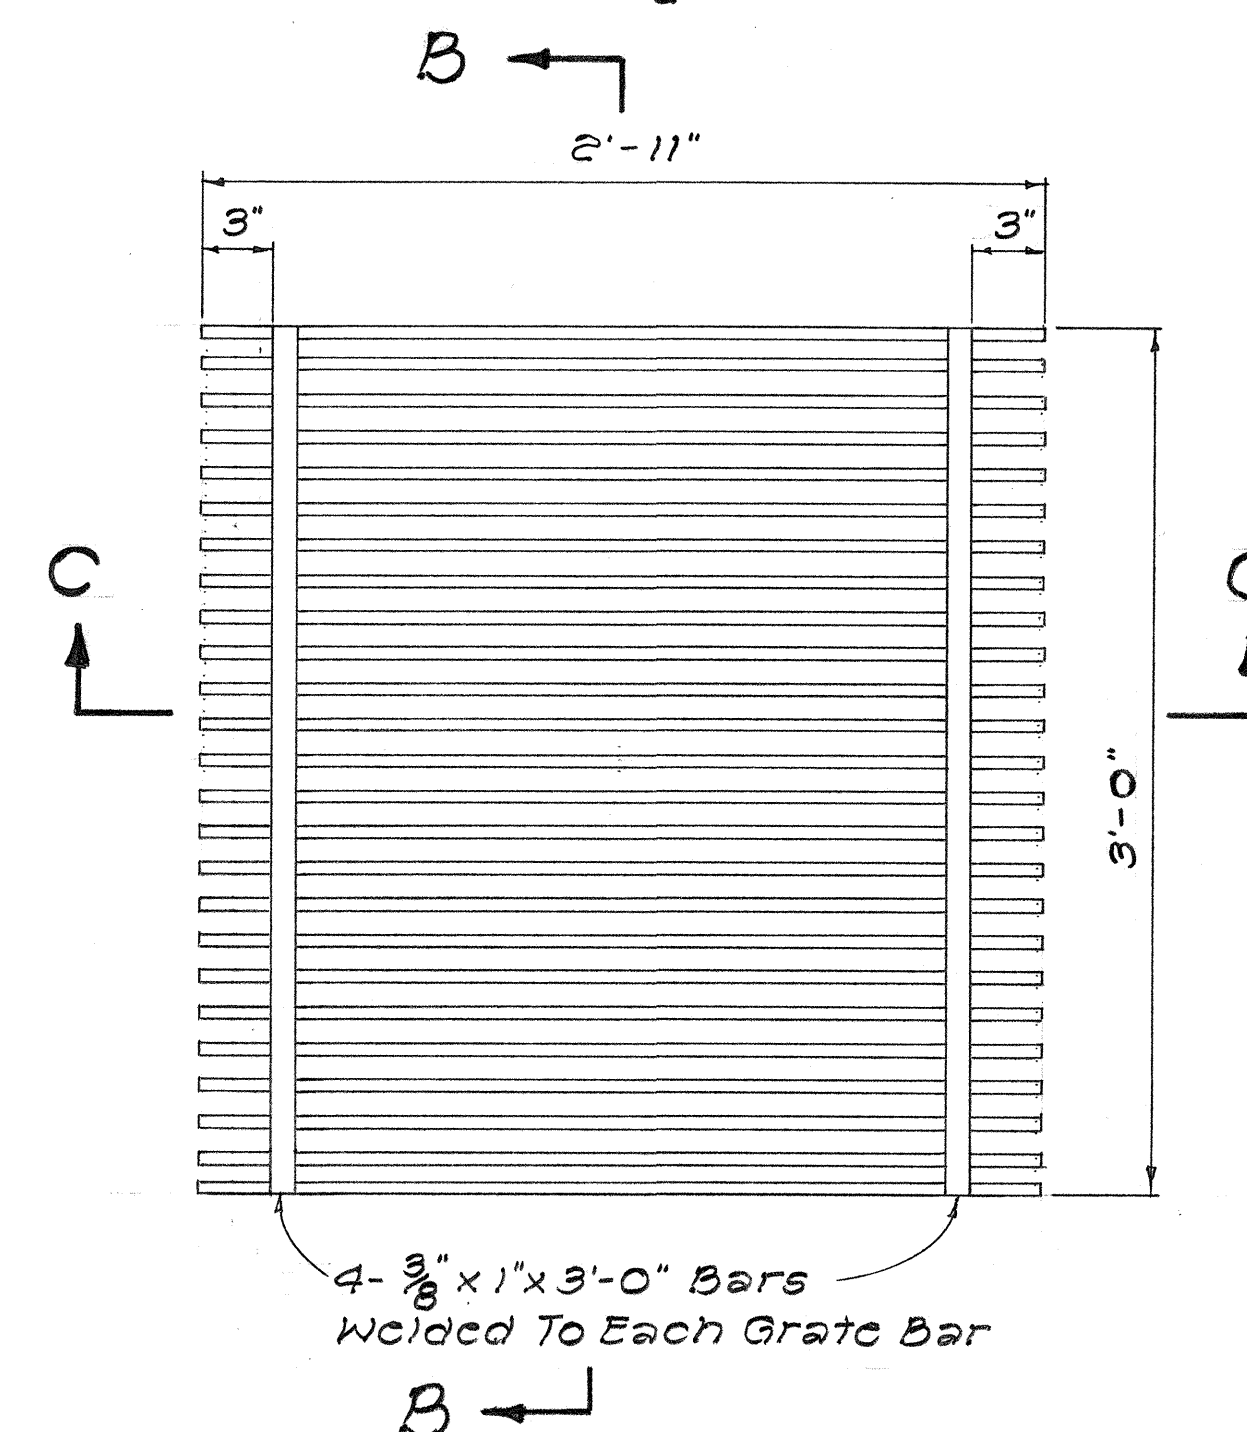


GRATING
Scale: 1 1/2" = 1'-0"

NOTE


1. All weld 5/16".
2. All steel shall be structural grade.
3. Grates and frame Ls shall be hot dip galvanized after fabrication in accordance with section 44.3(H) of the Standard Specification.
4. Minimum depth shall be 20'-0" or as directed by the Engineer.

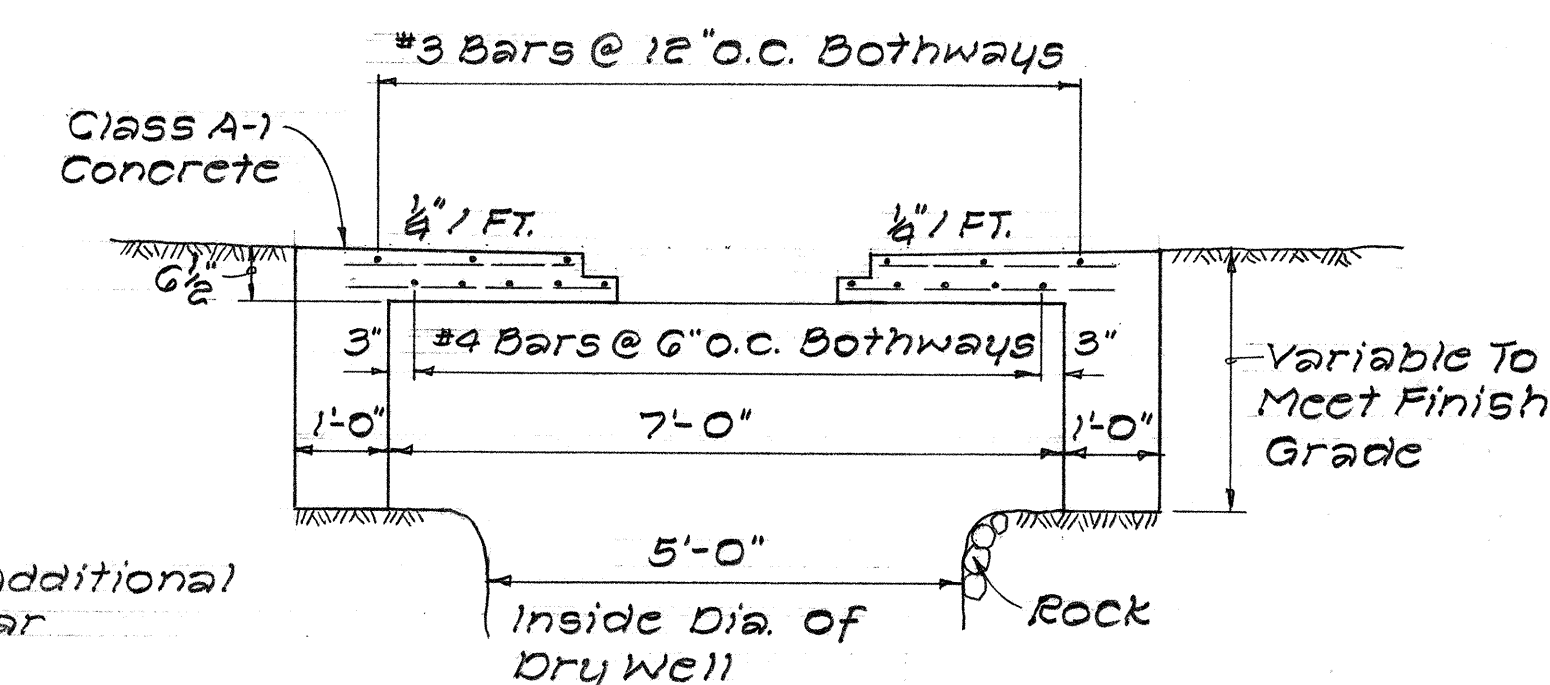


SECTION A-A
Scale: 1/2" = 1'-0"

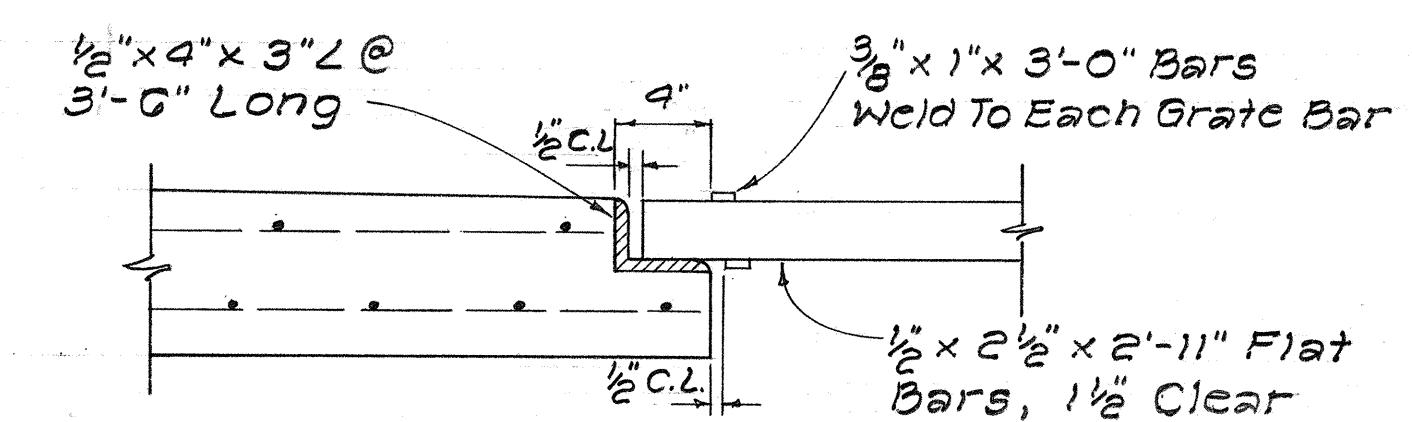

SECTION C-C
Scale: 1 1/2" = 1'-0"

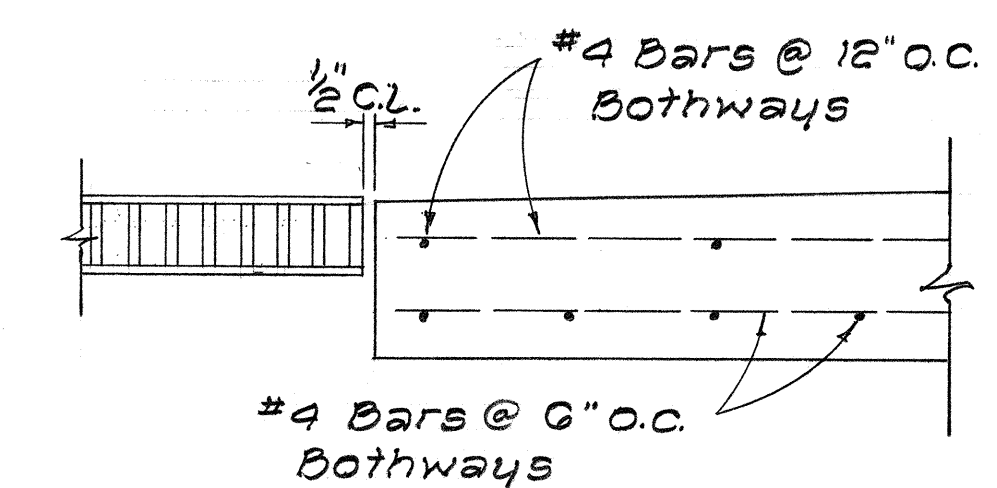

SECTION B-B
Scale: 1 1/2" = 1'-0"

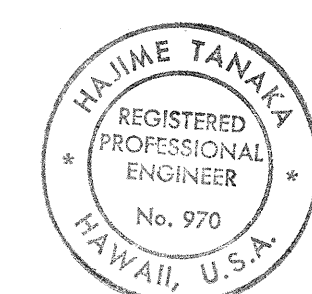

THIS WORK WAS PREPARED BY
ME OR UNDER MY SUPERVISION
H. Tanaka

STATE OF HAWAII
DEPARTMENT OF TRANSPORTATION
HIGHWAYS DIVISION

**DRYWELL AT STA. 183+80
(OFFSET 37' RIGHT)**

HONOLULU-WAIPIO RD. PROJ. NO. 240A-01-71 Unit 1

SHEET No. 1 OF 1 SHEETS