


FED. ROAD DIST. NO.	STATE	PROJ. NO.	FISCAL YEAR	SHEET NO.	TOTAL SHEETS
HAWAII	HAW.	240A-01-71 UNIT 1	1977	7	55

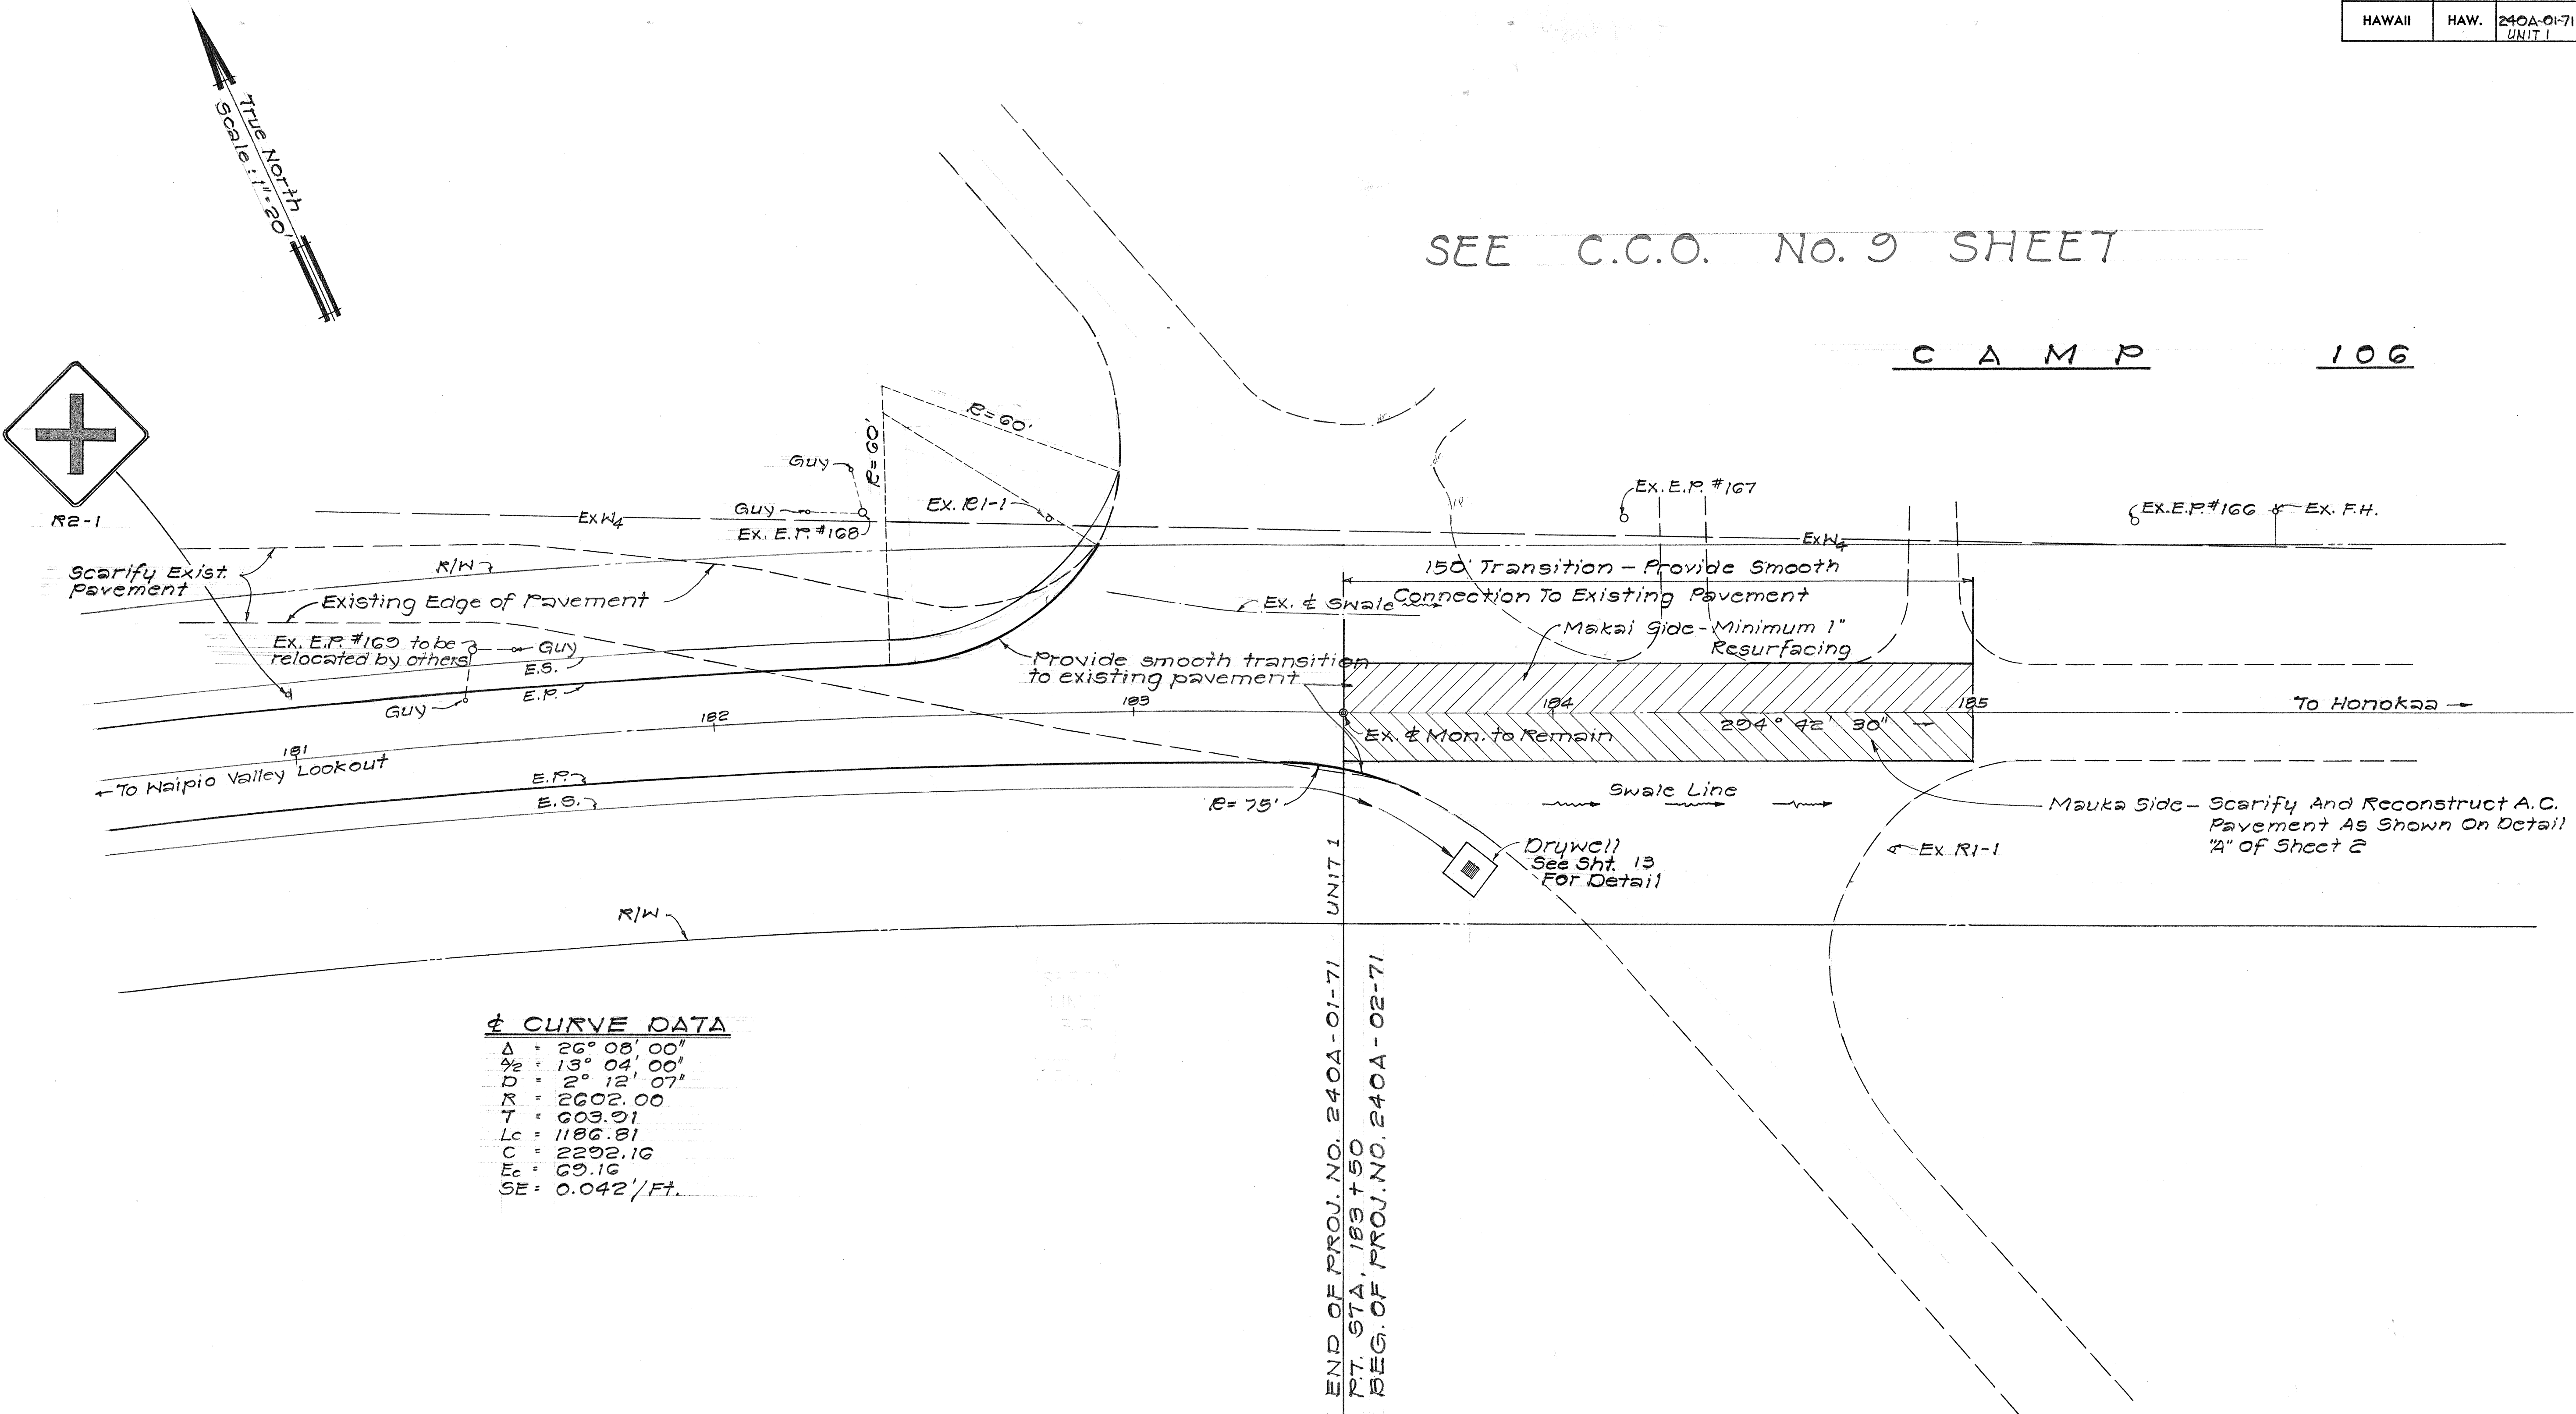


± CURVE DATA

Δ	= 26° 08' 00"
Δ/2	= 13° 04' 00"
D	= 2° 12' 07"
R	= 2602.00
T	= 603.91
Lc	= 1186.81
C	= 2292.16
E _c	= 69.16
SE	= 0.042'/Ft.

SURVEY PLOTTED BY	DATE
DESIGNED BY	
TRACED BY	
NOTED BY	
CHECKED BY	
ORIGINAL PLAN	
NOTE BOOK	
No.	

THIS WORK WAS PREPARED BY
ME OR UNDER MY SUPERVISION
[Signature]

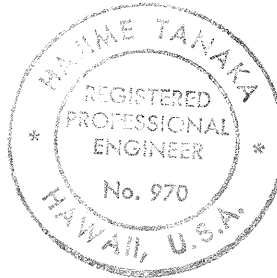

STATE OF HAWAII
DEPARTMENT OF TRANSPORTATION
HIGHWAYS DIVISION

INTERSECTION DETAILS
AT END OF PROJECT
PROJ. NO. 240A-01-71
Unit 1

SHEET No. 1 OF 1 SHEETS