
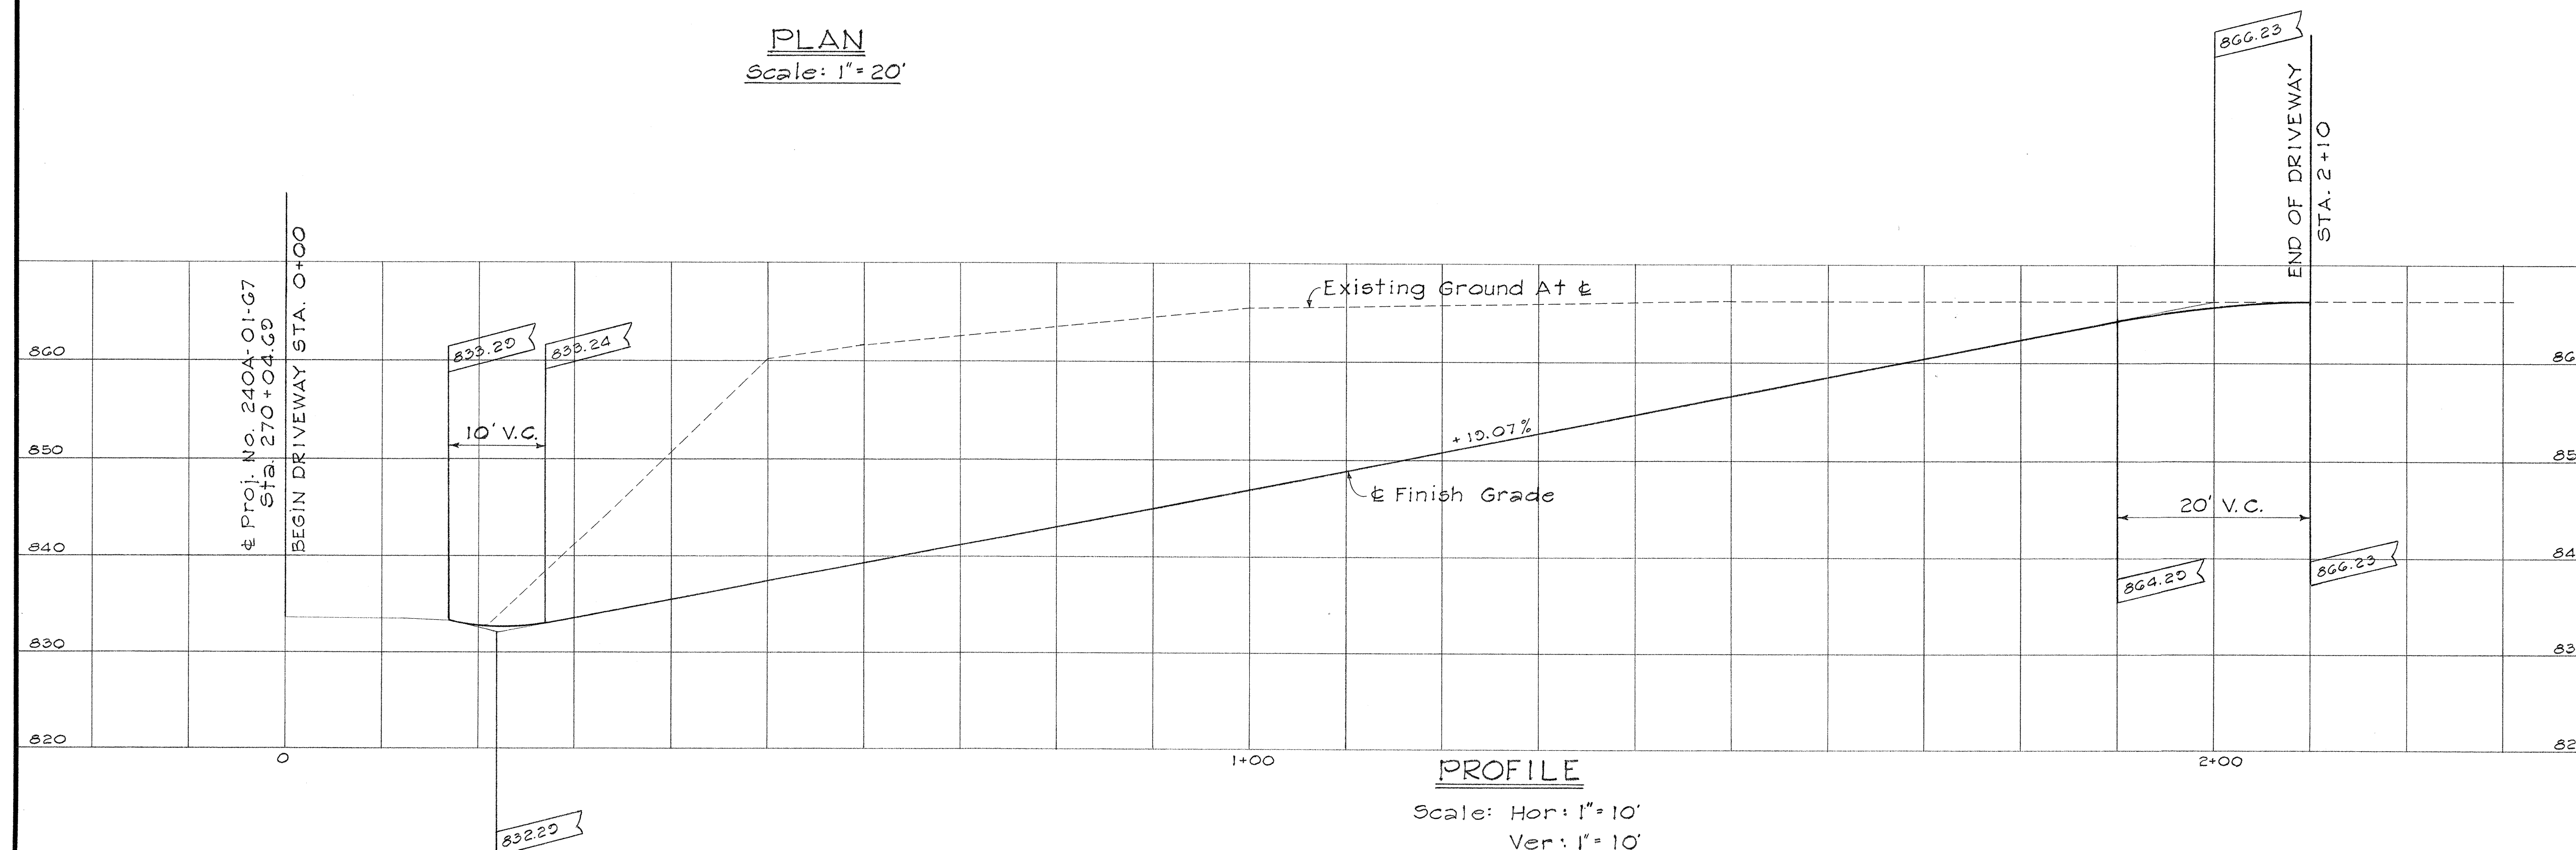
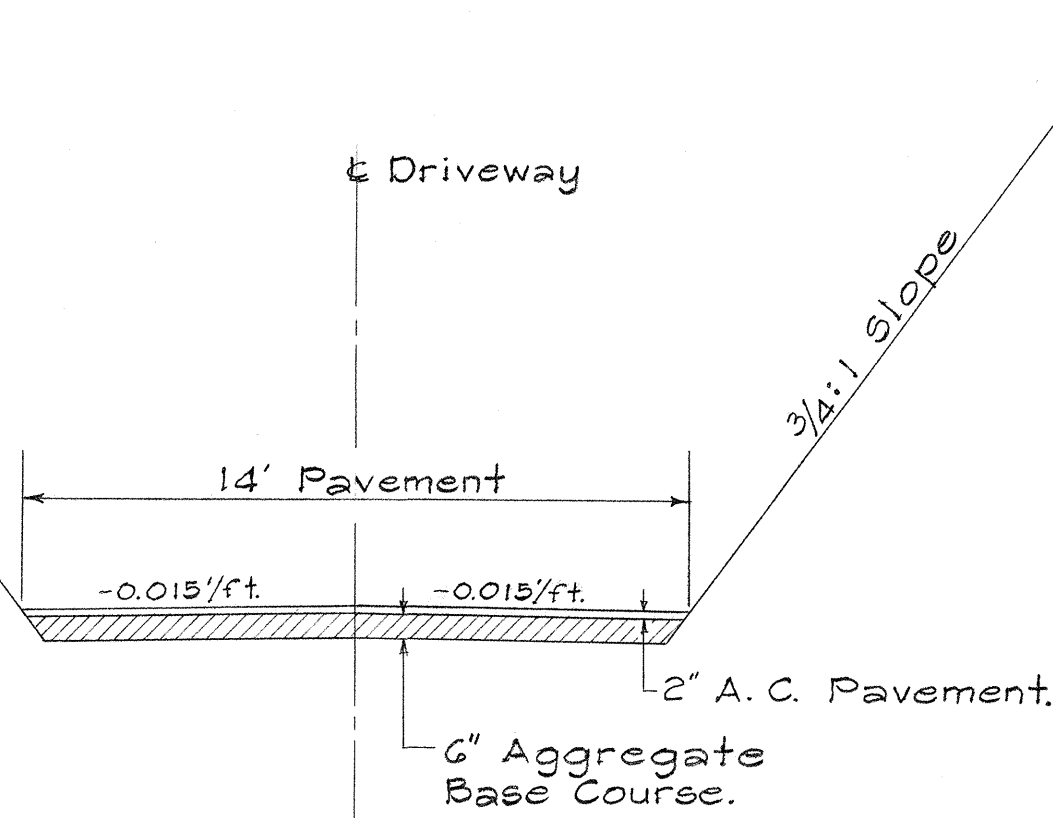


FED. ROAD DIST. NO.	STATE	PROJ. NO.	FISCAL YEAR	SHEET NO.	TOTAL SHEETS
HAWAII	HAW.	240A-01-71 UNIT 1	1977	30	55

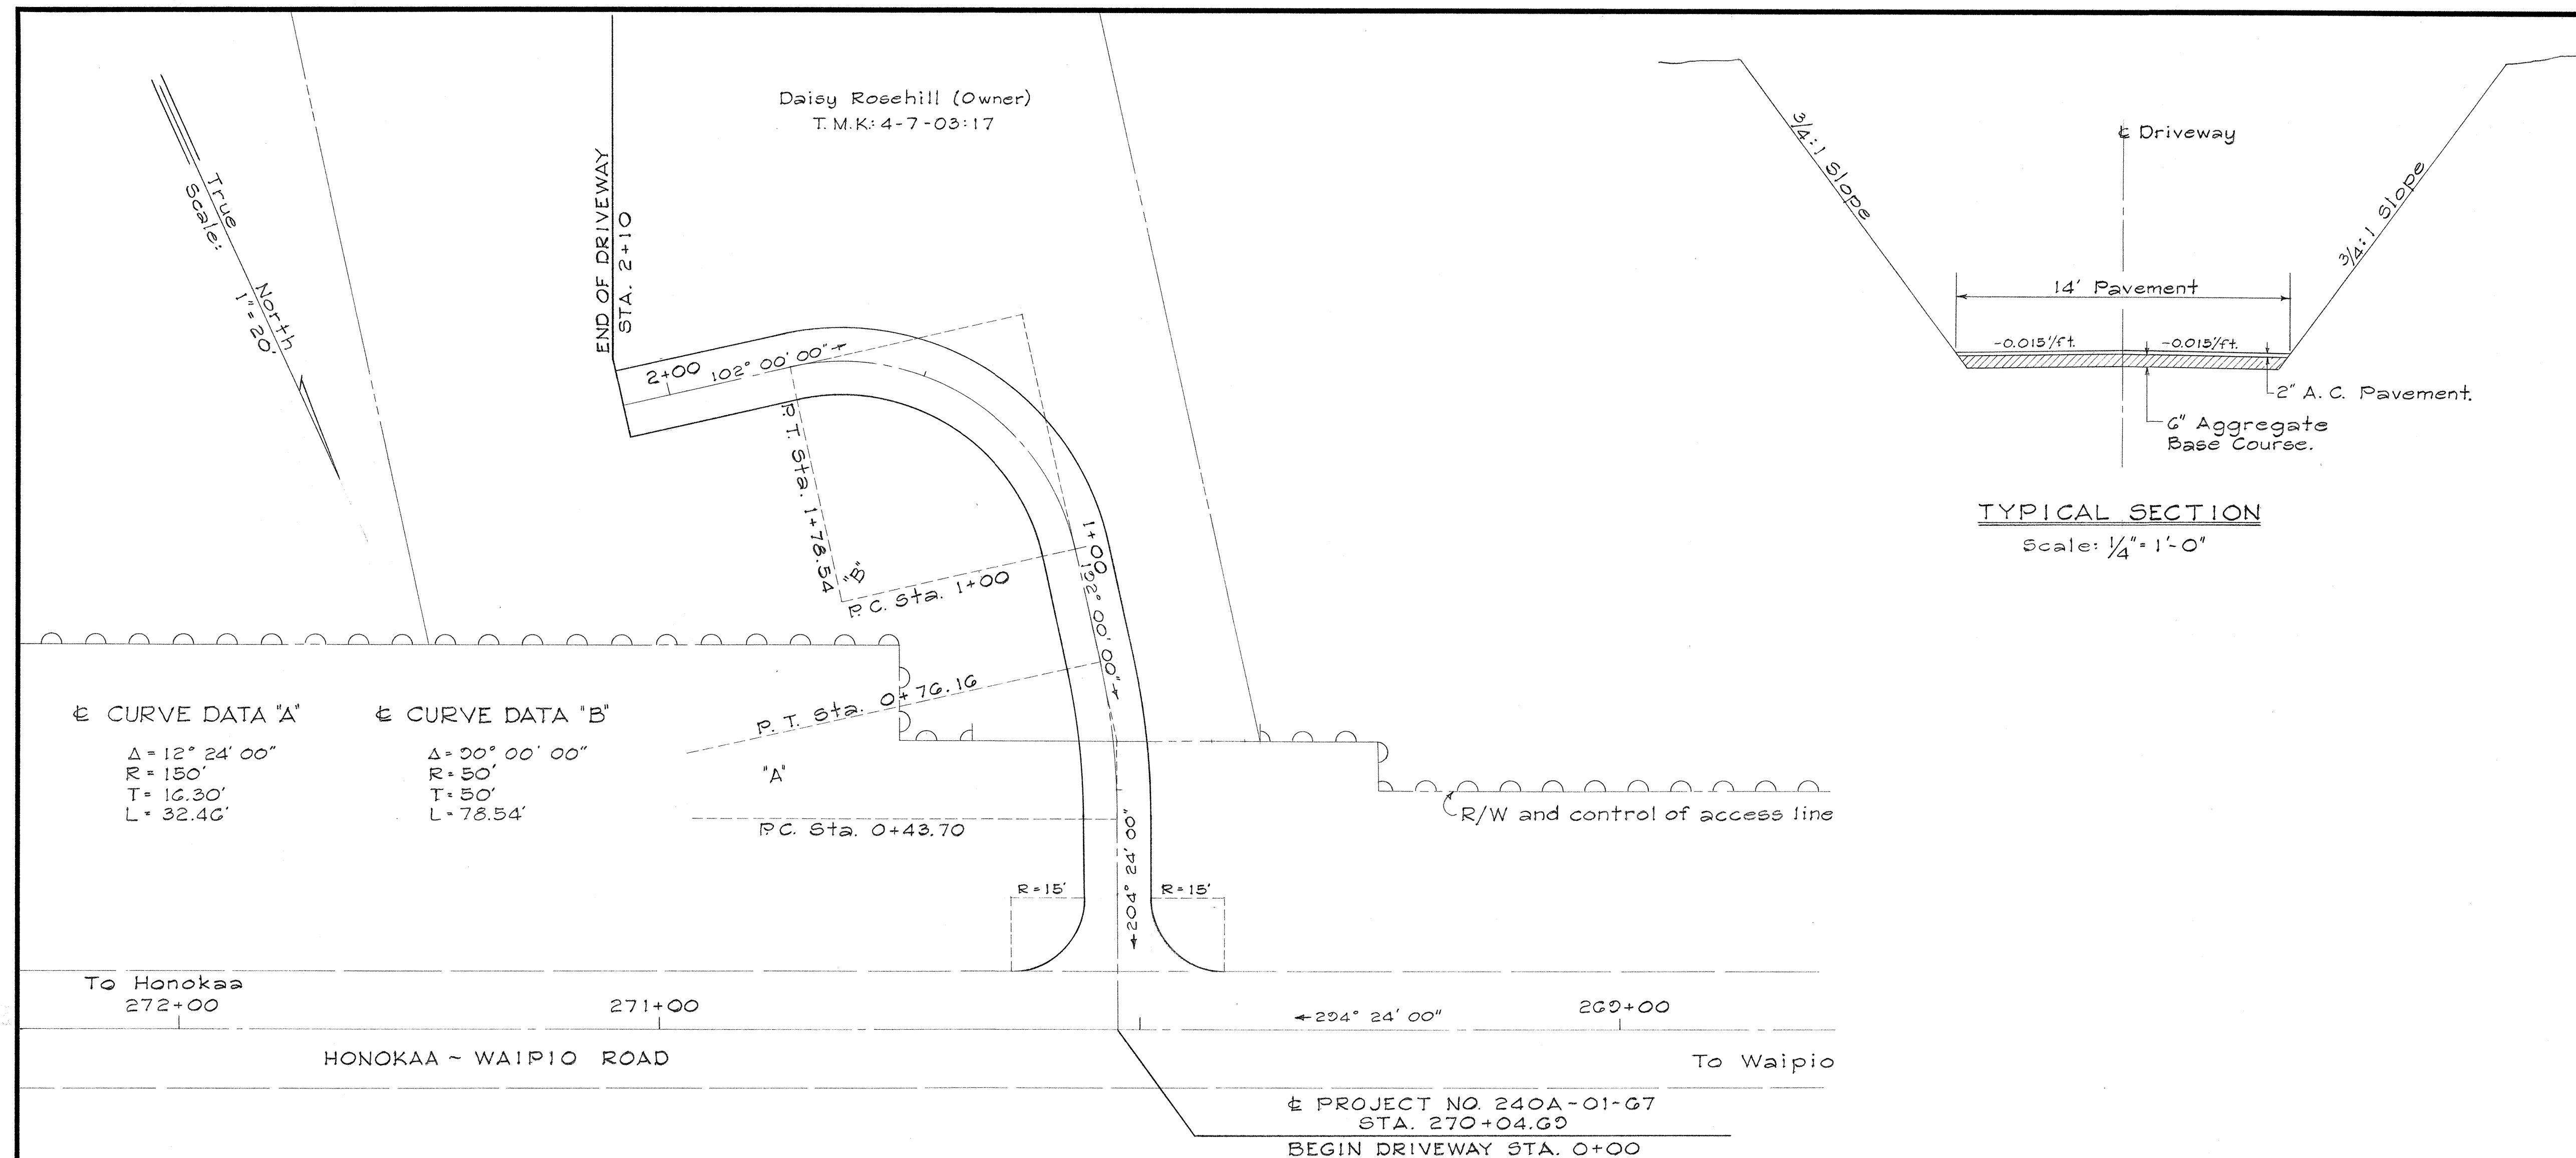

STATE OF HAWAII
DEPARTMENT OF TRANSPORTATION
HIGHWAYS DIVISION

DRIVEWAY FOR DAISY ROSEHILL
STA. 270+04.69 LEFT
PROJECT NO. 240A-01-G7

Scale: As Noted Date: June, 1974

SHEET No. 30 OF 55 SHEETS

ORIGINAL PLAN	DATE
DRAWN BY	
CHECKED BY	
NOTED BY	
DATE	