
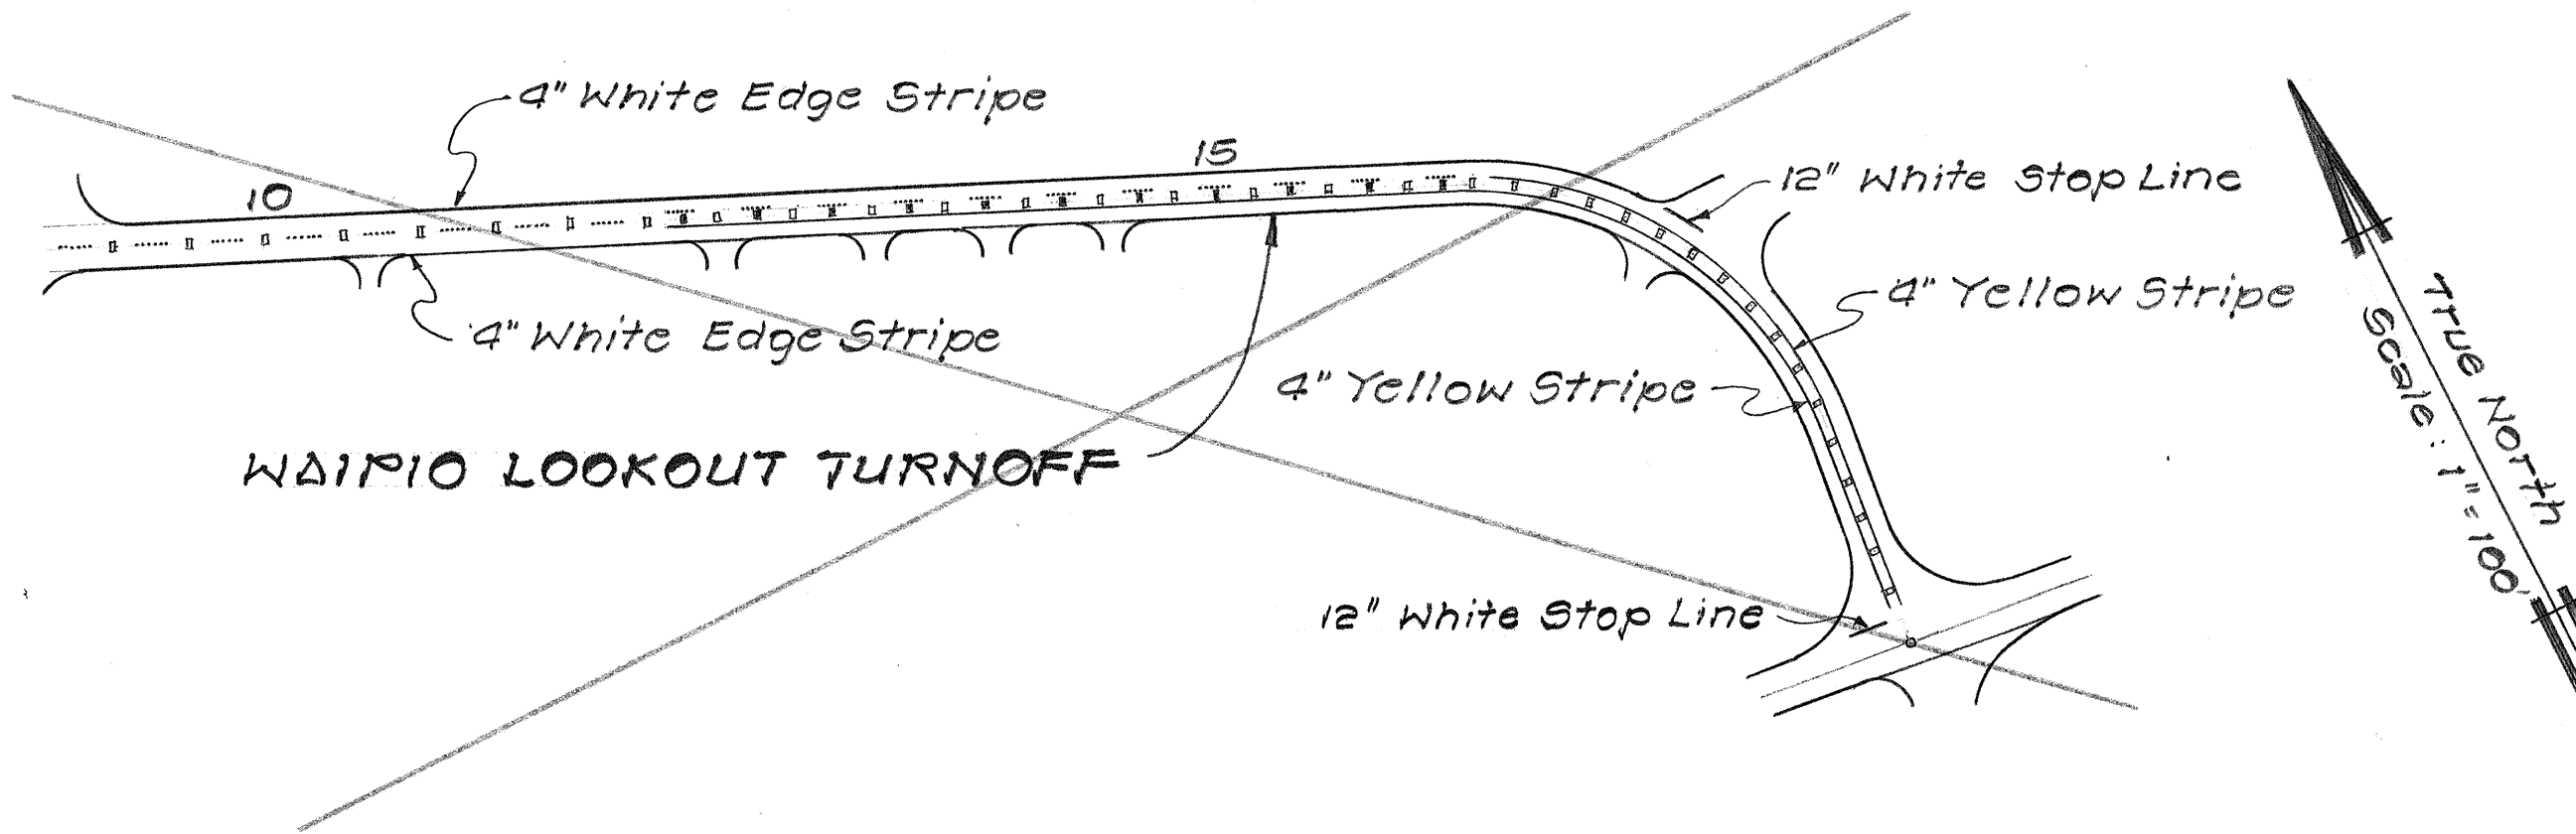


FED. ROAD DIST. NO.	STATE	PROJ. NO.	FISCAL YEAR	SHEET NO.	TOTAL SHEETS
HAWAII	HAW.	240A-01-71 UNIT 1	1977	14	55

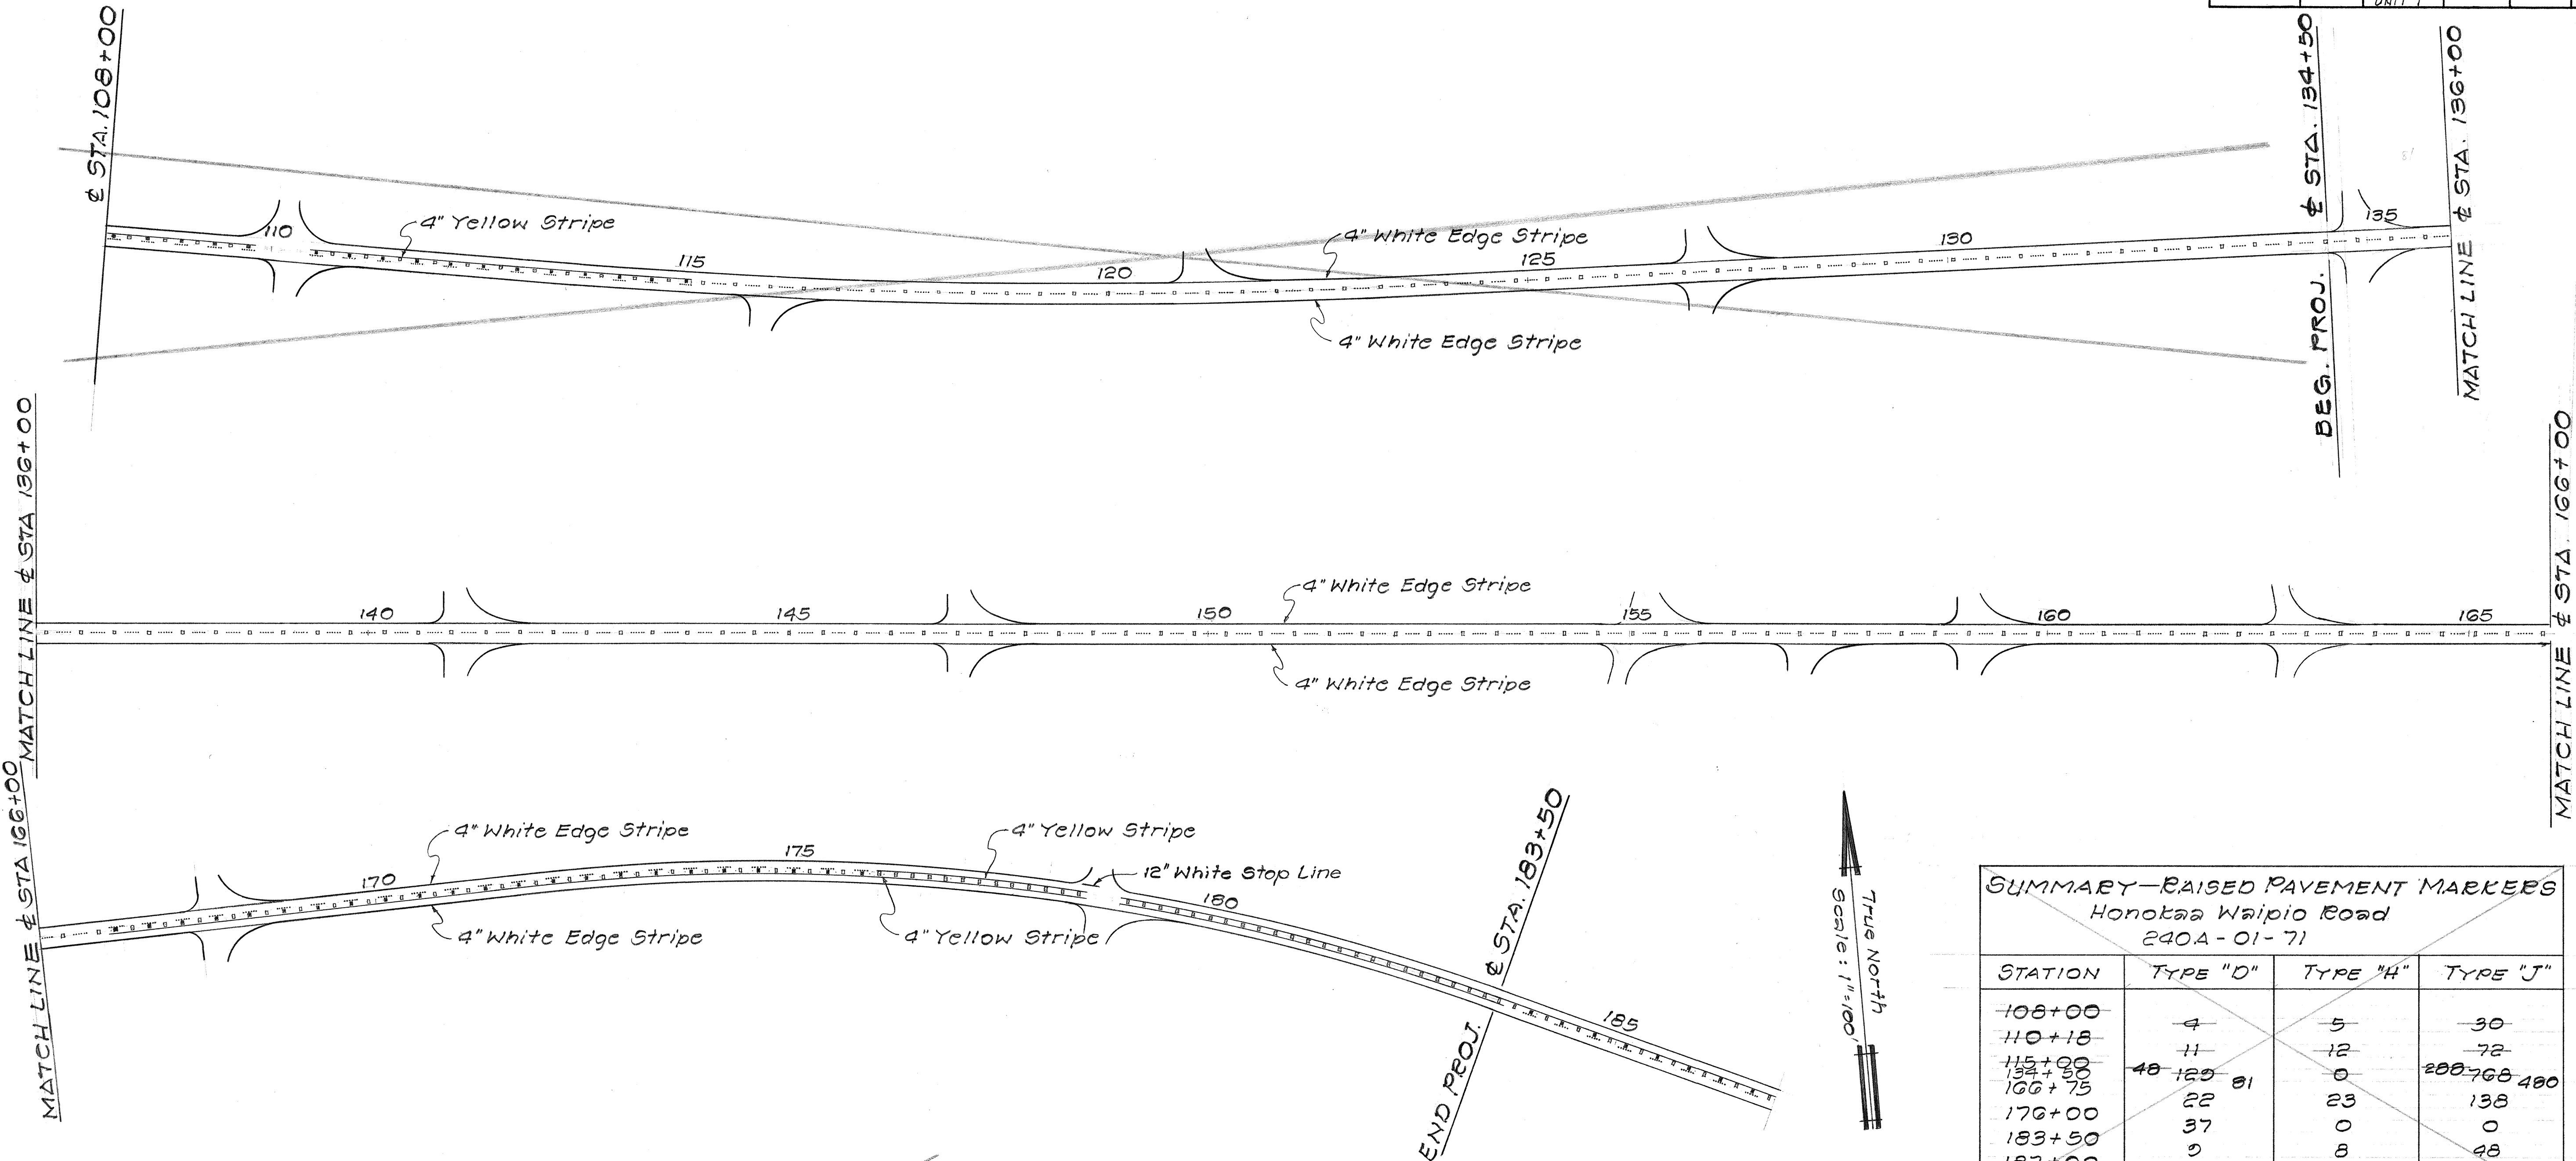


SUMMARY-RAISED PAVEMENT MARKERS Honokaa Waipio Road 240A-01-71			
STATION	TYPE "D"	TYPE "H"	TYPE "J"
108+00	4	5	30
110+18	11	12	72
115+00	48	0	200
124+50	125	81	480
126+75	22	23	138
170+00	37	0	0
183+50	2	8	48
187+00			
Spur Road	35	11	114

LEGEND

- Type "D"
- Type "H" 4
- Type "J" (6 ea. Per Line)

SUMMARY-RAISED PAVEMENT MARKERS Honokaa Waipio Road 240A-01-71			
STATION	TYPE "D"	TYPE "H"	TYPE "J"
134+50	101	0	400
173+50	13	14	56
178+50			
179+00	34	3	18
187+00			
SPUR RD.	4		

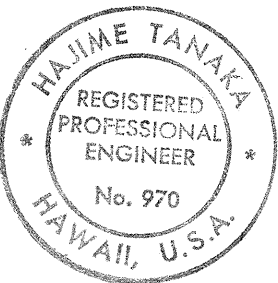

THIS WORK WAS PREPARED BY
ME OR UNDER MY SUPERVISION

H. Tanaka

STATE OF HAWAII
DEPARTMENT OF TRANSPORTATION
HIGHWAYS DIVISION

RAISED PAVEMENT MARKERS AND STRIPING PLAN

HONOKAA-WAIPIO RD. PROJ. NO. 240A-01-71
UNIT 1

SHEET No. 1 OF 1 SHEETS