

INDEX TO DRAWINGS	
SHEET NO.	DESCRIPTION
1	TITLE SHEET
2	TYPICAL ROADWAY & TRACTOR CROSSING SECTIONS & DETAILS
3	TYPICAL SIDEROAD & DRIVEWAY SECTIONS & DETAILS
4-5	PLAN & PROFILE
6	INTERSECTION DETAILS STA. 178+60
7	INTERSECTION DETAILS END OF PROJECT
8-12	DRAINAGE CULVERTS
13	DRYWELL - STA 183+80
14	RAISED PAVEMENT MARKERS & STRIPING PLAN
15	SUMMARY OF TRAFFIC SIGNS & ROAD DELINEATORS
16-26	CROSS SECTIONS
27-29	CROSS SECTIONS - SIDEROADS
30	PLAN & PROFILE ROSEHILL'S DRIVEWAY
31	CROSS SECTION ROSEHILL'S DRIVEWAY
32-55	STANDARD DETAILS

STATE OF HAWAII

DEPARTMENT OF TRANSPORTATION

LAND TRANSPORTATION FACILITIES DIVISION

"AS BUILT"

PLANS FOR

HONOKAA - WAIPIO ROAD


CAMP 106 TO WAIPIO LOOKOUT

PROJECT NO. 240A-01-71


UNIT I

DISTRICT OF HAMAKUA

ISLAND OF HAWAII

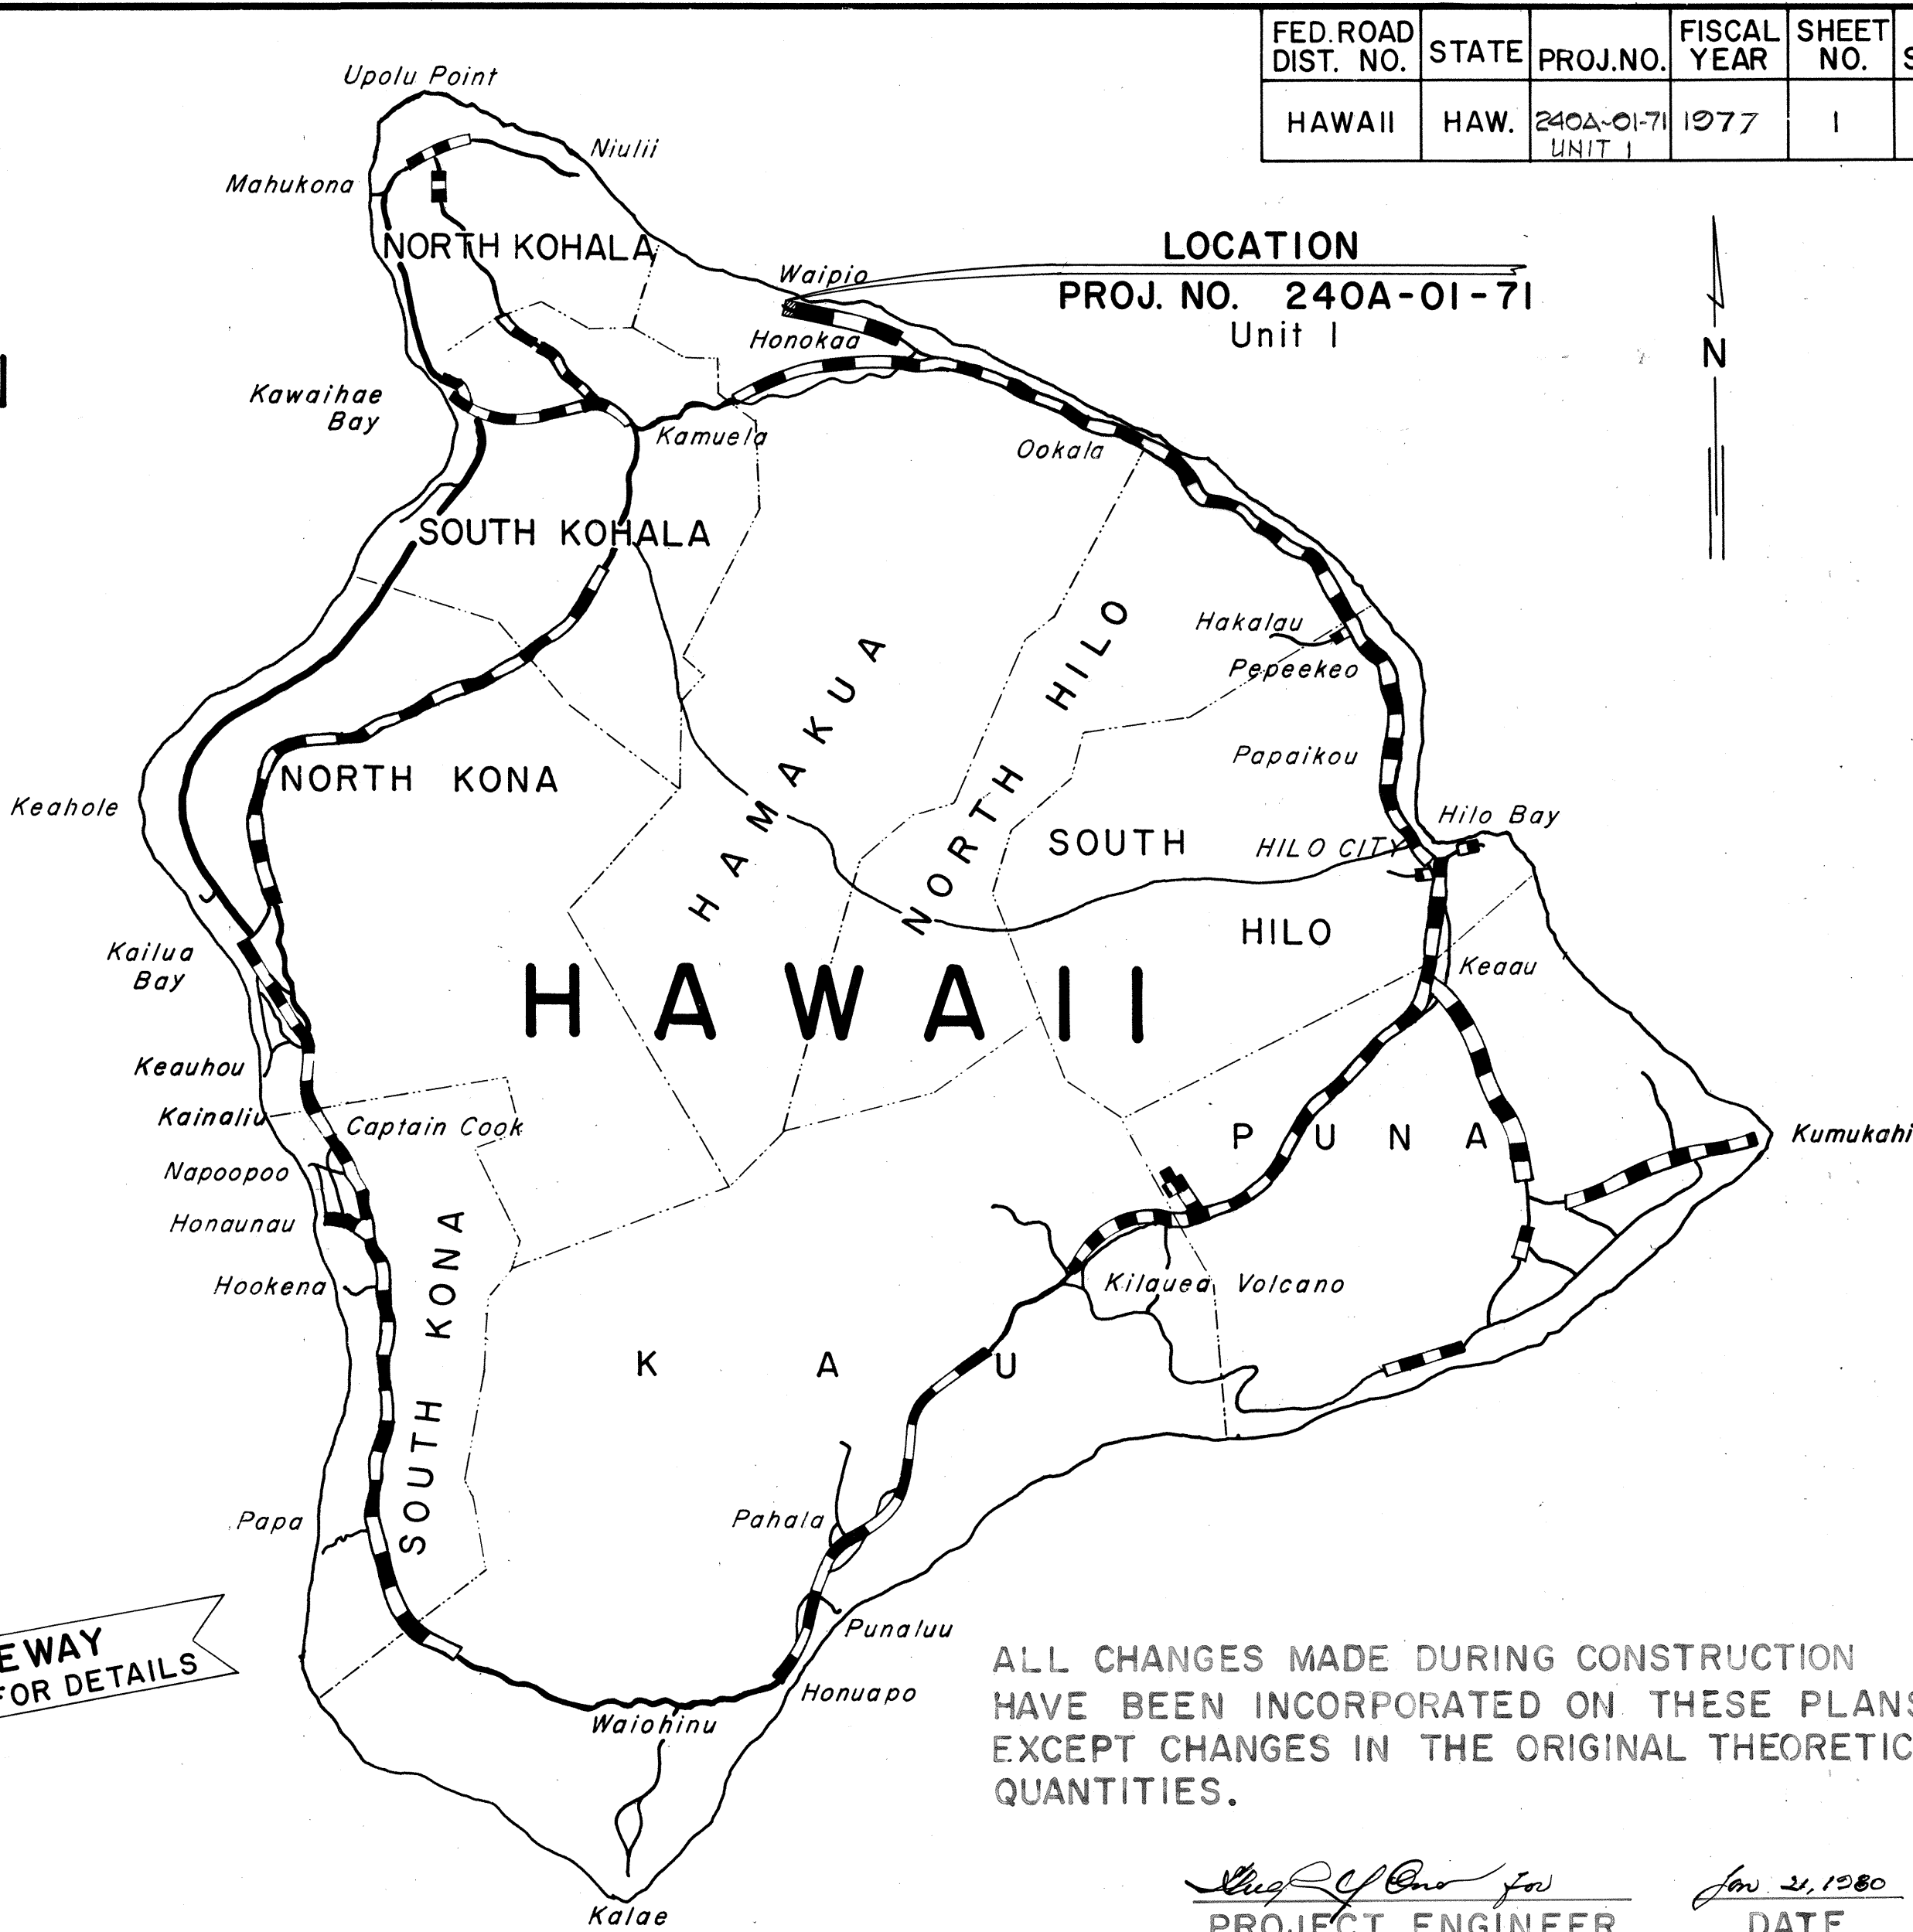

FED. ROAD DIST. NO.	STATE	PROJ. NO.	FISCAL YEAR	SHEET NO.	TOTAL SHEETS
HAWAII	HAW.	240A-01-71 UNIT I	1977	1	55

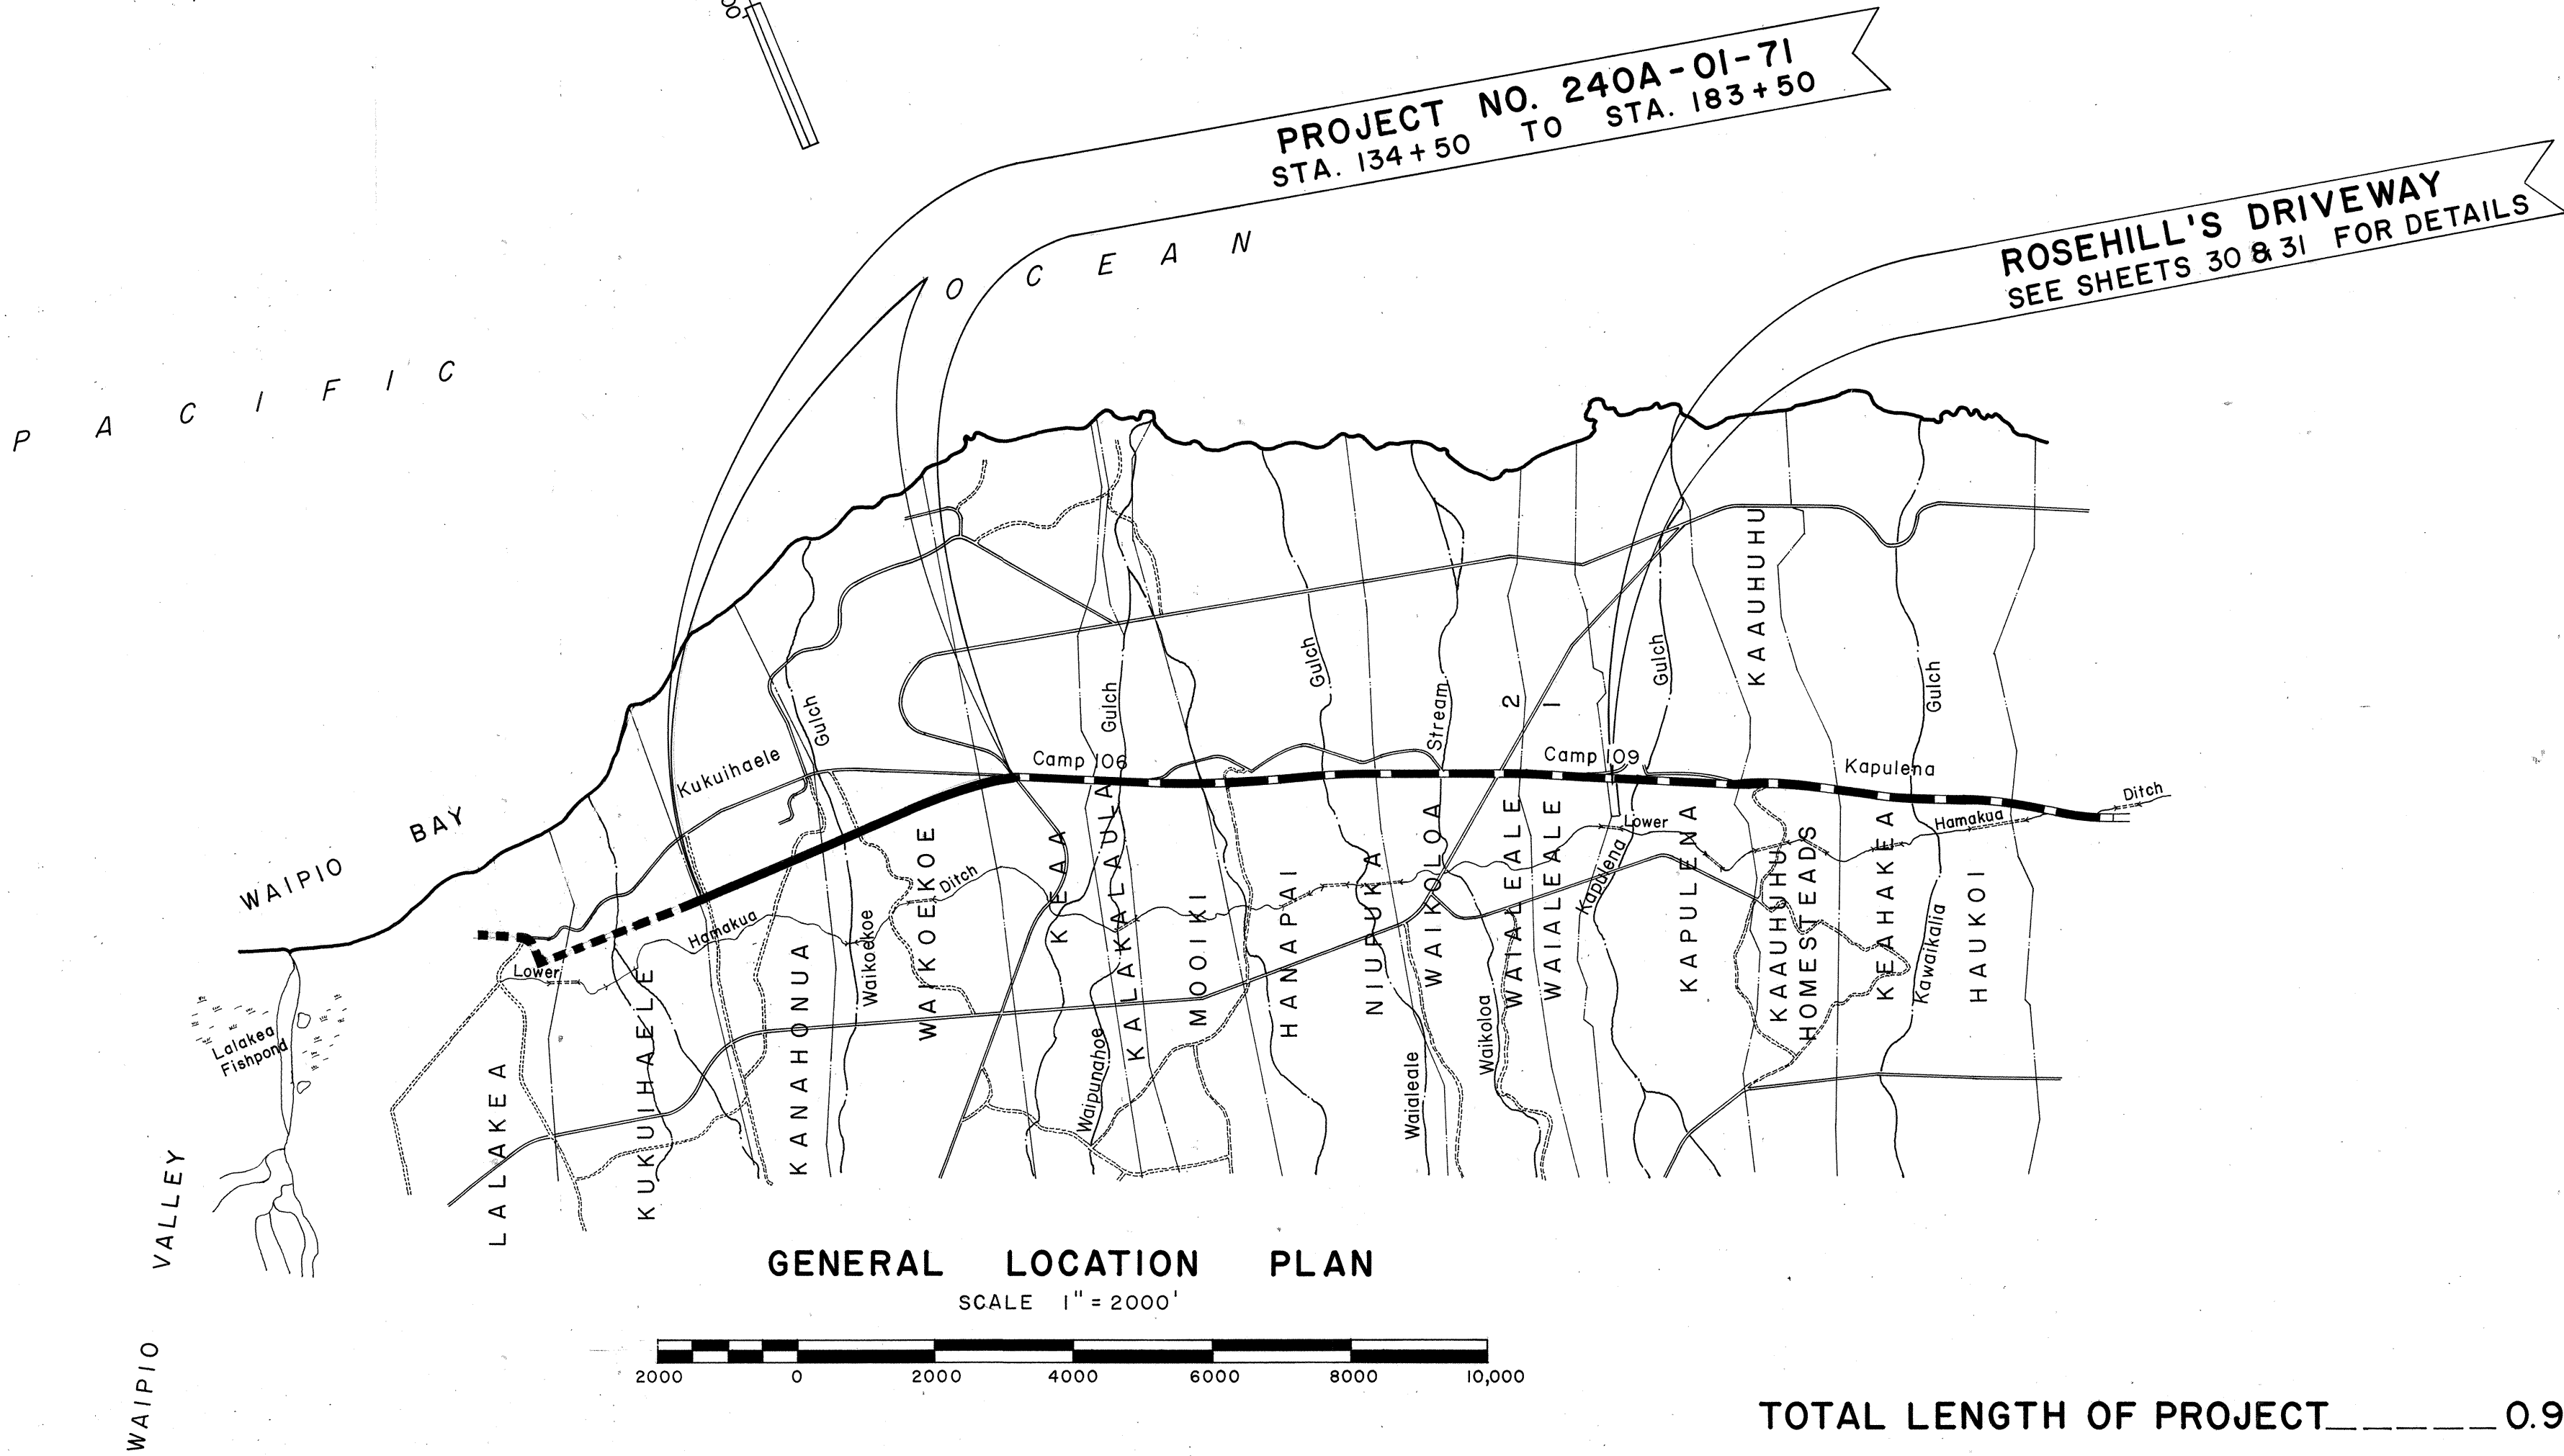

ALL CHANGES MADE DURING CONSTRUCTION HAVE BEEN INCORPORATED ON THESE PLANS EXCEPT CHANGES IN THE ORIGINAL THEORETICAL QUANTITIES.

for
PROJECT ENGINEER
(T. Fujimori)

for Jan 21, 1980
DATE

Federal Aid Projects Previously Constructed Or Under Construction

DESIGN CLASSIFICATION	
Current ADT (1973)	580
Interim ADT (1983)	1080
Design ADT (1993)	1420
DHV	11.0%
D	60/40
T	8.5%
T24	7.5%

JHK TANAKA, INC.
P.O. BOX 422
HILO, HAWAII

DEPARTMENT OF TRANSPORTATION STATE OF HAWAII	
APPROVED:	
<i>for</i> <i>R. Higashionna</i>	9/22/77
DIR. OF TRANSPORTATION	DATE

DESIGNED BY: HAJIME TANAKA
P.S. & E. BY: FREDERIC ABESHIMA (LT-DS)
DATE: SEPT. 1, 1977
PHONE: 548-4042

TOTAL LENGTH OF PROJECT 0.928 mi.