

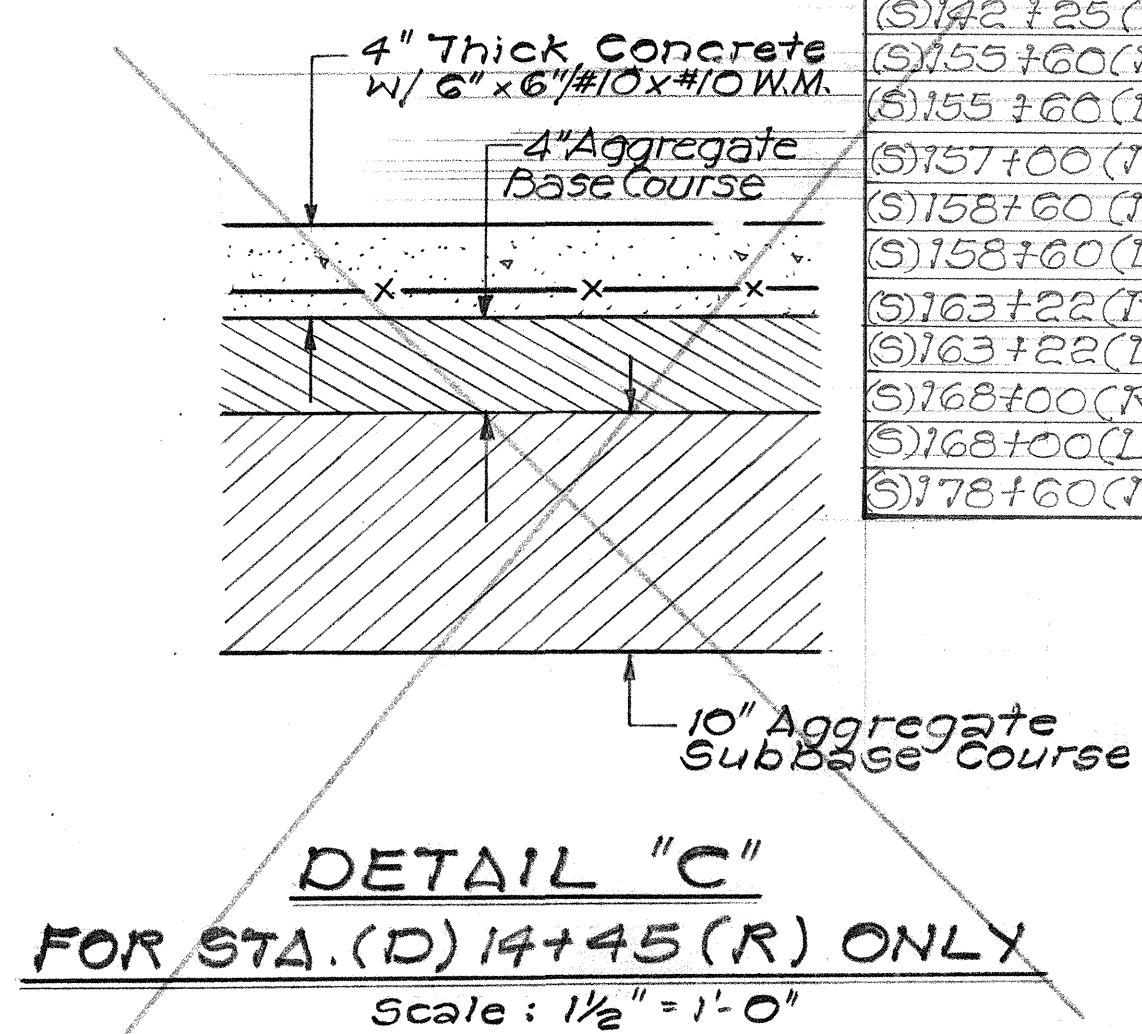
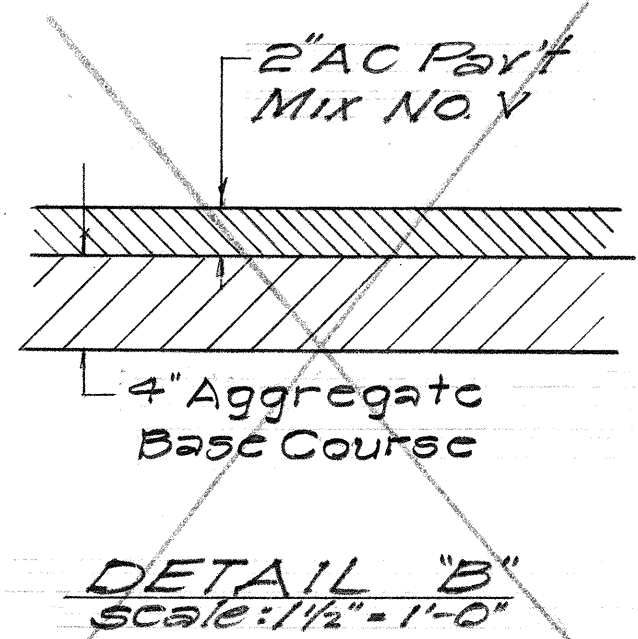
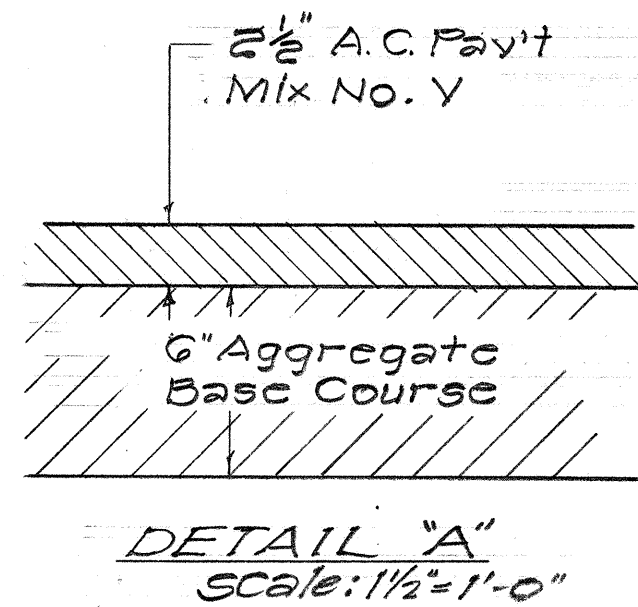
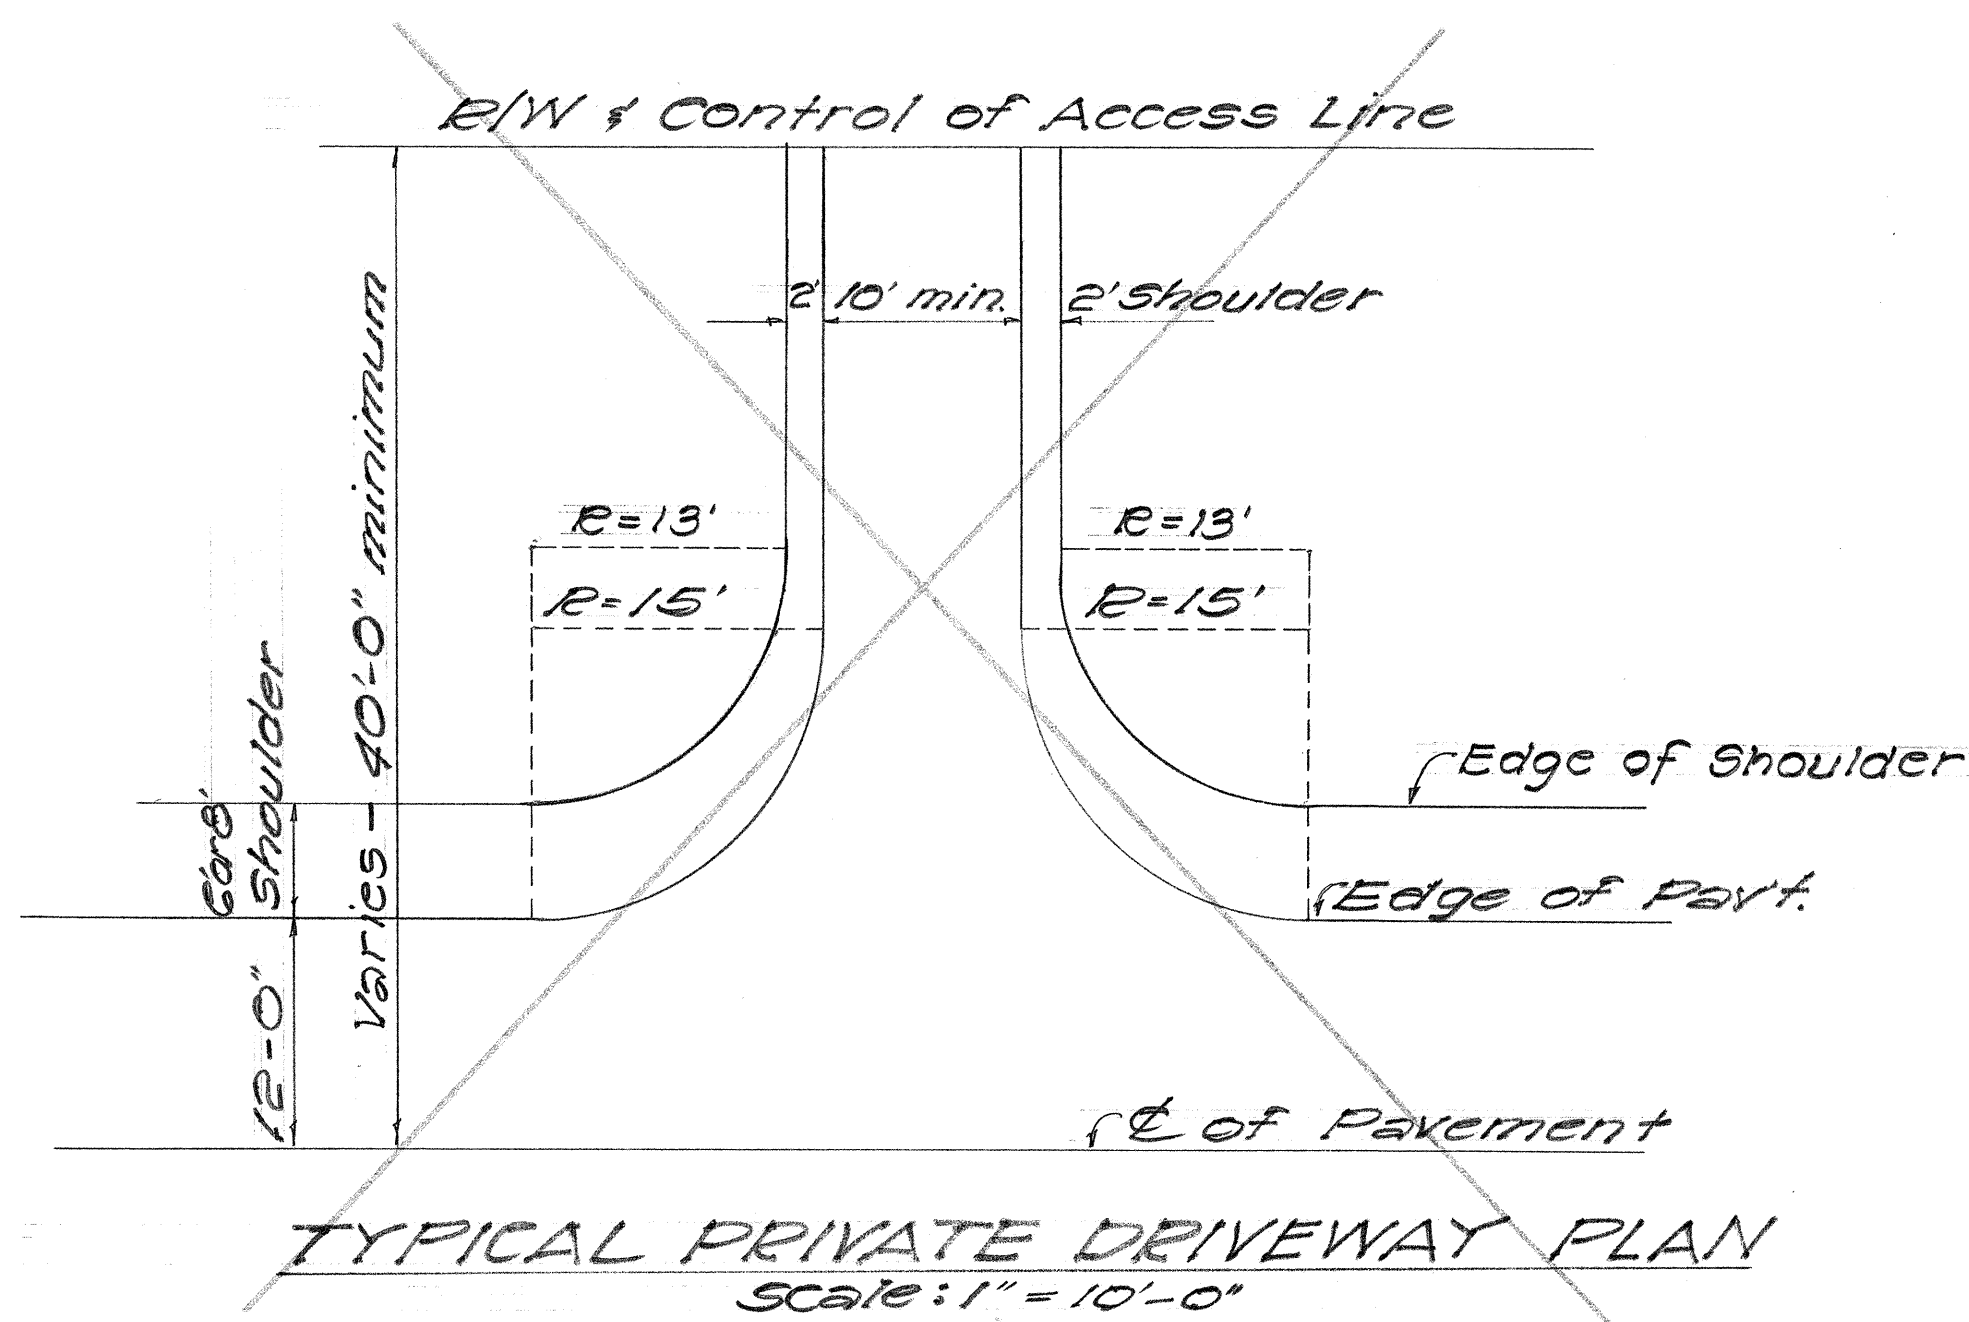
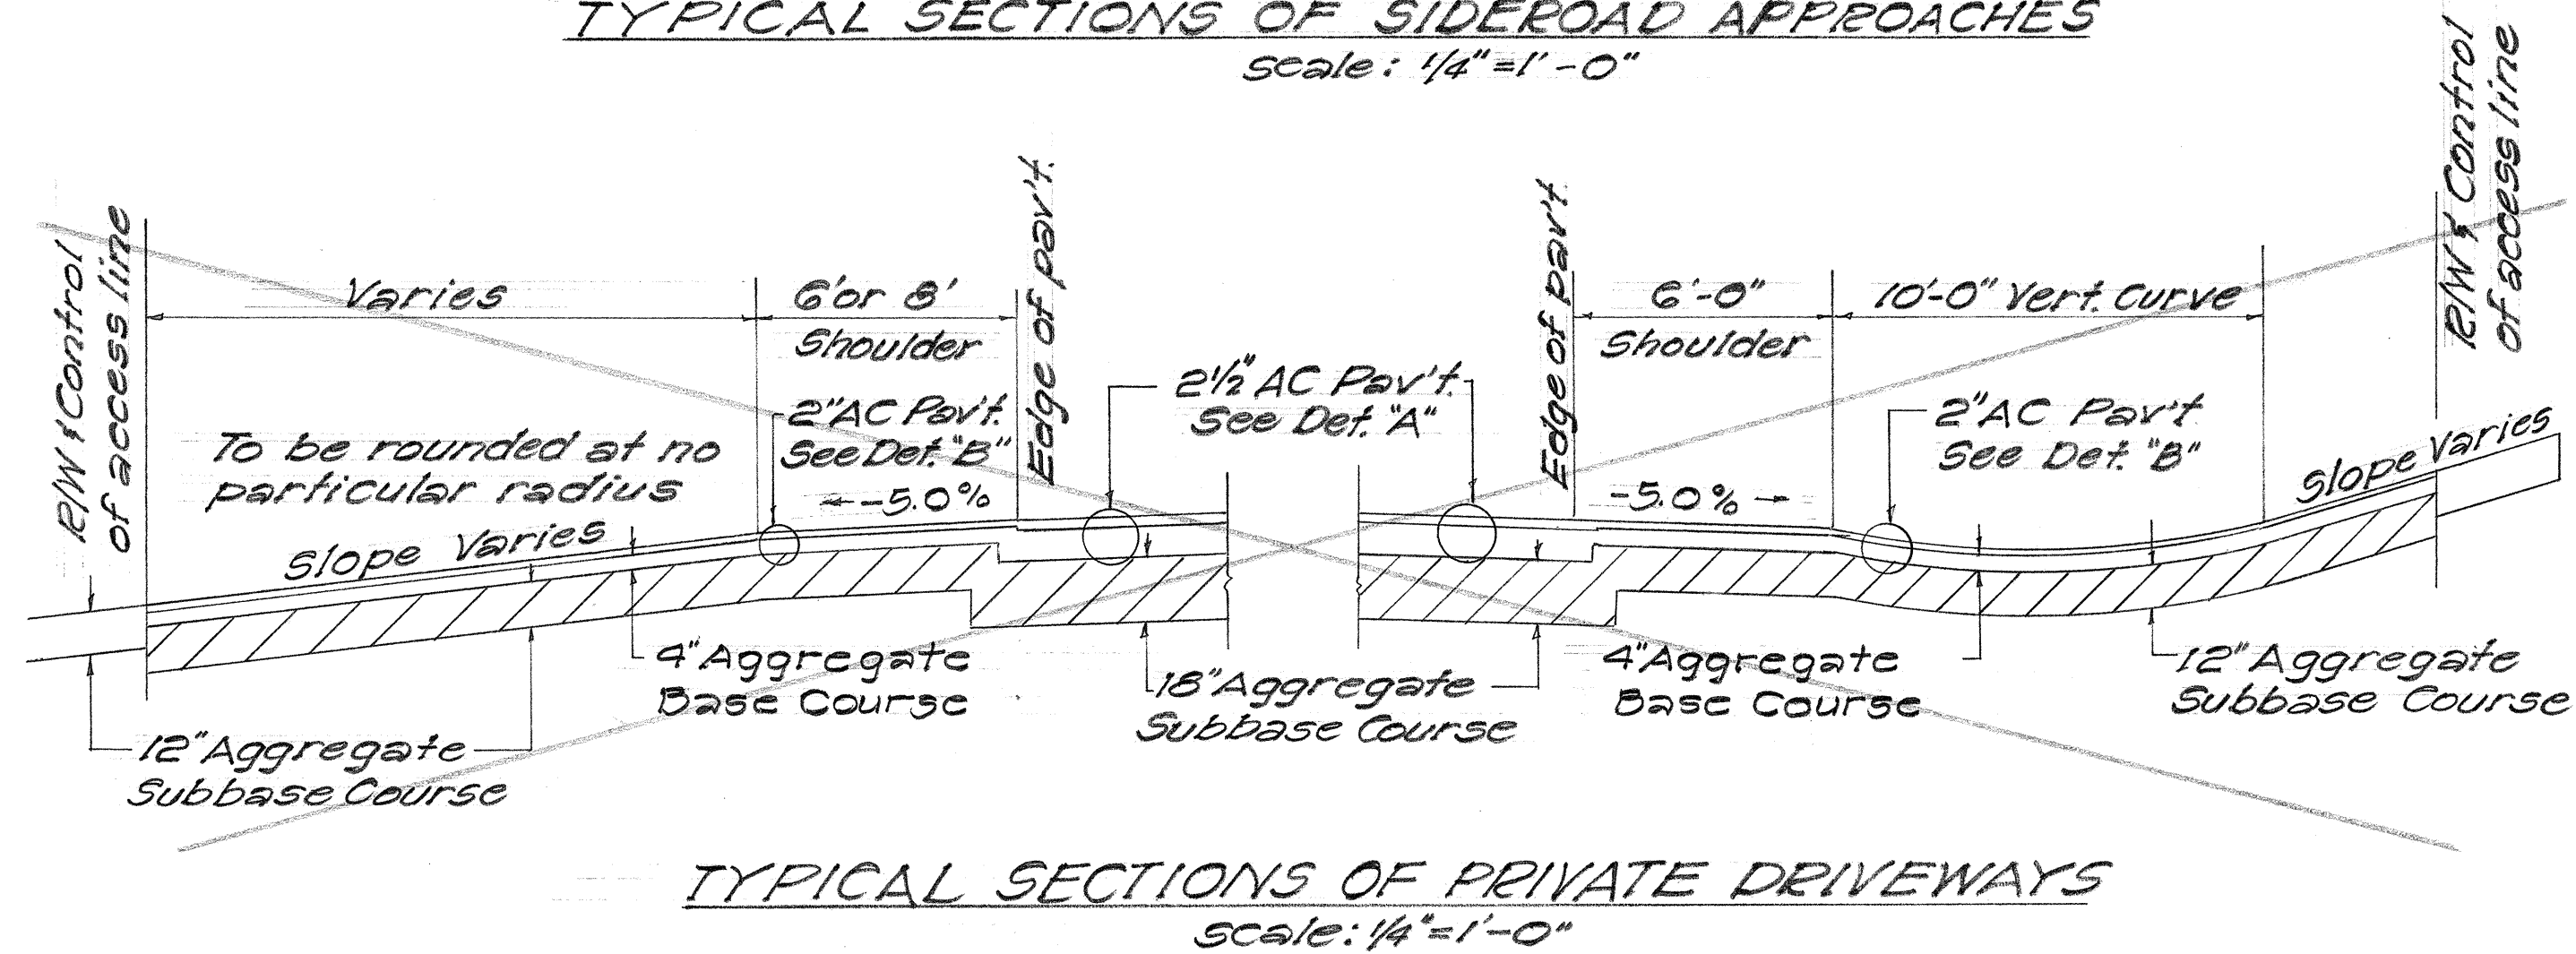


FED. ROAD DIST. NO.	STATE	PROJ. NO.	FISCAL YEAR	SHEET NO.	TOTAL SHEETS
HAWAII	HAW.	240A-01-71 UNIT 1	1977	3	55

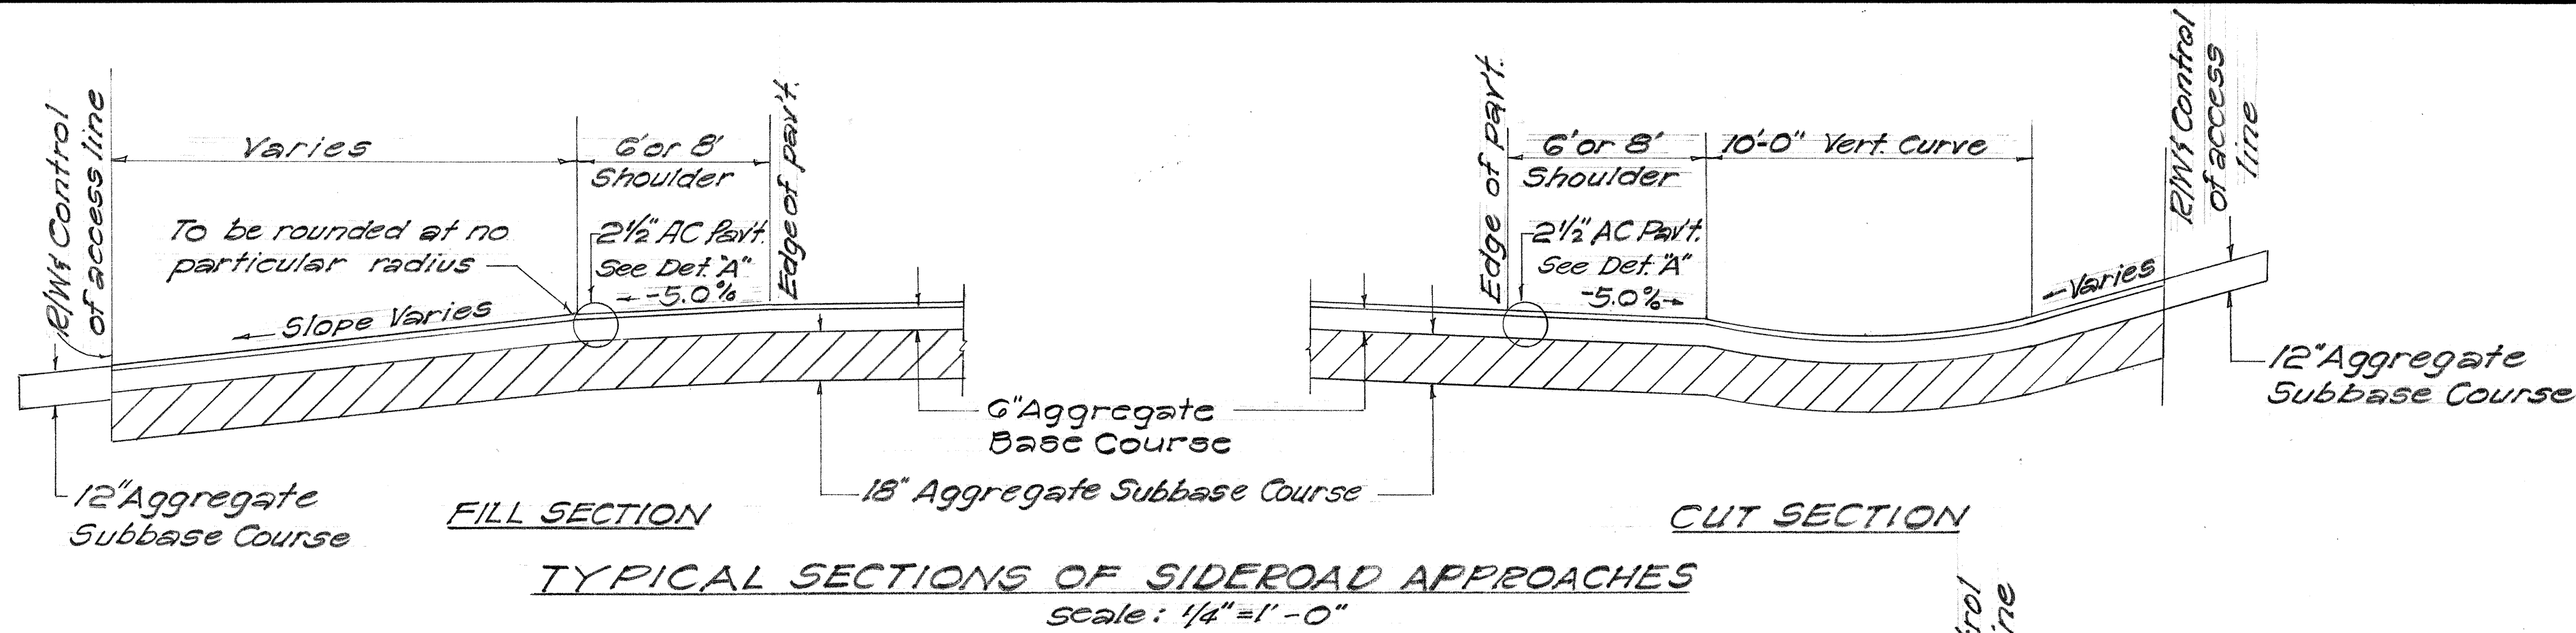

CONSTRUCT SMOOTH AND EASY CONNECTION
TO EXISTING DRIVEWAYS AND SIDEROAD APPROACHES

Station	Pav't Area (S.Y.)	B.C. Area (S.Y.)	Exc. (C.Y.)	Emb. (C.Y.)	Subbase (C.Y.)
(S) 110+18 (R)	178	210	140	0	105.0
(S) 116+25 (R)	182	231	0	125	119.6
(S) 116+25 (L)	433	489	0	3340	244.4
(S) 121+00 (L)	233	276	732	0	137.8
(S) 127+00 (R)	256	299	366	0	149.4
(S) 127+00 (L)	200	231	20	0	115.6
(S) 135+28.29 (R)	467	517	1512	0	301.0
(S) 135+28.29 (L)	500	550	346	57	317.0
(S) 141+00 (R)	289	341	883	0	170.6
(S) 141+00 (L)	183	216	332	0	107.8
(S) 147+00 (R)	206	240	826	0	120.0
(S) 147+00 (L)	194	229	203	0	114.4
(S) 155+00 (R)	178	226	446	0	112.8
(S) 155+00 (L)	217	257	371	0	128.3
(S) 157+00 (R)	256	302	201	0	151.1
(S) 159+00 (R)	211	242	327	0	189.6
(S) 159+00 (L)	267	311	208	0	155.6
(S) 162+90 (R)	144	182	0	320	91.1
(S) 162+90 (L)	182	232	0	352	116.1
(S) 168+00 (R)	250	290	426	0	145.0
(S) 168+00 (L)	289	276	231	0	185.2
(S) 178+60 (R)	124	220	601	0	110.0
(D) 10+55 (R)	44	59	109	0	25.5
(D) 12+42 (R)	51	66	329	0	41.5
(D) 13+20 (R)	47	62	188	0	33.3
(D) 13+84 (R)	61	76	112	0	33.0
(D) 14+45 (R)	44	59	33	0	16.4
(S) 14+70 (L)	56	71	0	0	35.6
(S) 17+43 (R)	61	76	0	142	60.0
(S) 135+28.29 (R)	312	350	1,741	Not Pay Item	195
(S) 135+28.29 (L)	430	484	1,281		270
(S) 142+25 (R)	232	255	58		132
(S) 142+25 (L)	112	127	37		72
(S) 155+60 (R)	184	200	235		115
(S) 155+60 (L)	163	178	63		25
(S) 157+00 (R)	208	228	55		137
(S) 158+60 (R)	163	178	417		98
(S) 158+60 (L)	216	237	382		131
(S) 163+22 (R)	122	145	0		83
(S) 163+22 (L)	210	228	0		126
(S) 168+00 (R)	187	204	448		113
(S) 168+00 (L)	170	186	101		103
(S) 178+60 (R)	56	67	395		42

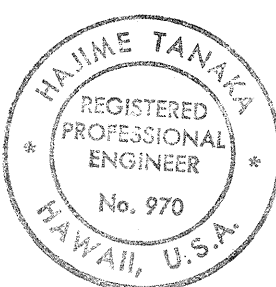

THIS WORK WAS PREPARED BY
ME OR UNDER MY SUPERVISION

STATE OF HAWAII
DEPARTMENT OF TRANSPORTATION
HIGHWAYS DIVISION

TYPICAL SIDEROAD AND
DRIVEWAY SECTIONS AND
DETAILS

HONOLULU-WAIPIO ROAD PROJ. NO. 240A-01-71
Unit 1

SHEET No. 1 OF 1 SHEETS

DATE	_____
DESIGNED BY	_____
CHECKED BY	_____
QUANTITIES BY	_____
NOTE BOOK	_____
ORIGINAL PLAN	_____
SURVEY PLOTTED BY	_____
DRAWN BY	_____
DESIGNED BY	_____
CHECKED BY	_____
QUANTITIES BY	_____
NOTE BOOK	_____
ORIGINAL PLAN	_____