
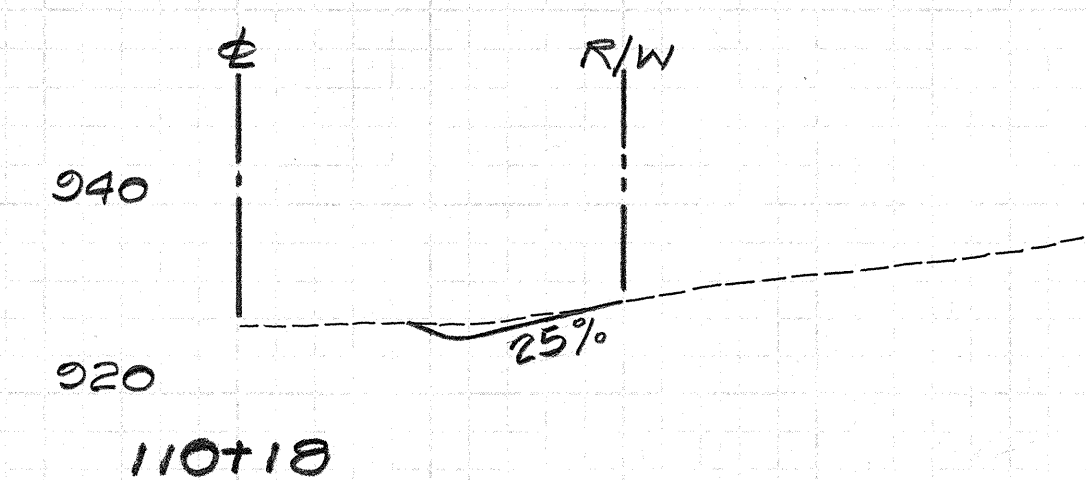
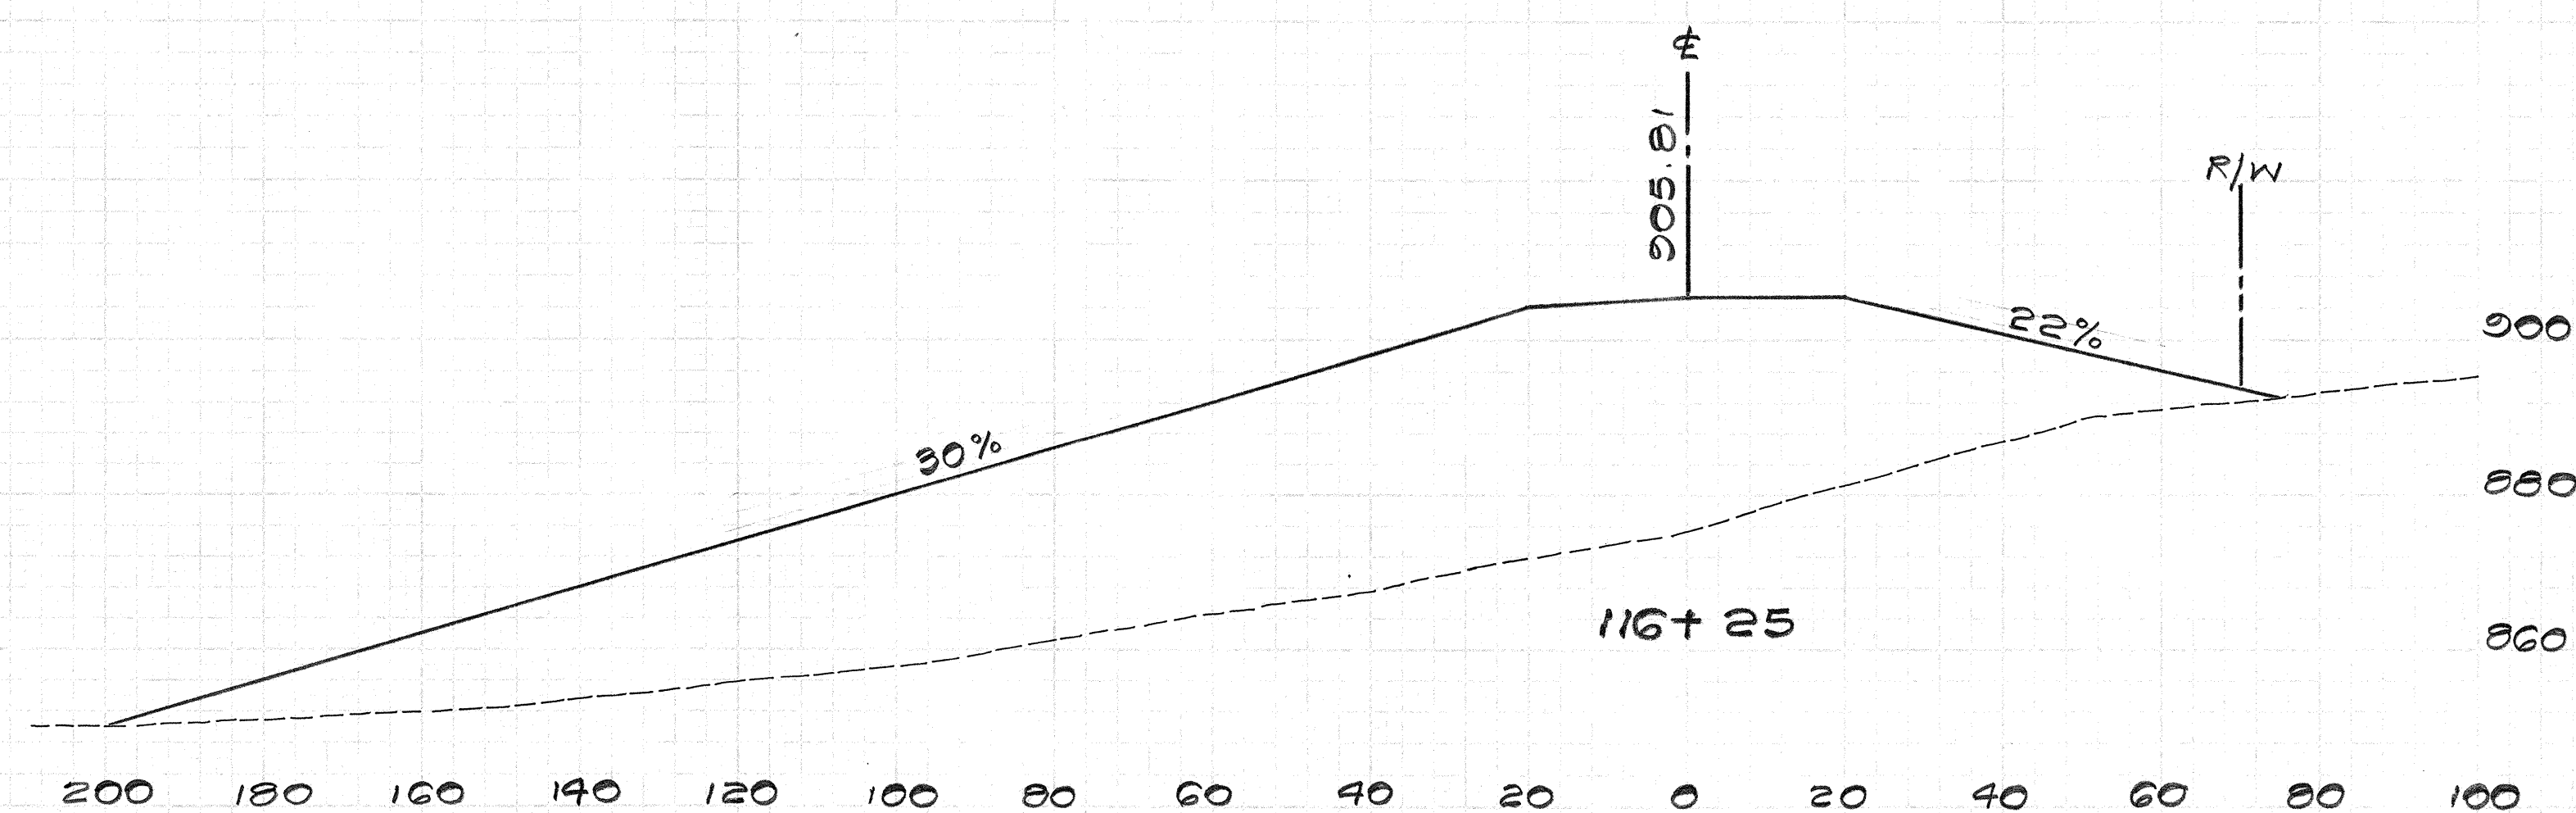


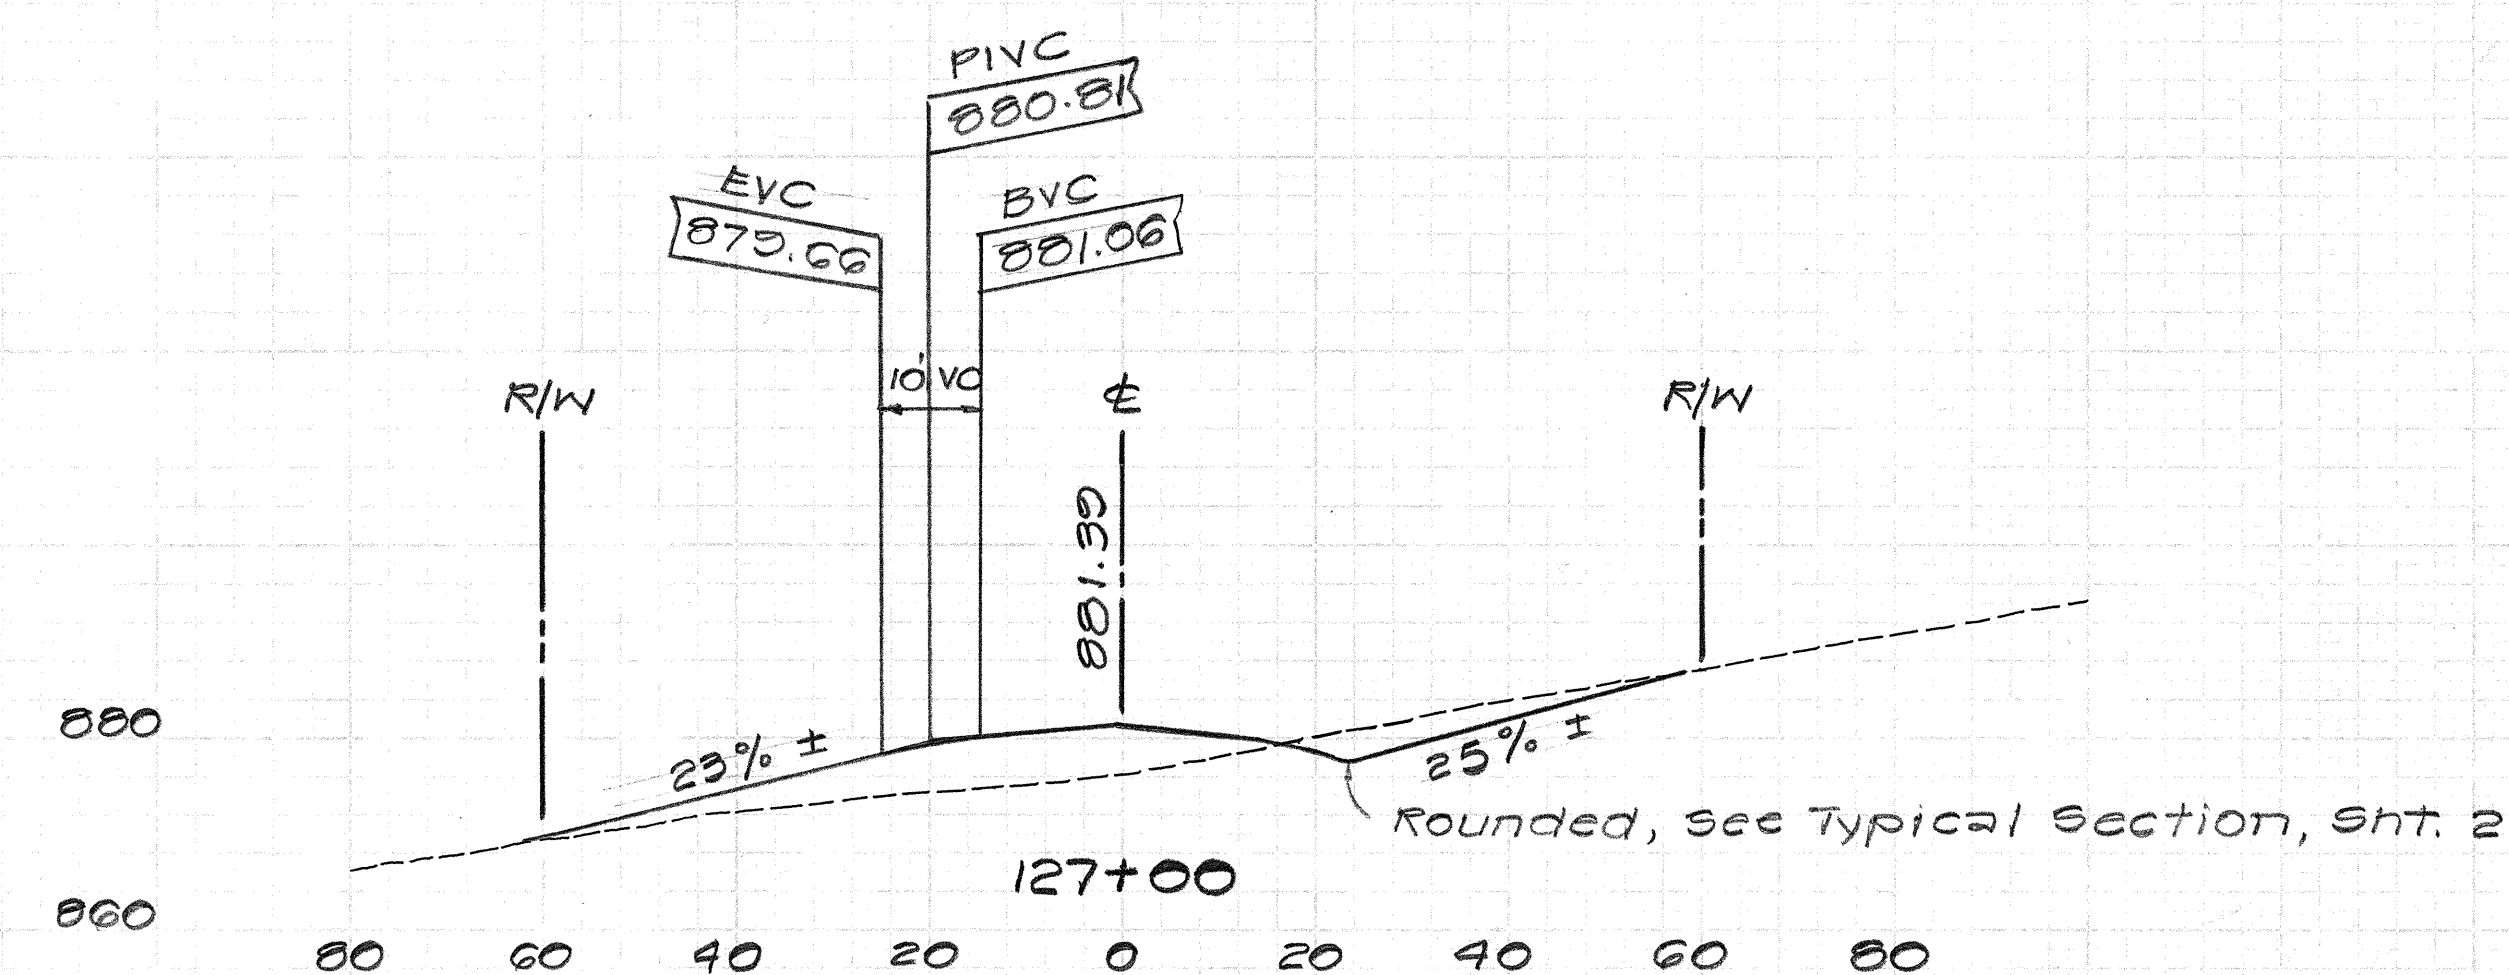

SIDEROAD APPROACHES ~ HONOKAA ~ WAIPIO ROAD