
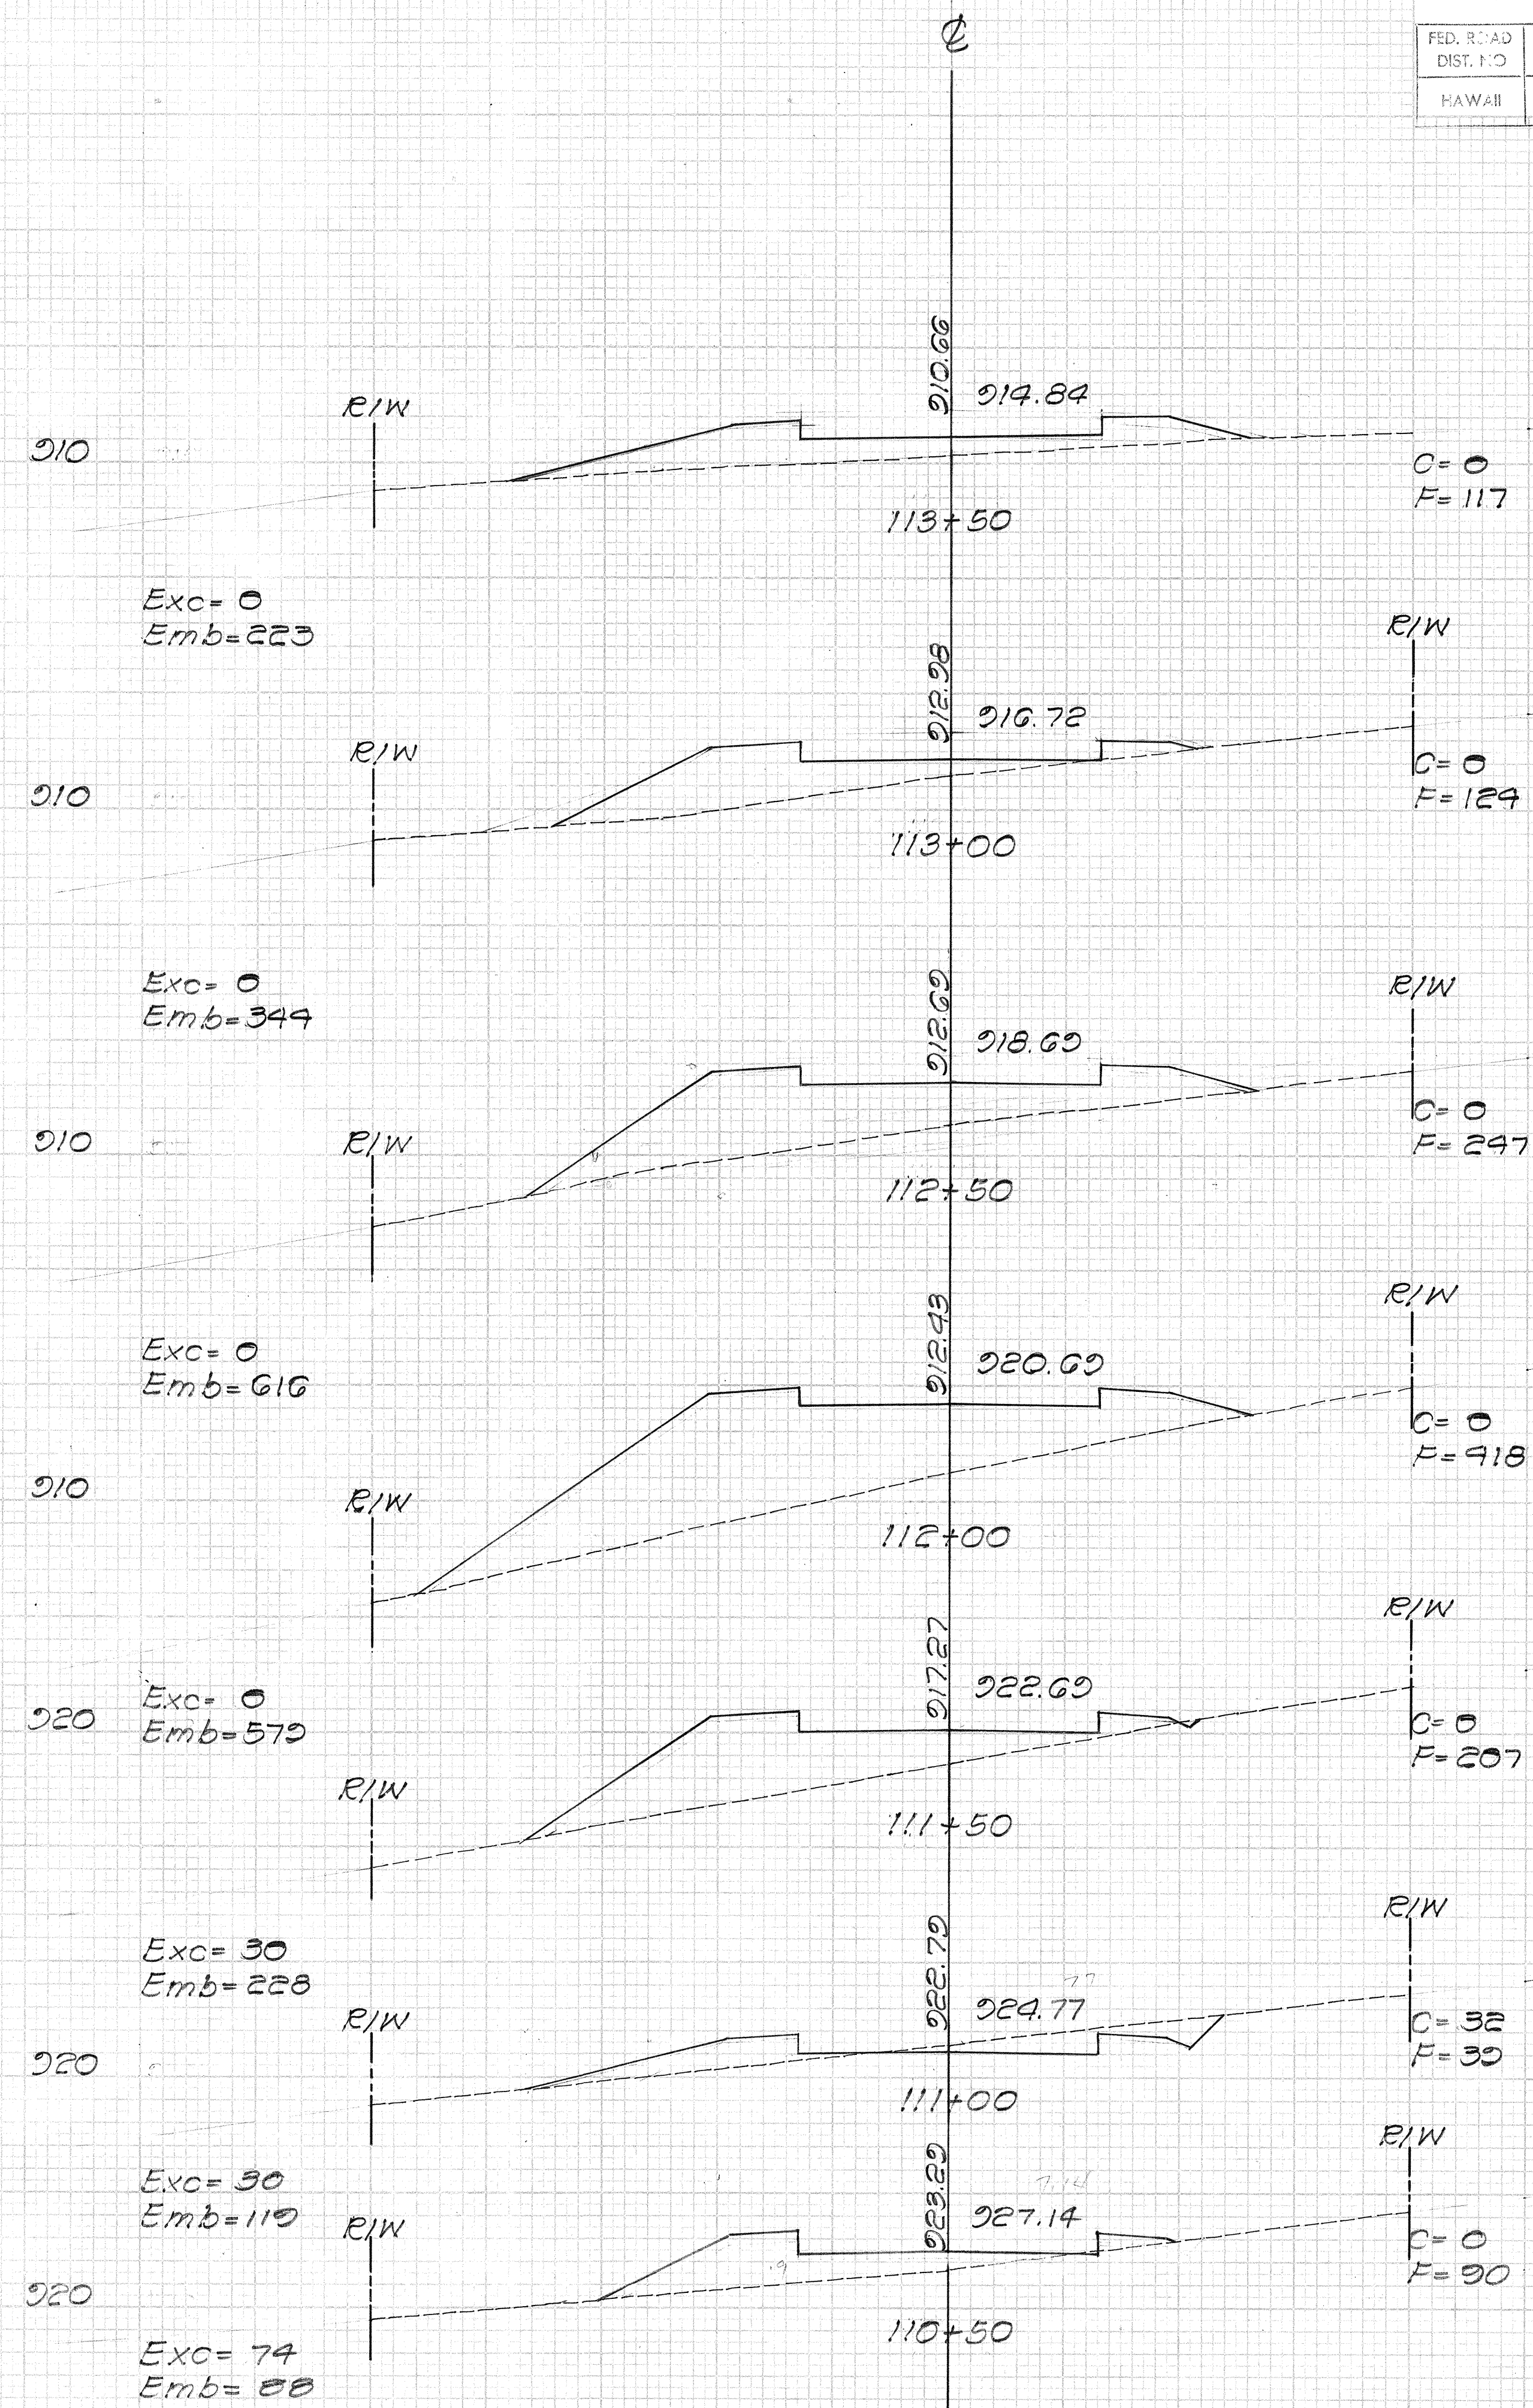




FED. ROAD DIST. NO.	STATE	PROJ. NO.	FISCAL YEAR	SHEET NO.	TOTAL SHEETS
HAWAII	HAW.	240A-017 UNIT 2	1978	28	63

DATE	
BY	
FINAL SURVEY	
NOTE BOOK	
TEMPLATE	
AREAS CHECKED	
NO.	

DATE	
BY	
ORIGINAL SURVEY	
NOTE BOOK	
TEMPLATE	
AREAS CHECKED	
NO.	

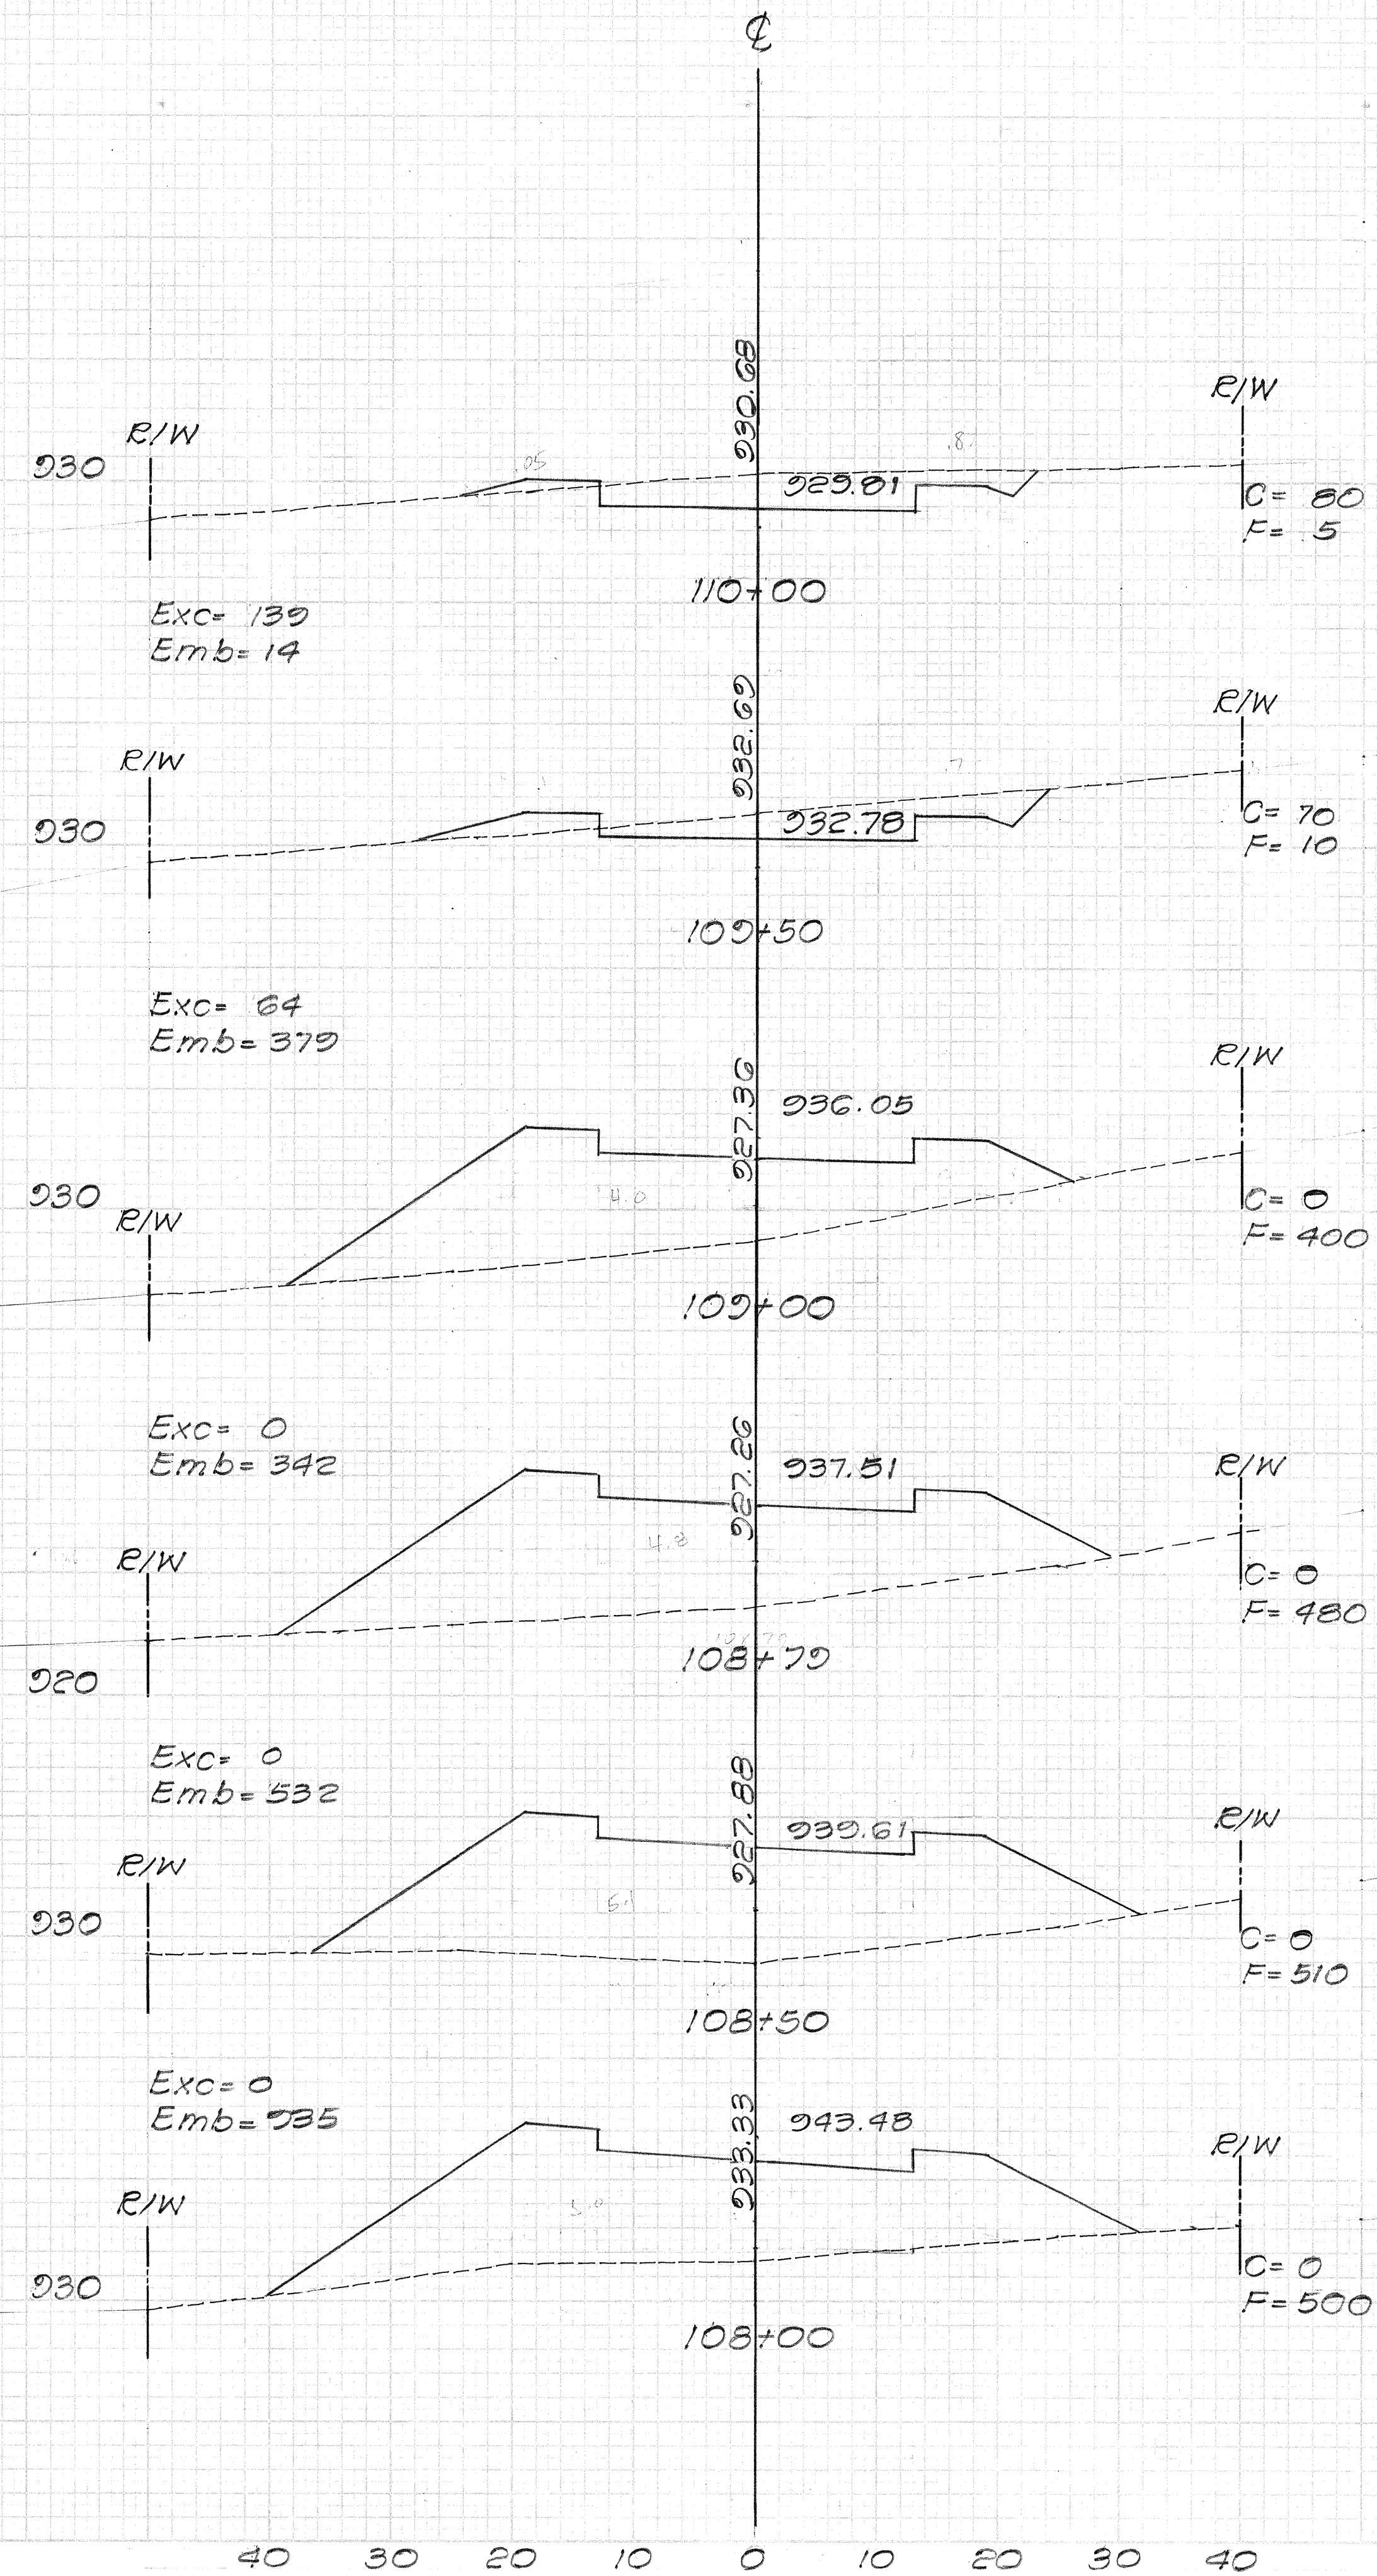


FED. ROAD DIST. NO.	STATE	PROJ. NO.	FISCAL YEAR	SHEET NO.	TOTAL SHEETS
HAWAII	HAW.	240A-01-71 UNIT 2	1978	29	63

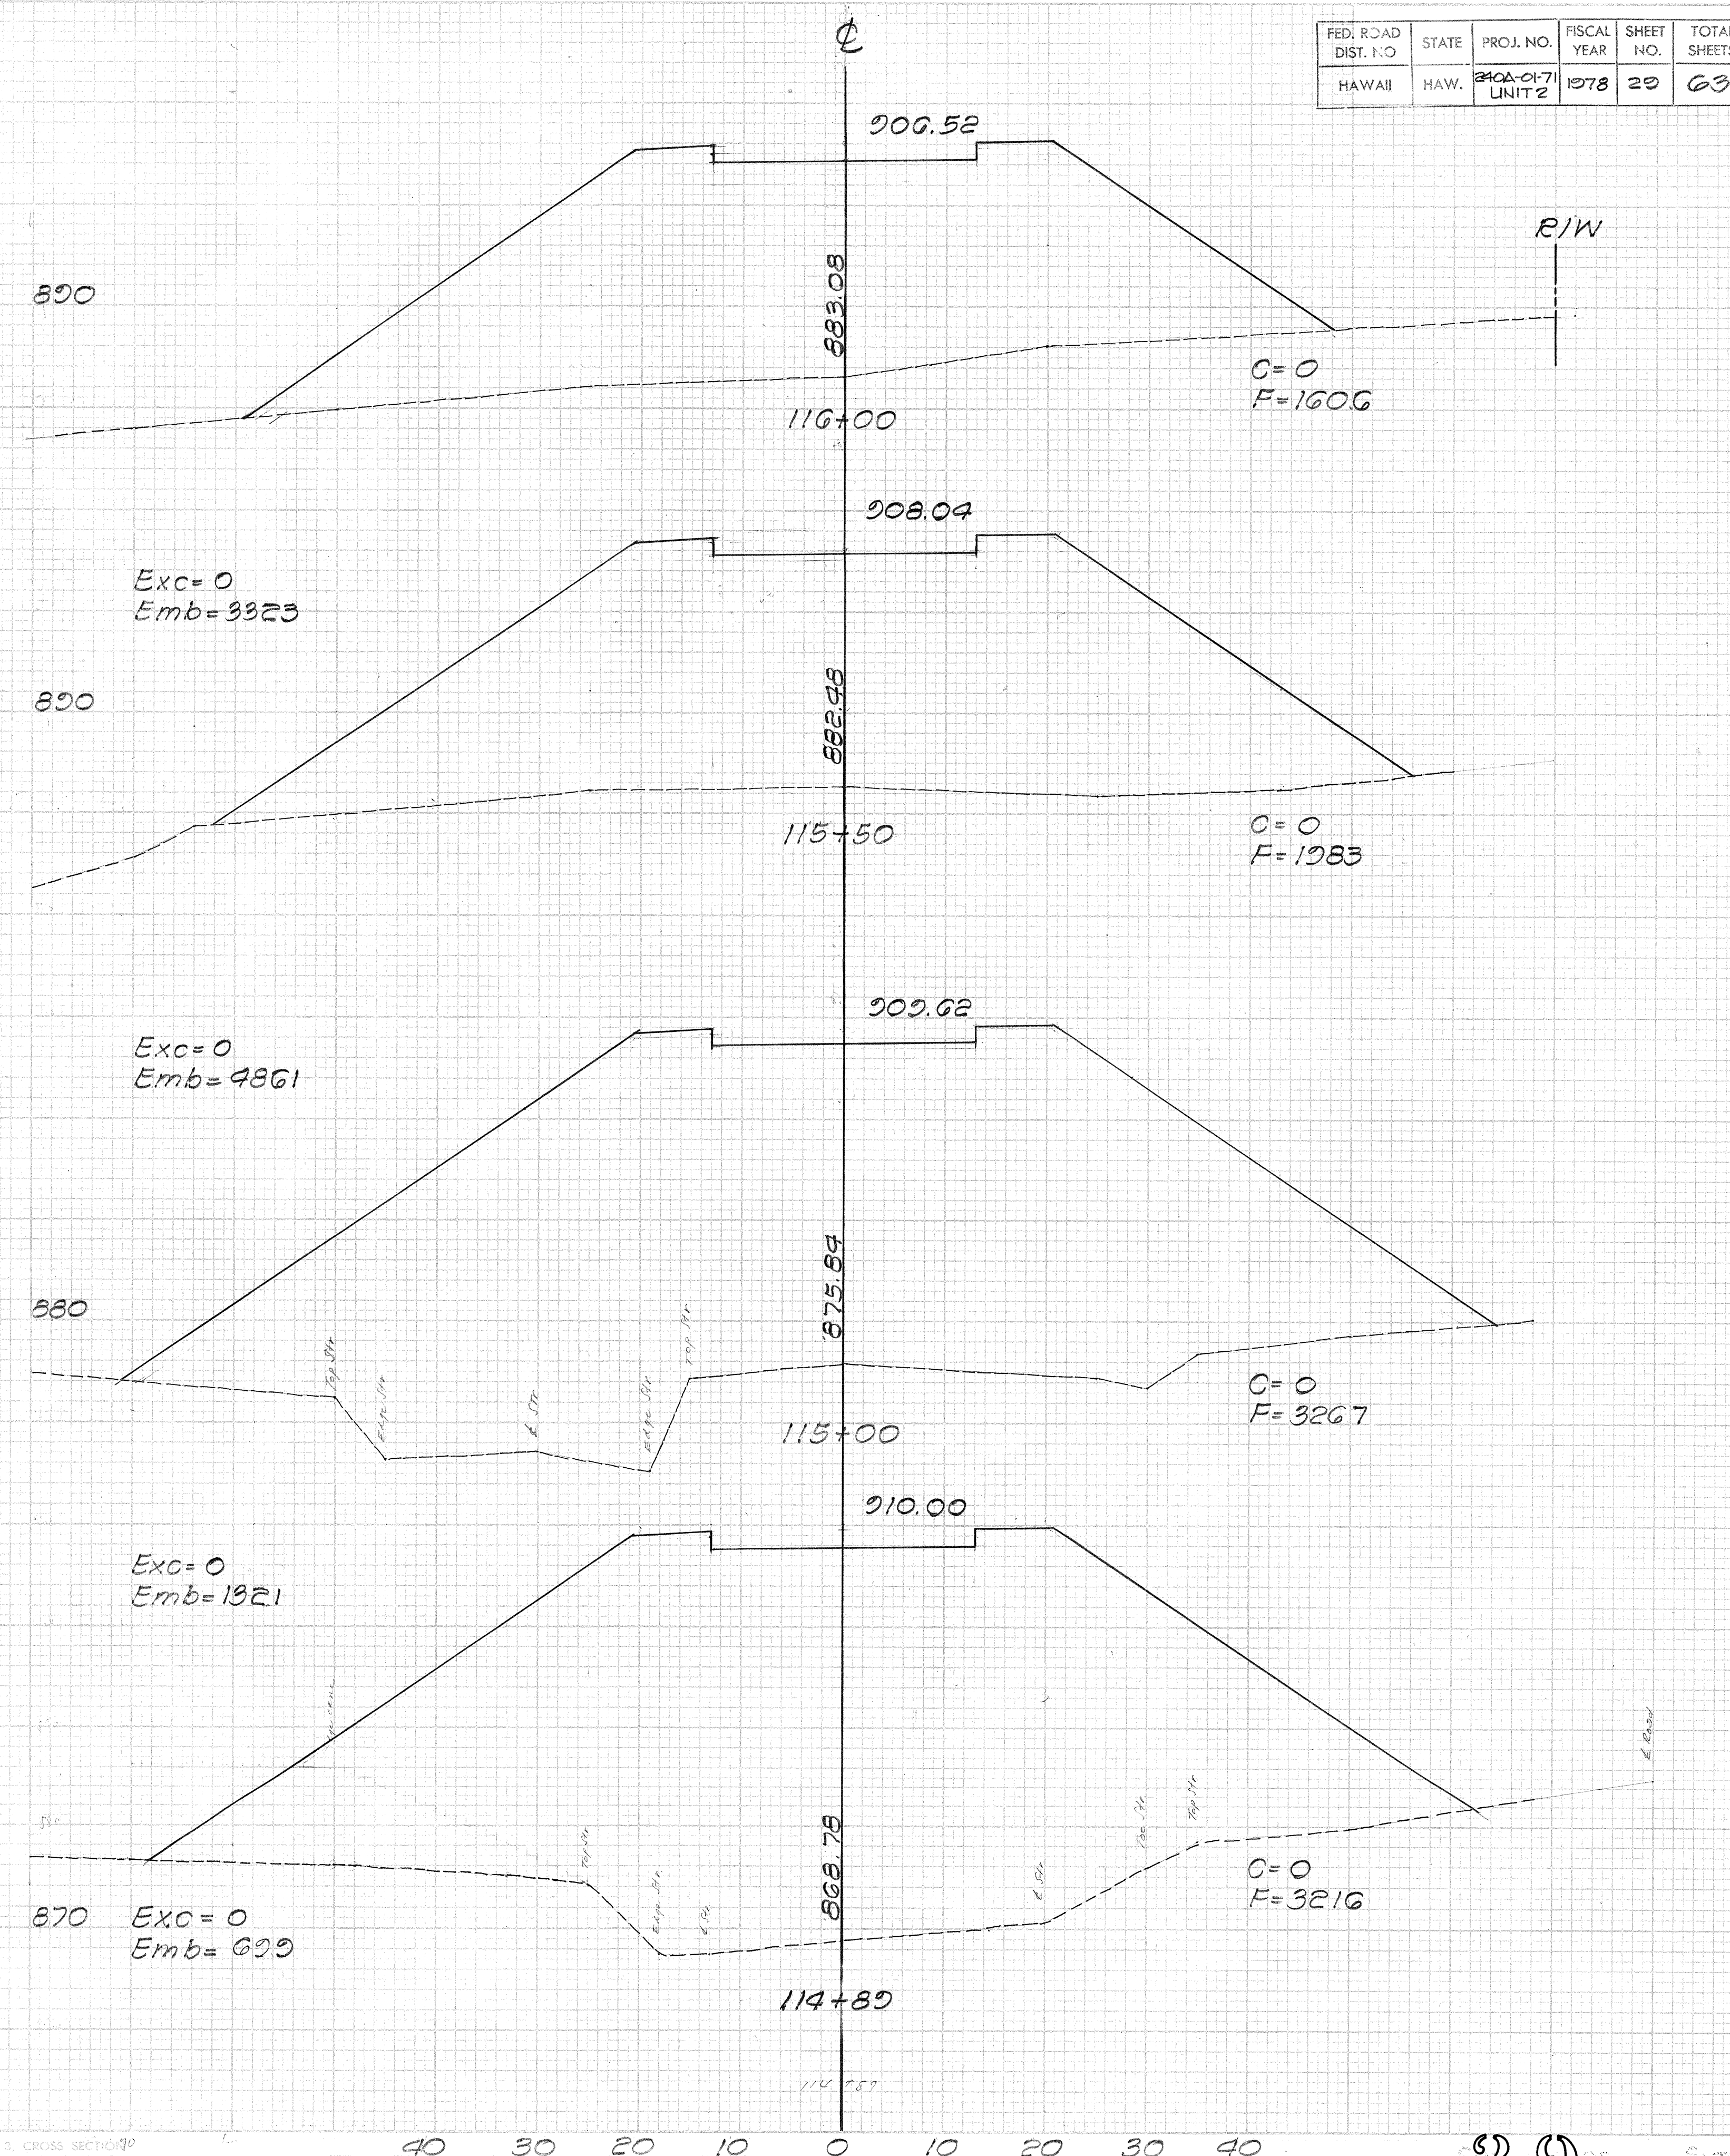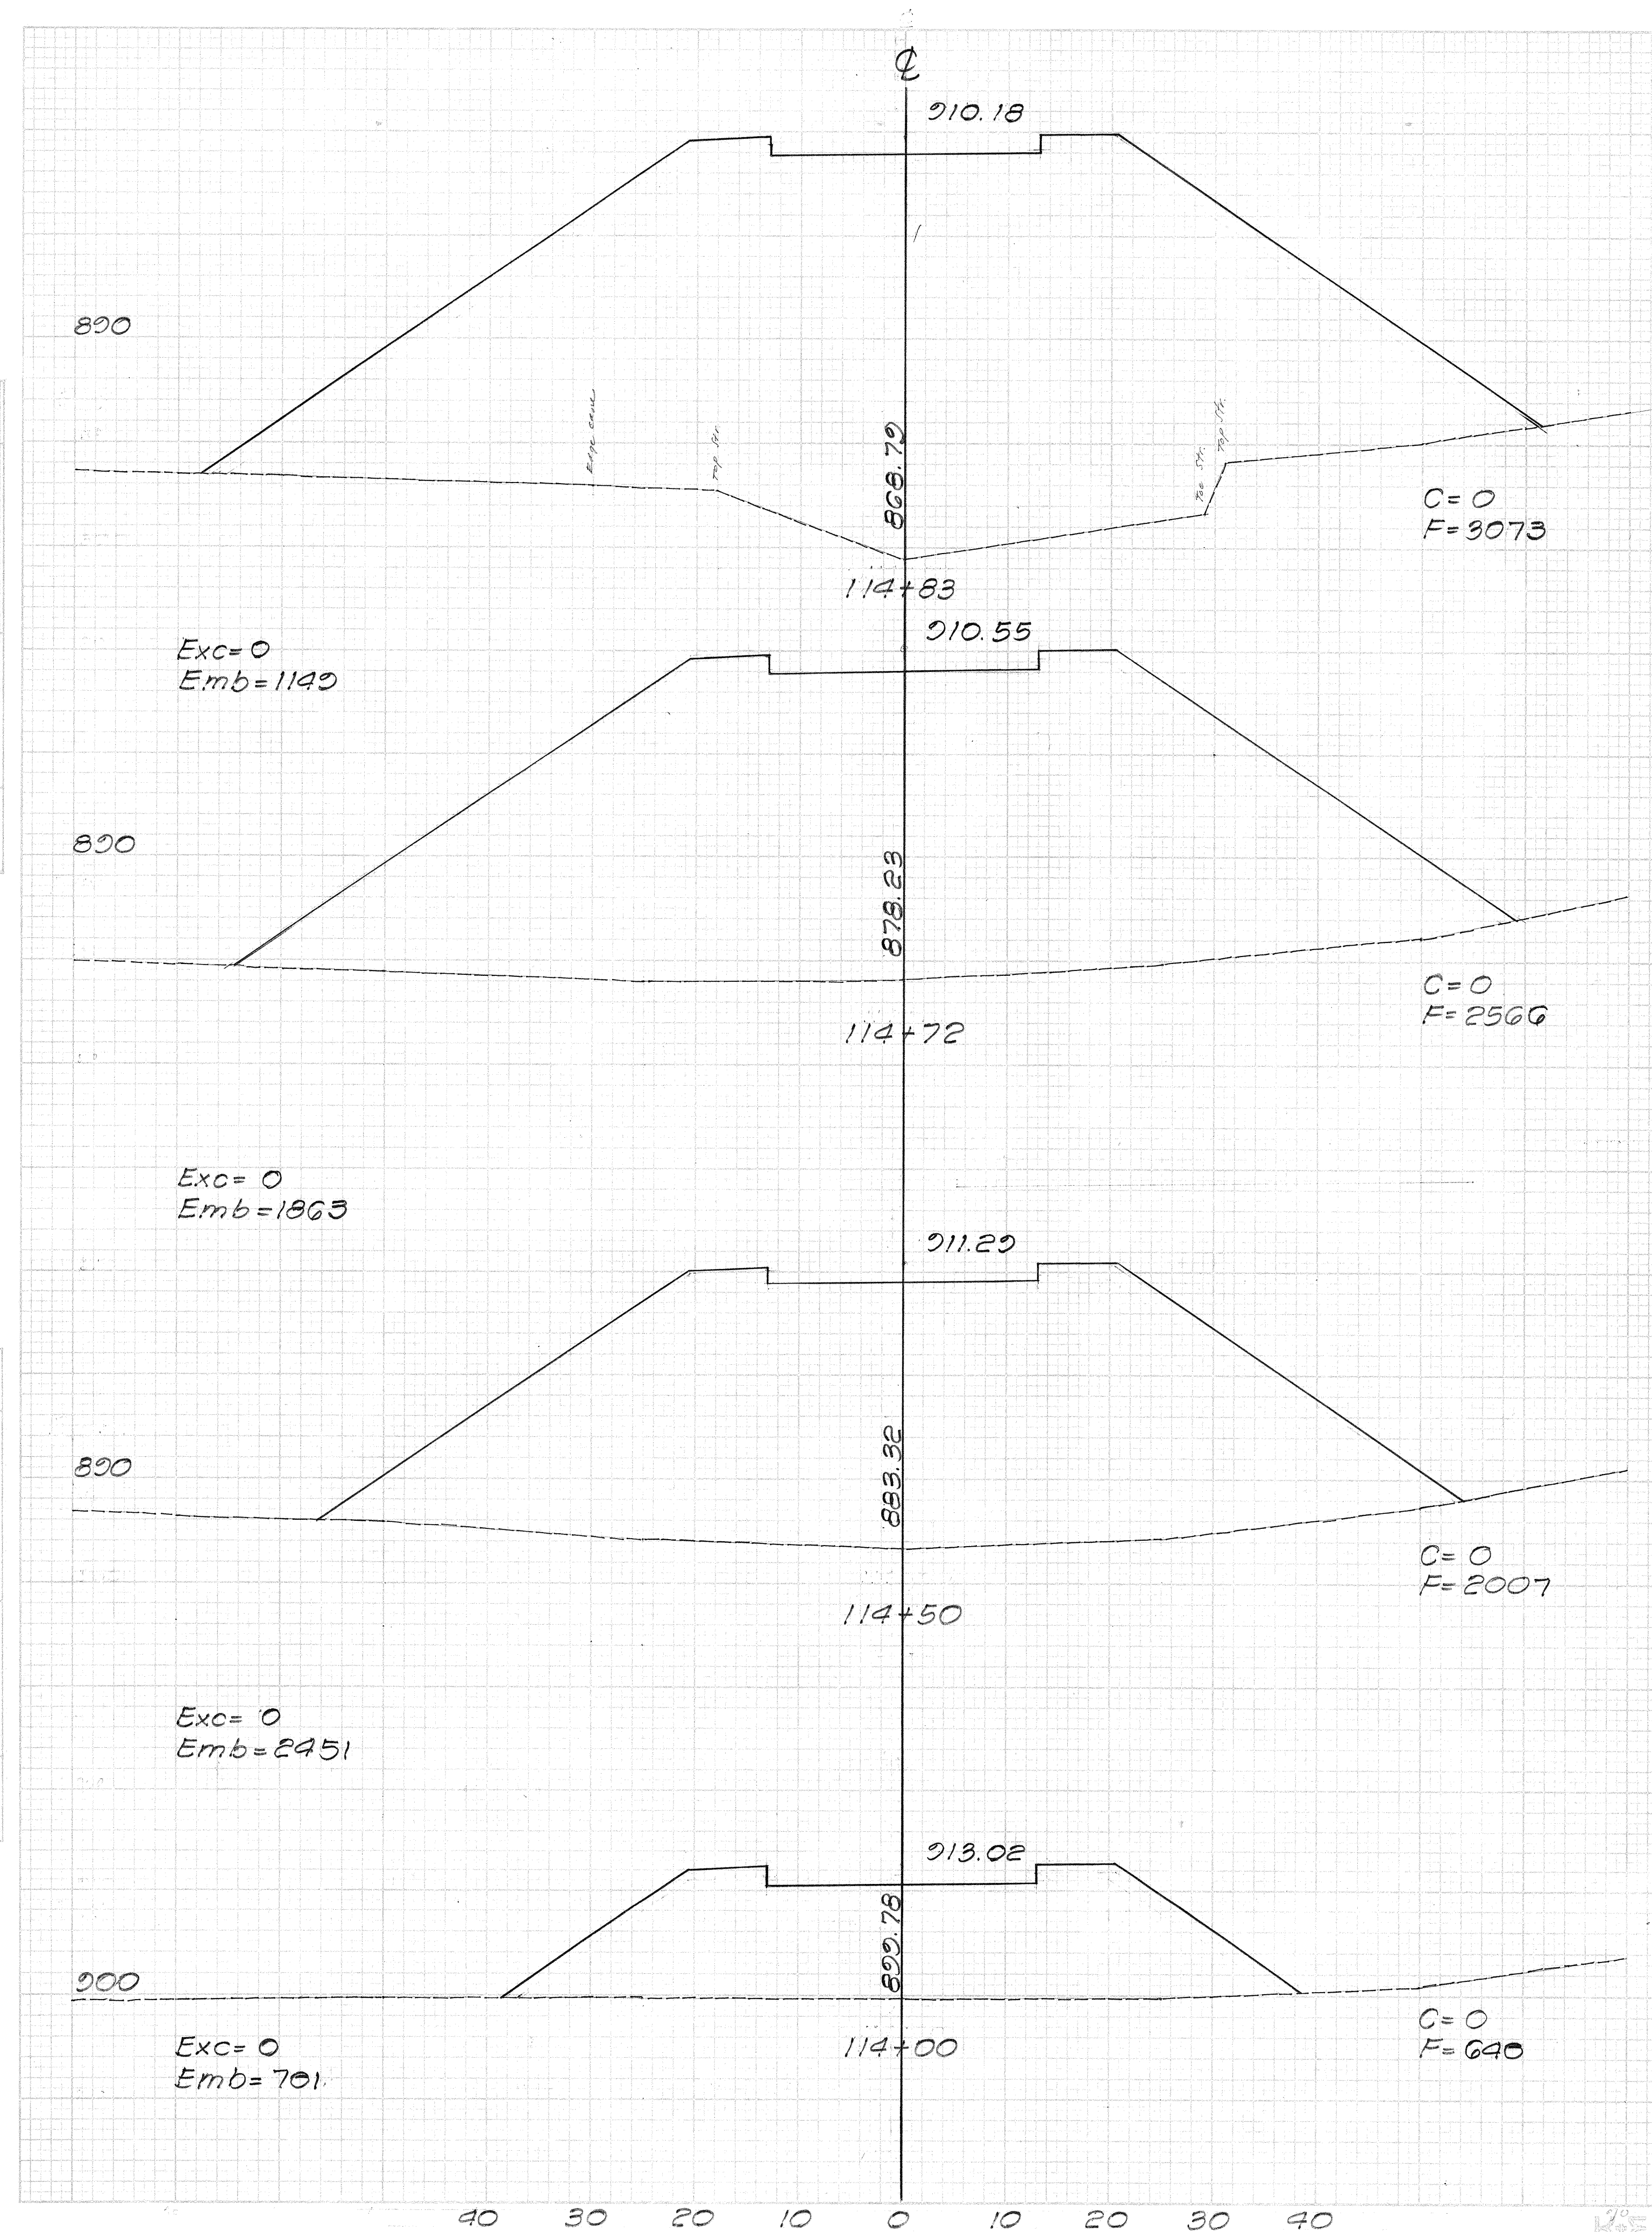



FED. ROAD DIST. NO.	STATE	PROJ. NO.	FISCAL YEAR	SHEET NO.	TOTAL SHEETS
HAWAII	HAW.	240A-0171 UNIT 2	1978	30	63

FINAL SURVEY	DATE
PLANNED	
NOTED	
REMARKS	
NO.	

ORIGINAL SURVEY	DATE
PLANNED	
NOTED	
REMARKS	
NO.	

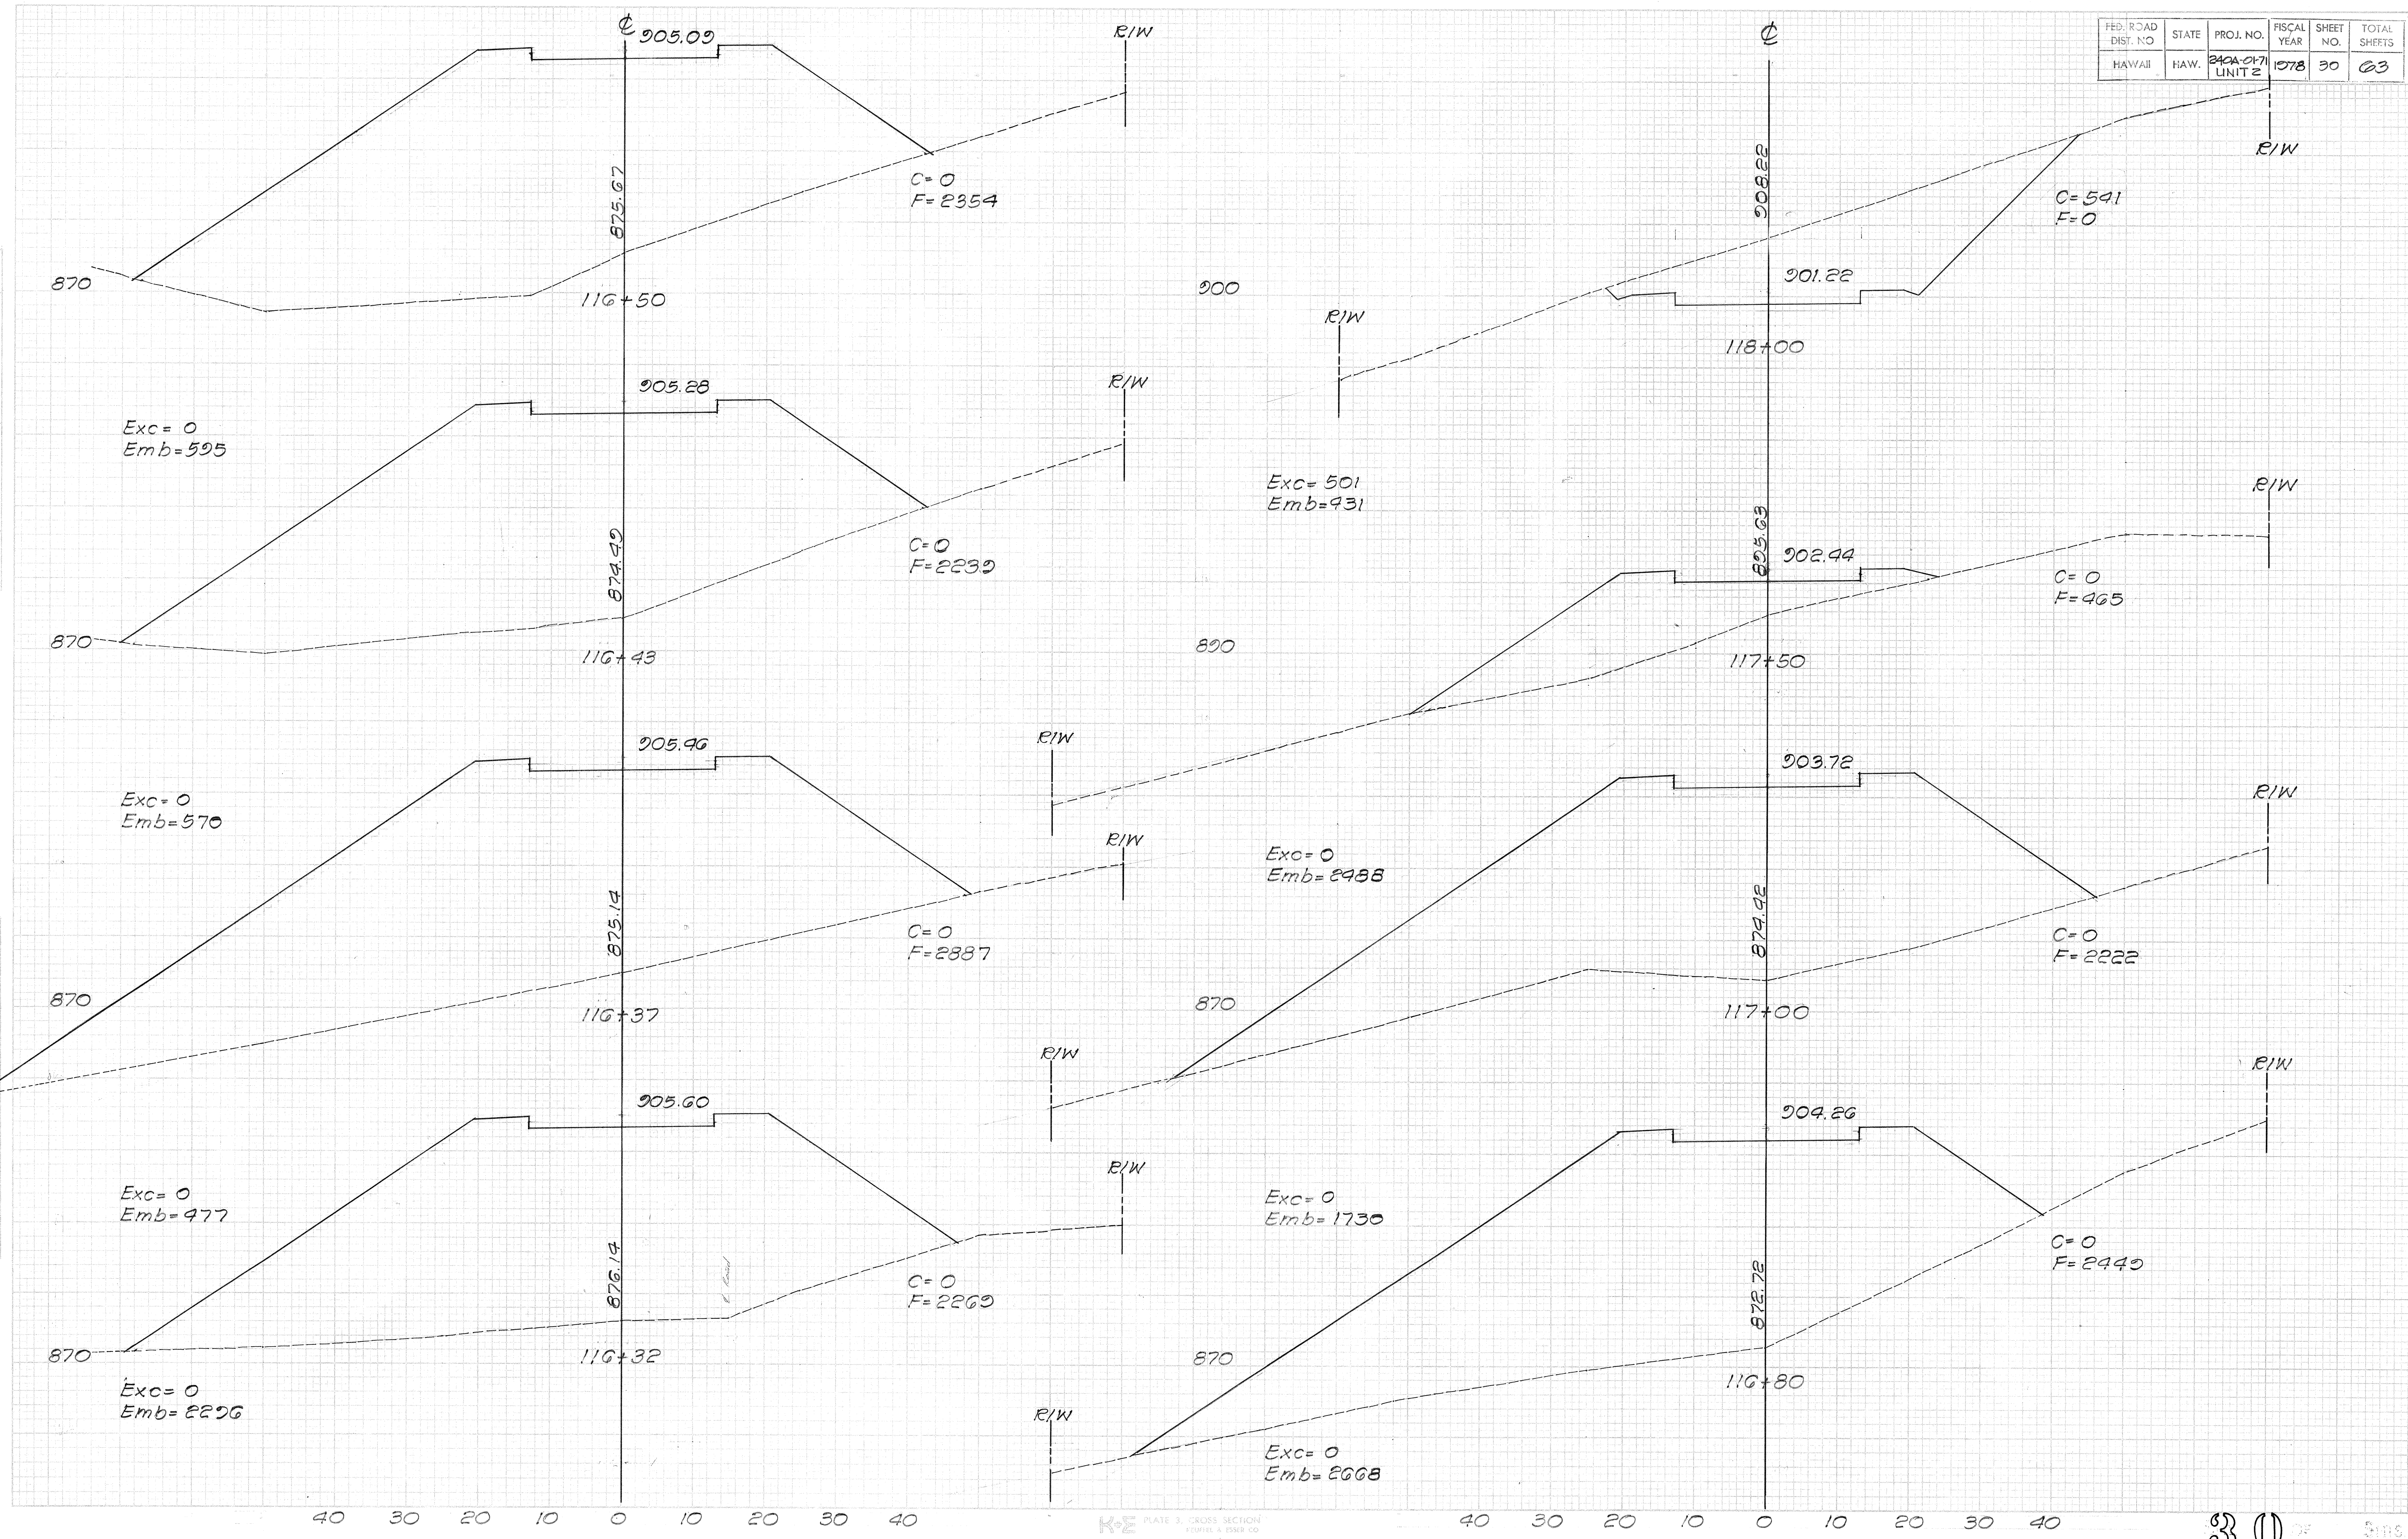


FED. ROAD DIST. NO.	STATE	PROJ. NO.	FISCAL YEAR	SHEET NO.	TOTAL SHEETS
HAWAII	HAW.	24CA-01-71 UNIT 2	1978	31	63

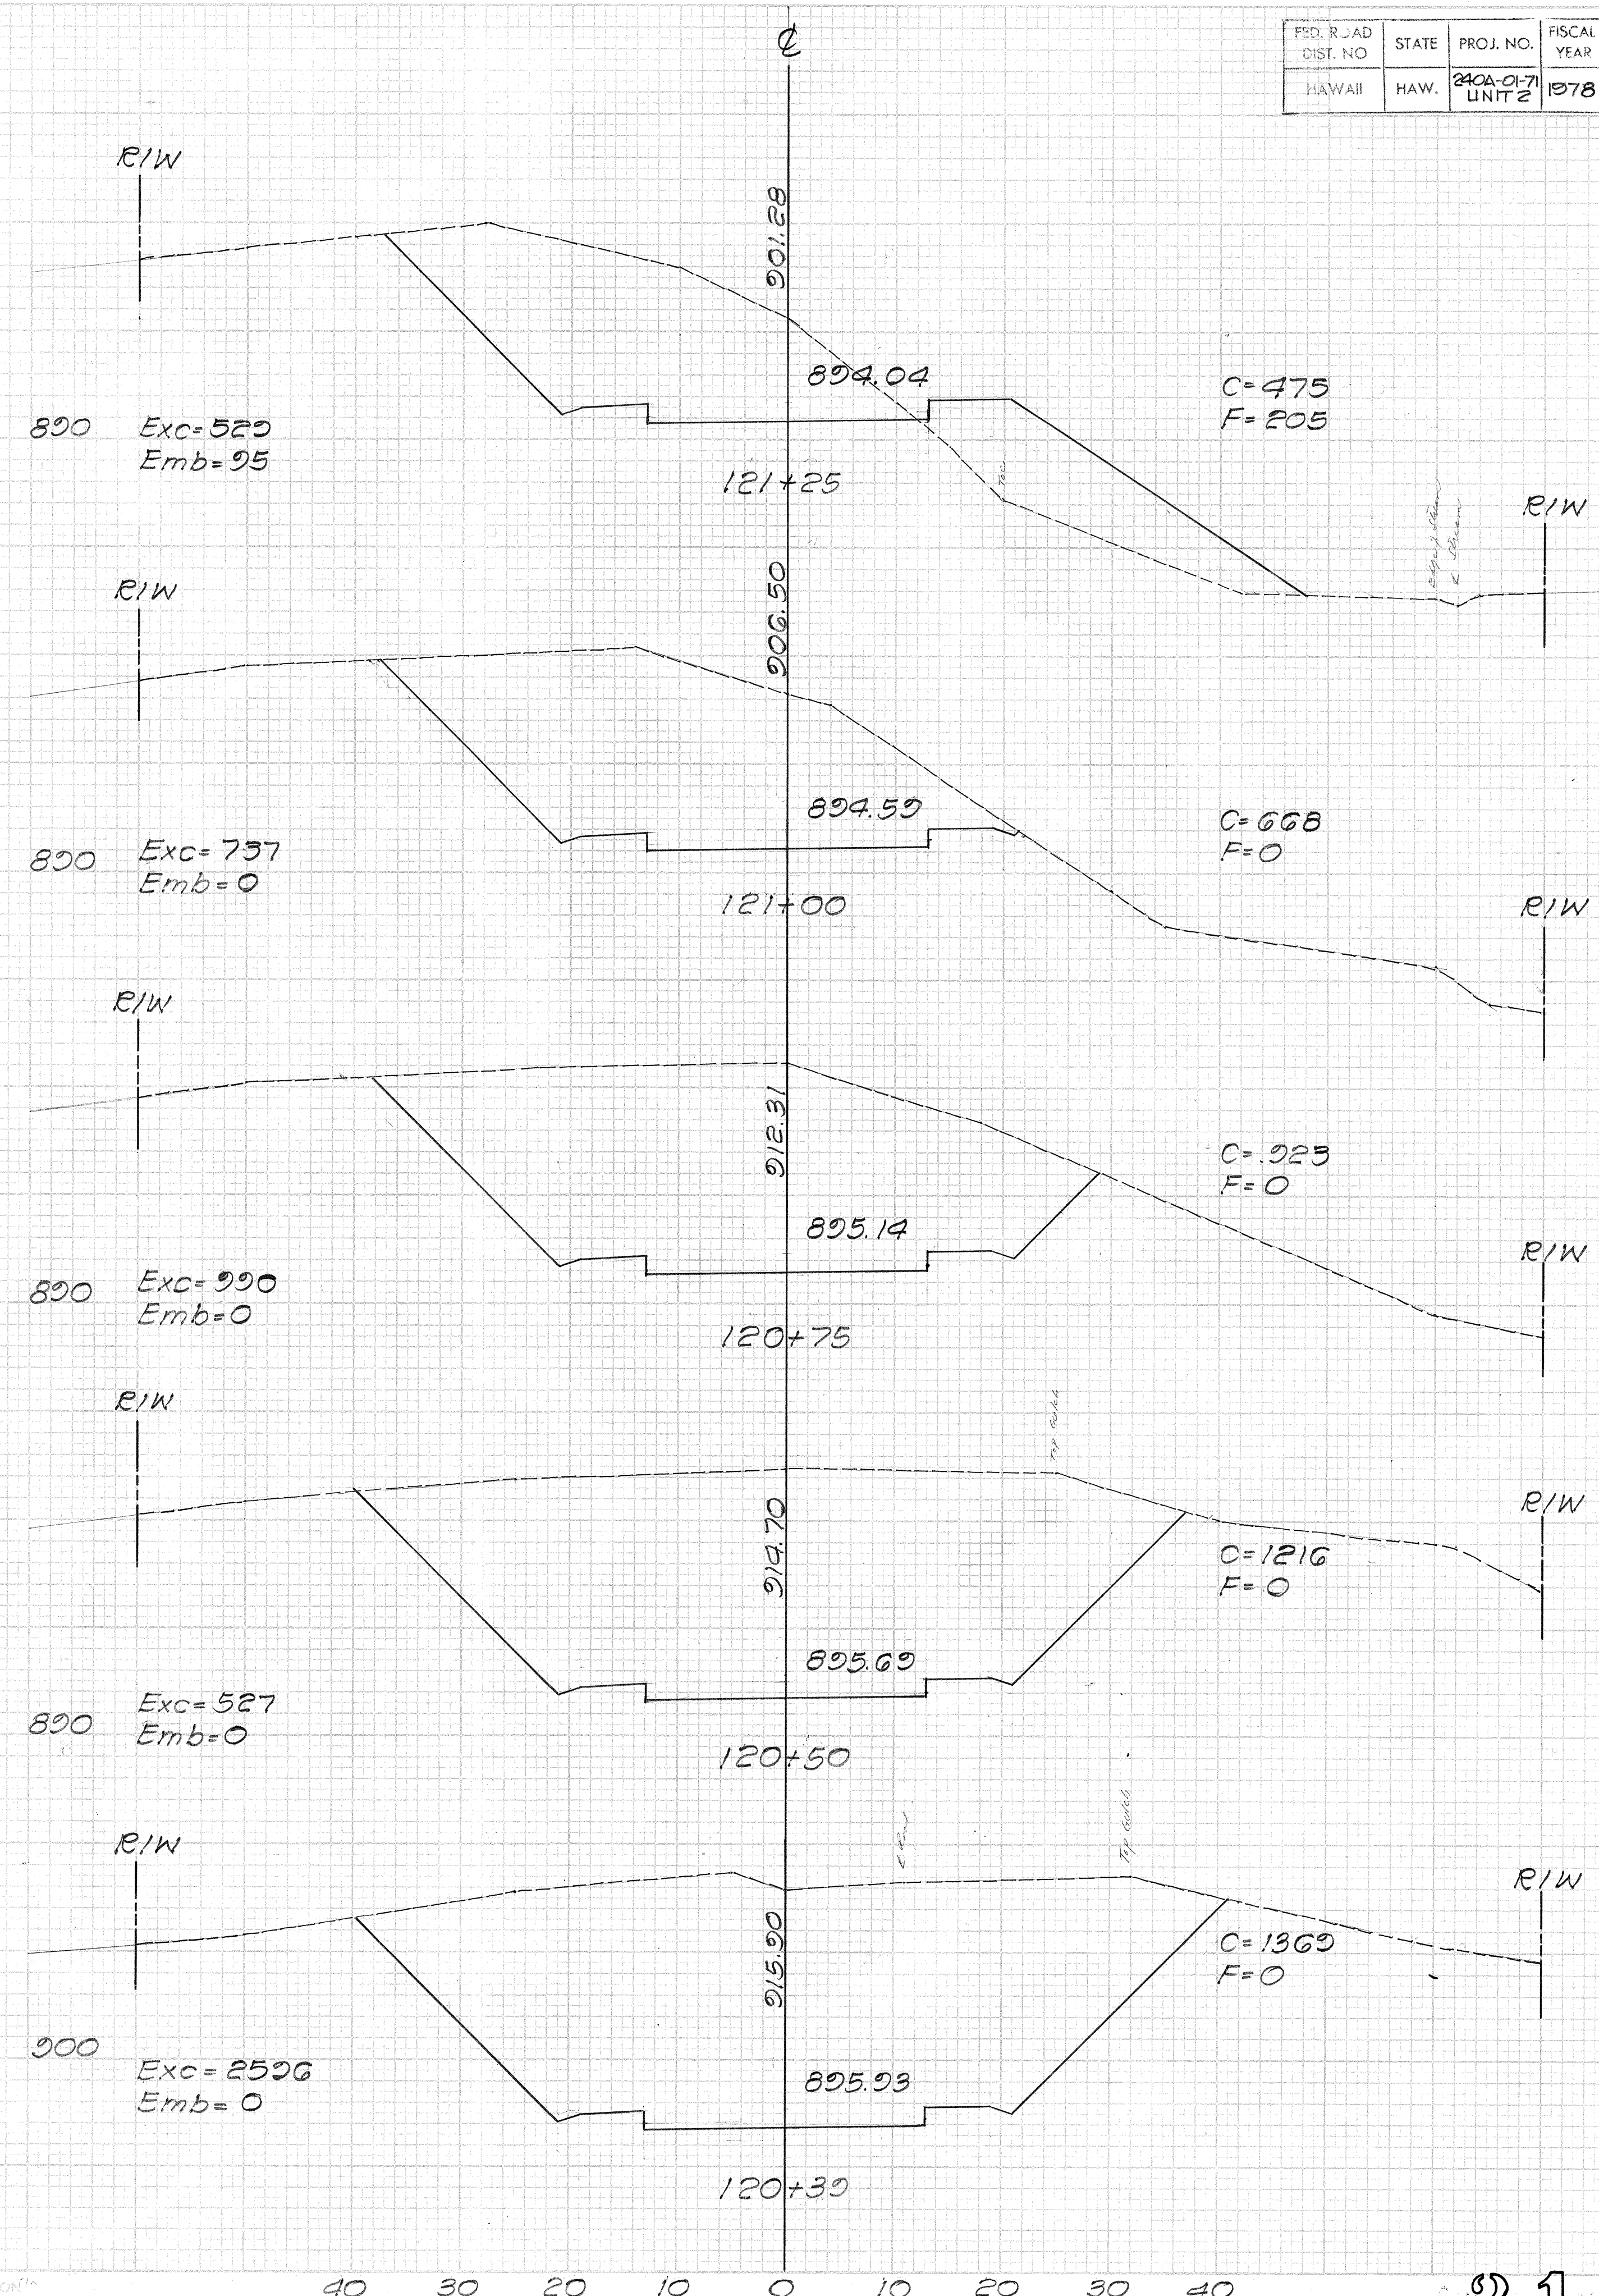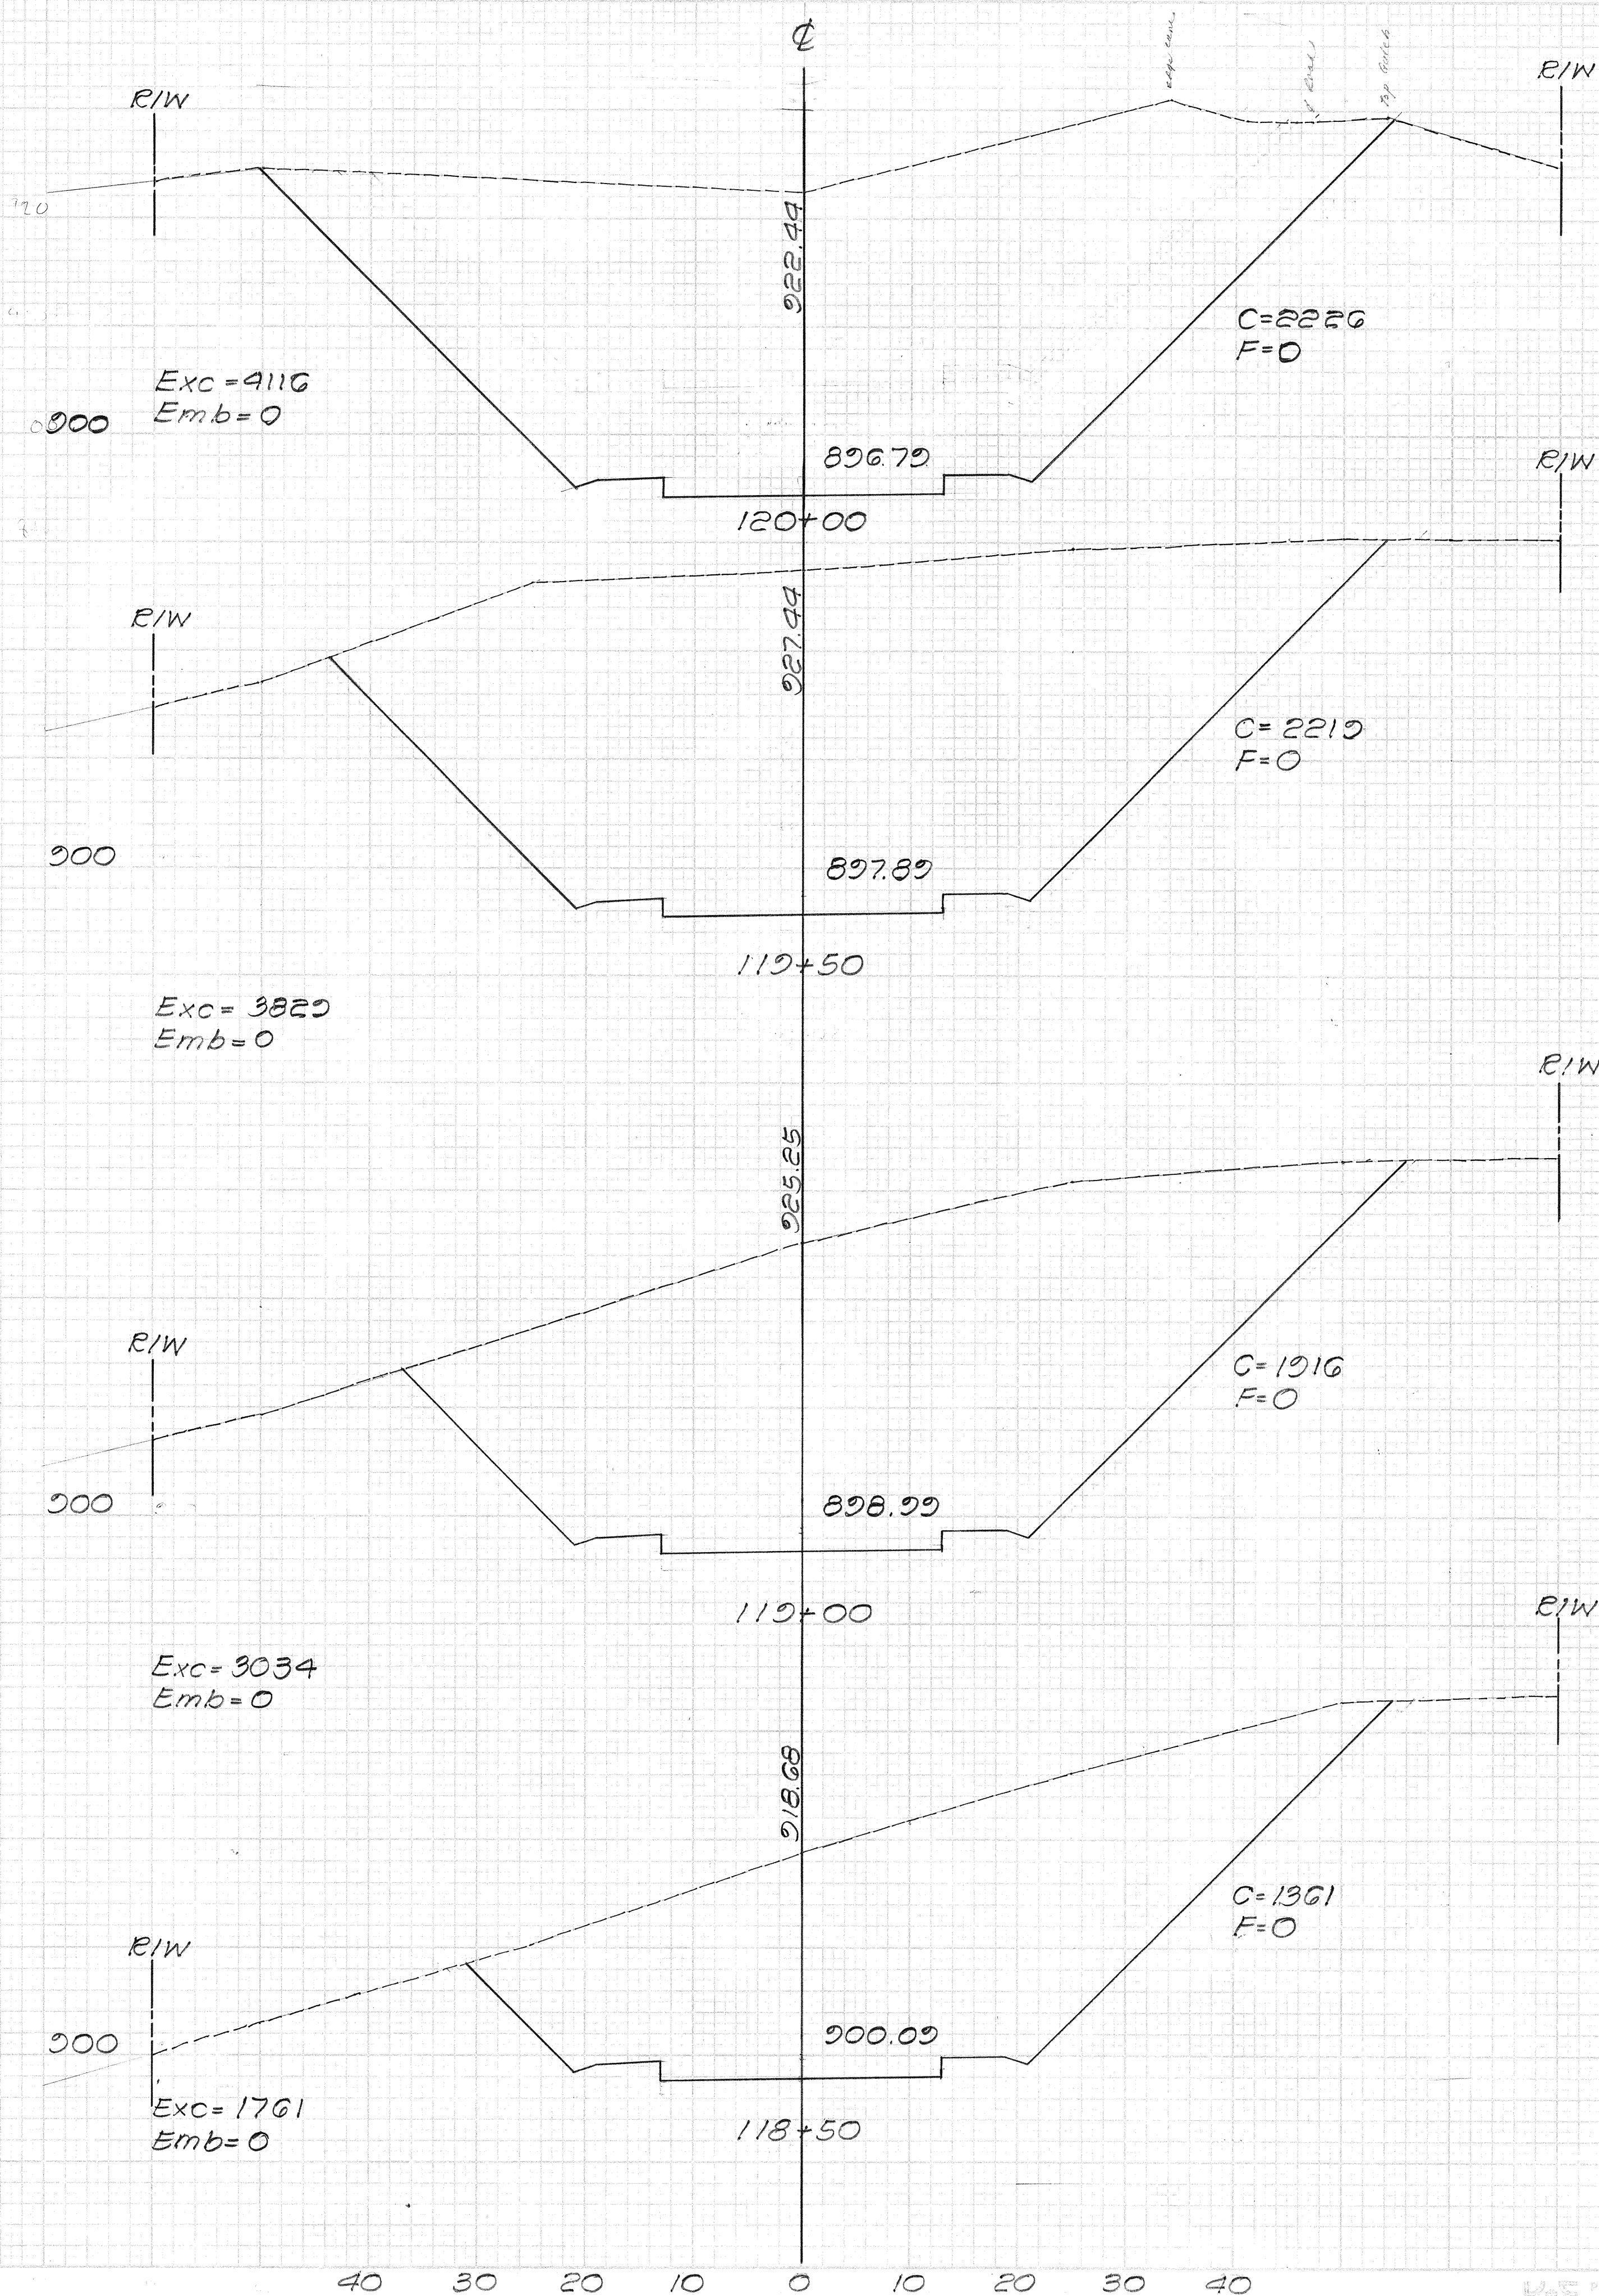

DATE	BY	NO.
FINAL SURVEY	PLOTTED	REVISION
NOTE BOOK	REVISION	NO.
AREAS CHECKED		

DATE	BY	NO.
ORIGINAL SURVEY	PLOTTED	REVISION
NOTE BOOK	REVISION	NO.
AREAS CHECKED		



FED. ROAD DIST. NO.	STATE	PROJ. NO.	FISCAL YEAR	SHEET NO.	TOTAL SHEETS
HAWAII	HAW.	240A-01-71 UNIT 2	1978	32	63

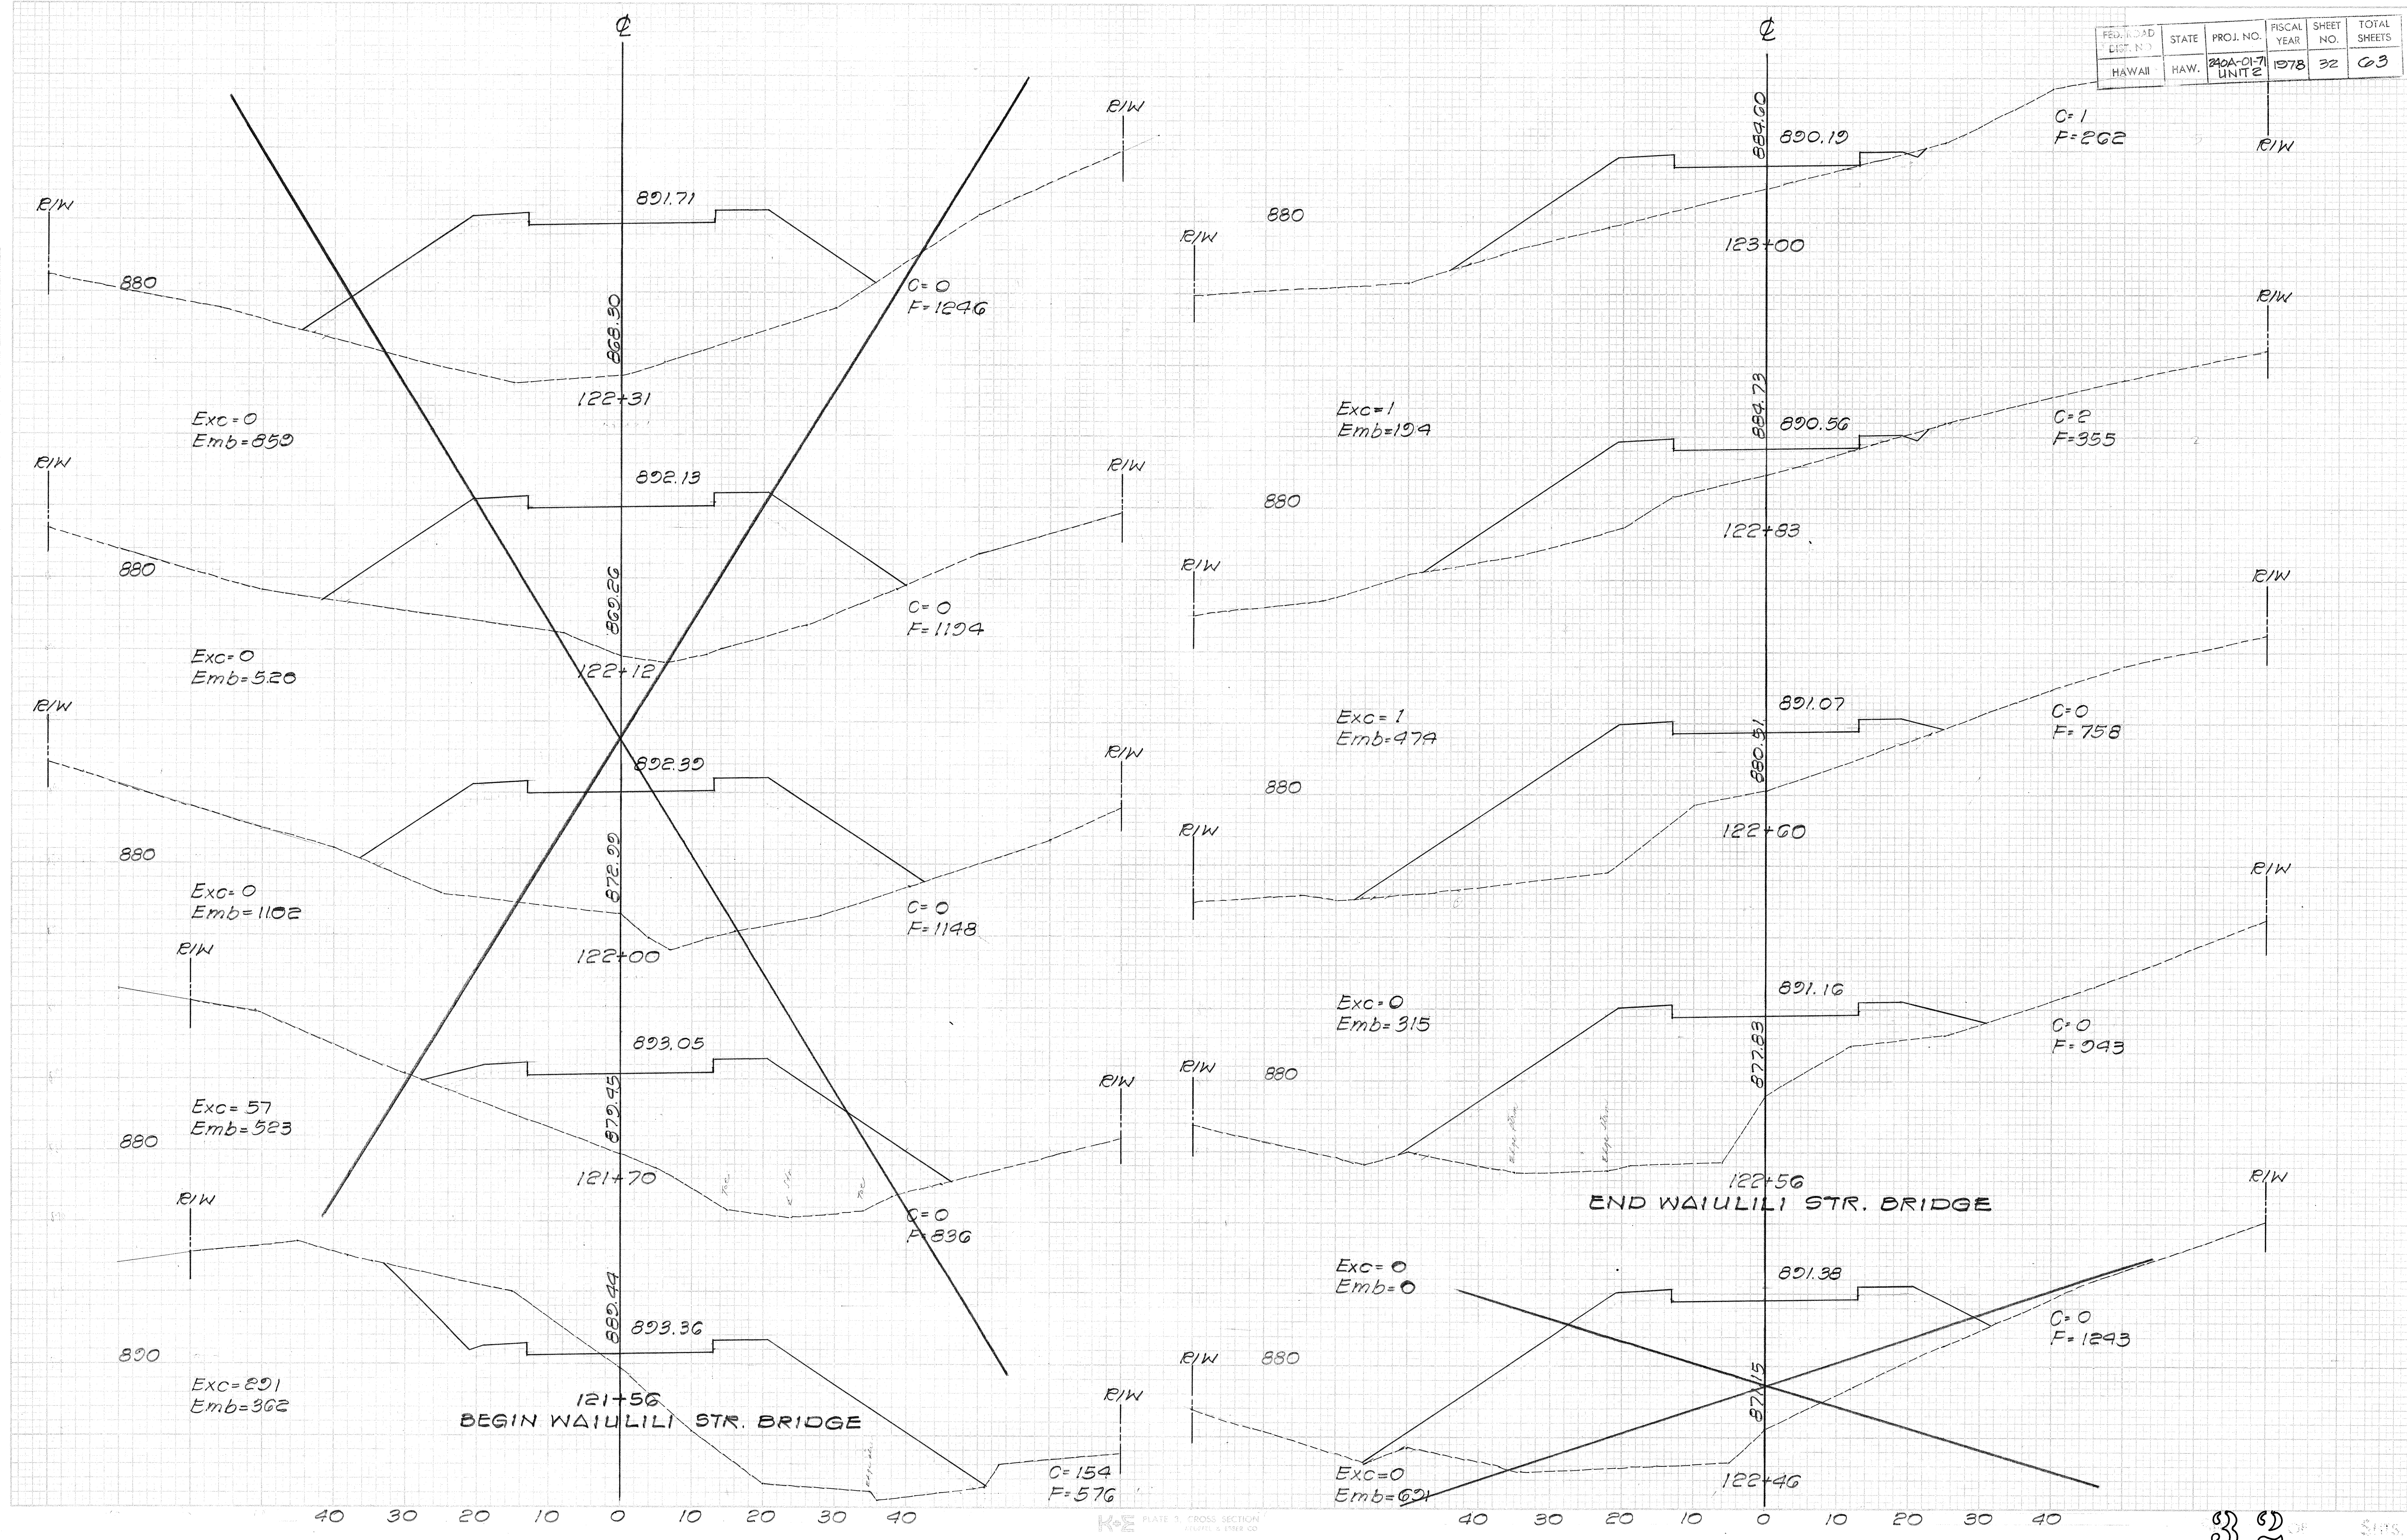

DATE: _____
 BY: _____
 SURVEYED: _____
 PLOTTED: _____
 FINAL: _____
 NO. _____
 NOTE BOOK: _____
 TEMPLATE: _____
 AREAS CHECKED: _____

DATE: _____
 BY: _____
 SURVEYED: _____
 PLOTTED: _____
 ORIGINAL: _____
 NO. _____
 NOTE BOOK: _____
 TEMPLATE: _____
 AREAS CHECKED: _____

FED. ROAD DIST. NO.	STATE	PROJ. NO.	FISCAL YEAR	SHEET NO.	TOTAL SHEETS
HAWAII	HAW.	240A-01-71 UNIT 2	1978	33	63

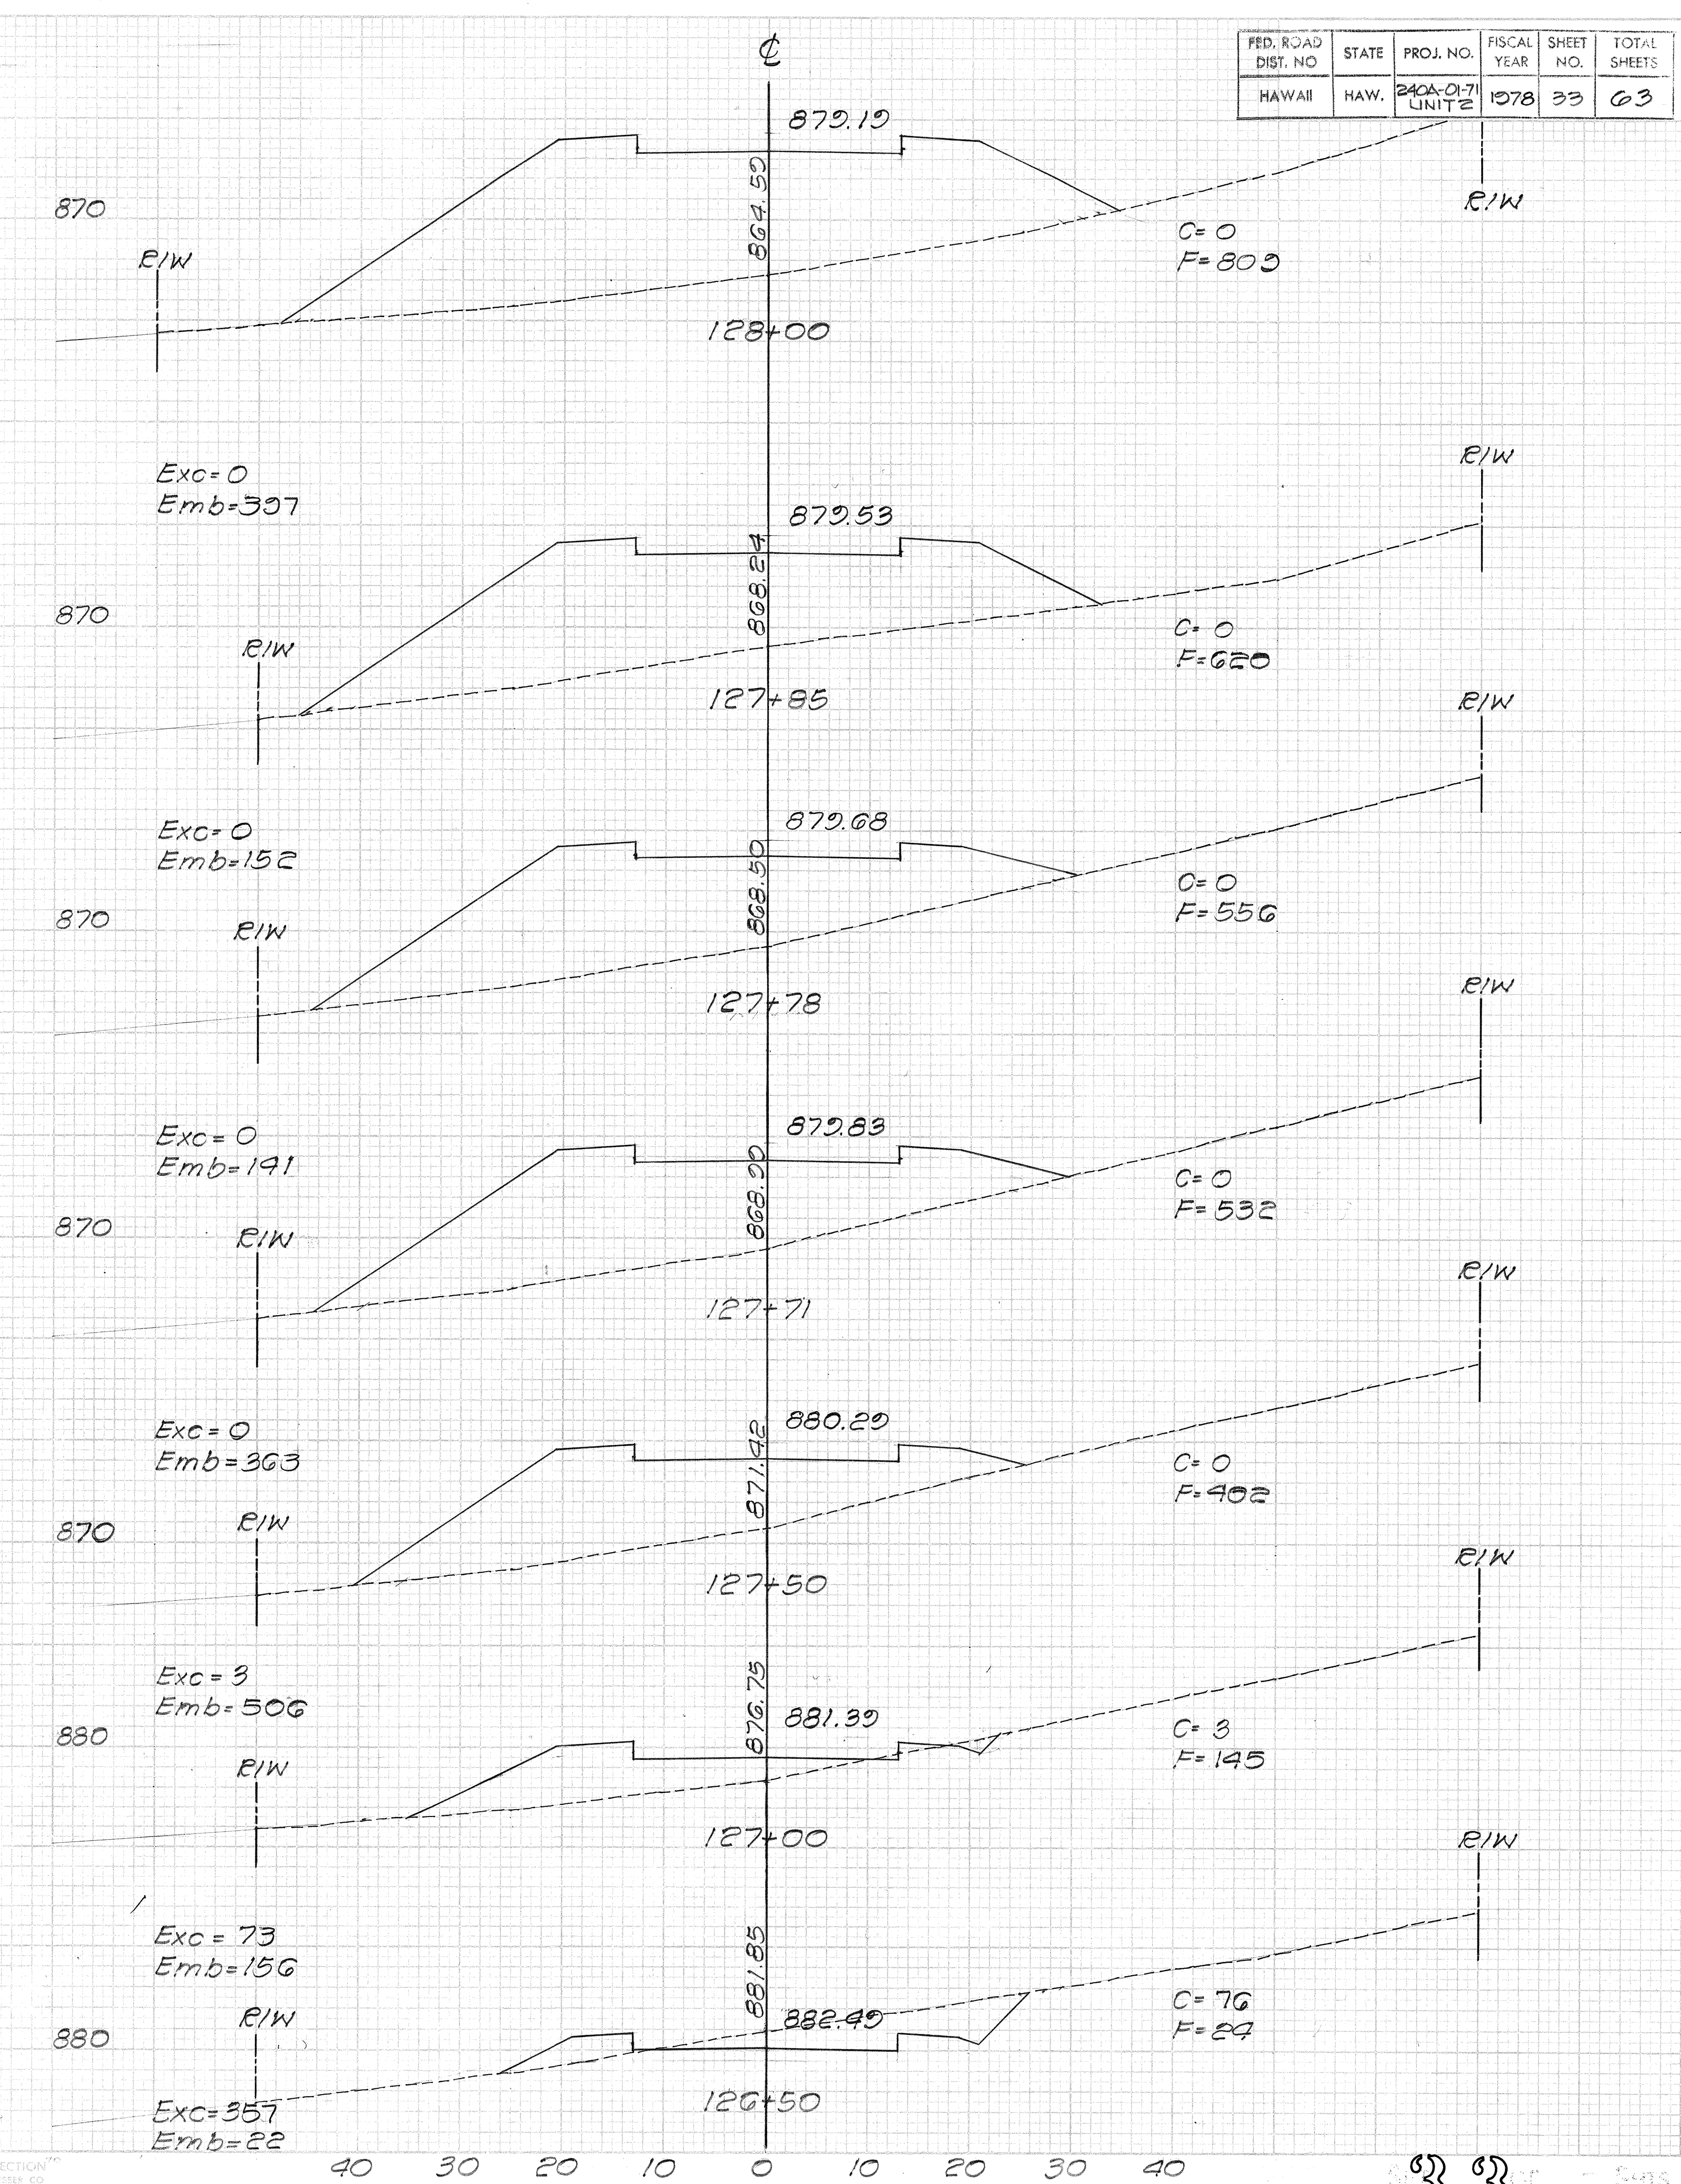
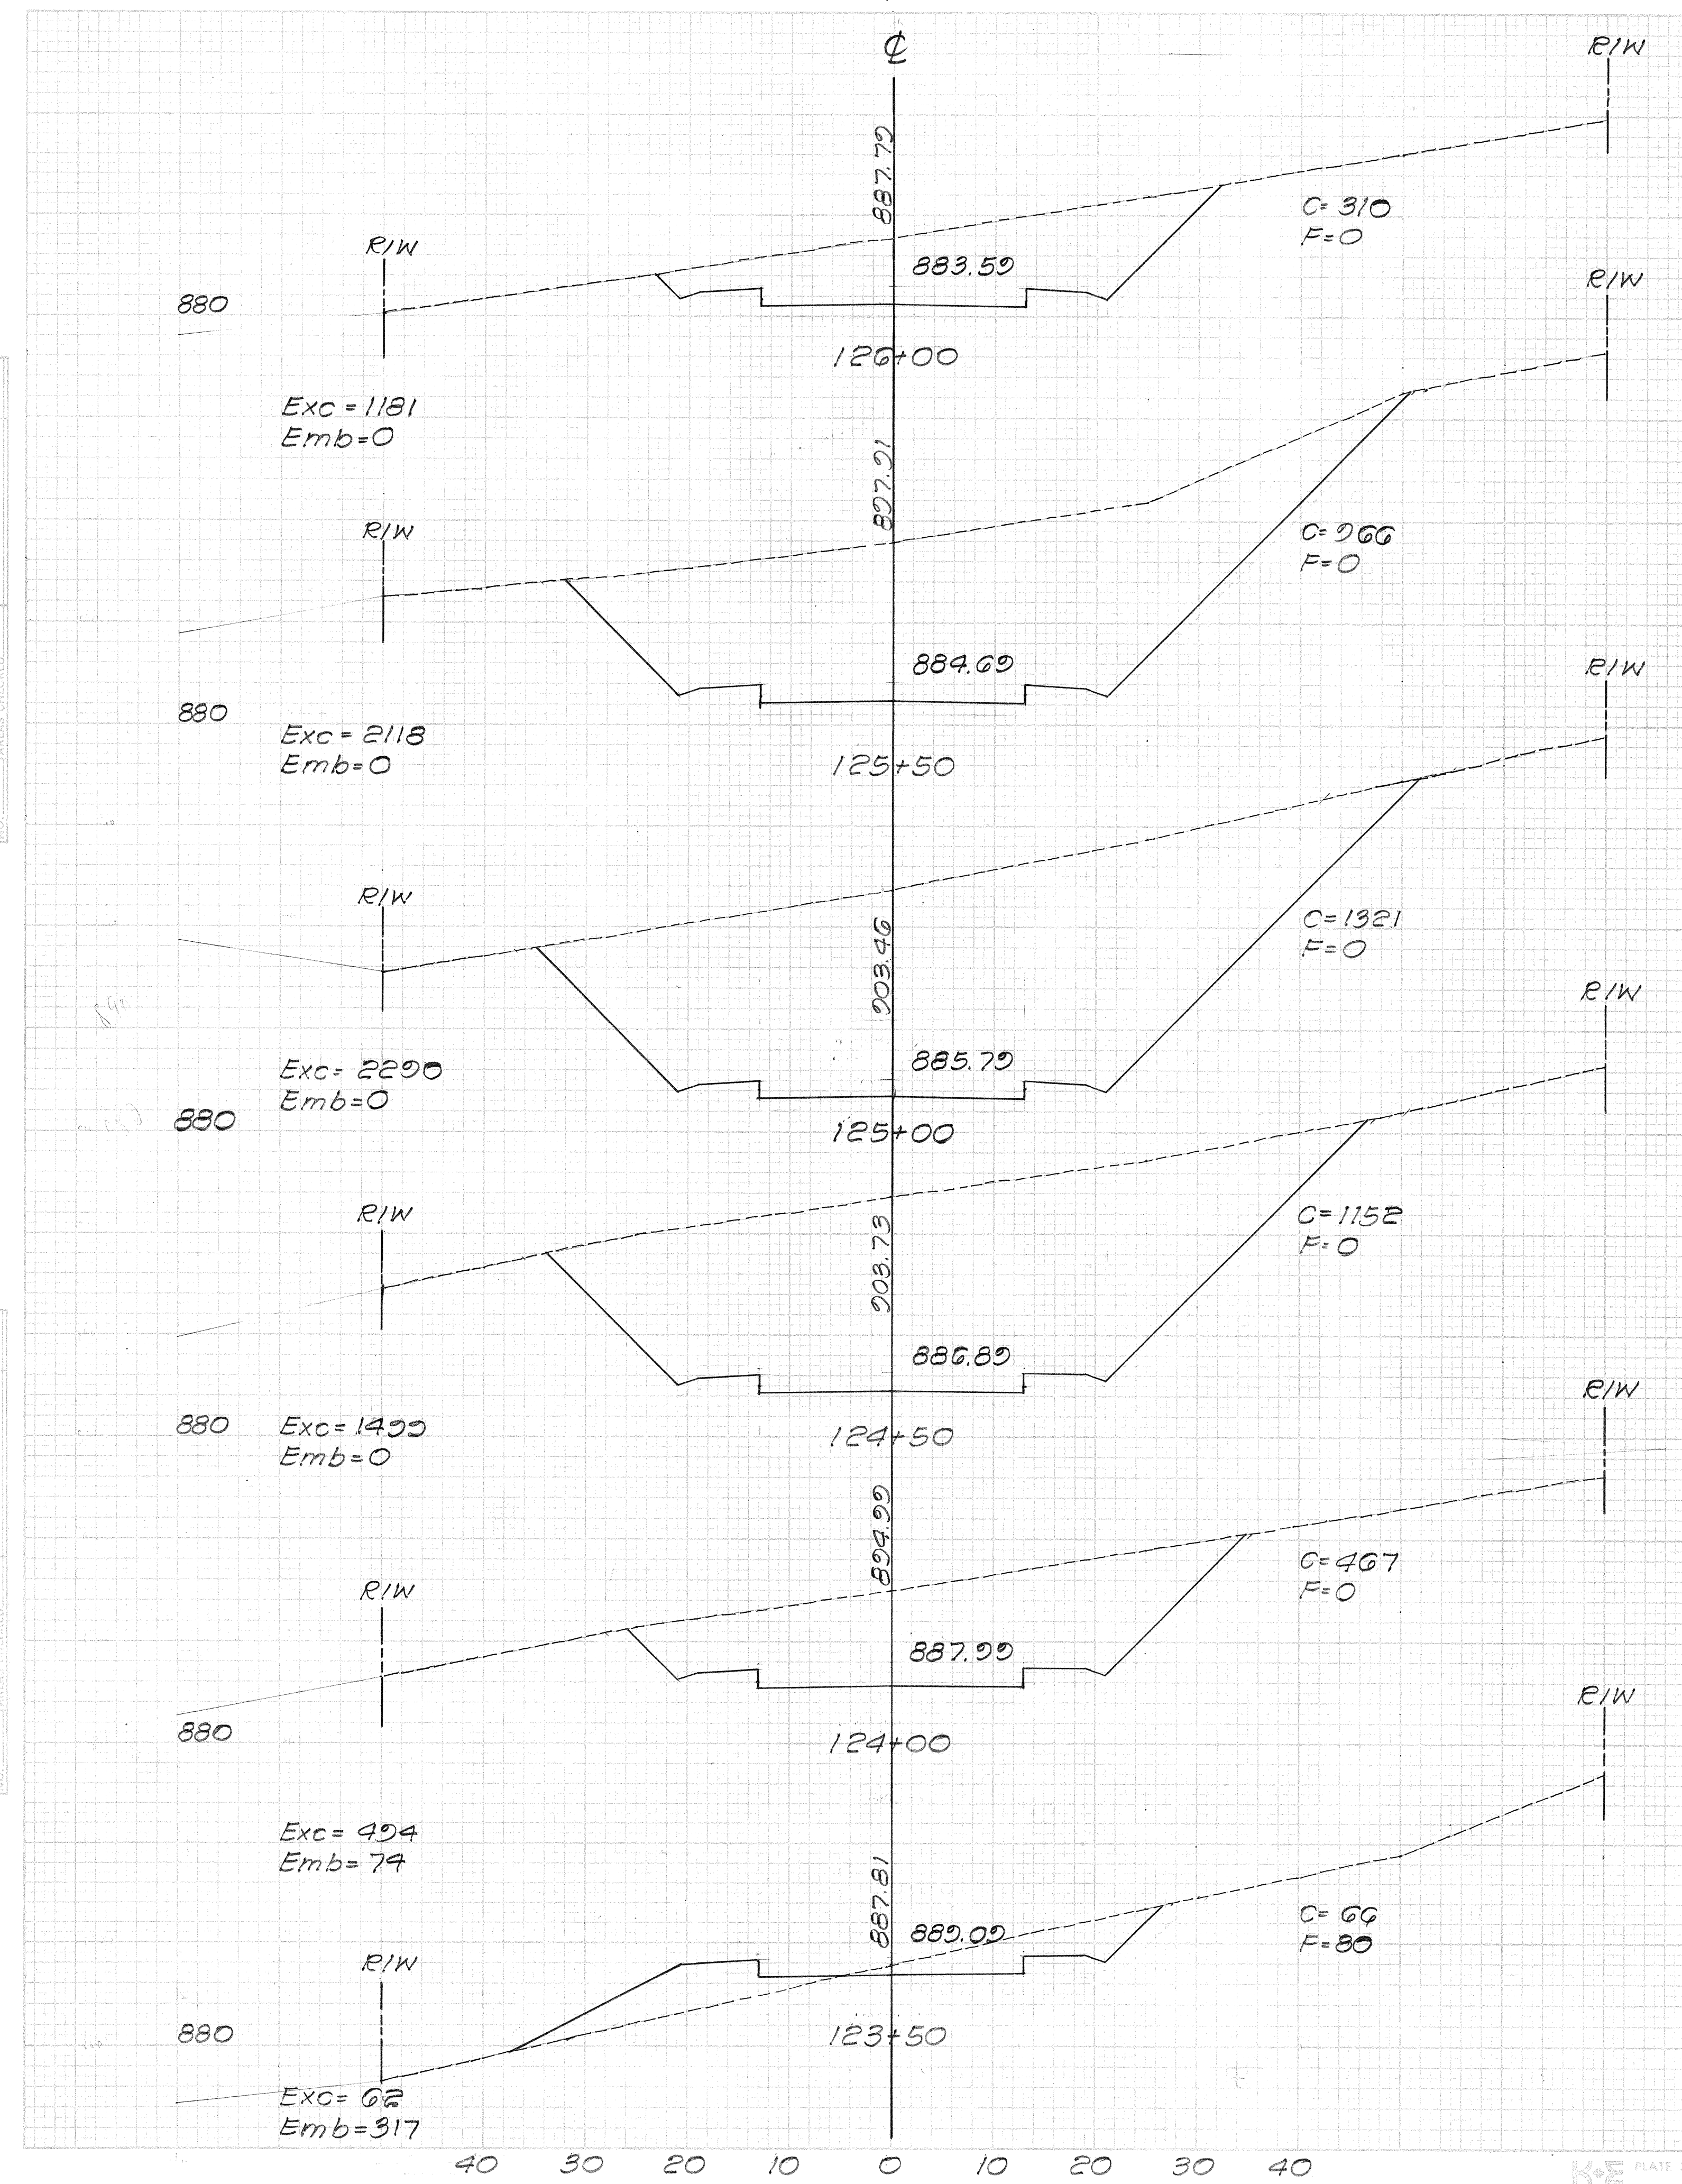



PAU

FED. ROAD DIST. NO.	STATE	PROJ. NO.	FISCAL YEAR	SHEET NO.	TOTAL SHEETS
HAWAII	HAW.	240A-01-71 UNIT 2	1978	34	63

DATE	BY	FINAL SURVEY	REVISION	NO.

DATE	BY	ORIGINAL SURVEY	REVISION	NO.

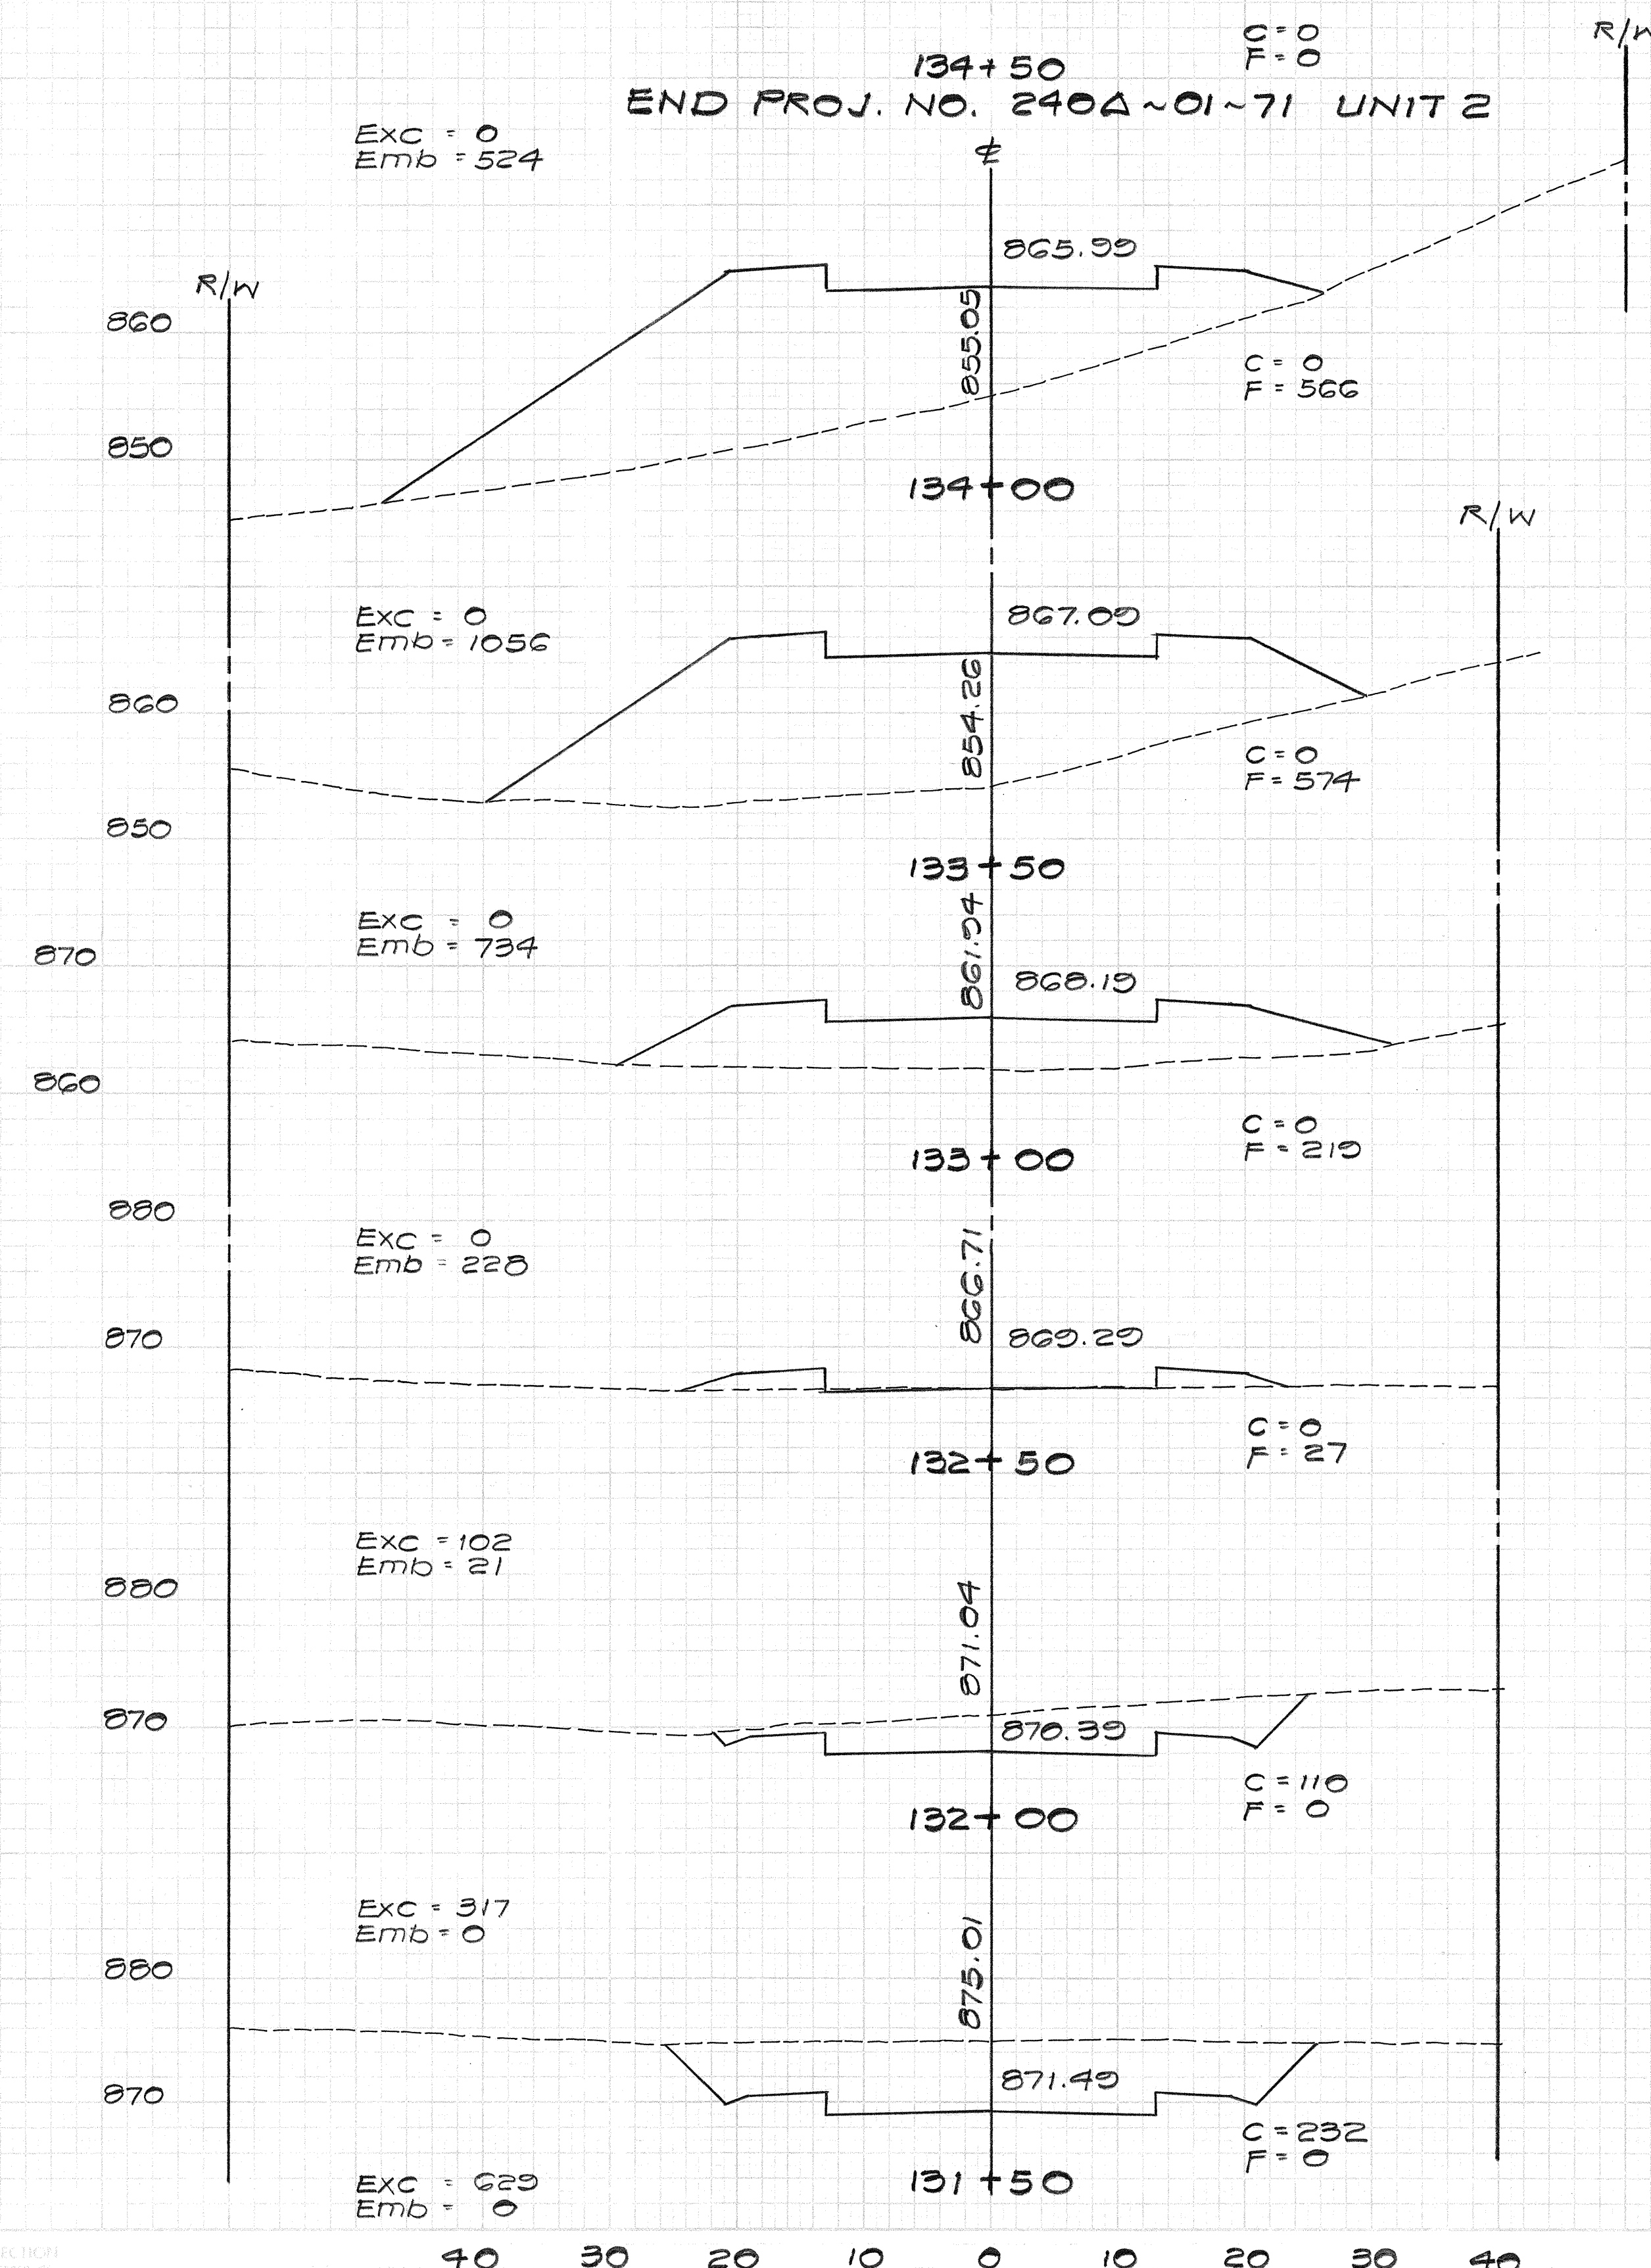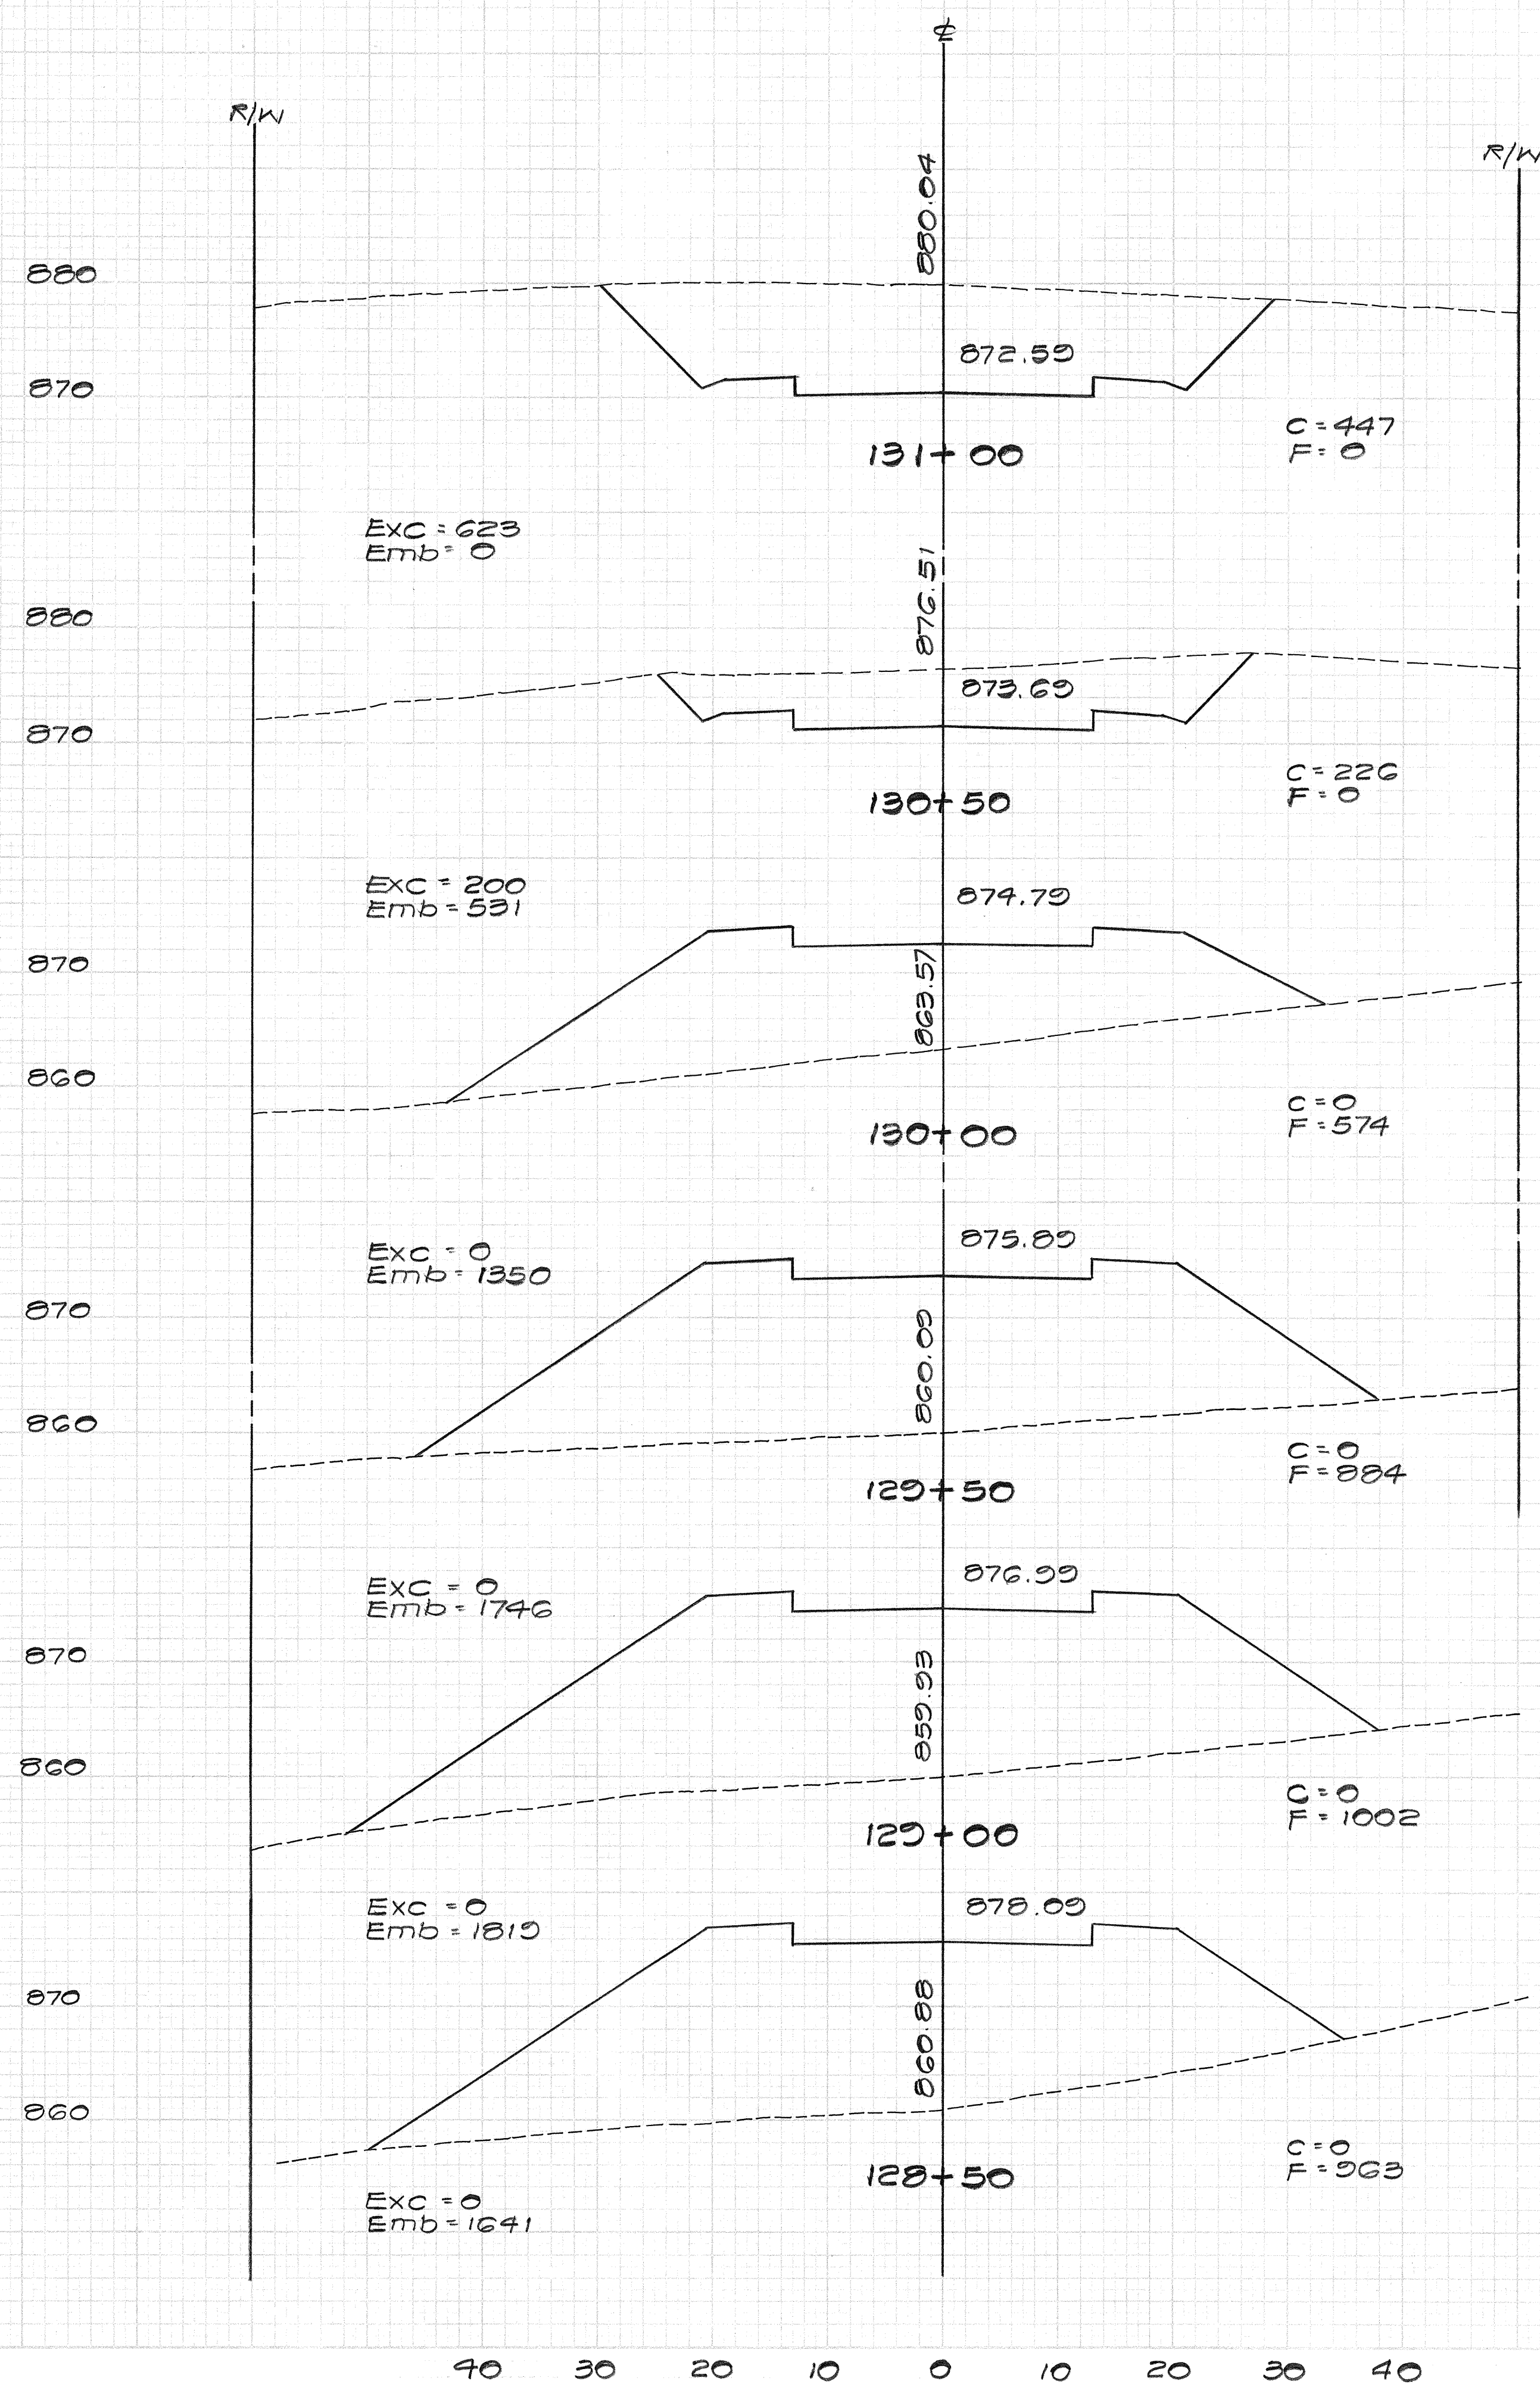


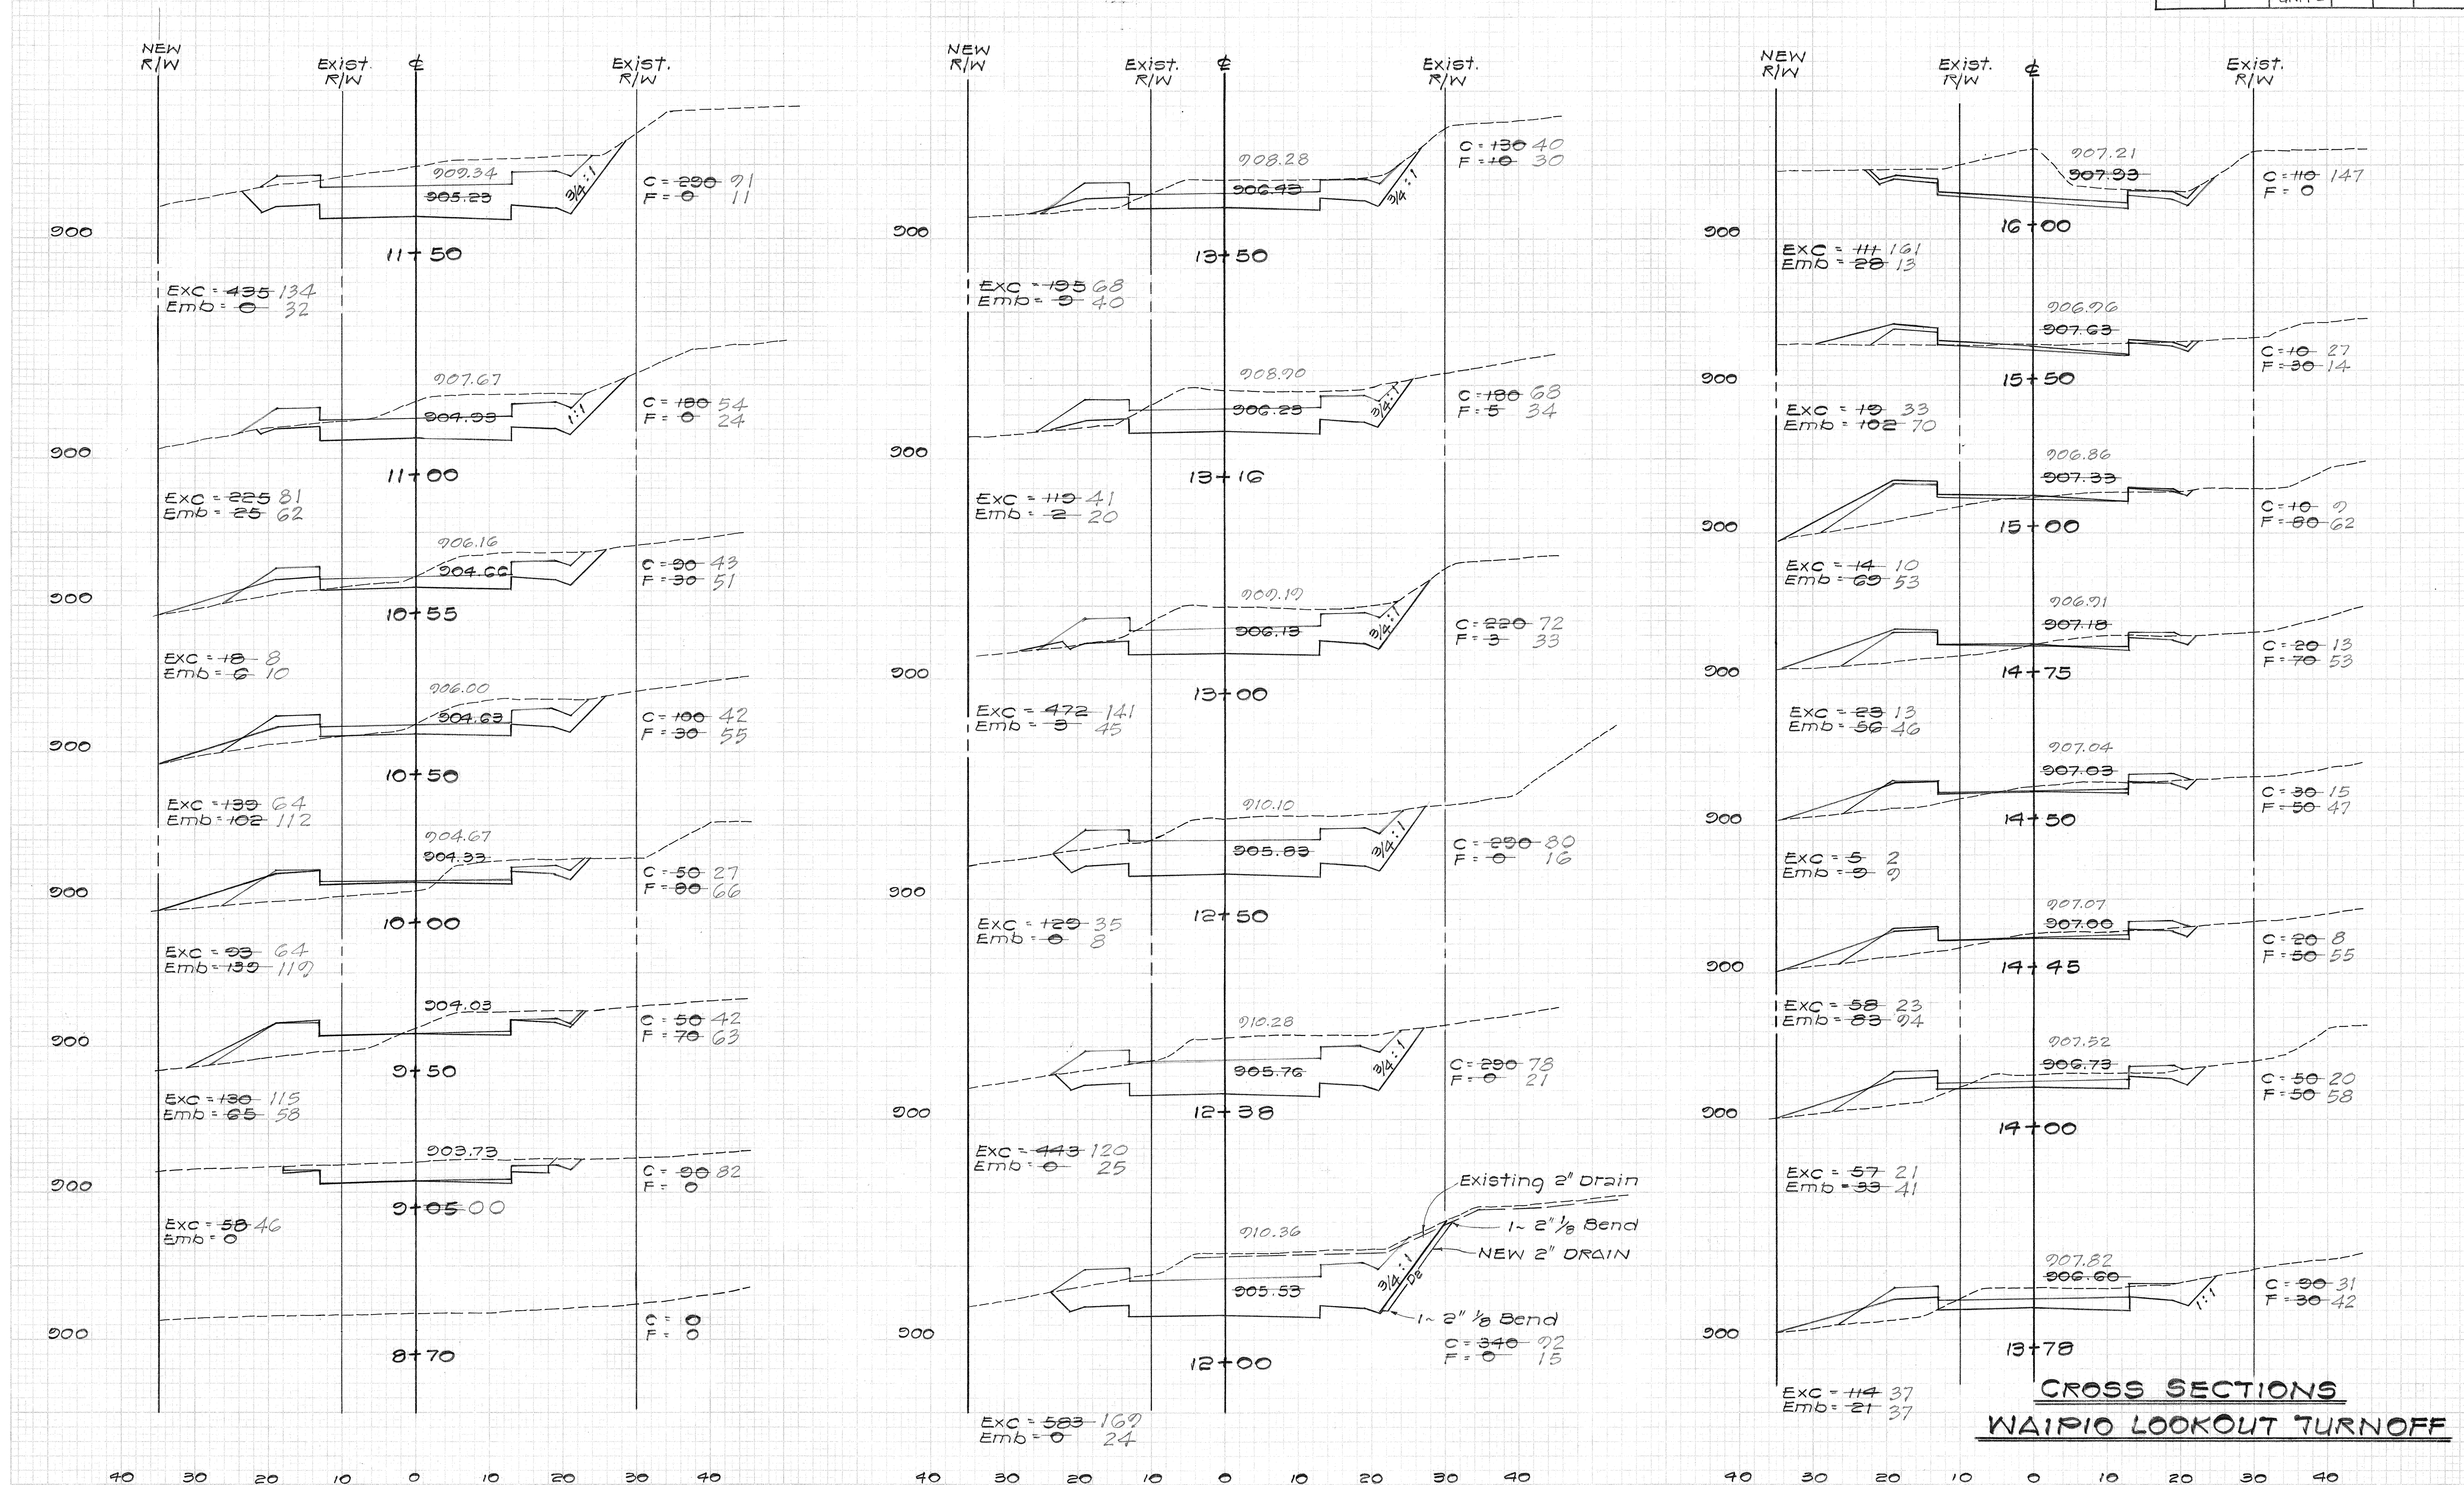

FED. ROAD DIST. NO.	STATE	PROJ. NO.	FISCAL YEAR	SHEET NO.	TOTAL SHEETS
HAWAII	HAW.	240A-01-71 UNIT 2	1978	36	63

DATE	BY	FINAL SURVEY	SURVEYED	PLOTTED	NOTE BOOK	TEAR SHEET	AREAS CHECKED	NO.

DATE	BY	ORIGINAL SURVEY	SURVEYED	PLOTTED	NOTE BOOK	TEAR SHEET	AREAS CHECKED	NO.

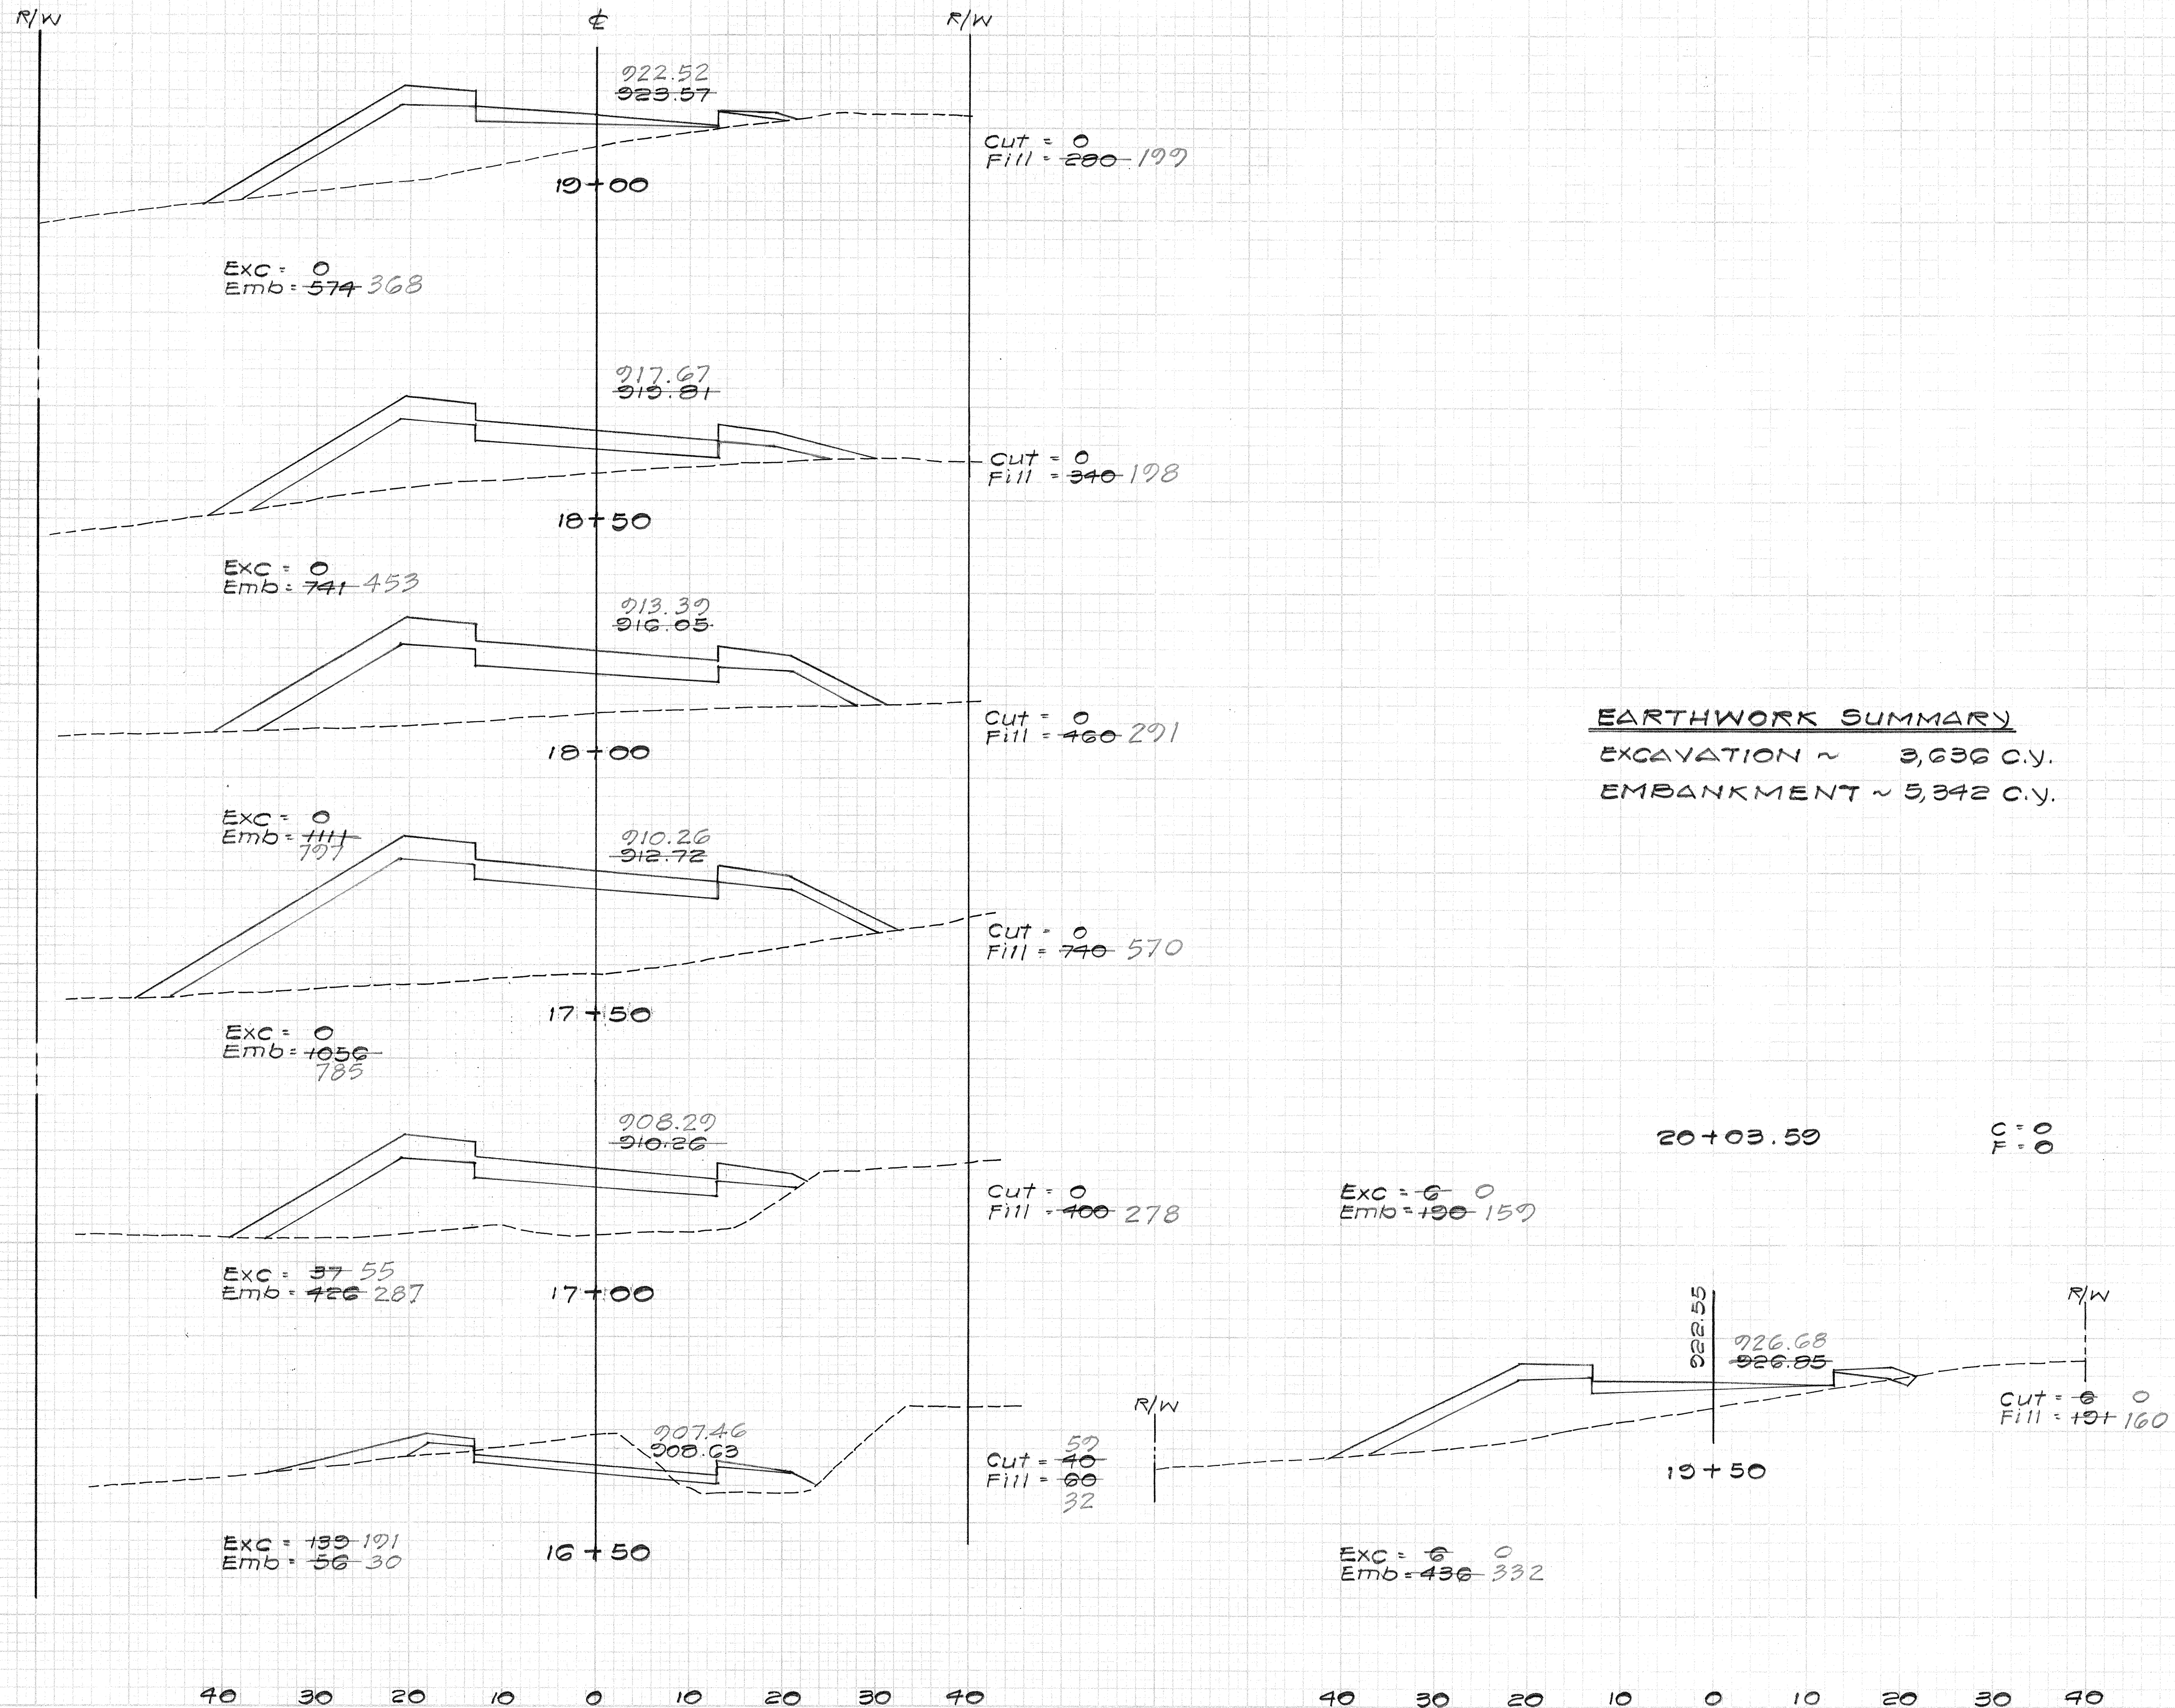


**CROSS SECTIONS
 WAIPIO LOOKOUT TURNOFF**

FED. ROAD DIST. NO.	STATE	PROJ. NO.	FISCAL YEAR	SHEET NO.	TOTAL SHEETS
HAWAII	HAW.	200A-0171 UNIT 2	1978	37	63

DATE	BY	NO.
FINAL SURVEY	PLOTTED	TEMPLATE
NOTE BOOK		AREAS CHECKED
NO.		

DATE	BY	NO.
ORIGINAL SURVEY	PLOTTED	TEMPLATE
NOTE BOOK		AREAS CHECKED
NO.		

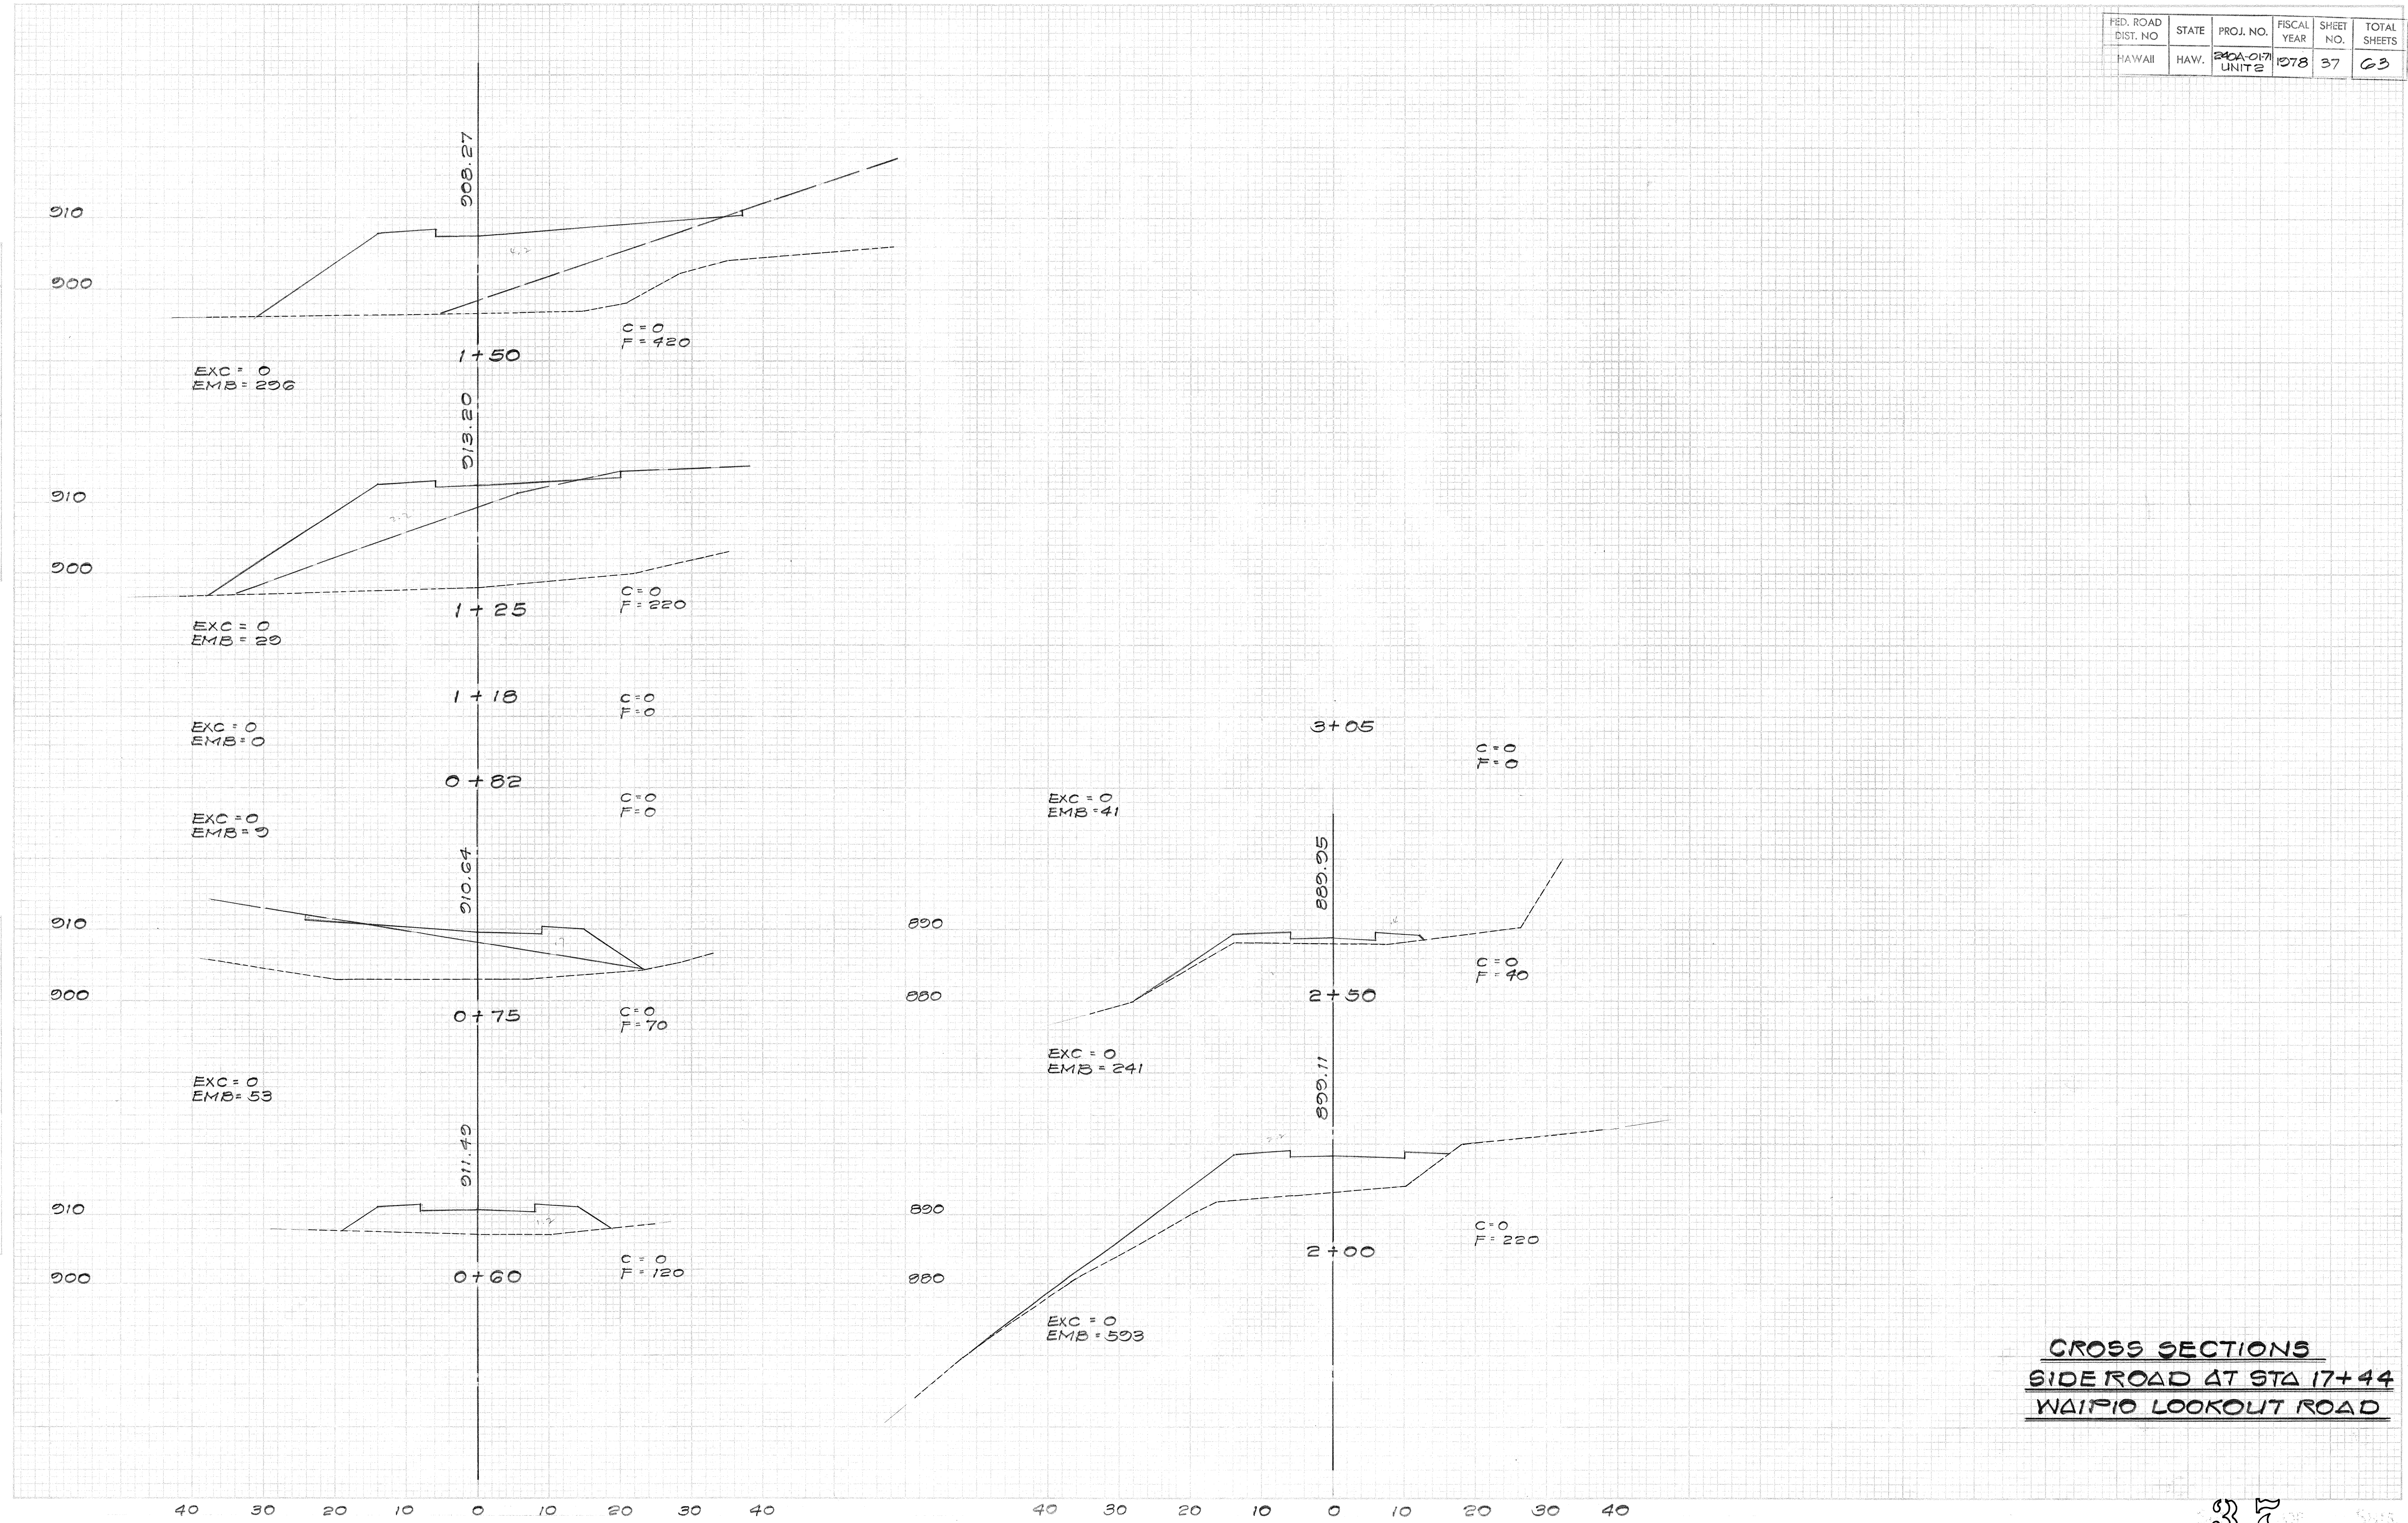

INTK @ 17+45 WAIPIO LOOKOUT