

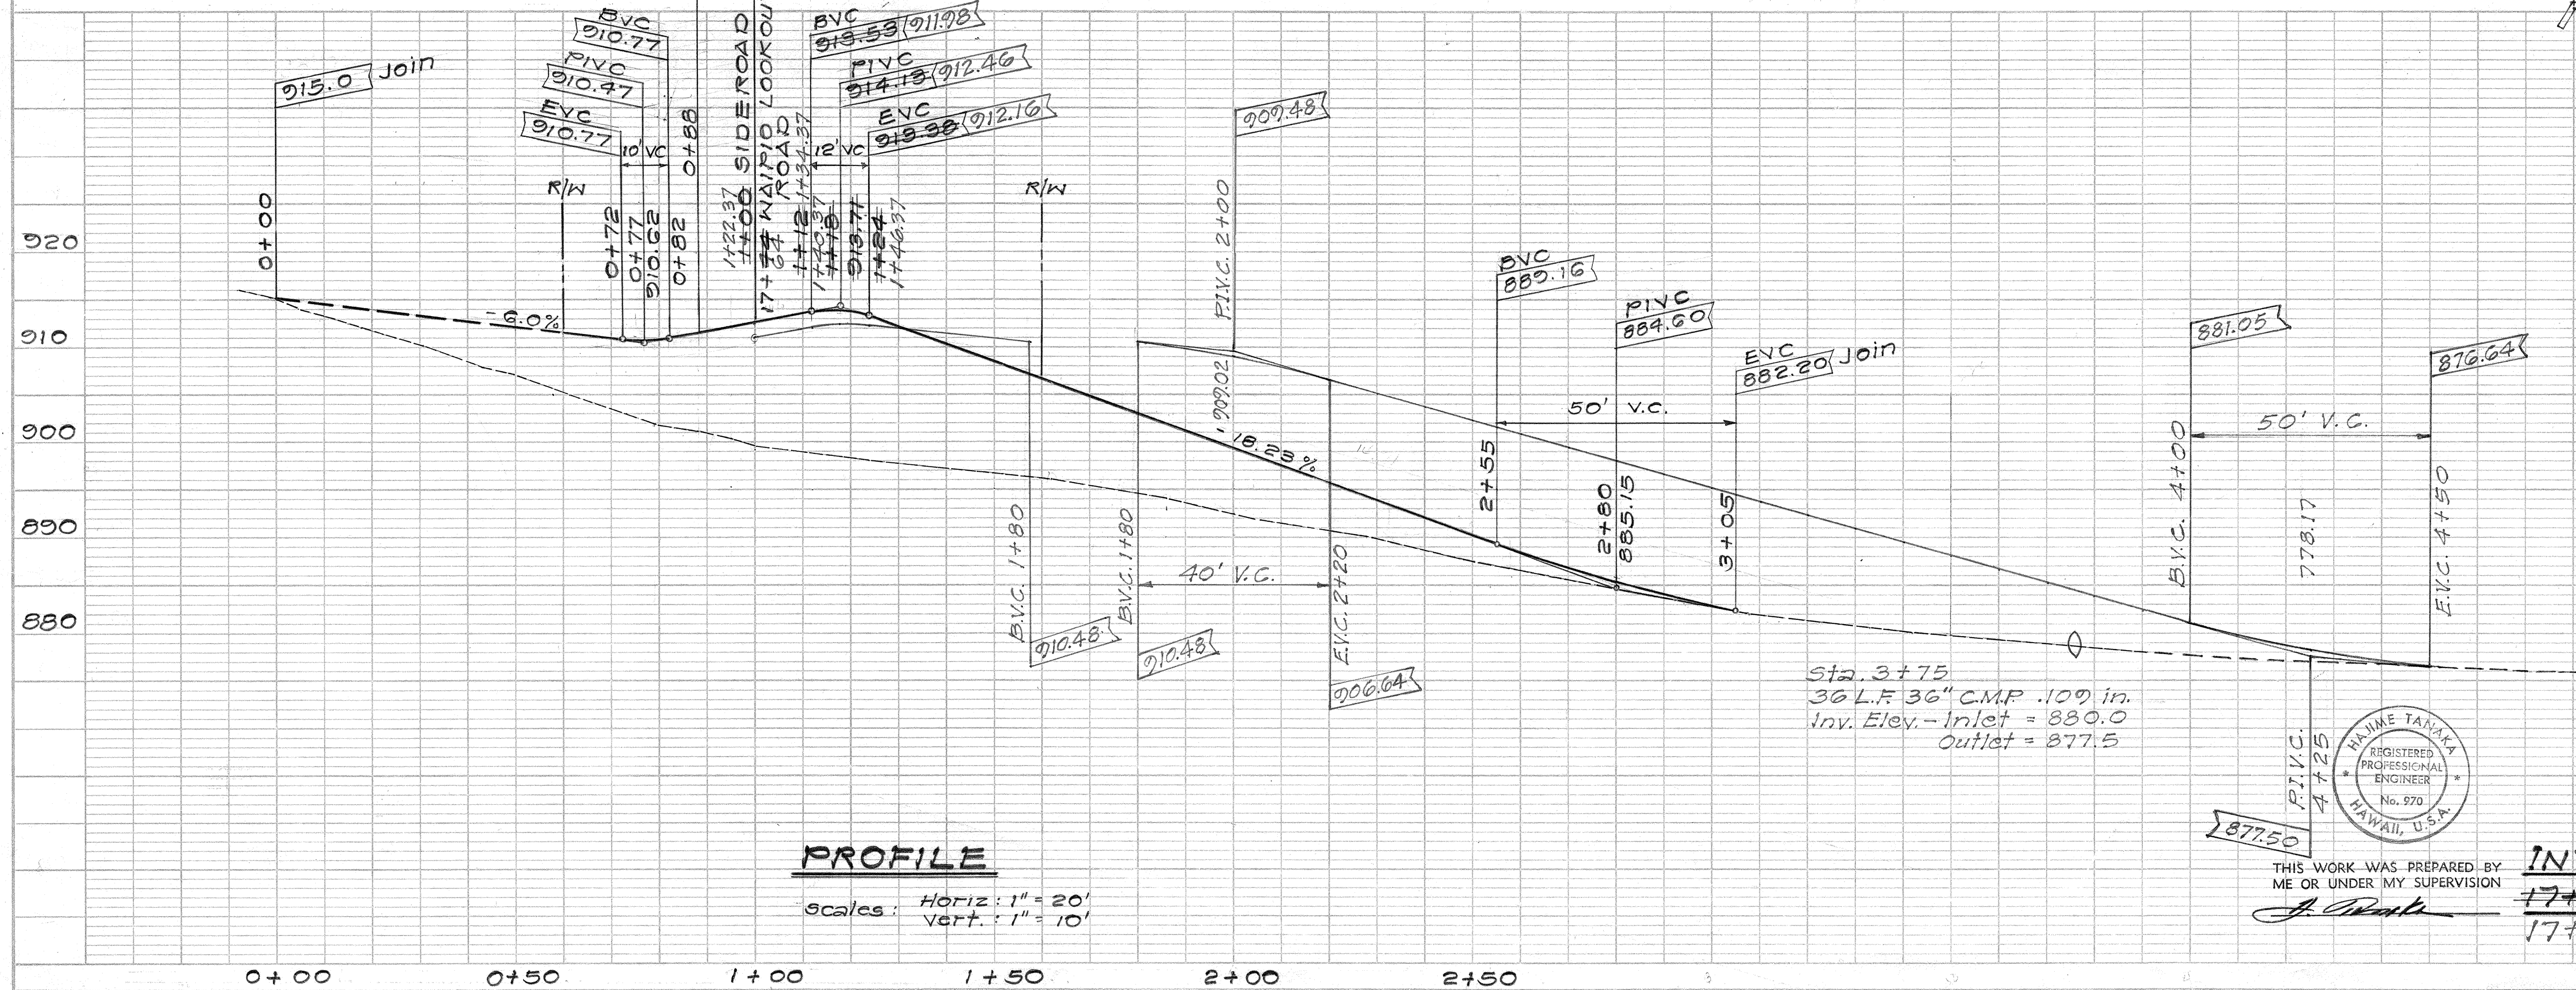


PROJECT NO.	STATE	PROJ. NO.	FISCAL YEAR	SHEET NO.	TOTAL SHEETS
240A-01-71	HAW.	UNIT 2	1978	6	63

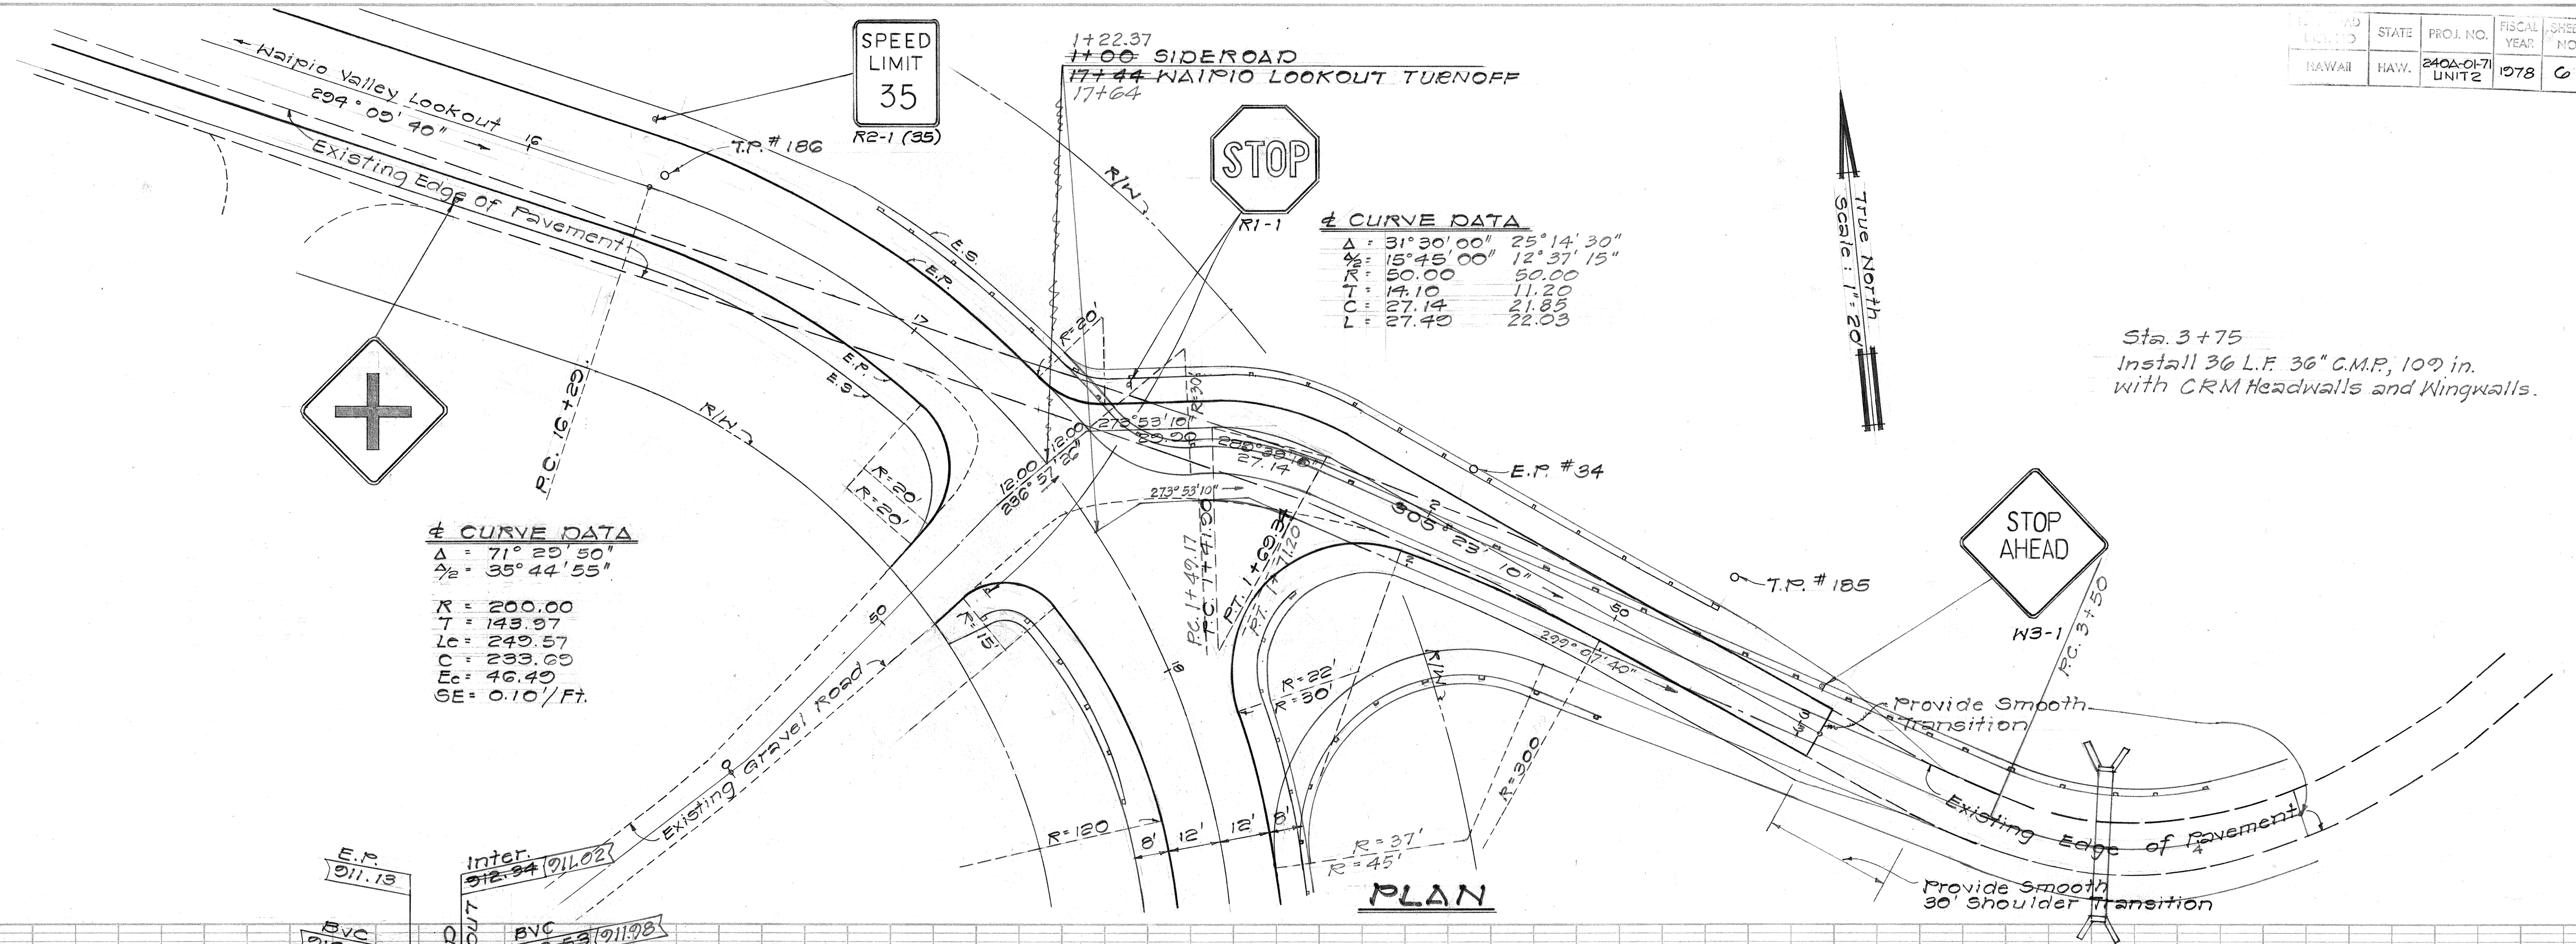

INTERSECTION DETAILS AT STA. 17+44 WAIPIO LOOKOUT ROAD 17+64

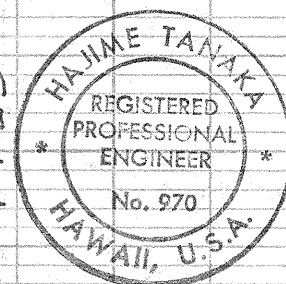

THIS WORK WAS PREPARED BY ME OR UNDER MY SUPERVISION