


FED. ROAD DIST. NO.	STATE	PROJ. NO.	FISCAL YEAR	SHEET NO.	TOTAL SHEETS
HAWAII	HAW.	240A-01-71 UNIT 2	1978	26	63

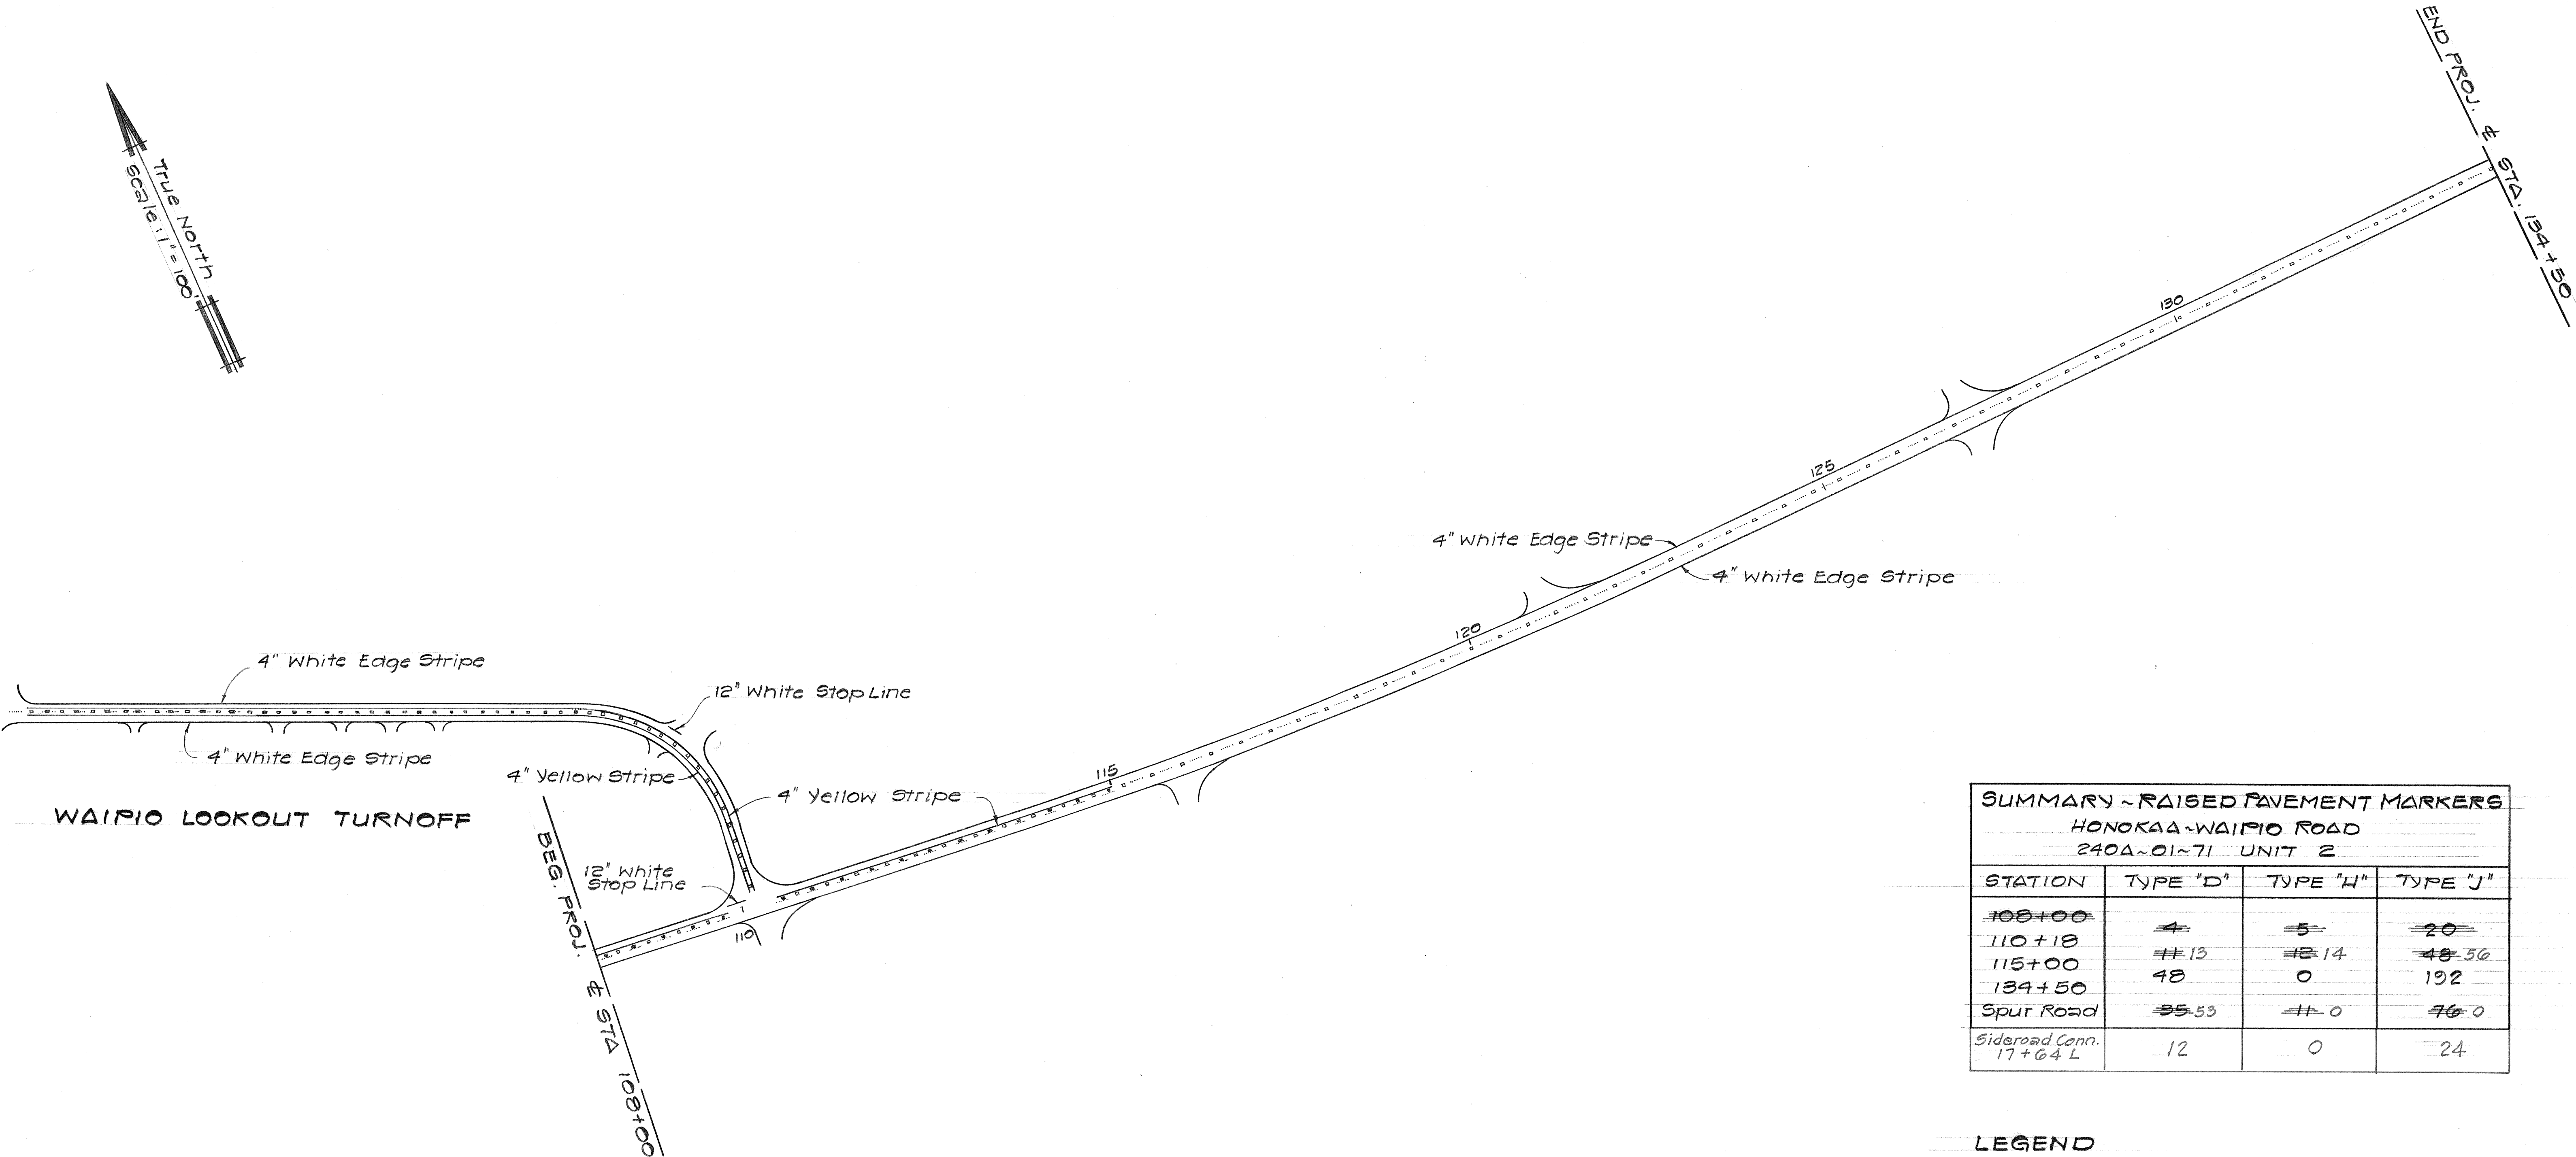


SUMMARY - RAISED PAVEMENT MARKERS HONOKAA-WAIPIO ROAD 240A-01-71 UNIT 2			
STATION	TYPE "D"	TYPE "H"	TYPE "J"
108+00	4	5	20
110+18	## 13	## 14	48 56
115+00	48	0	192
134+50			
Spur Road	35 53	## 0	76 0
Sideroad Conn. 17+64 L	12	0	24

LEGEND

- TYPE "D"
- TYPE "H"
- TYPE "J" (4 Ea. Per Line)

NOTE

Pavement striping to be done by the State Forces

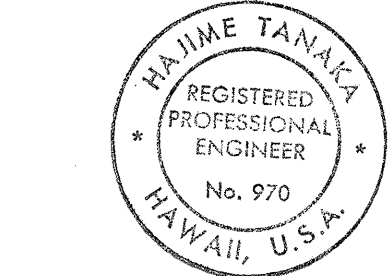

THIS WORK WAS PREPARED BY ME OR UNDER MY SUPERVISION

STATE OF HAWAII
DEPARTMENT OF TRANSPORTATION
LAND TRANSPORTATION FACILITIES DIVISION

RAISED PAVEMENT MARKERS AND STRIPING PLAN

HONOKAA-WAIPIO RD. PROJ. NO. 240A-01-71
UNIT 2

SHEET No. 1 OF 1 SHEETS

DATE	_____
SURVEY PLOTTED BY	_____
DRAWN BY	_____
CHECKED BY	_____
DESIGNED BY	_____
QUANTITIES BY	_____
CHECKED BY	_____
ORIGINAL PLAN	_____
NOTE BOOK	_____
No.	_____