

FED. ROAD DIST. NO.	STATE	PROJ. NO.	FISCAL YEAR	SHEET NO.	TOTAL SHEETS
HAWAII	HAW.	240A-01-22M	1992	24	31

SIGN SCHEDULE					
STATION TO STATION	TYPE	10 SQ. FT. OR LESS		105 SQ. FT. OR MORE	
		W/POST	W/O POST	W/POST	W/O POST
48+76.49 ~ 49+99.36	R1-1-A	2			
	R1-2	1			
	R4-7-a (36"x48")			1	
	R5-1-a (36"x36")		2		
	"LEFT TURN HERE (36"x48")			1	

Note: Milepost marker "0" shown on intersection plan is reflected in Milepost Marker Schedule on Sheet No. 31.

PAVEMENT MARKER SCHEDULE					
STATION		TYPE			
FROM	TO	CL	DL	HL	J
48+76.49	49+99.36	29	10	10	24

PAVEMENT MARKING SUMMARY	
DESCRIPTION	QUANTITY
TAPE-TYPE I OR THERMOPLASTIC EXTRUSION	
4-Inch Pavement Stripe (Yellow)	185 L.F.
12-Inch Pavement Stripe (Yellow)	25 L.F.
Double 4-Inch Pavement Stripe (Yellow)	160 L.F.
Pavement Arrow	1 Each
Pavement Word	3 Each
TAPE TYPE II OR THERMOPLASTIC EXTRUSION	
4-Inch Pavement Stripe (White)	430 L.F.
8-Inch Pavement Stripe (White)	125 L.F.
12-Inch Pavement Stripe (White)	60 L.F.
THERMOPLASTIC EXTRUSION	
4-Inch Pavement Stripe (White)	25 L.F.
12-Inch Pavement Stripe (White)	50 L.F.

REFLECTOR MARKER SCHEDULE	
STATION	RM-4 w/o Post
49+75 o/s 39' Rt.	1

NOTE: THIS SHEET HAS BEEN DELETED FROM THE CONTRACT PLANS.

STATE OF HAWAII

DEPARTMENT OF TRANSPORTATION

HIGHWAYS DIVISION

ROAD WIDENING TYPICAL SECTION

CROSS SECTIONS & SCHEDULES


HONOKAA-WAIPIO ROAD

PROJECT NO. 240A-01-22M


HAMAKUA, HAWAII

Scale: As Noted Date: April 1992

SHEET NO. 2 OF 2 SHEETS

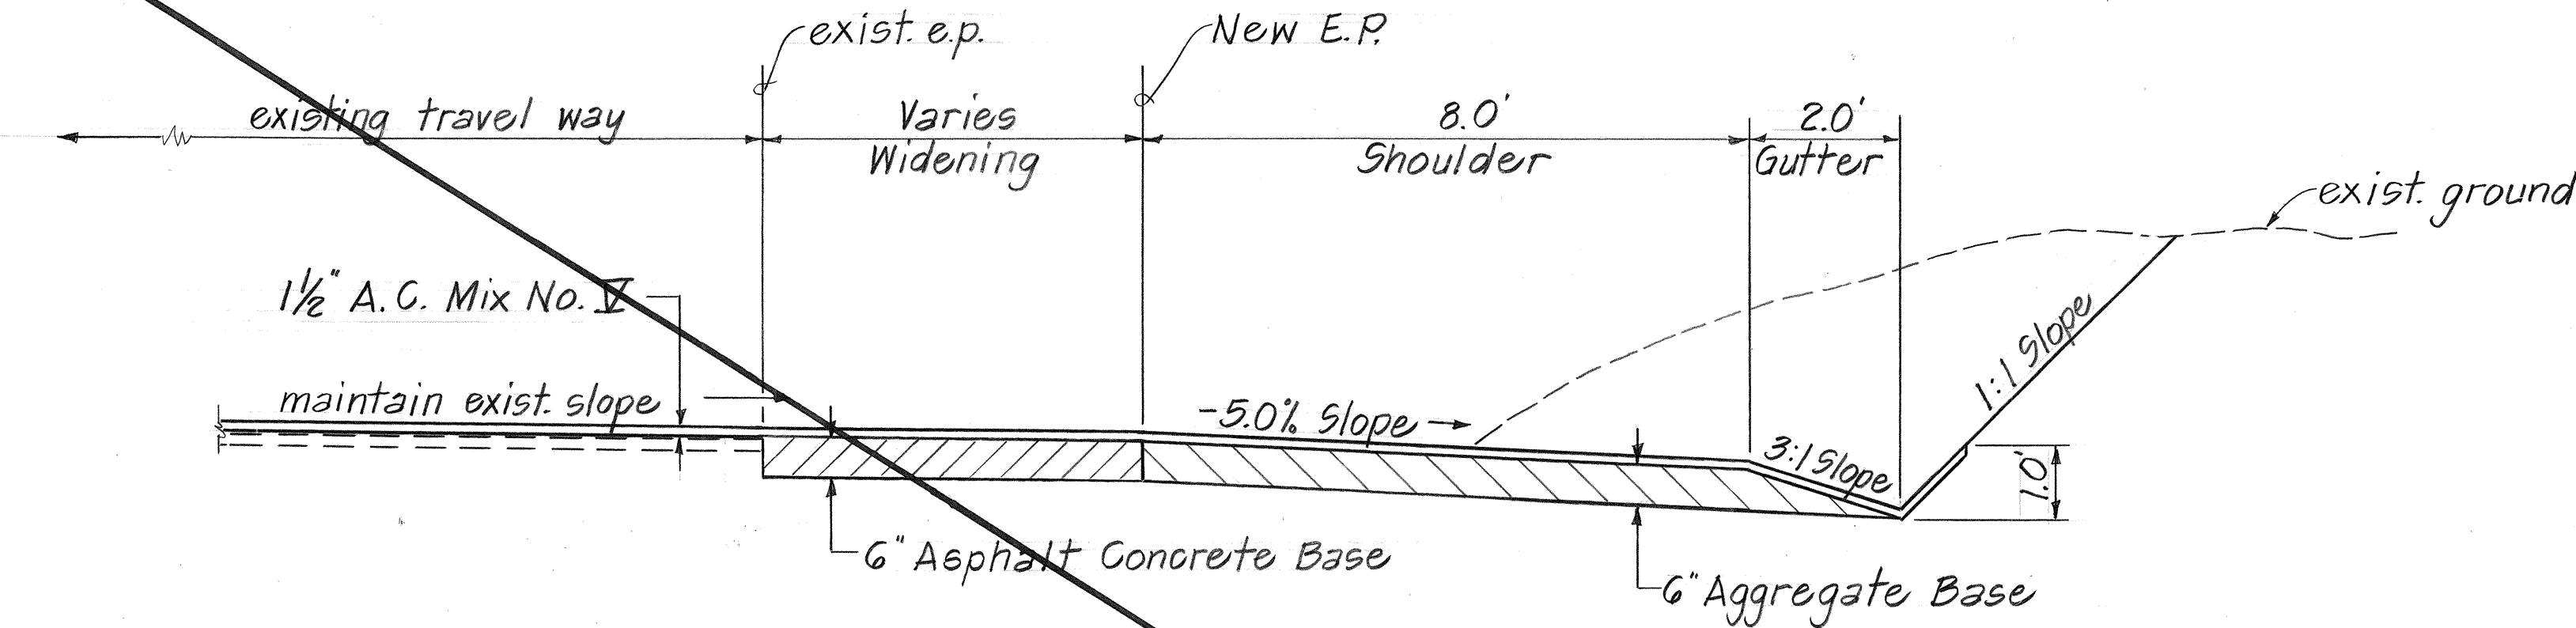

TYPICAL ROAD WIDENING SECTION
Scale: 1/2" = 1'-0"

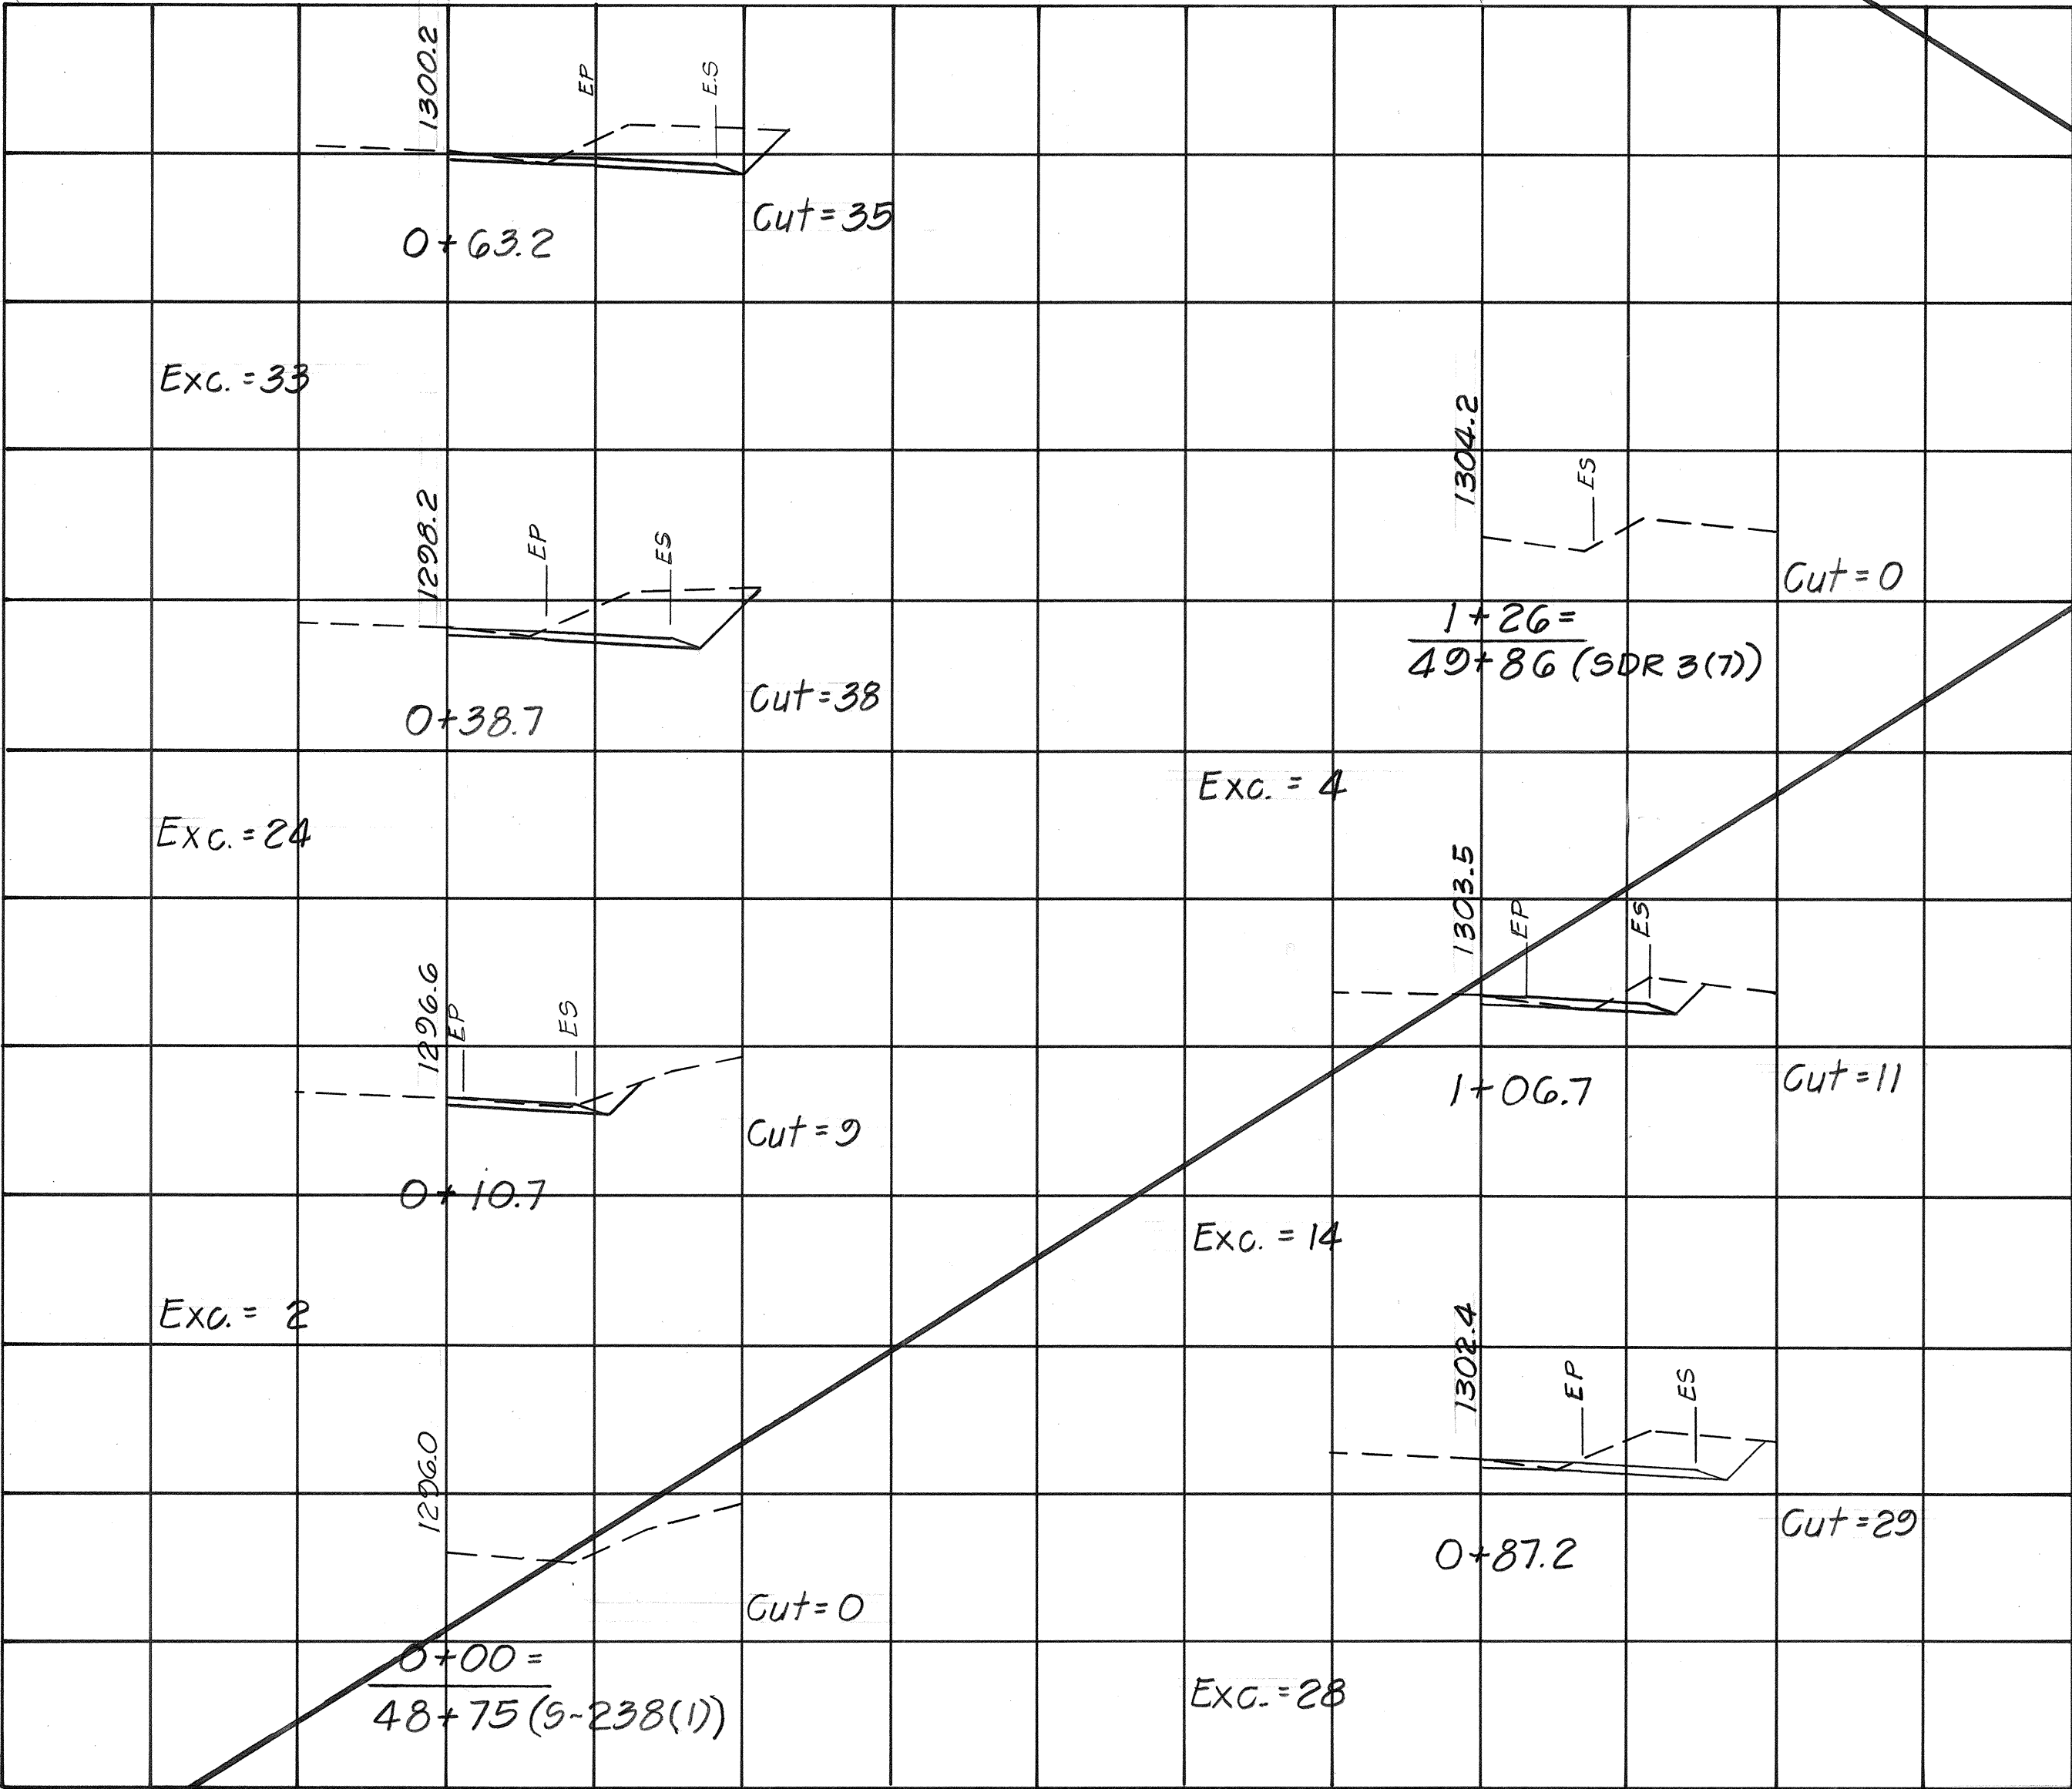

ROAD WIDENING CROSS SECTIONS
Scale: Hor: 1" = 10'
Ver: 1" = 10'

ORIGINAL PLAN	DATE
DESIGNED BY	
TRACED BY	
NOTE BOOK	
QUANTITIES BY	
CHECKED BY	
NO.	