

FED. ROAD DIST. NO.	STATE	PROJ. NO.	FISCAL YEAR	SHEET NO.	TOTAL SHEETS
HAWAII	HAW.	240A-01-22M	1992	23	31

ESTIMATED QUANTITIES

Roadway Excavation	105 C.Y.
Aggregate Base	15 C.Y.
Asphalt Concrete Base	23 Tons
Asphalt Concrete, Mix No. V	80 Tons


Curve Data

$\Delta = 126^{\circ}27'00''$
$R = 62.00'$
$T = 122.87'$
$L = 136.83'$

Curve Data

$\Delta = 53^{\circ}33'00''$
$D = 28.6479'$
$R = 200.00'$
$T = 100.92'$
$L_c = 186.92'$
$C = 180.20'$

DATE	_____
SURVEY PLOTTED BY	_____
PLAN	_____
DRAWN BY	_____
DESIGNED BY	_____
QUANTITIES BY	_____
CHECKED BY	_____
NO.	1376

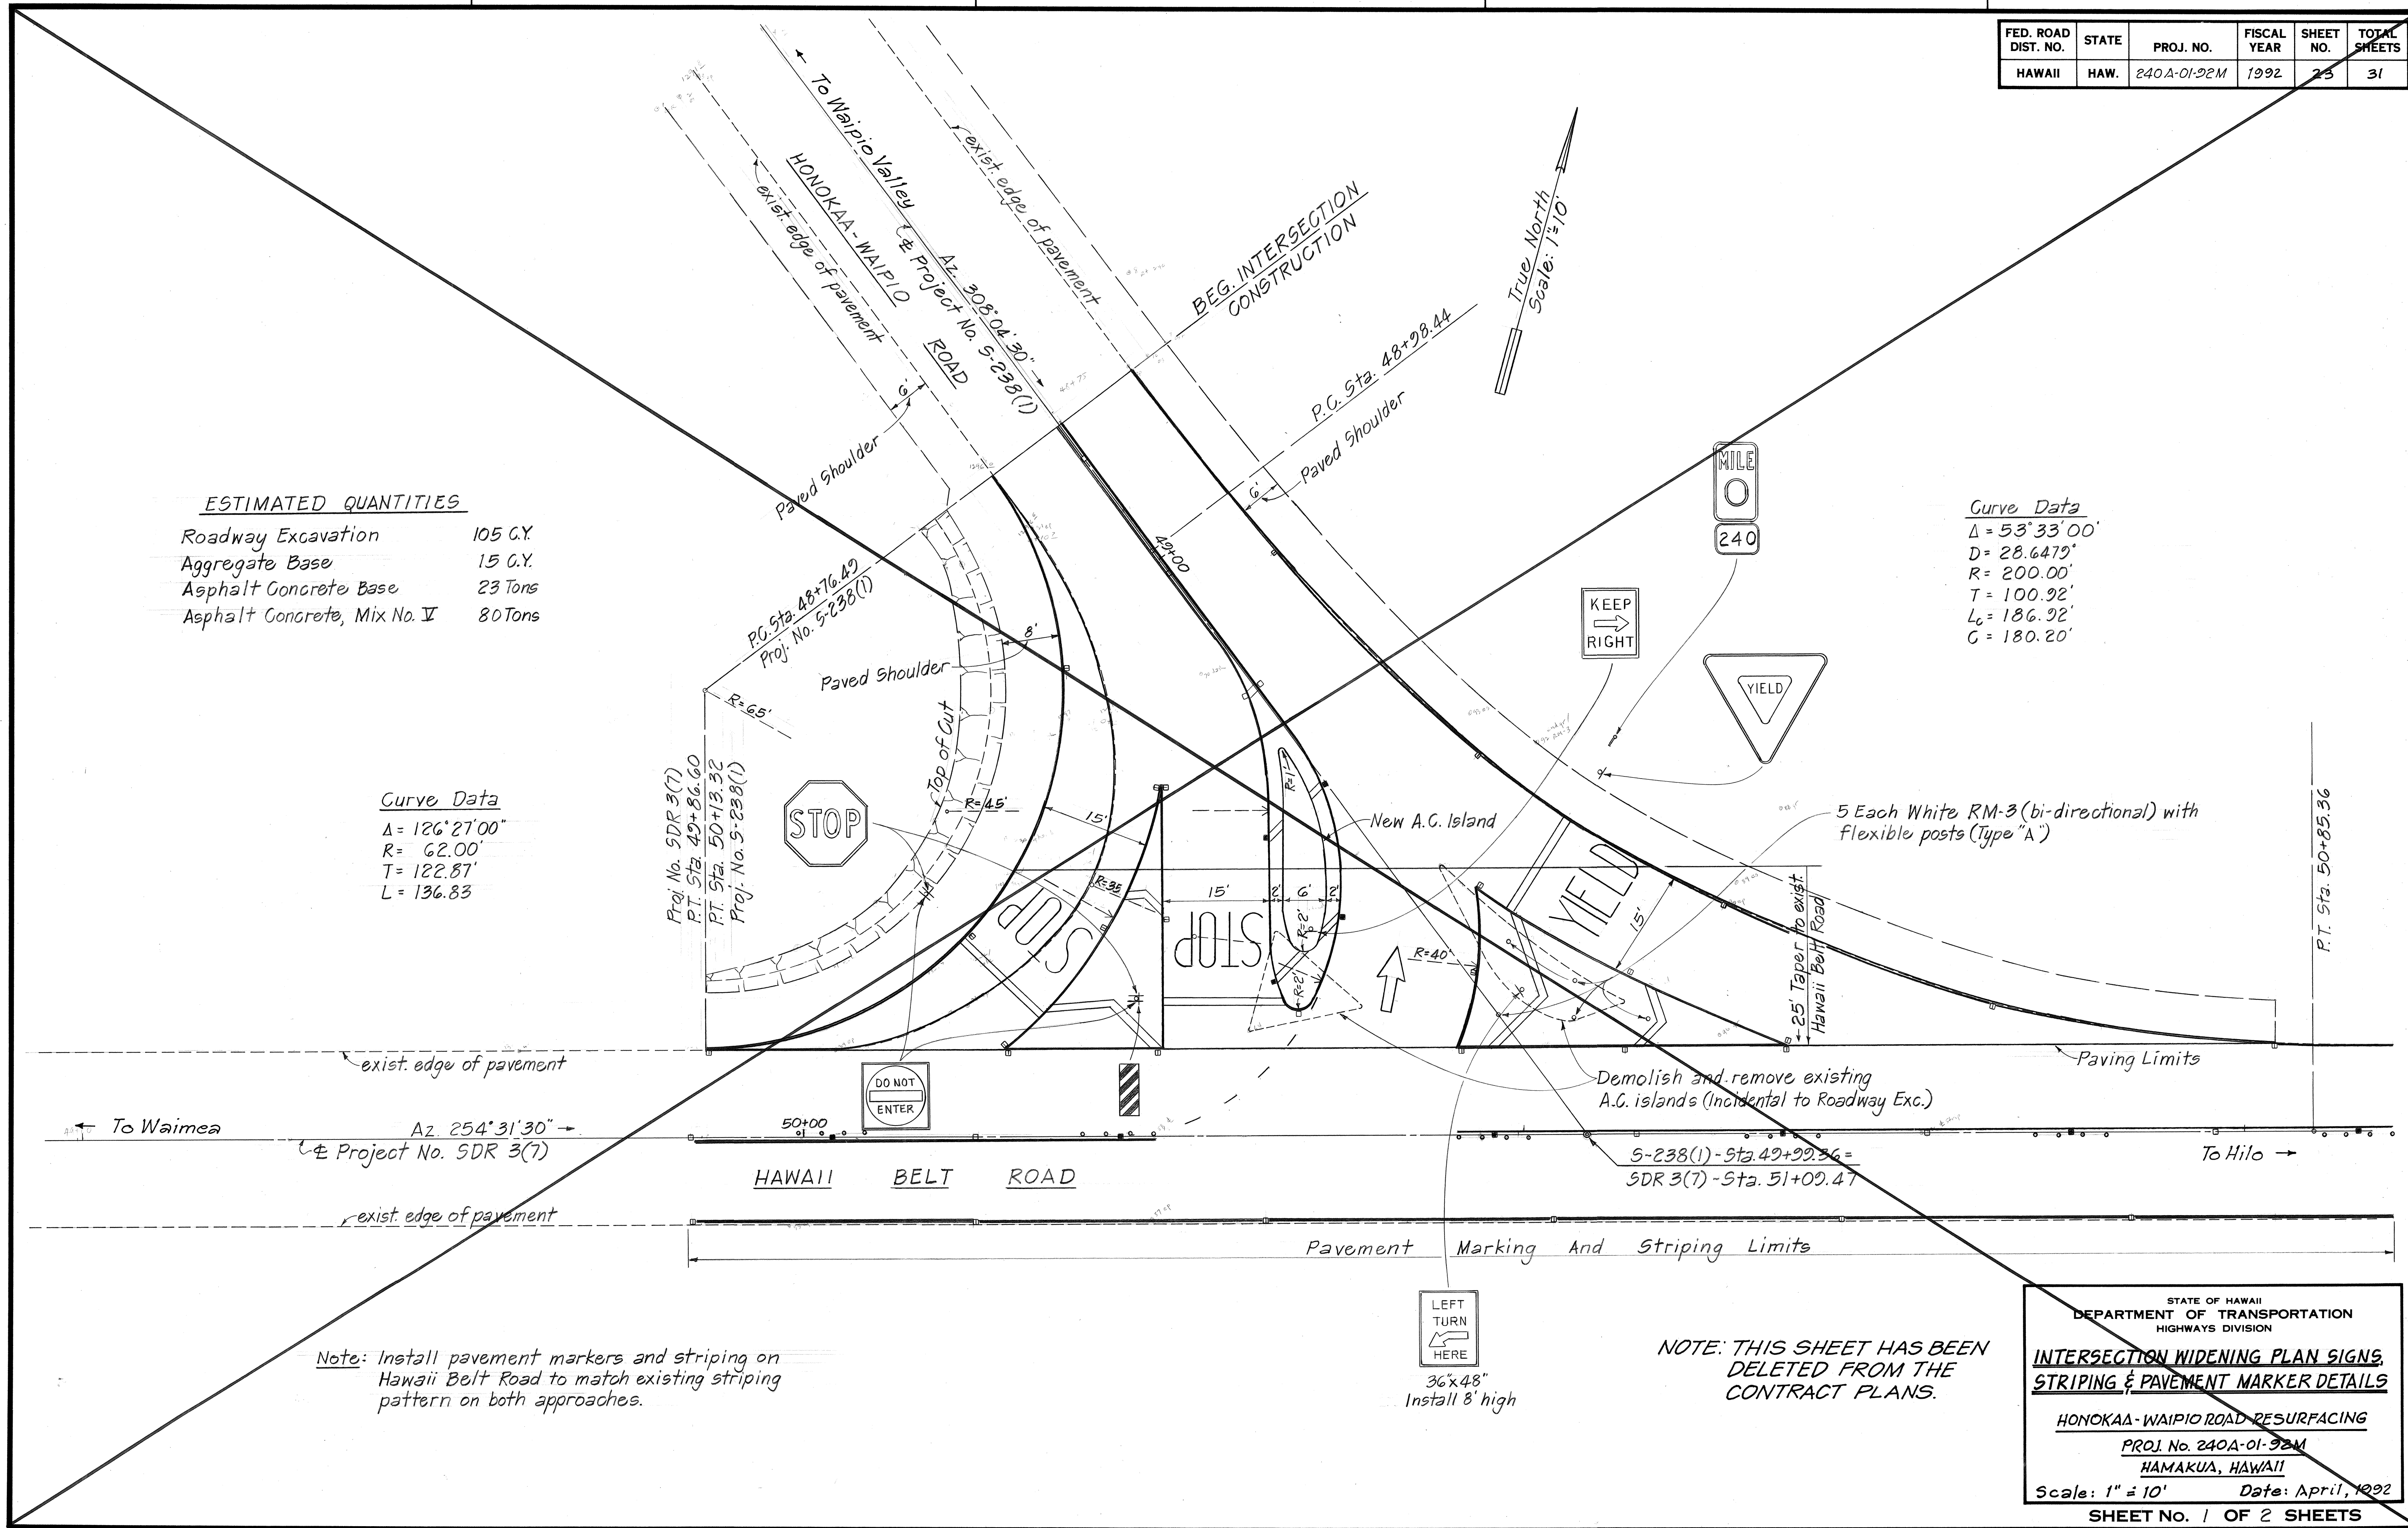

Note: Install pavement markers and striping on Hawaii Belt Road to match existing striping pattern on both approaches.

NOTE: THIS SHEET HAS BEEN DELETED FROM THE CONTRACT PLANS.

STATE OF HAWAII
DEPARTMENT OF TRANSPORTATION
HIGHWAYS DIVISION

**INTERSECTION WIDENING PLAN SIGNS
STRIPING & PAVEMENT MARKER DETAILS**

HONOKAA-WAIPIO ROAD RESURFACING

PROJ. No. 240A-01-22M

HAMAKUA, HAWAII

Scale: 1" = 10' Date: April, 1992

SHEET NO. 1 OF 2 SHEETS