


INDEX TO DRAWINGS	
SHEET NO.	DESCRIPTION
1	TITLE SHEET
2	STANDARD PLANS SUMMARY
3-4	TYPICAL SECTIONS & DETAILS
5-22	ROADWAY & STRIPING PLAN
*23	INTERSECTION WIDENING PLAN
*24	INTERSECTION WIDENING DETAILS & SCHEDULES
25	PAVEMENT RECONSTRUCTION DETAILS & SCHEDULE
26	SURVEY MONUMENT SCHEDULE, STRIPING & SIGNING NOTES
27	E.P. MARKING & SCHEDULE
28-29	REFLECTOR MARKER SCHEDULE & DETAILS
30	SIGN SCHEDULE
31	CONSTRUCTION SIGN DETAIL & MISCELLANEOUS SCHEDULES




*PLAN SHEETS 23 AND 24 ARE DELETED FROM THE CONTRACT PLANS.
NEW TOTAL = 29

HAWAII DISTRICT
DESIGNED BY J. KASAMOTO
P. S. & E. BY
587-2250
APRIL 1992
DATE
PHONE

STATE OF HAWAII
DEPARTMENT OF TRANSPORTATION
HIGHWAYS DIVISION
"AS-BUILT"
PLANS FOR
HONOKAA - WAIPIO ROAD RESURFACING
HONOKAA TO WAIPIO
PROJECT NO. 240A-01-92M
DISTRICT OF HAMAKUA
ISLAND OF HAWAII

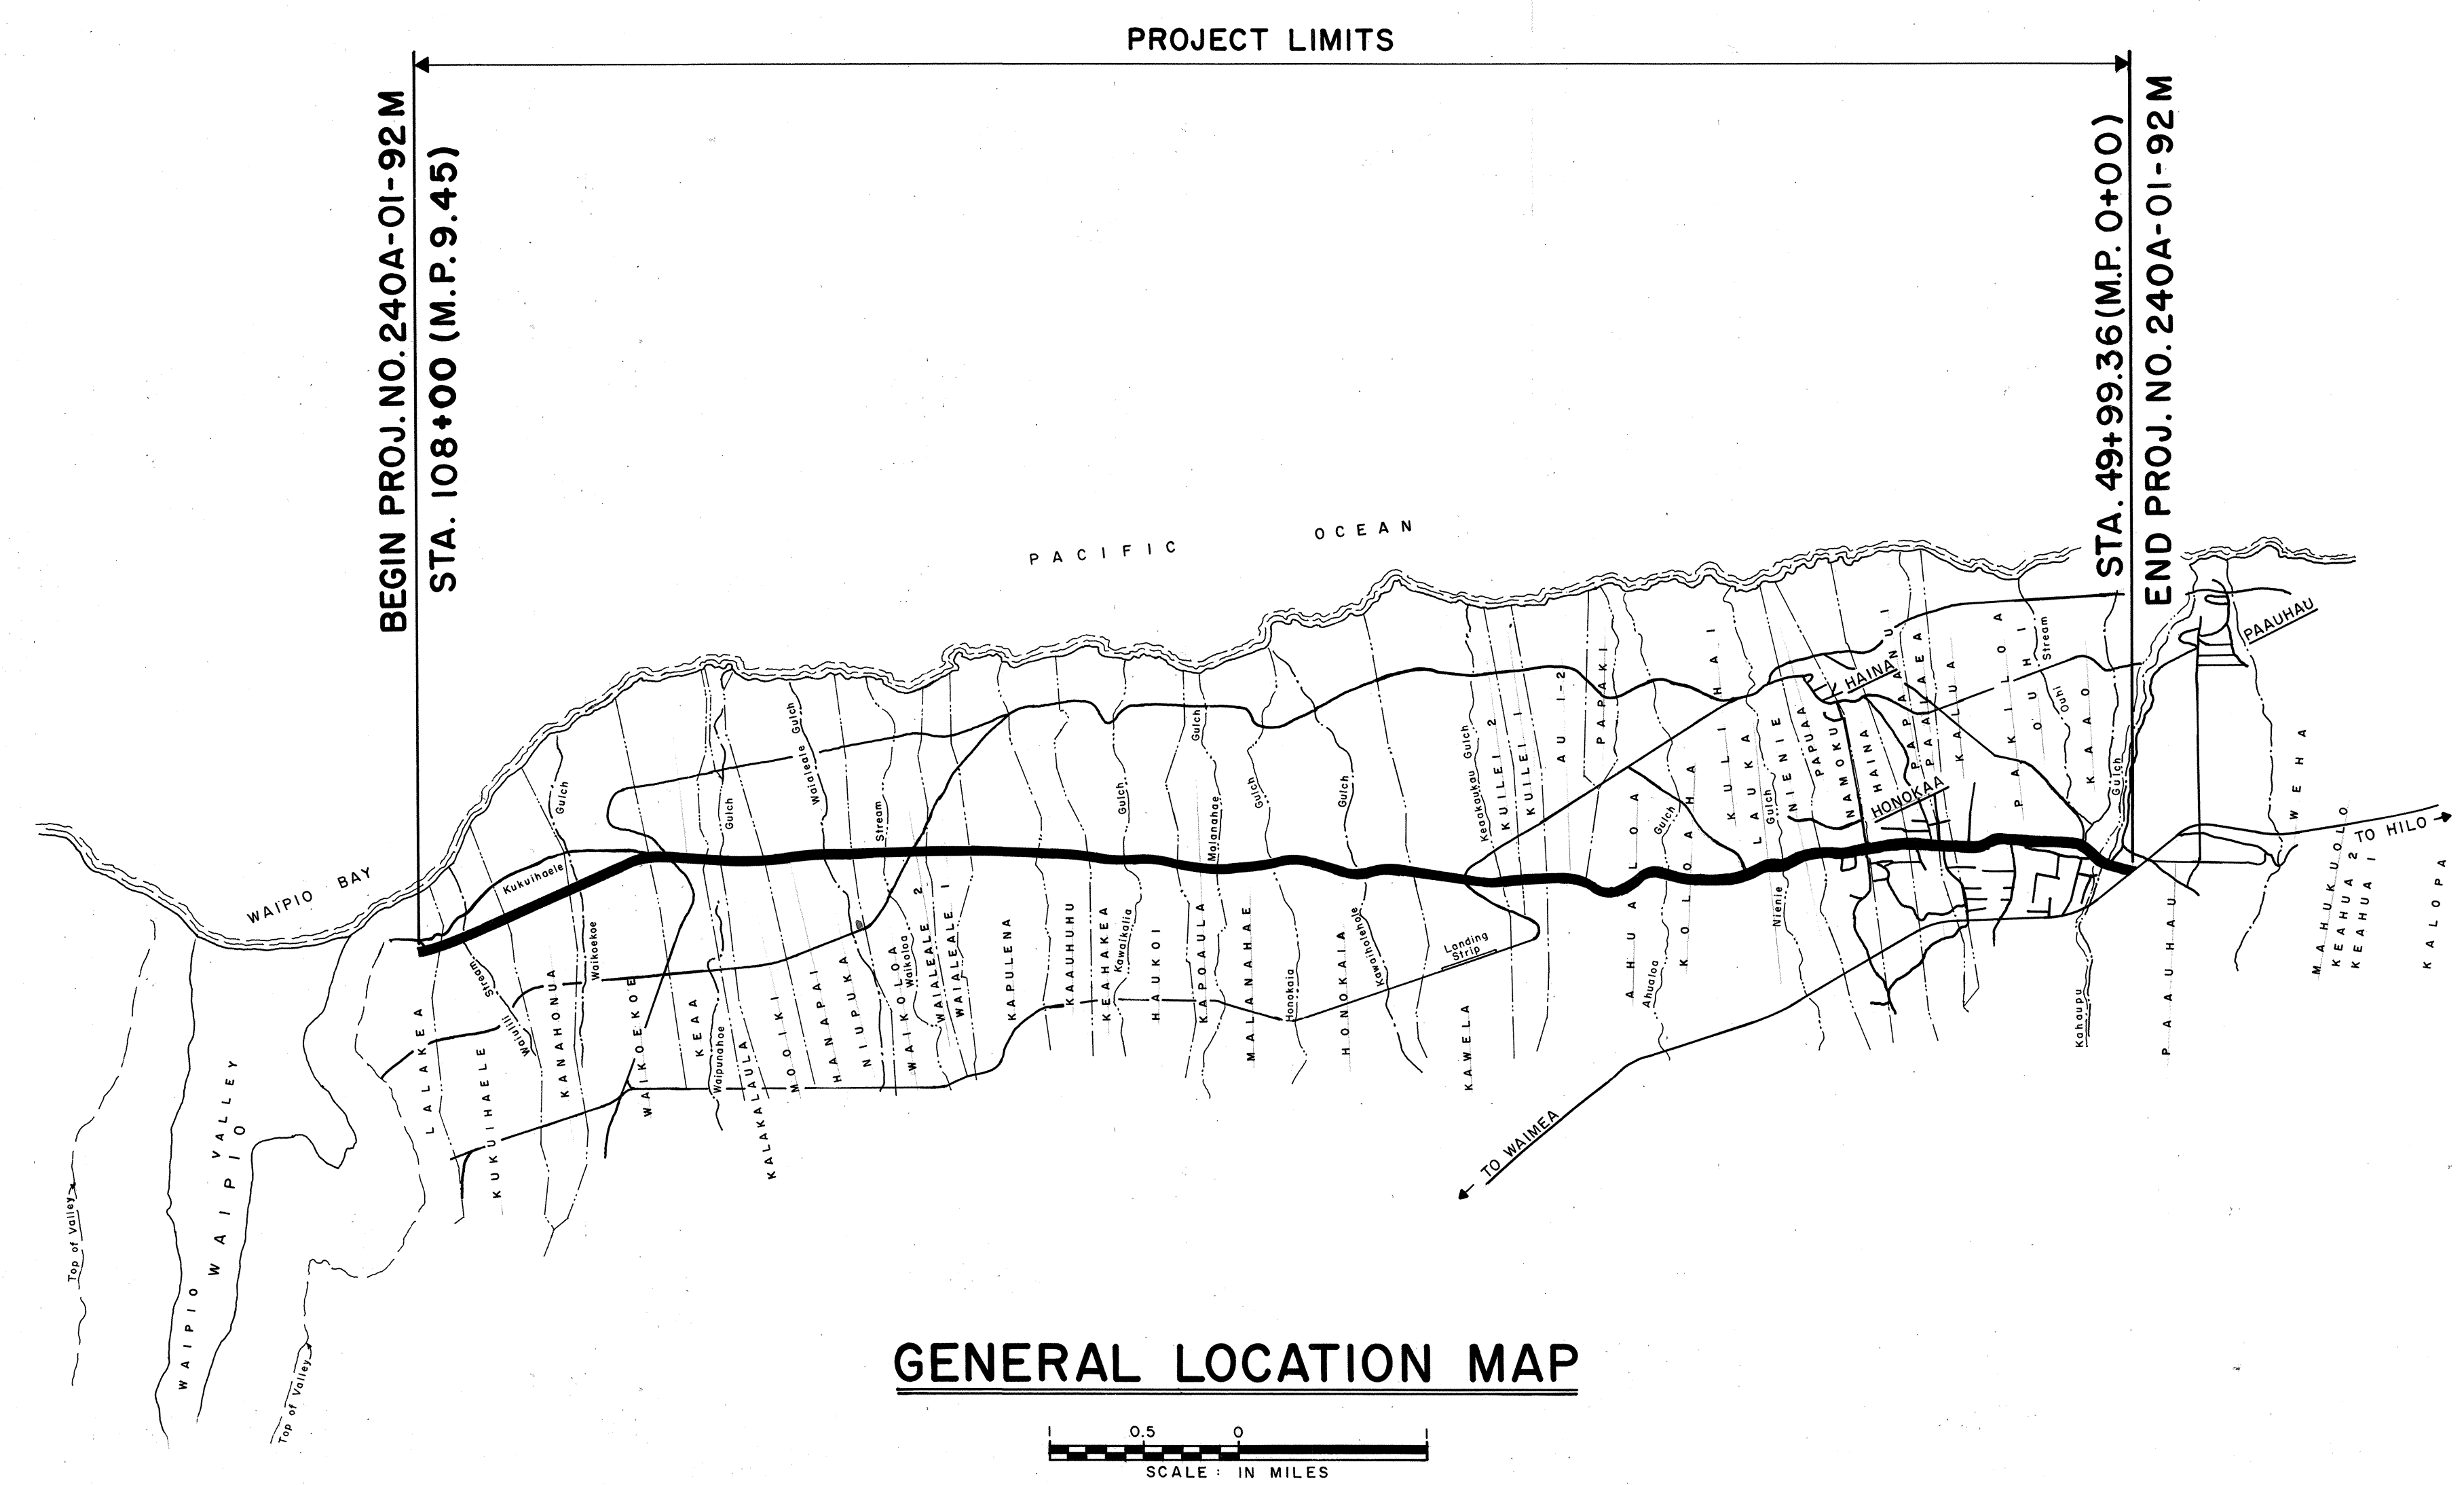

FED. ROAD DIST. NO.	STATE	PROJ. NO.	FISCAL YEAR	SHEET NO.	TOTAL SHEETS
HAWAII	HAW.	240A-01-92M	1992	1	31

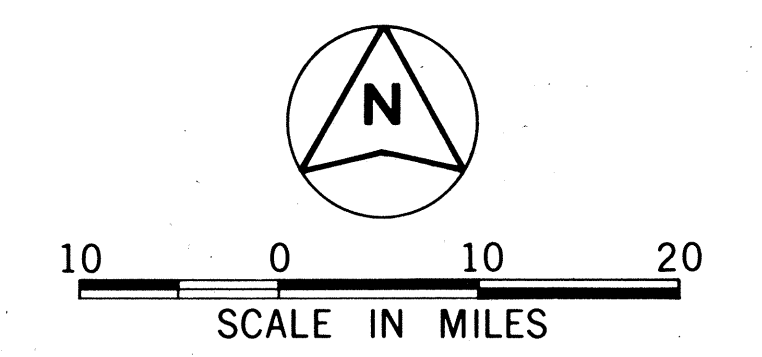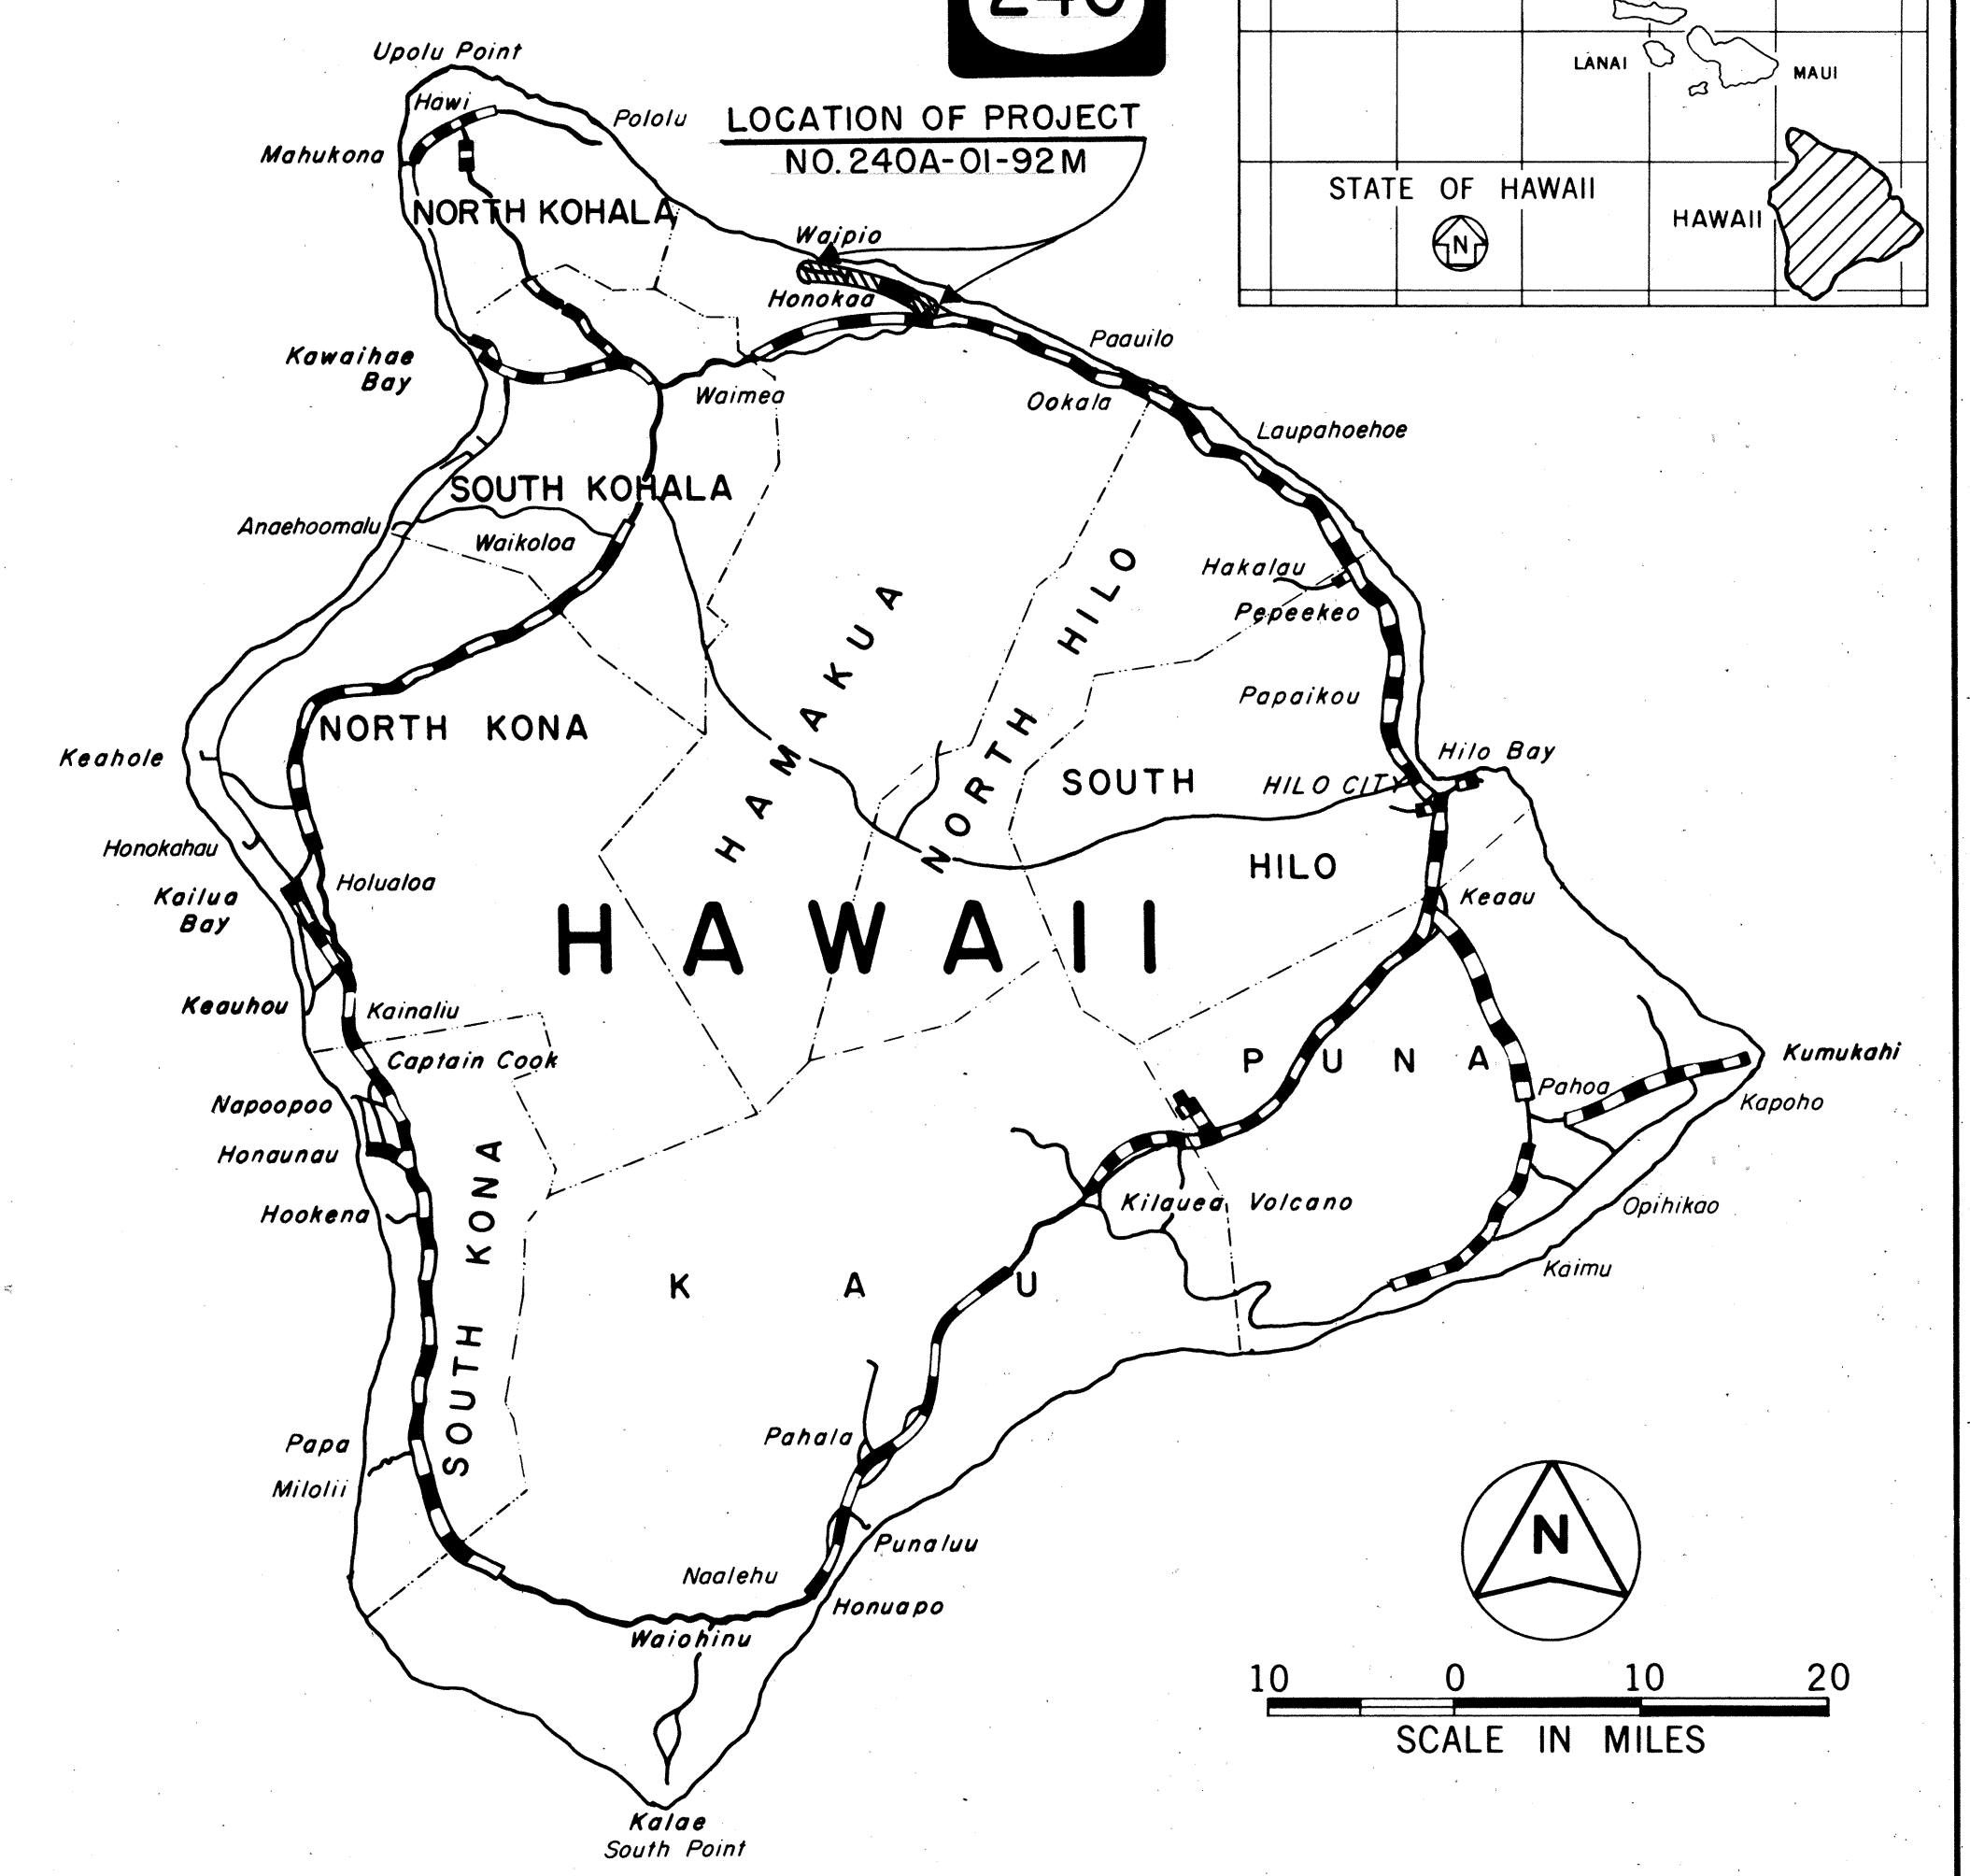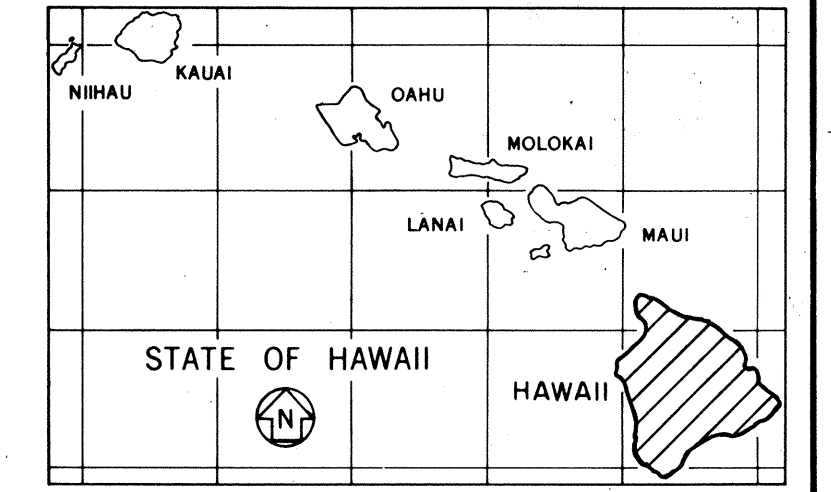

FEDERAL AID PROJECTS PREVIOUSLY CONSTRUCTED OR UNDER CONSTRUCTION
MILE POST 0.00 TO MILE POST 9.45

CHANGES MADE DURING CONSTRUCTION HAVE BEEN INCORPORATED ON THESE PLANS EXCEPT CHANGES IN THE ORIGINAL THEORETICAL QUANTITIES. FOR ACTUAL QUANTITIES, REFER TO PROJECT LEDGER AND/OR COMPUTATION BOOK.

Roy Shioji
RESIDENT ENGINEER
11/13/95
DATE

DEPARTMENT OF TRANSPORTATION
STATE OF HAWAII
APPROVED:
F. Harano
DIR. OF TRANSPORTATION
4/24/92
DATE