
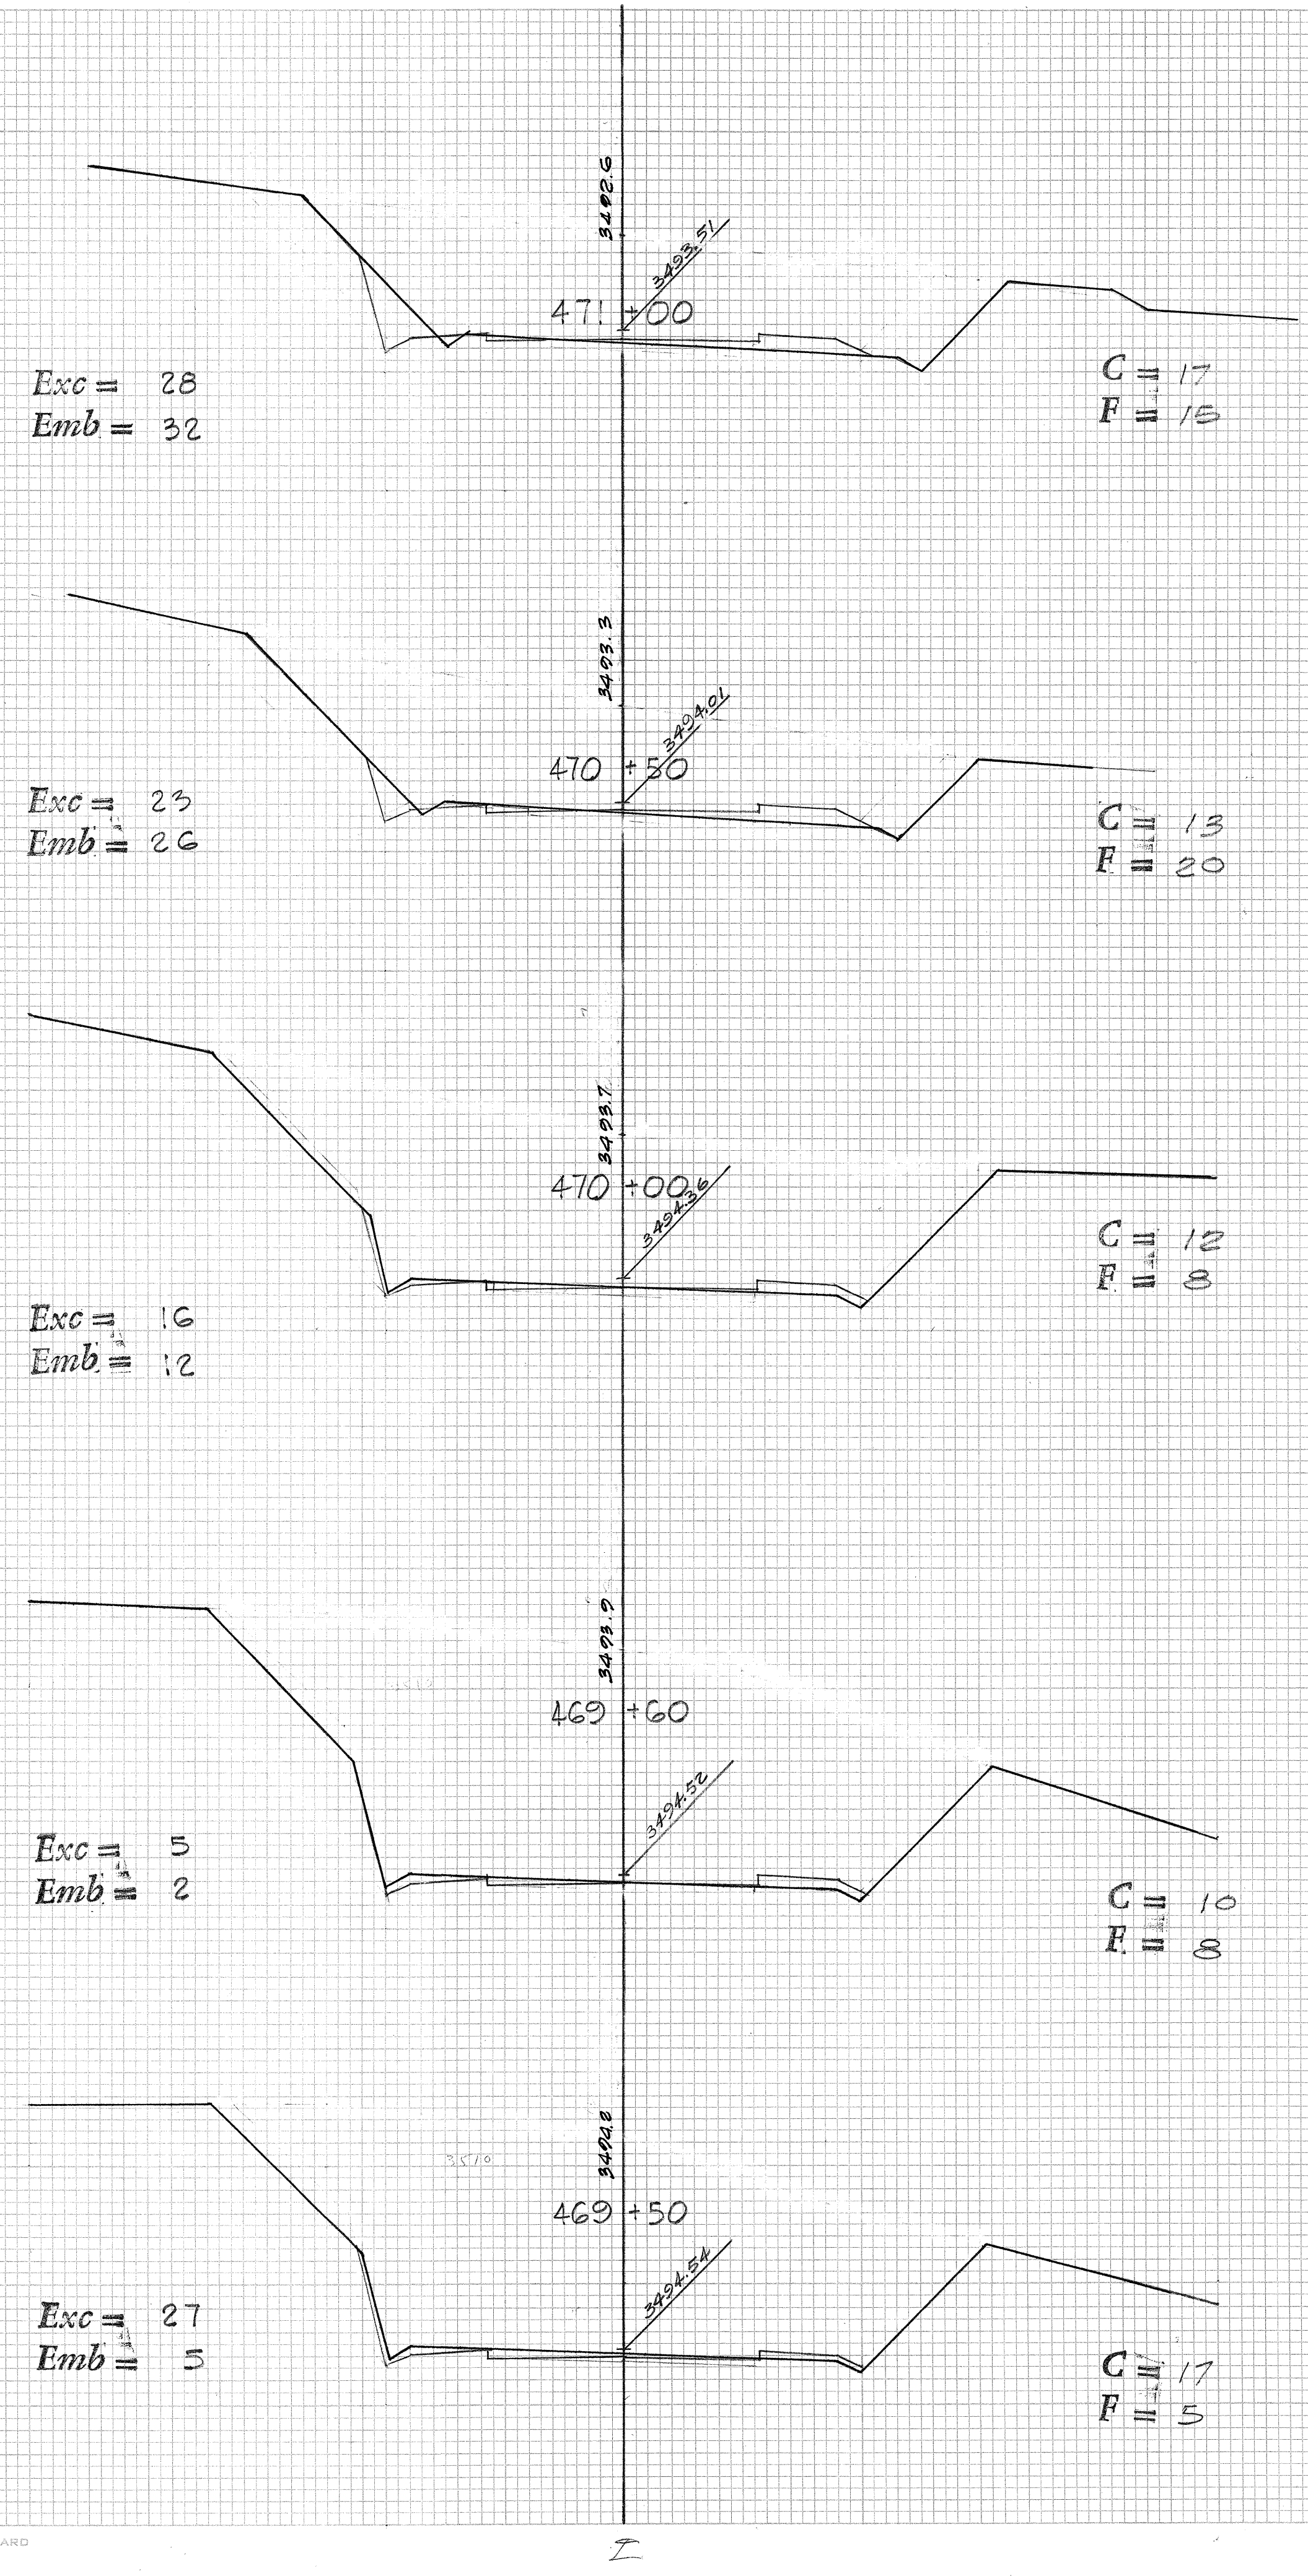


FED. ROAD DIST. NO.	STATE	FED. AID PROJ. NO.	FISCAL YEAR	SHEET NO.	TOTAL SHEETS
HAWAII	HAW.	5-0250(2)	1961	11	16

FINAL SURVEY	SURVEYED	DATE
NOTE BOOK	PLOTTED	BY
NO.	TEMPERATURE	
	AREAS CHECKED	


ORIGINAL SURVEY	SURVEYED	DATE
NOTE BOOK	PLOTTED	BY
NO.	TEMPERATURE	
	AREAS CHECKED	

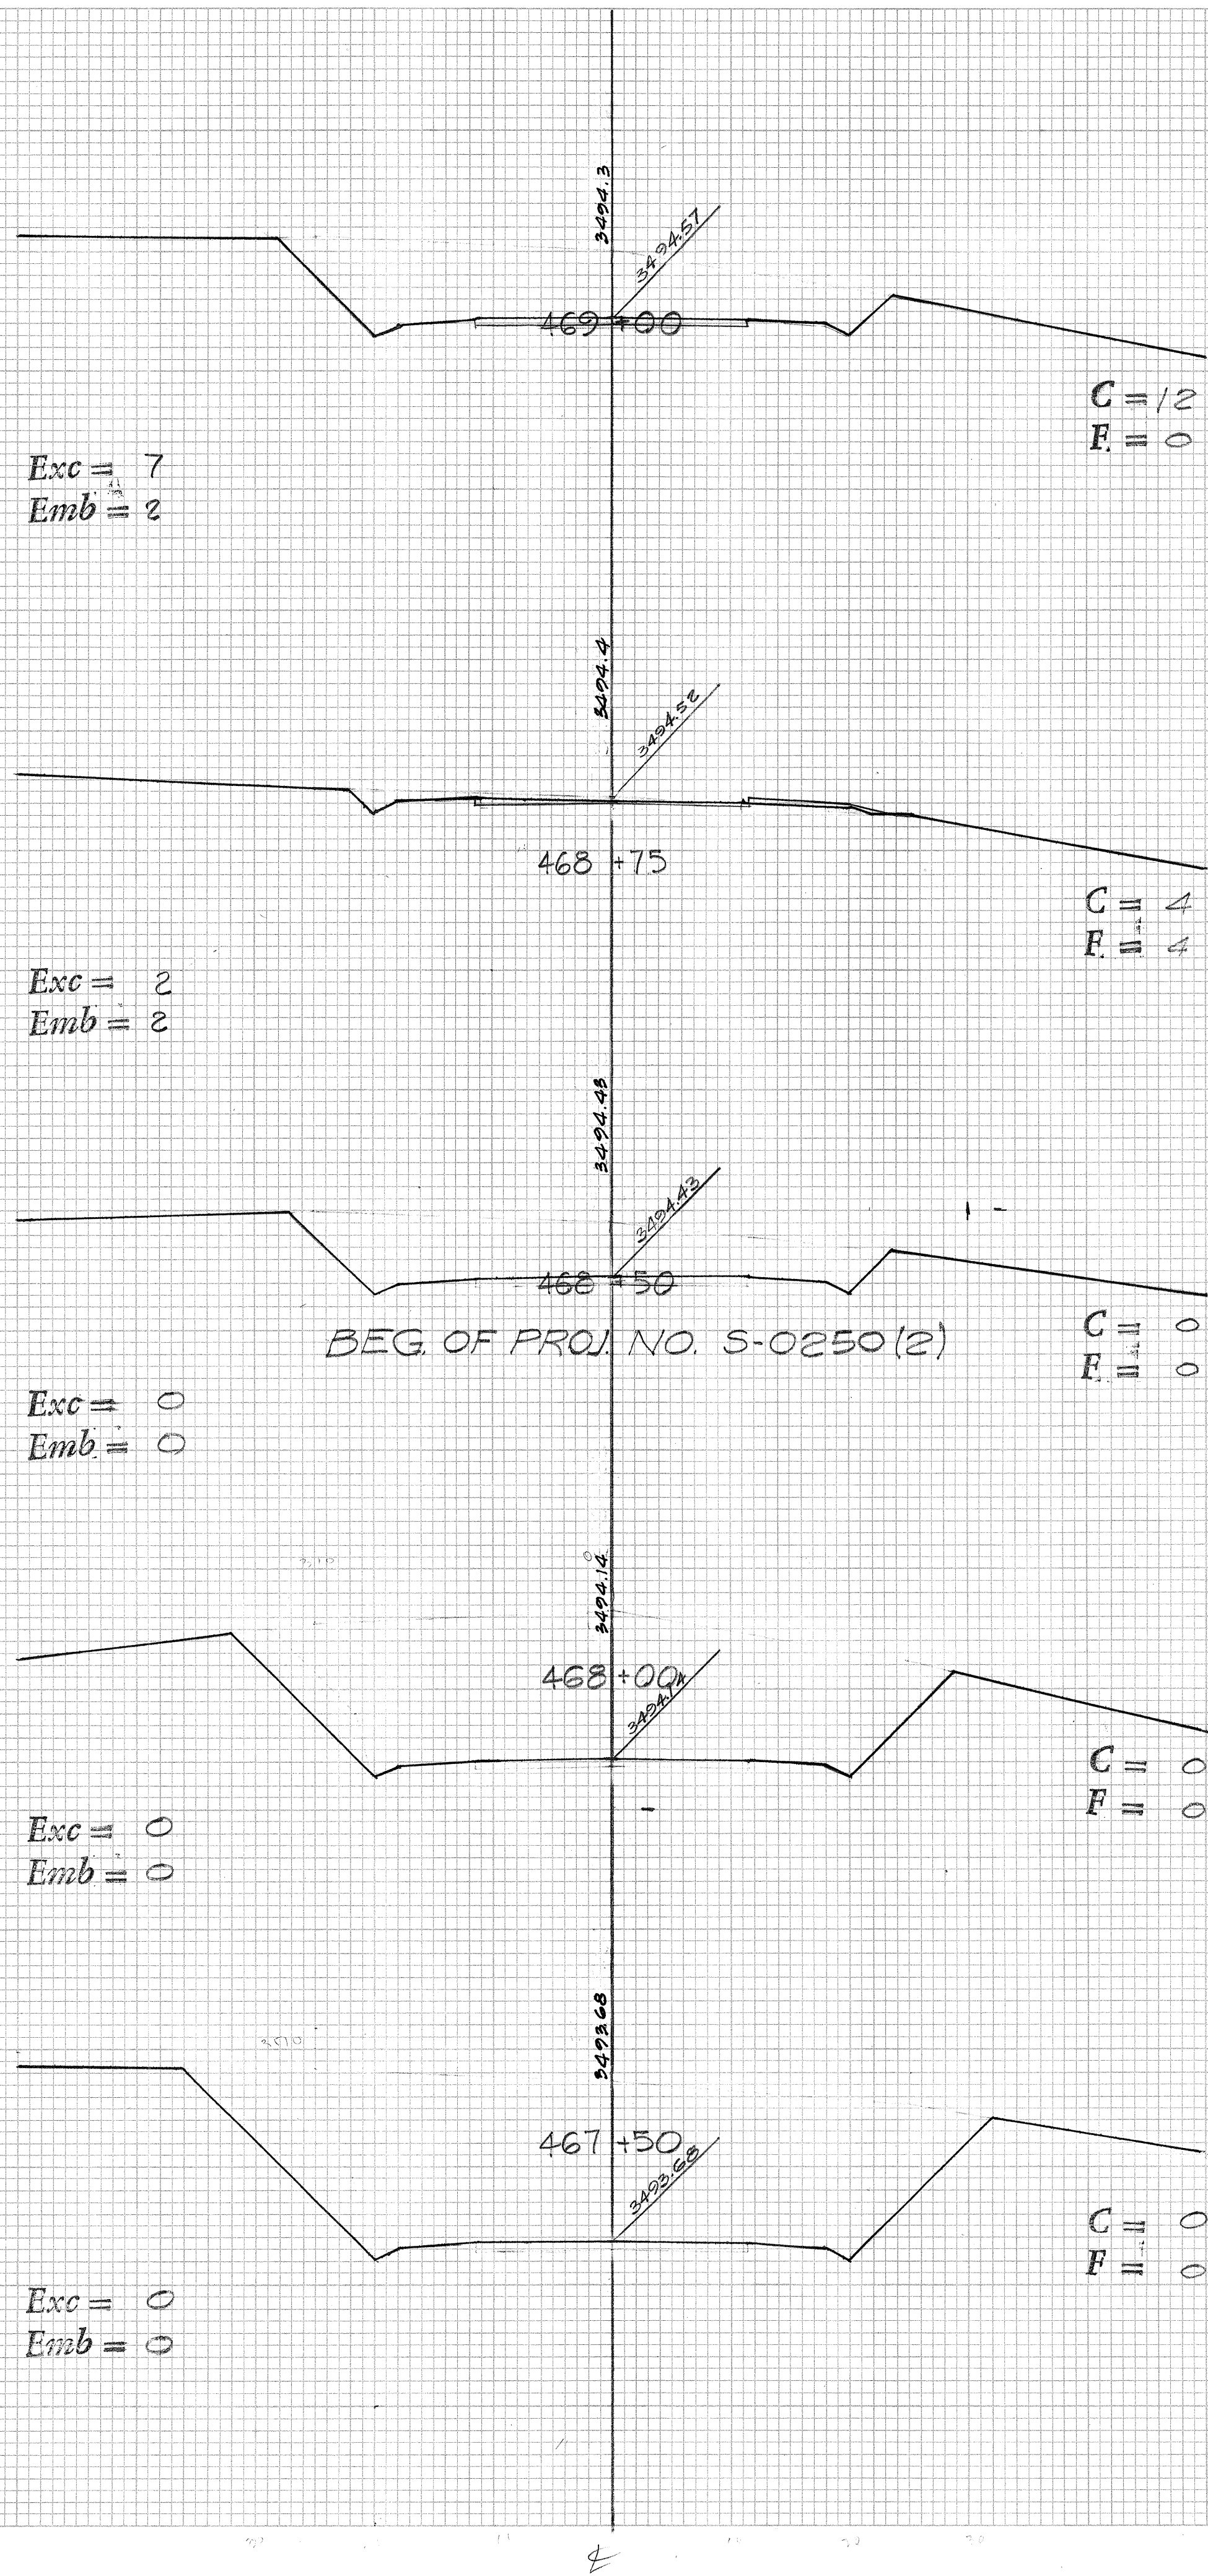

FED. ROAD DIST. No.	STATE	FED. AID PROJ. No.	FISCAL YEAR	SHEET No.	TOTAL SHEETS
HAWAII	HAW.	2-0290(2)	1961	12	16

DATE	BY	SURVEYED	PLOTTED	TEMPLATE	NO. BOOK	AREAS CHECKED



DATE	BY	SURVEYED	PLOTTED	TEMPLATE	NO. BOOK	AREAS CHECKED

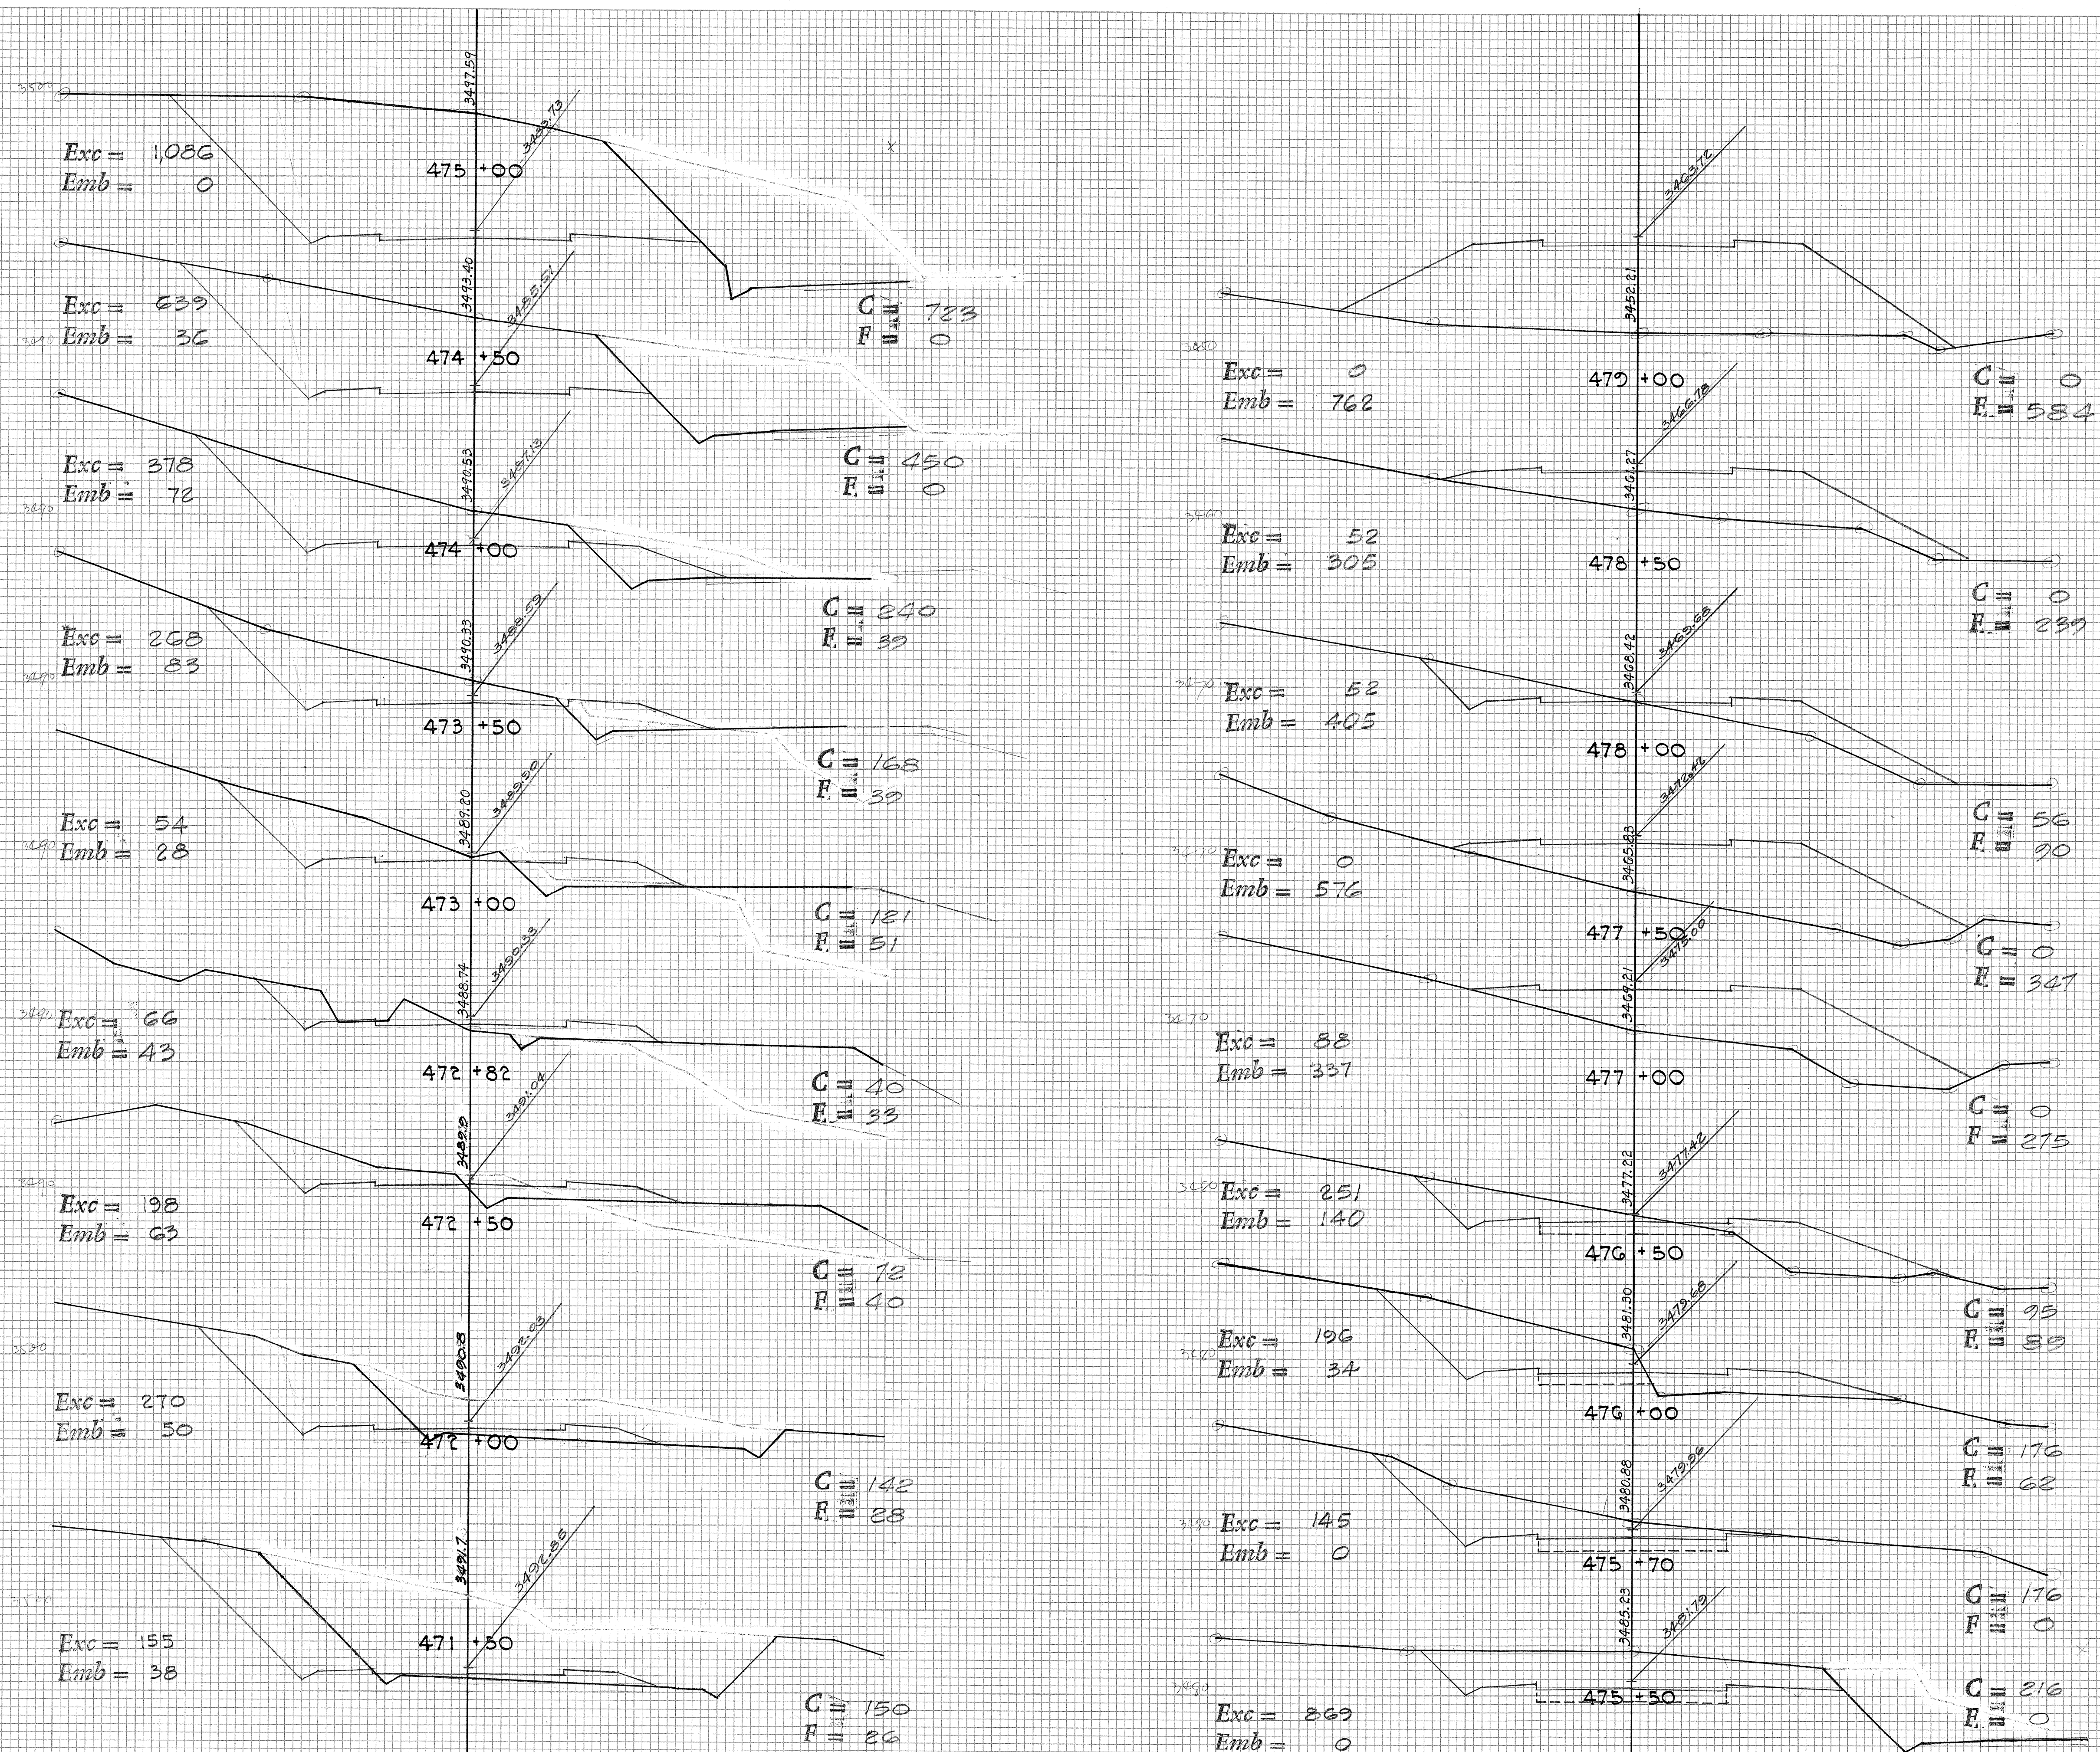

FED. ROAD DIST. No.	STATE	FED. AID PROJ. No.	FISCAL YEAR	SHEET No.	TOTAL SHEETS
HAWAII	HAW.	50250(2)	1961	13	16

DATE	BY
FINAL SURVEY	SURVEYED
NOTE BOOK	PLOTTED
NO.	AREAS CHECKED


DATE	BY
ORIGINAL SURVEY	SURVEYED
NOTE BOOK	PLOTTED
NO.	AREAS CHECKED

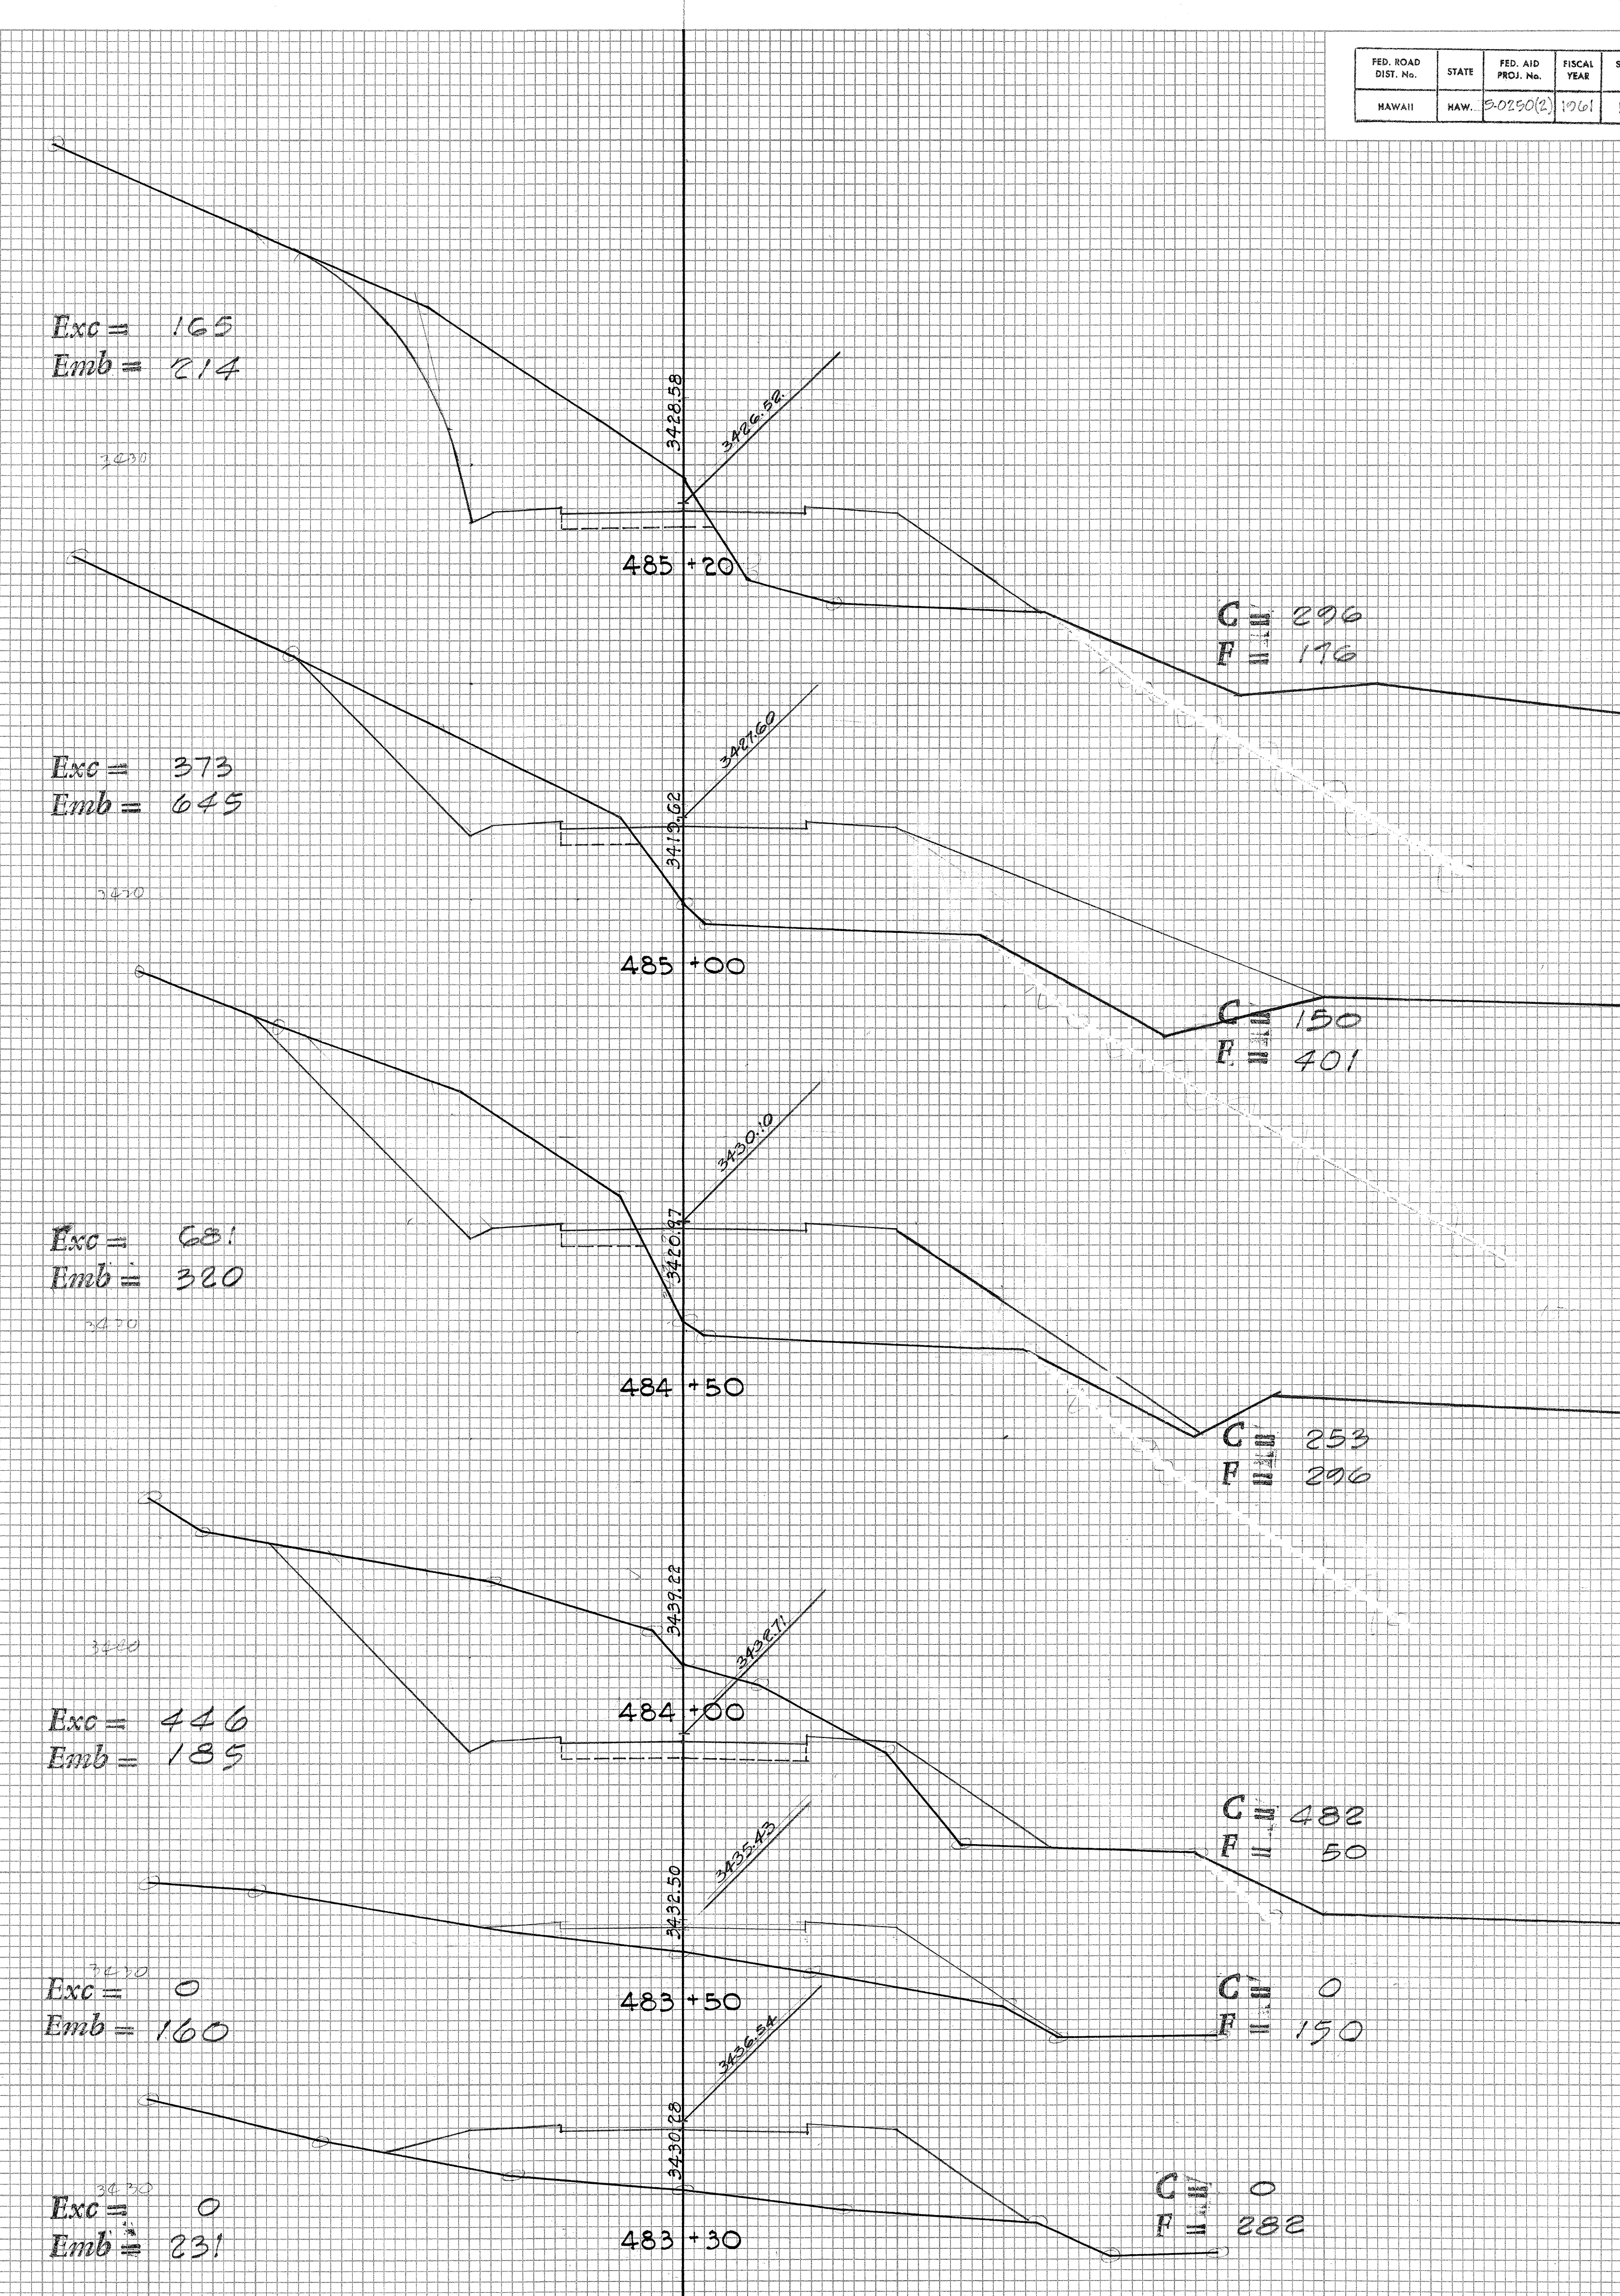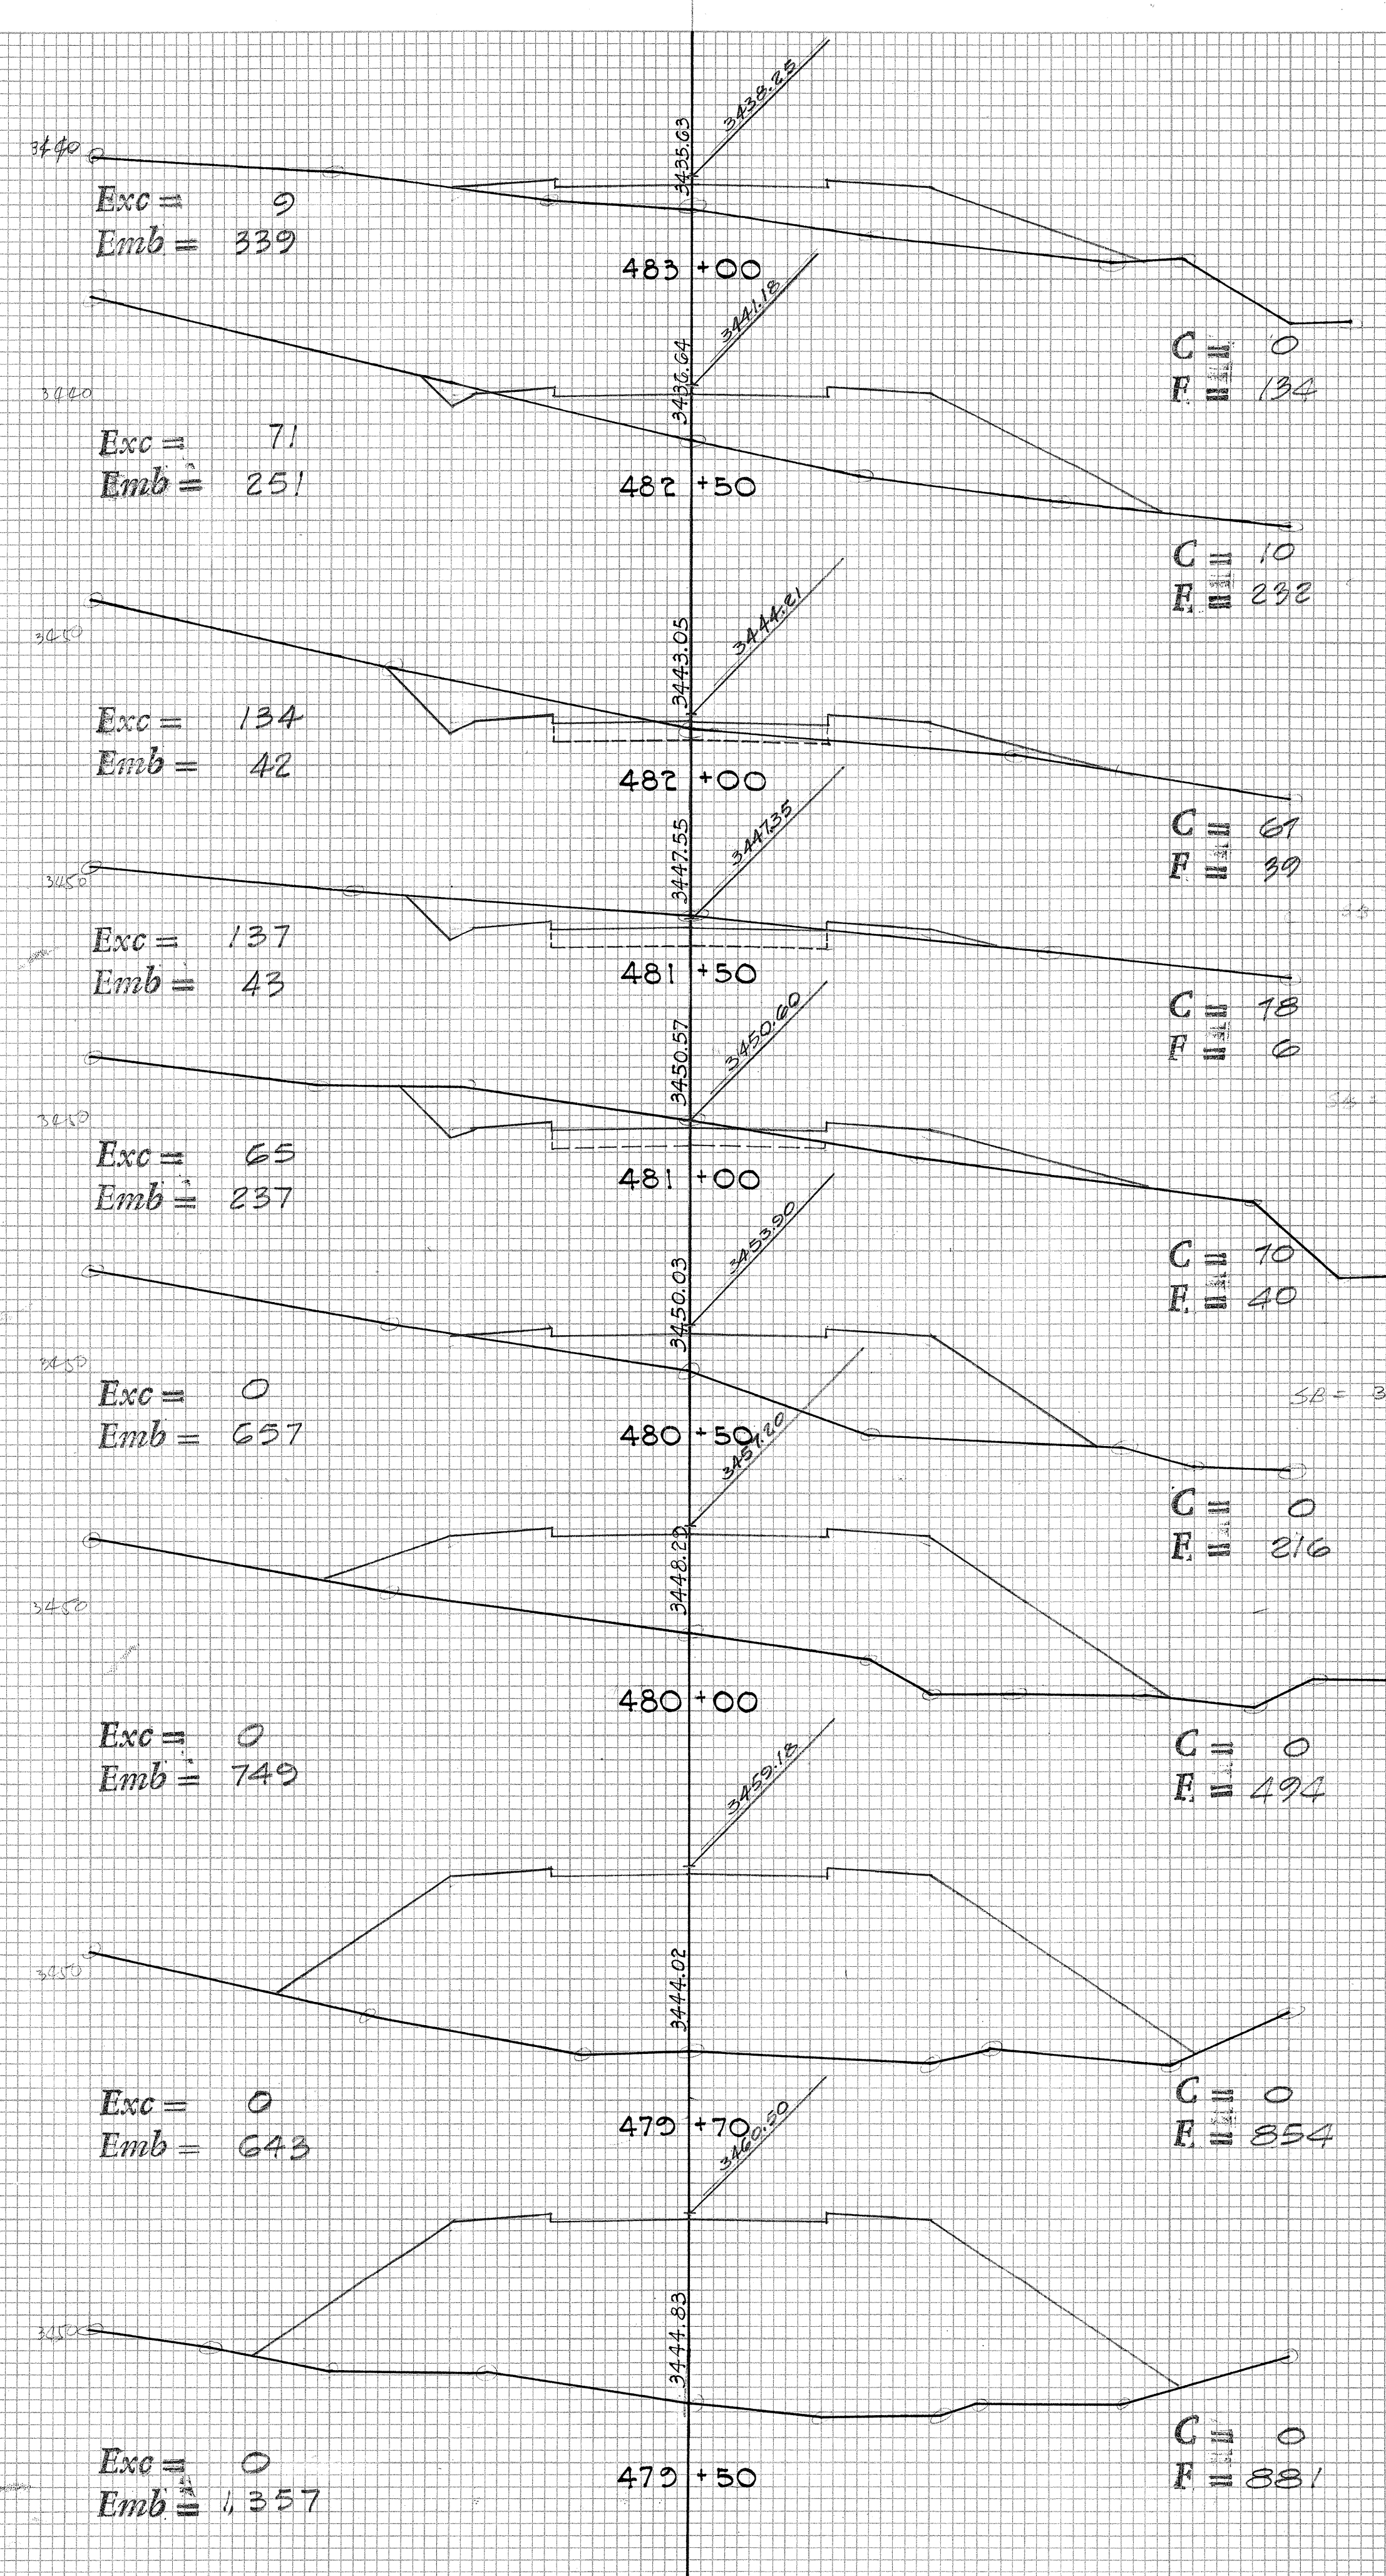

FED. ROAD DIST. No.	STATE	FED. AID PROJ. No.	FISCAL YEAR	SHEET No.	TOTAL SHEETS
HAWAII	HAW.	5-0290(2)	1961	14	16

FINAL SURVEY	SURVEYED	DATE
	PLOTTED	BY
	NOTE BOOK	
	AREAS CHECKED	


ORIGINAL SURVEY	SURVEYED	DATE
	PLOTTED	BY
	NOTE BOOK	
	AREAS CHECKED	

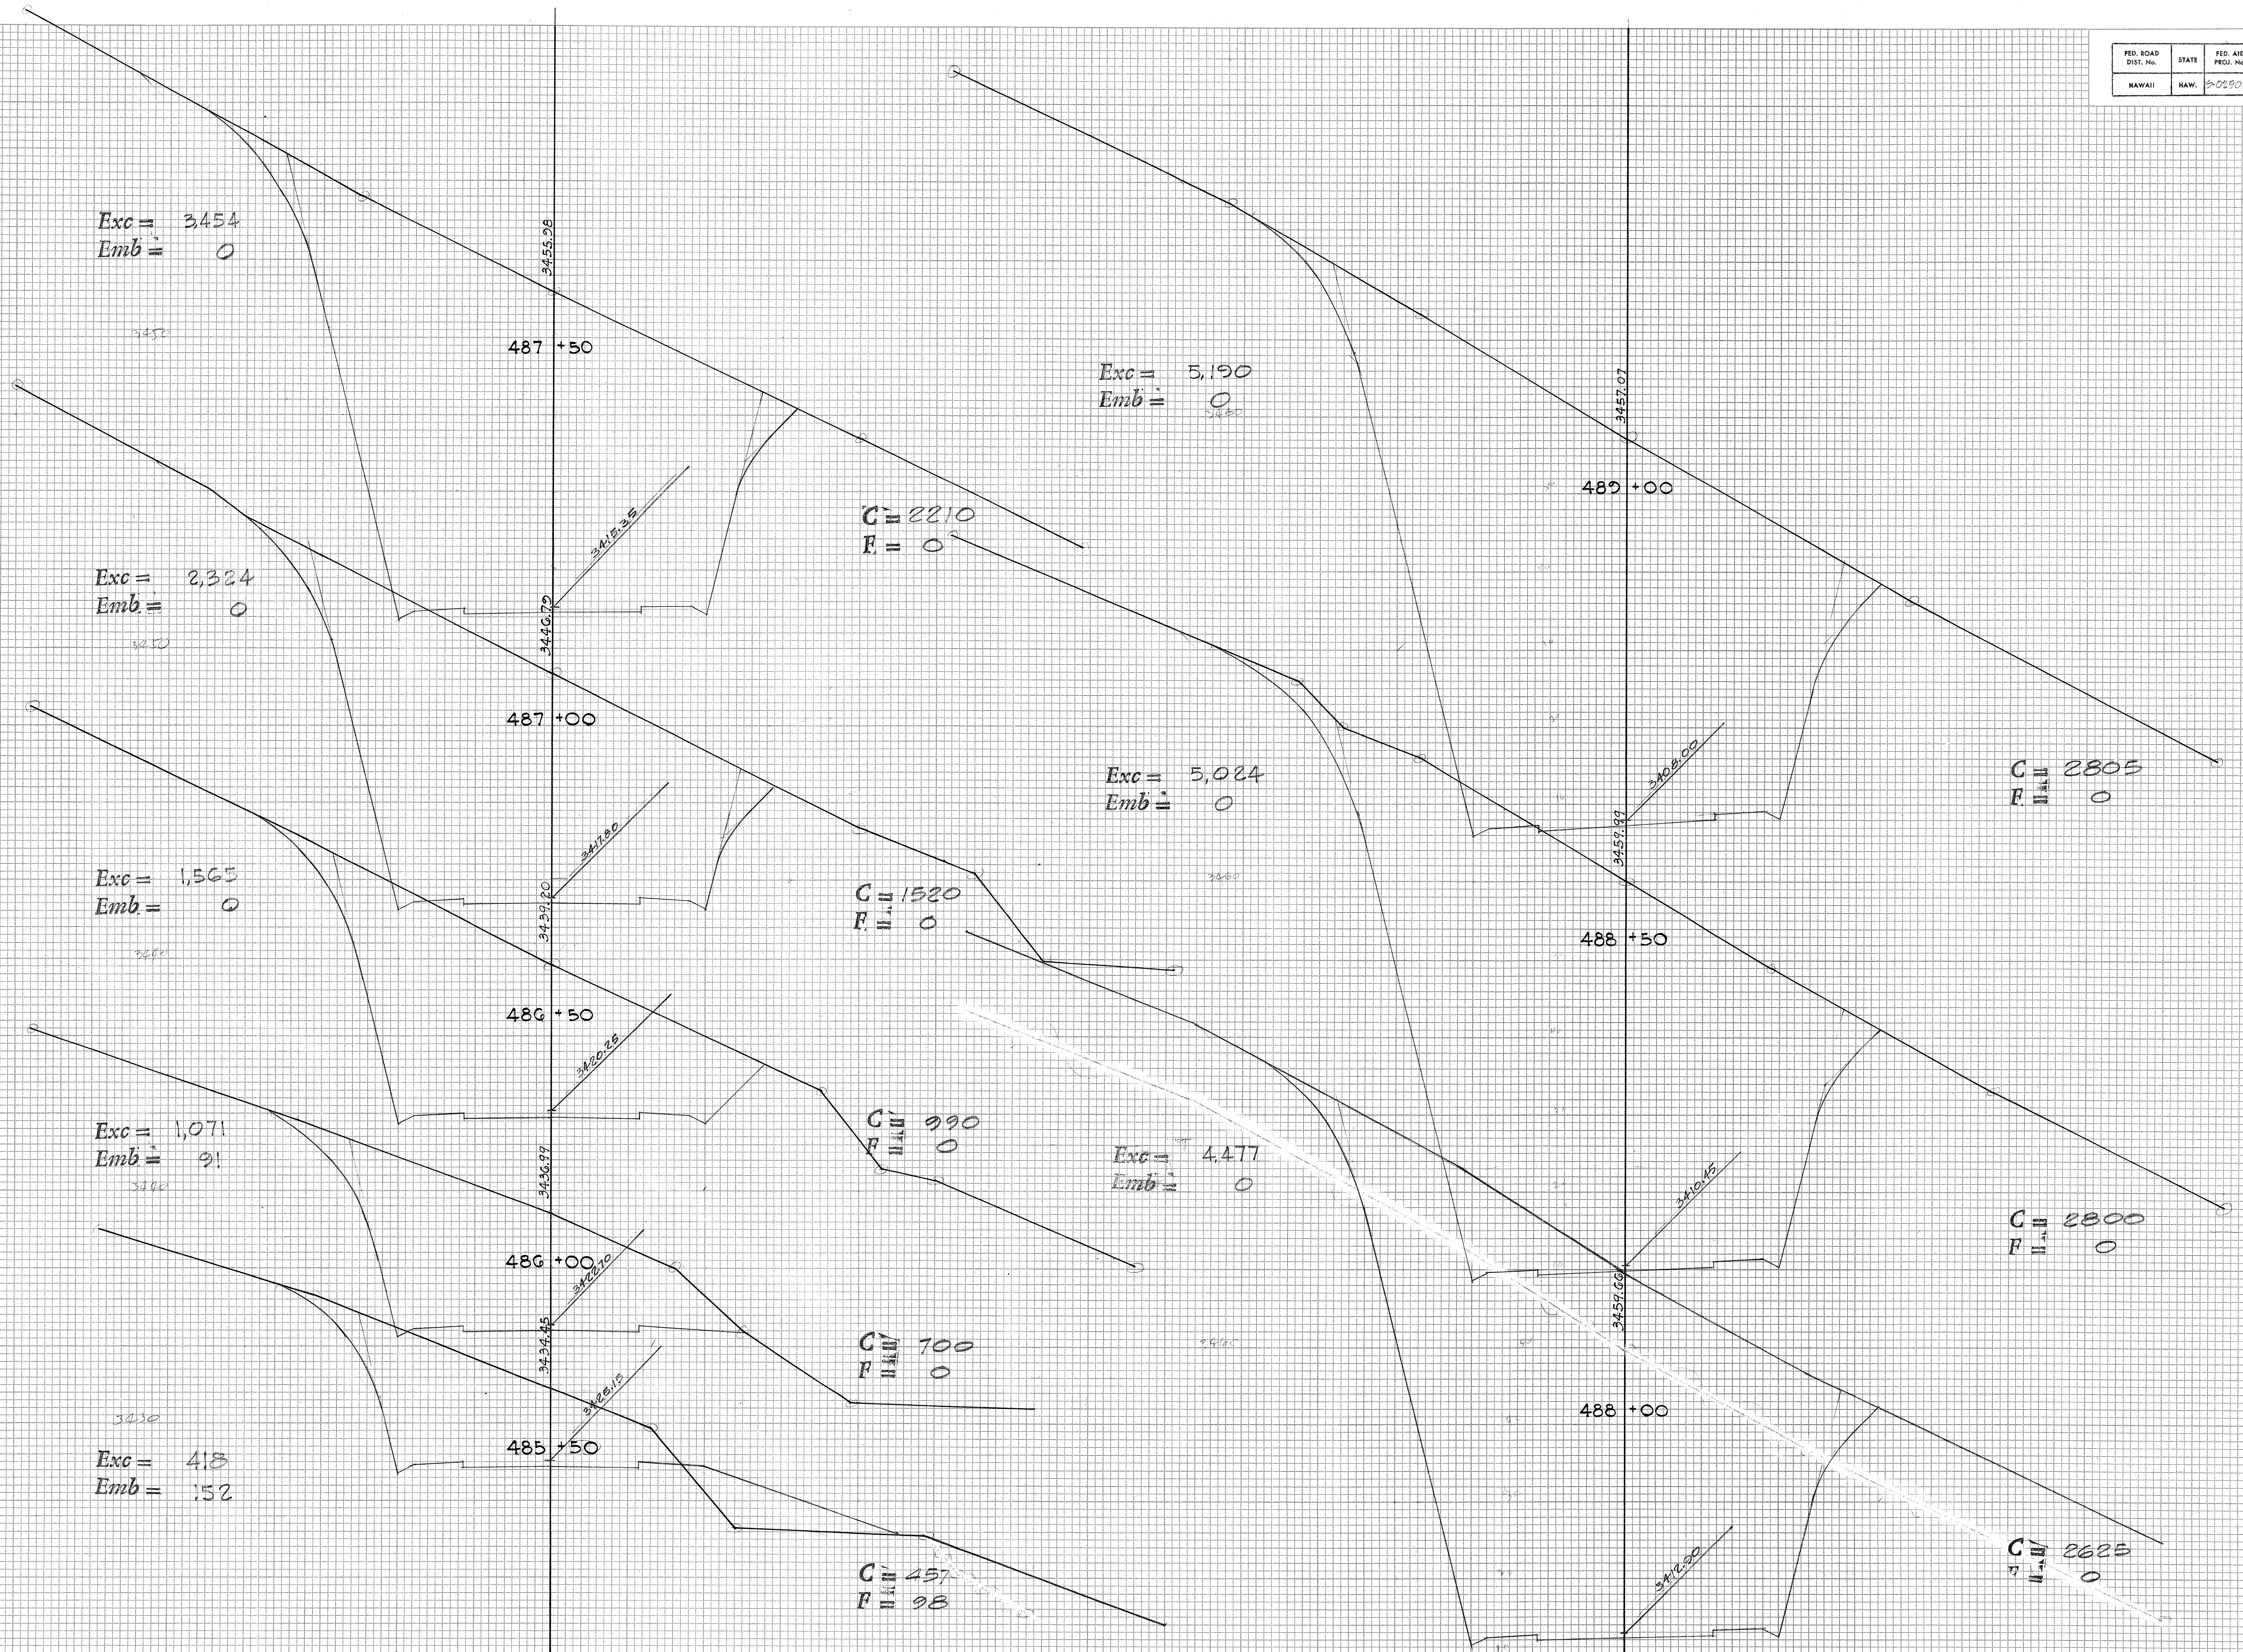

FED. ROAD DIST. No.	STATE	FED. AID PROJ. No.	FISCAL YEAR	SHEET No.	TOTAL SHEETS
HAWAII	HAW.	5-0250(2)	1961	15	16

FINAL SURVEY	BY	DATE
SURVEYED		
PLOTTED		
NOTE BOOK		
AREAS CHECKED		
NO.		

ORIGINAL SURVEY	BY	DATE
SURVEYED		
PLOTTED		
NOTE BOOK		
AREAS CHECKED		
NO.		

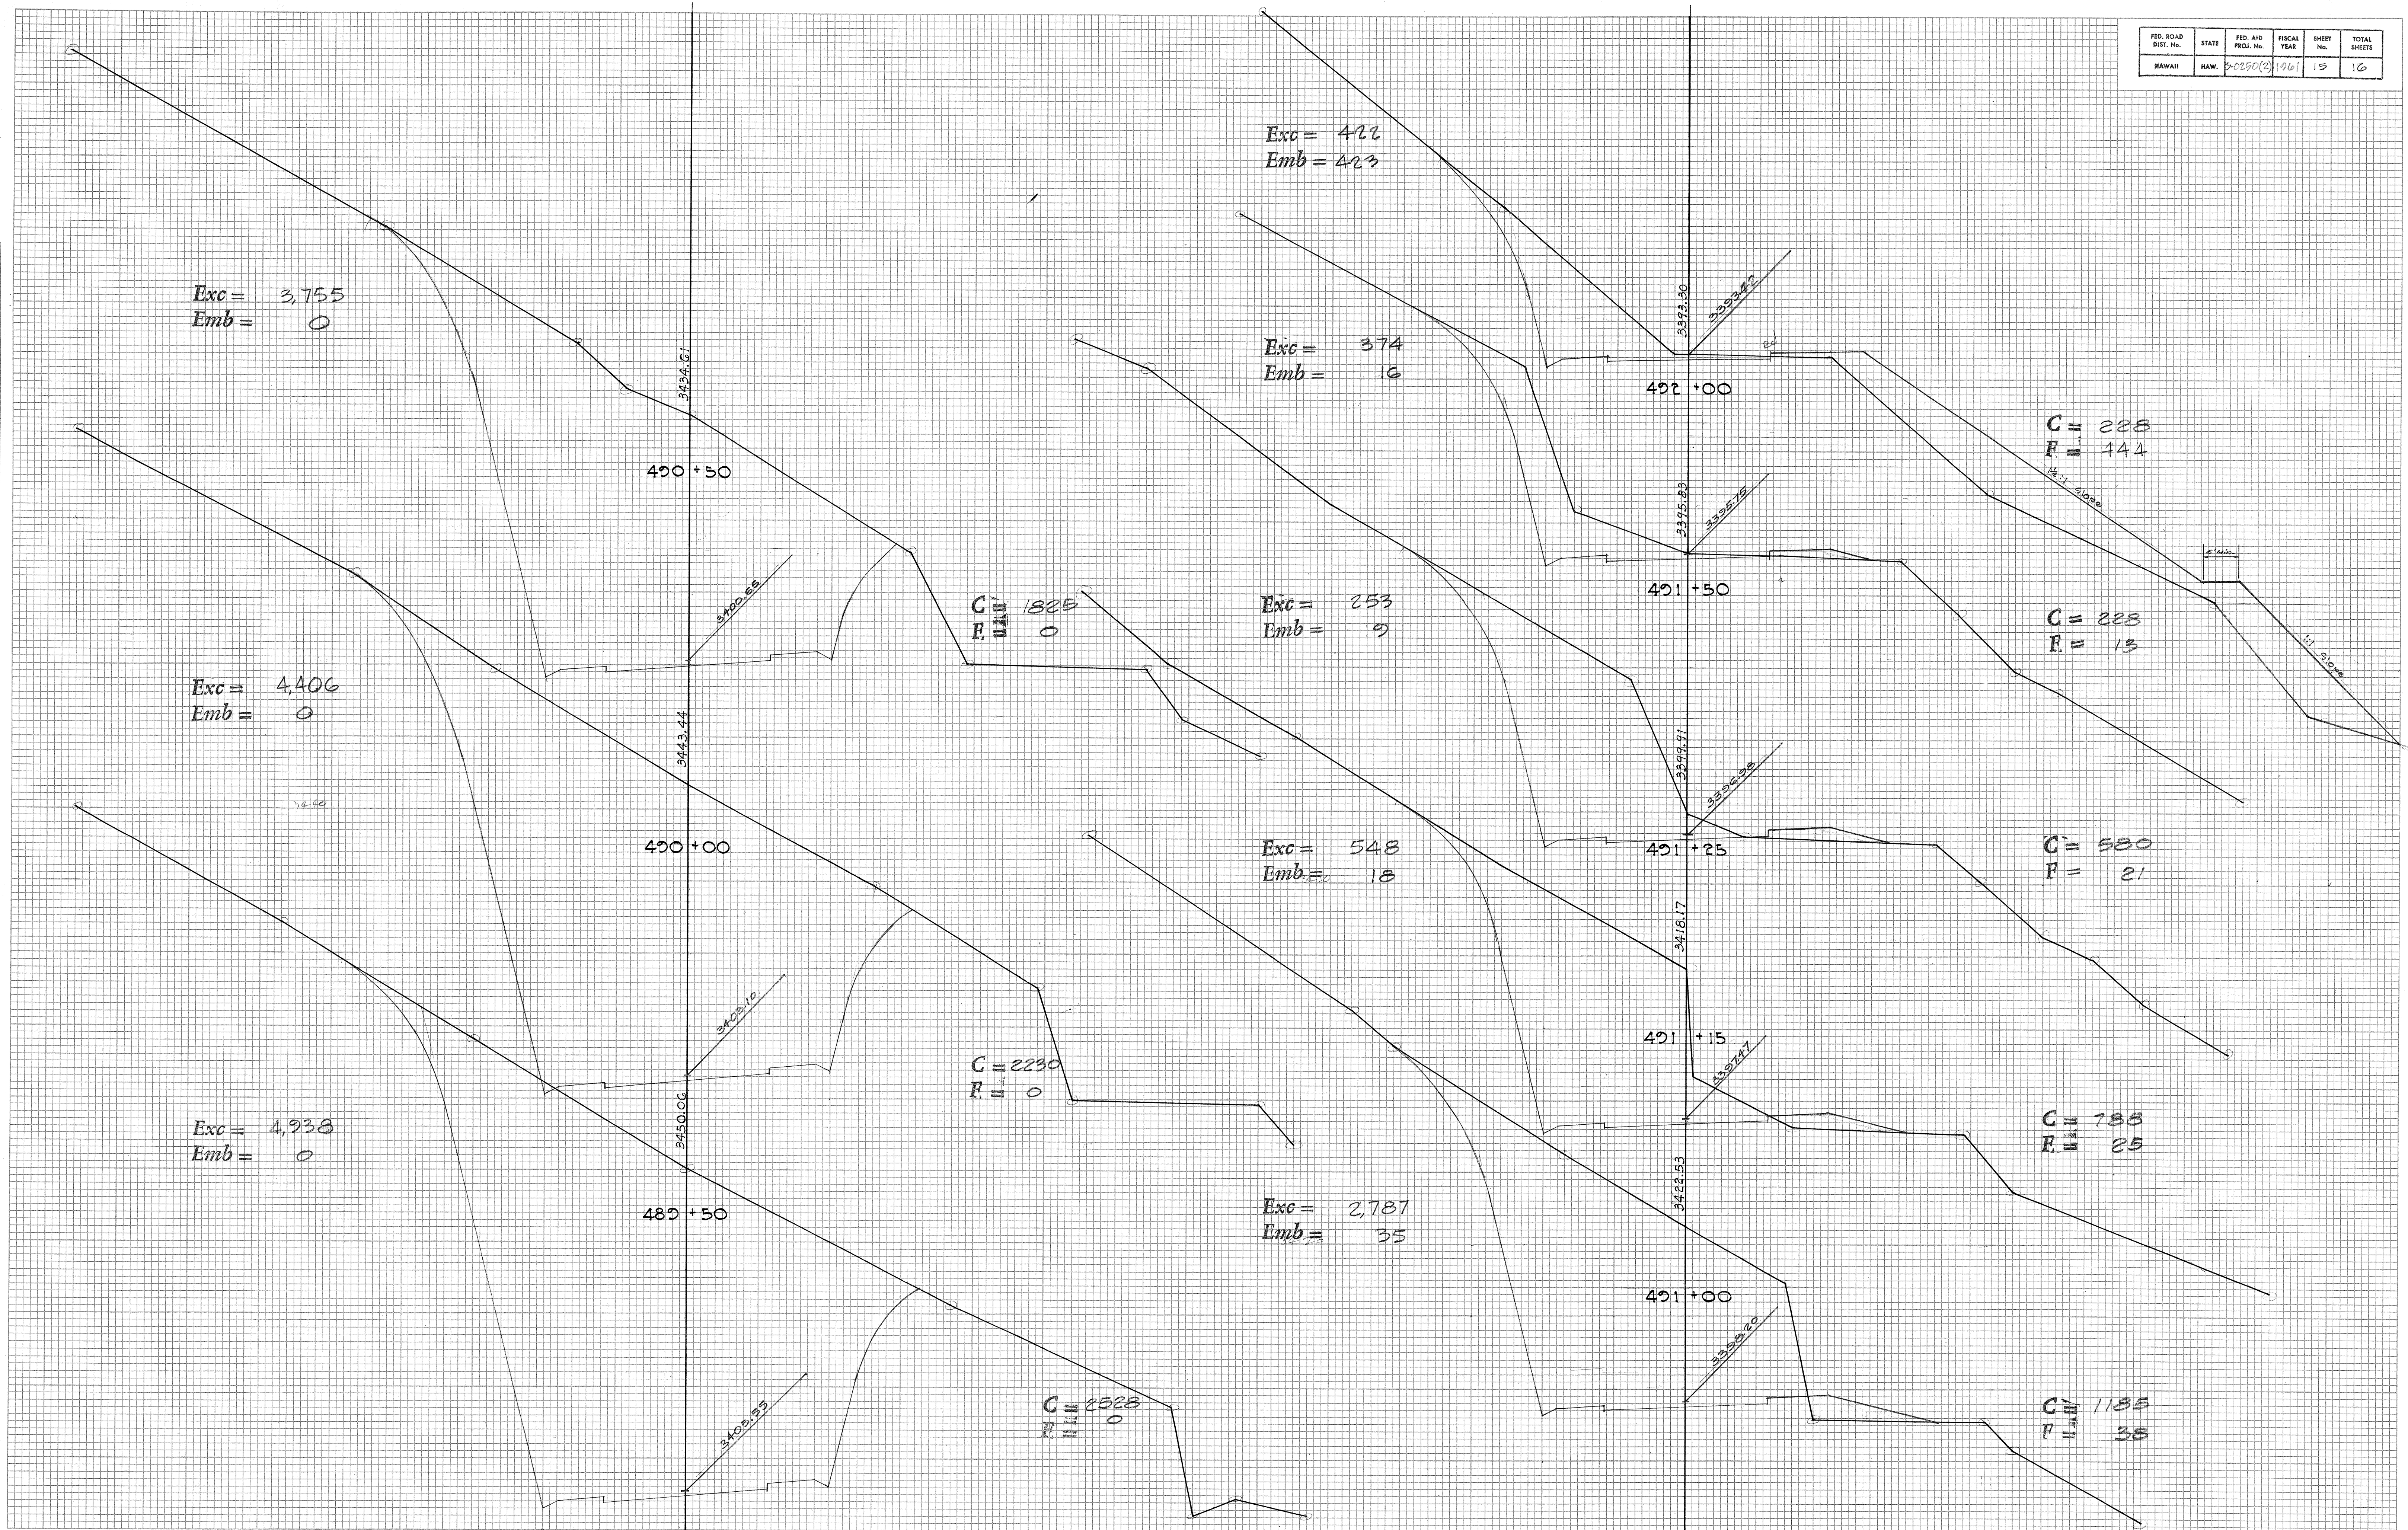

FED. ROAD DIST. No.	STATE	FED. AID PROJ. No.	FISCAL YEAR	SHEET No.	TOTAL SHEETS
HAWAII	HAW.	6-0250(2)	1961	16	16

FINAL SURVEY	DATE	BY
DESIGNED		
PLOTTED		
NOTE BOOK		
NO.		

ORIGINAL SURVEY	DATE	BY
DESIGNED		
PLOTTED		
NOTE BOOK		
NO.		

