


GENERAL NOTES:

1. Azimuths and coordinates are referred to "Puu Loa" Δ.
2. Install Δ Monuments along Δ of R/W as staked by the Engineer.
3. Existing pavements within R/W to be abandoned shall be scarified and dressed as ordered by the Engineer.
4. Utility Poles shall be relocated by others.

R.P. 3605, L.C. Aw. 8513 to Lorenzo B. Lincoln
Anna L. Perry - Piske - Owner

R.P. 3605, L.C. Aw. 8513 to Lorenzo B. Lincoln
Richard Smart - Owner

FED. ROAD DIST. NO.	STATE	FED. AID PROJ. NO.	FISCAL YEAR	SHEET NO.	TOTAL SHEETS
HAWAII	HAW.	9-0250(2)	1961	4	16

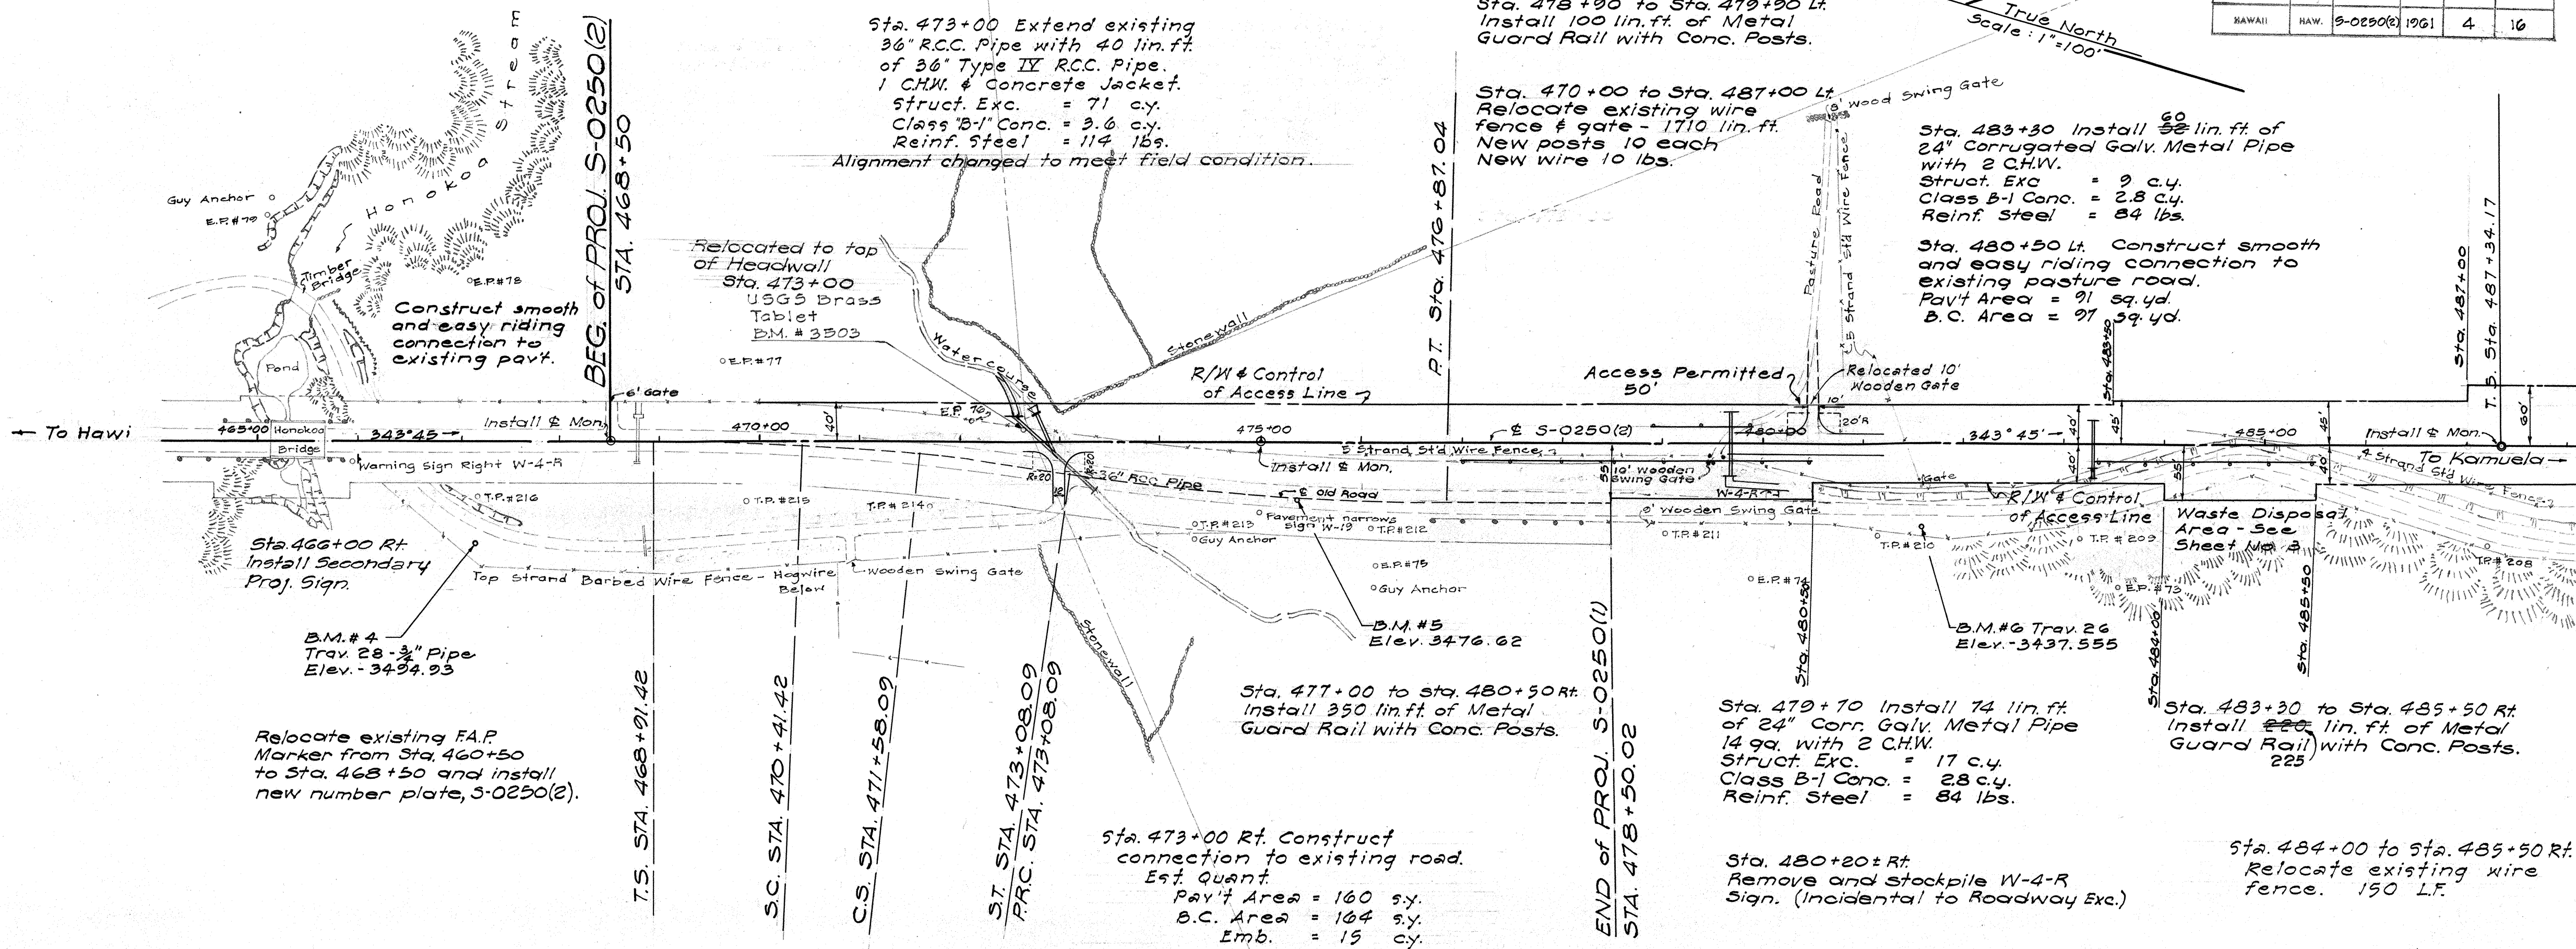

RIGHT-OF-WAY SYMBOLS

- Vehicular Access Permitted
- No Vehicular Access Permitted



R.P. 3605, L.C. Aw. 8513 to Lorenzo B. Lincoln
Kahua Ranch Ltd. - Owner

Note:

The soil profile data shown on these sheets are for design purposes only and are intended for the convenience of the Engineer in control of earthwork. The borings were carefully taken and are believed to be reliable, but the Engineer does not guarantee the accuracy of same. The Contractor is hereby advised and will be presumed to have made his own investigation on the site prior to submission of his bid. The State will not be held responsible for data shown in these sheets.

SOIL LEGEND

- Ash
- Ash mixed with Andesite
- Decomposed Andesite mixed with Ash
- Decomposed Andesite
- Andesite Clinker
- Andesite

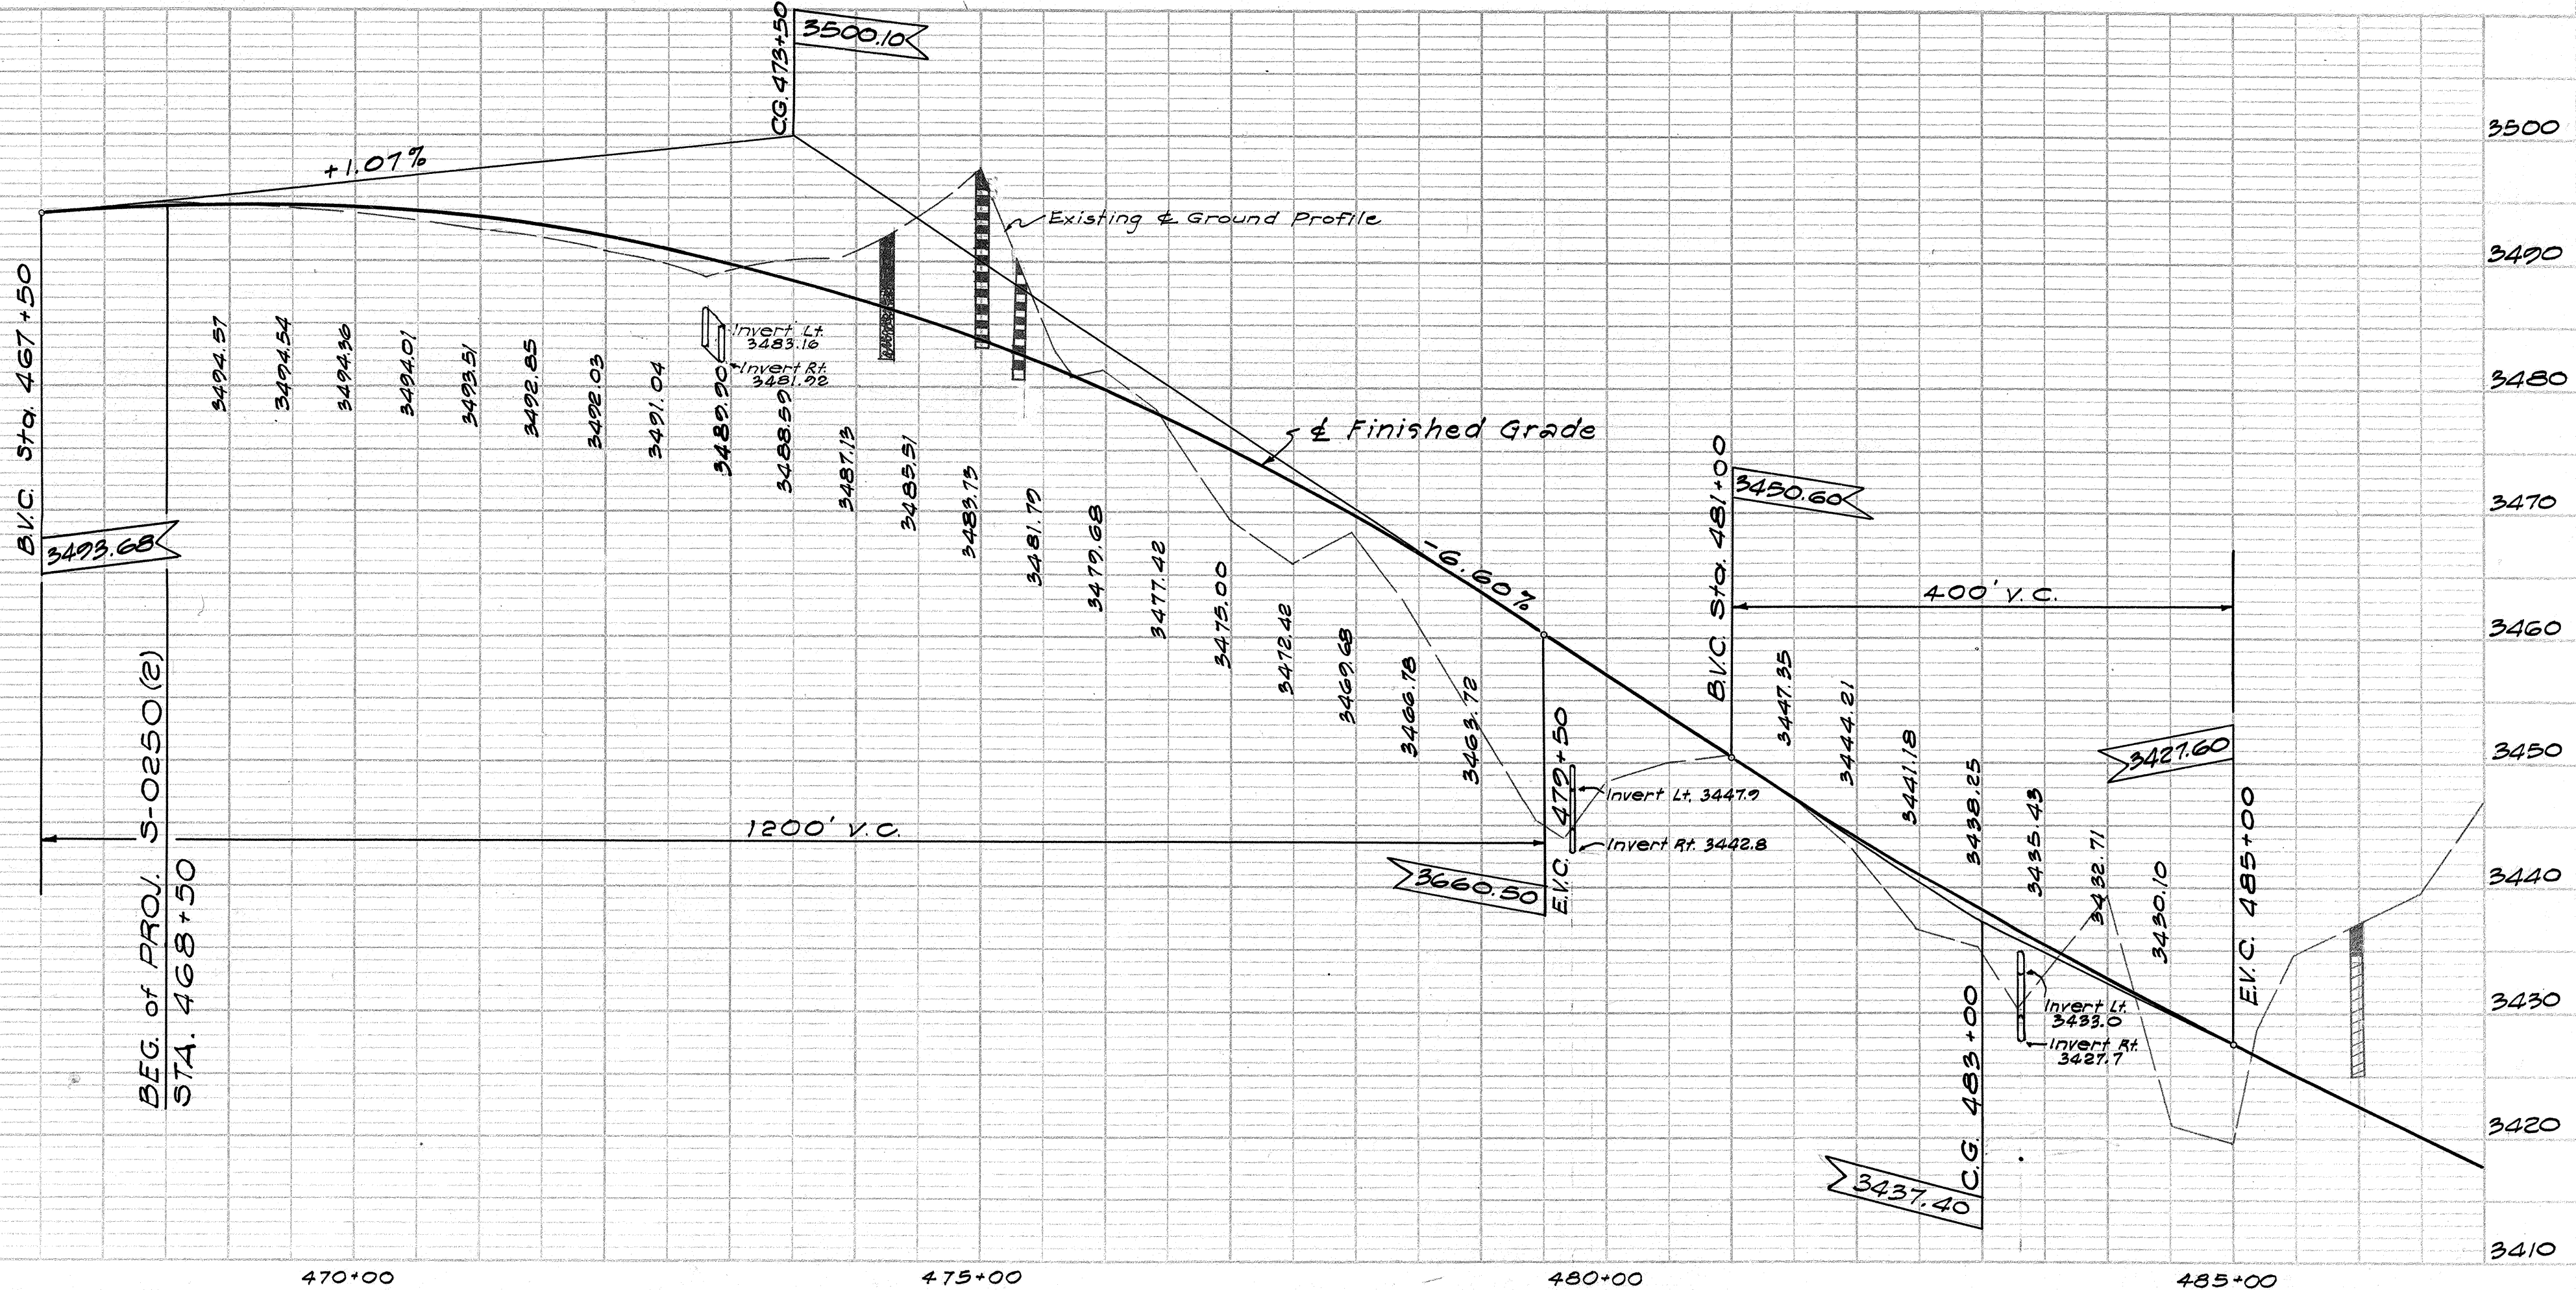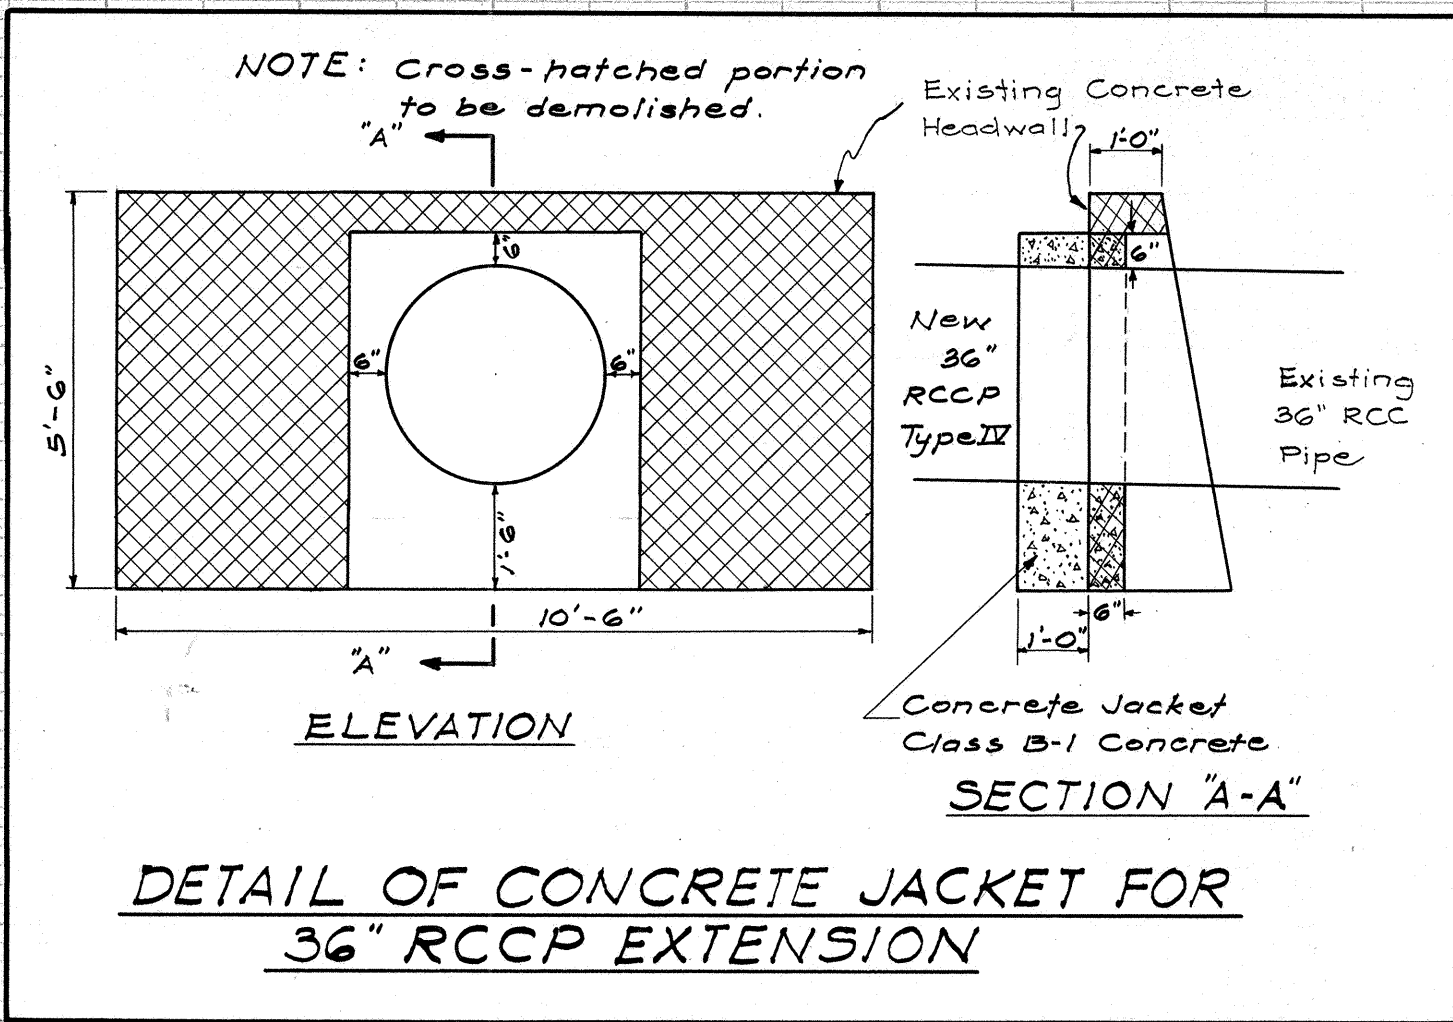

FED. ROAD DIST. No.	STATE	FED. AID PROJ. No.	FISCAL YEAR	SHEET No.	TOTAL SHEETS
HAWAII	HAW.	5-0250(2)	1961	9	16

PLAN	DATE	BY
SURVEYED		
PLOTTED		
NOTE BOOK		
ALIGNMENT CHECKED		
NO.		

PROFILE	DATE	BY
SURVEYED		
NOTE BOOK		
GRADES CHECKED		
B.M. S. NOTED		
STRUCTURE NOTATIONS CHKD.		
NO.		

