


FED. ROAD DIST. NO.	STATE	FED. AID PROJ. NO.	FISCAL YEAR	SHEET NO.	TOTAL SHEETS
HAWAII	HAWAII	S-0250(1)	1961	3	10

END PROJ. NO S-0250(1)
Sta. 478+50.22

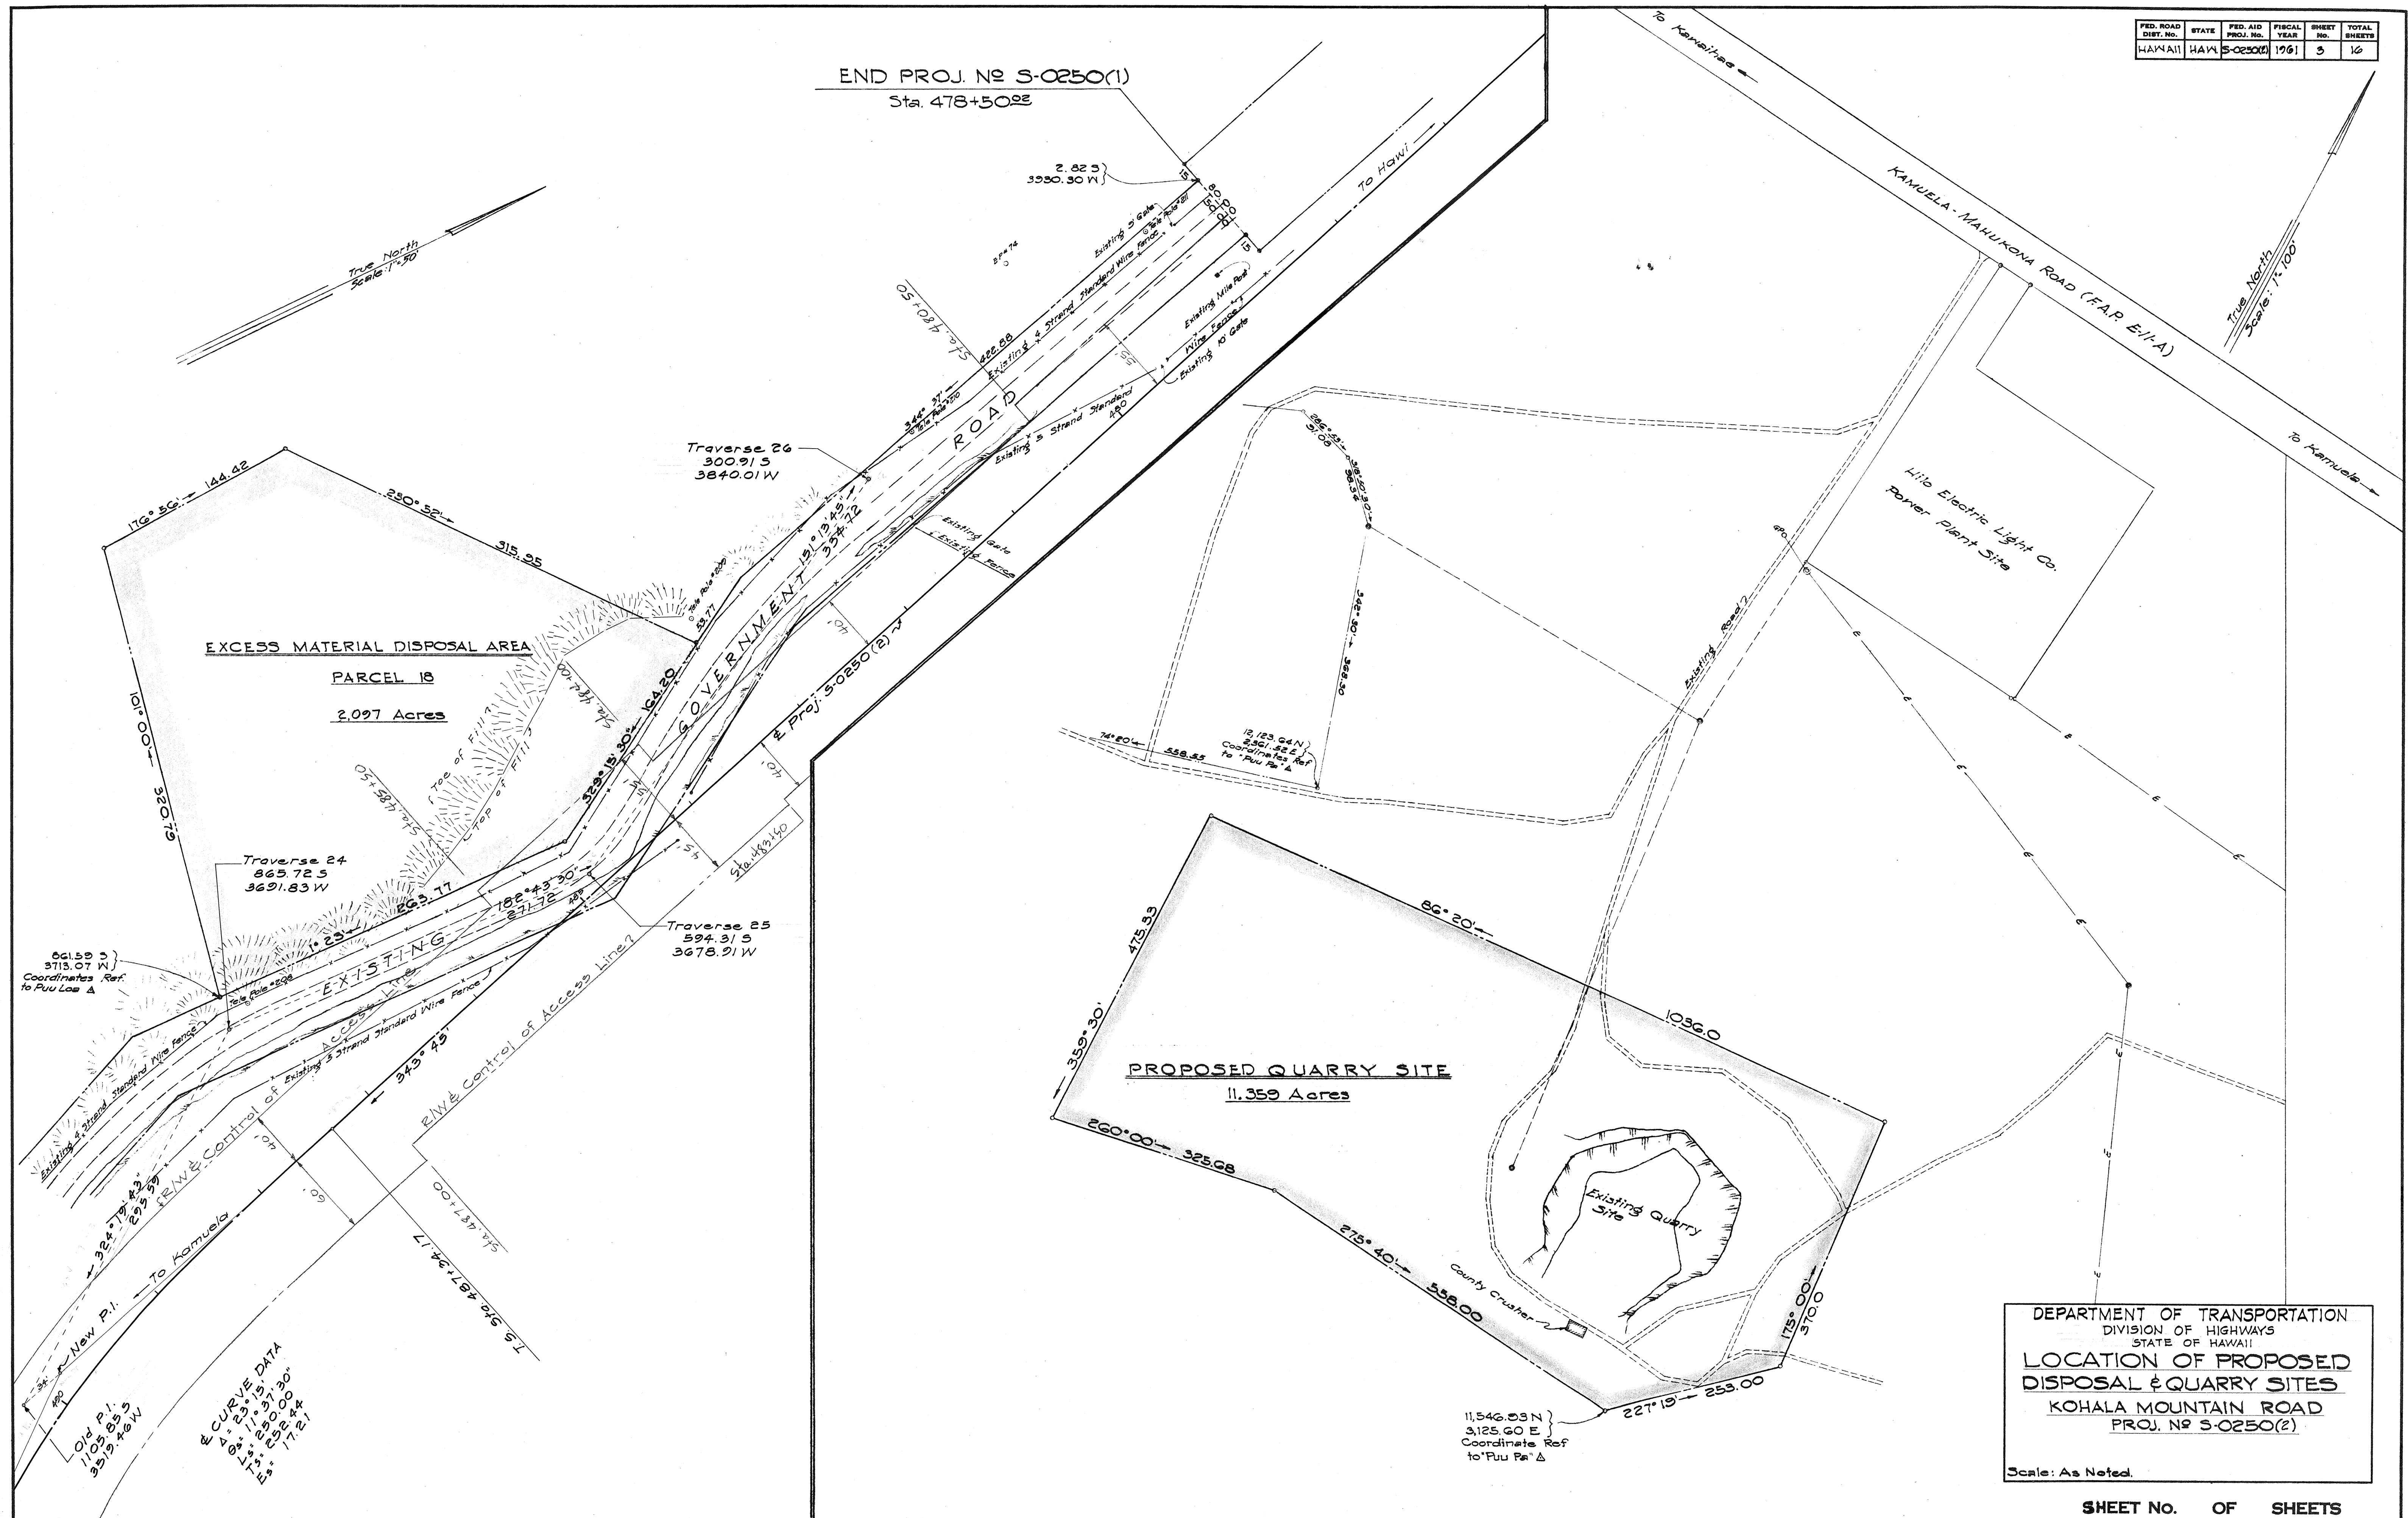

DESIGNED BY	DATE
TRACED BY	
QUANTITIES BY	
CHECKED BY	
NO.	

DEPARTMENT OF TRANSPORTATION
DIVISION OF HIGHWAYS
STATE OF HAWAII
**LOCATION OF PROPOSED
DISPOSAL & QUARRY SITES**
KOHALA MOUNTAIN ROAD
PROJ. NO S-0250(2)

Scale: As Noted.

SHEET No. OF SHEETS