

INDEX TO DRAWINGS	
SHEET	DESCRIPTION
1	Title Sheet
2	Typical Sections
3	Quarry & Waste Disposal Sites
4-5	Plan and Profile
6-10	Standard Details
11-16	Cross Sections

STATE OF HAWAII

DEPARTMENT OF TRANSPORTATION

DIVISION OF HIGHWAYS

PLANS OF

KOHALA MOUNTAIN ROAD


FEDERAL AID SECONDARY PROJECT NO. S-0250(2)

DISTRICT OF SOUTH KOHALA

ISLAND OF HAWAII

SCALES

PLAN	-----	1 INCH	= 100 FT.
PROFILE	-----	HOR. 1 INCH	= 100 FT.
		VER. 1 INCH	= 10 FT.
CROSS SECTION	-----	HOR. 1 INCH	= 10 FT.
		VER. 1 INCH	= 10 FT.

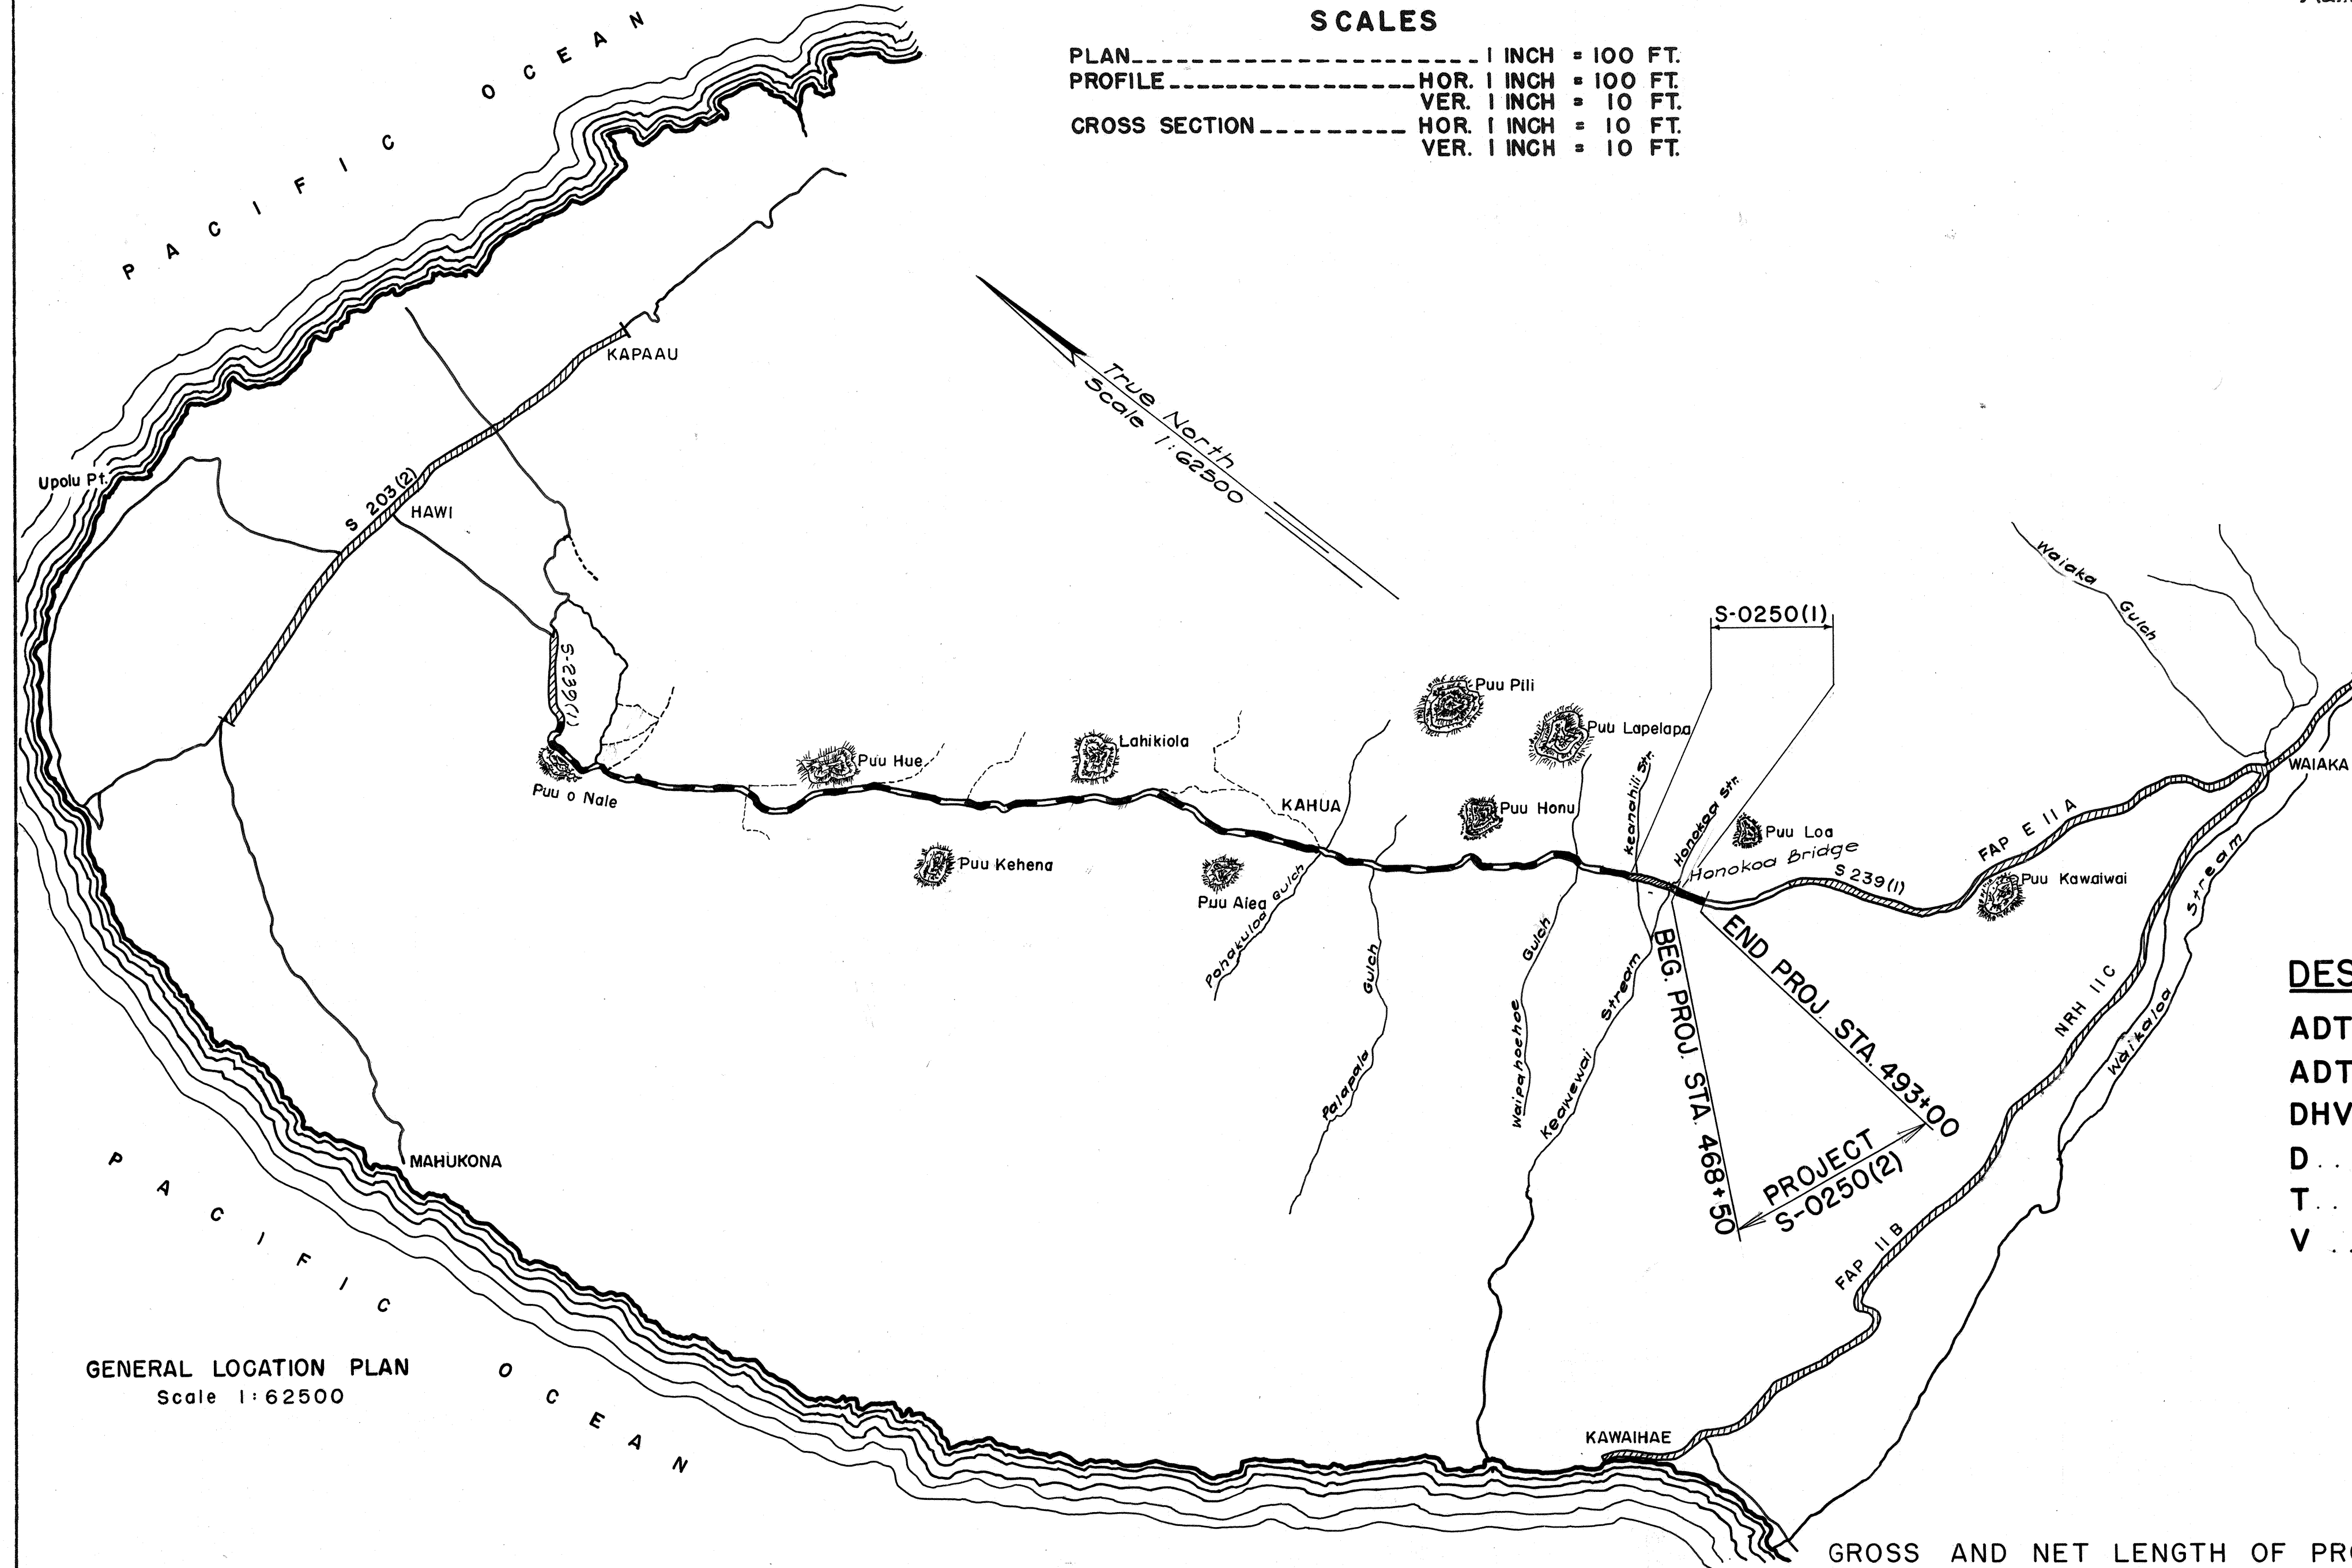


GENERAL LOCATION PLAN

Scale 1:62500

LOCATION OF PROJECT

S-0250(2)

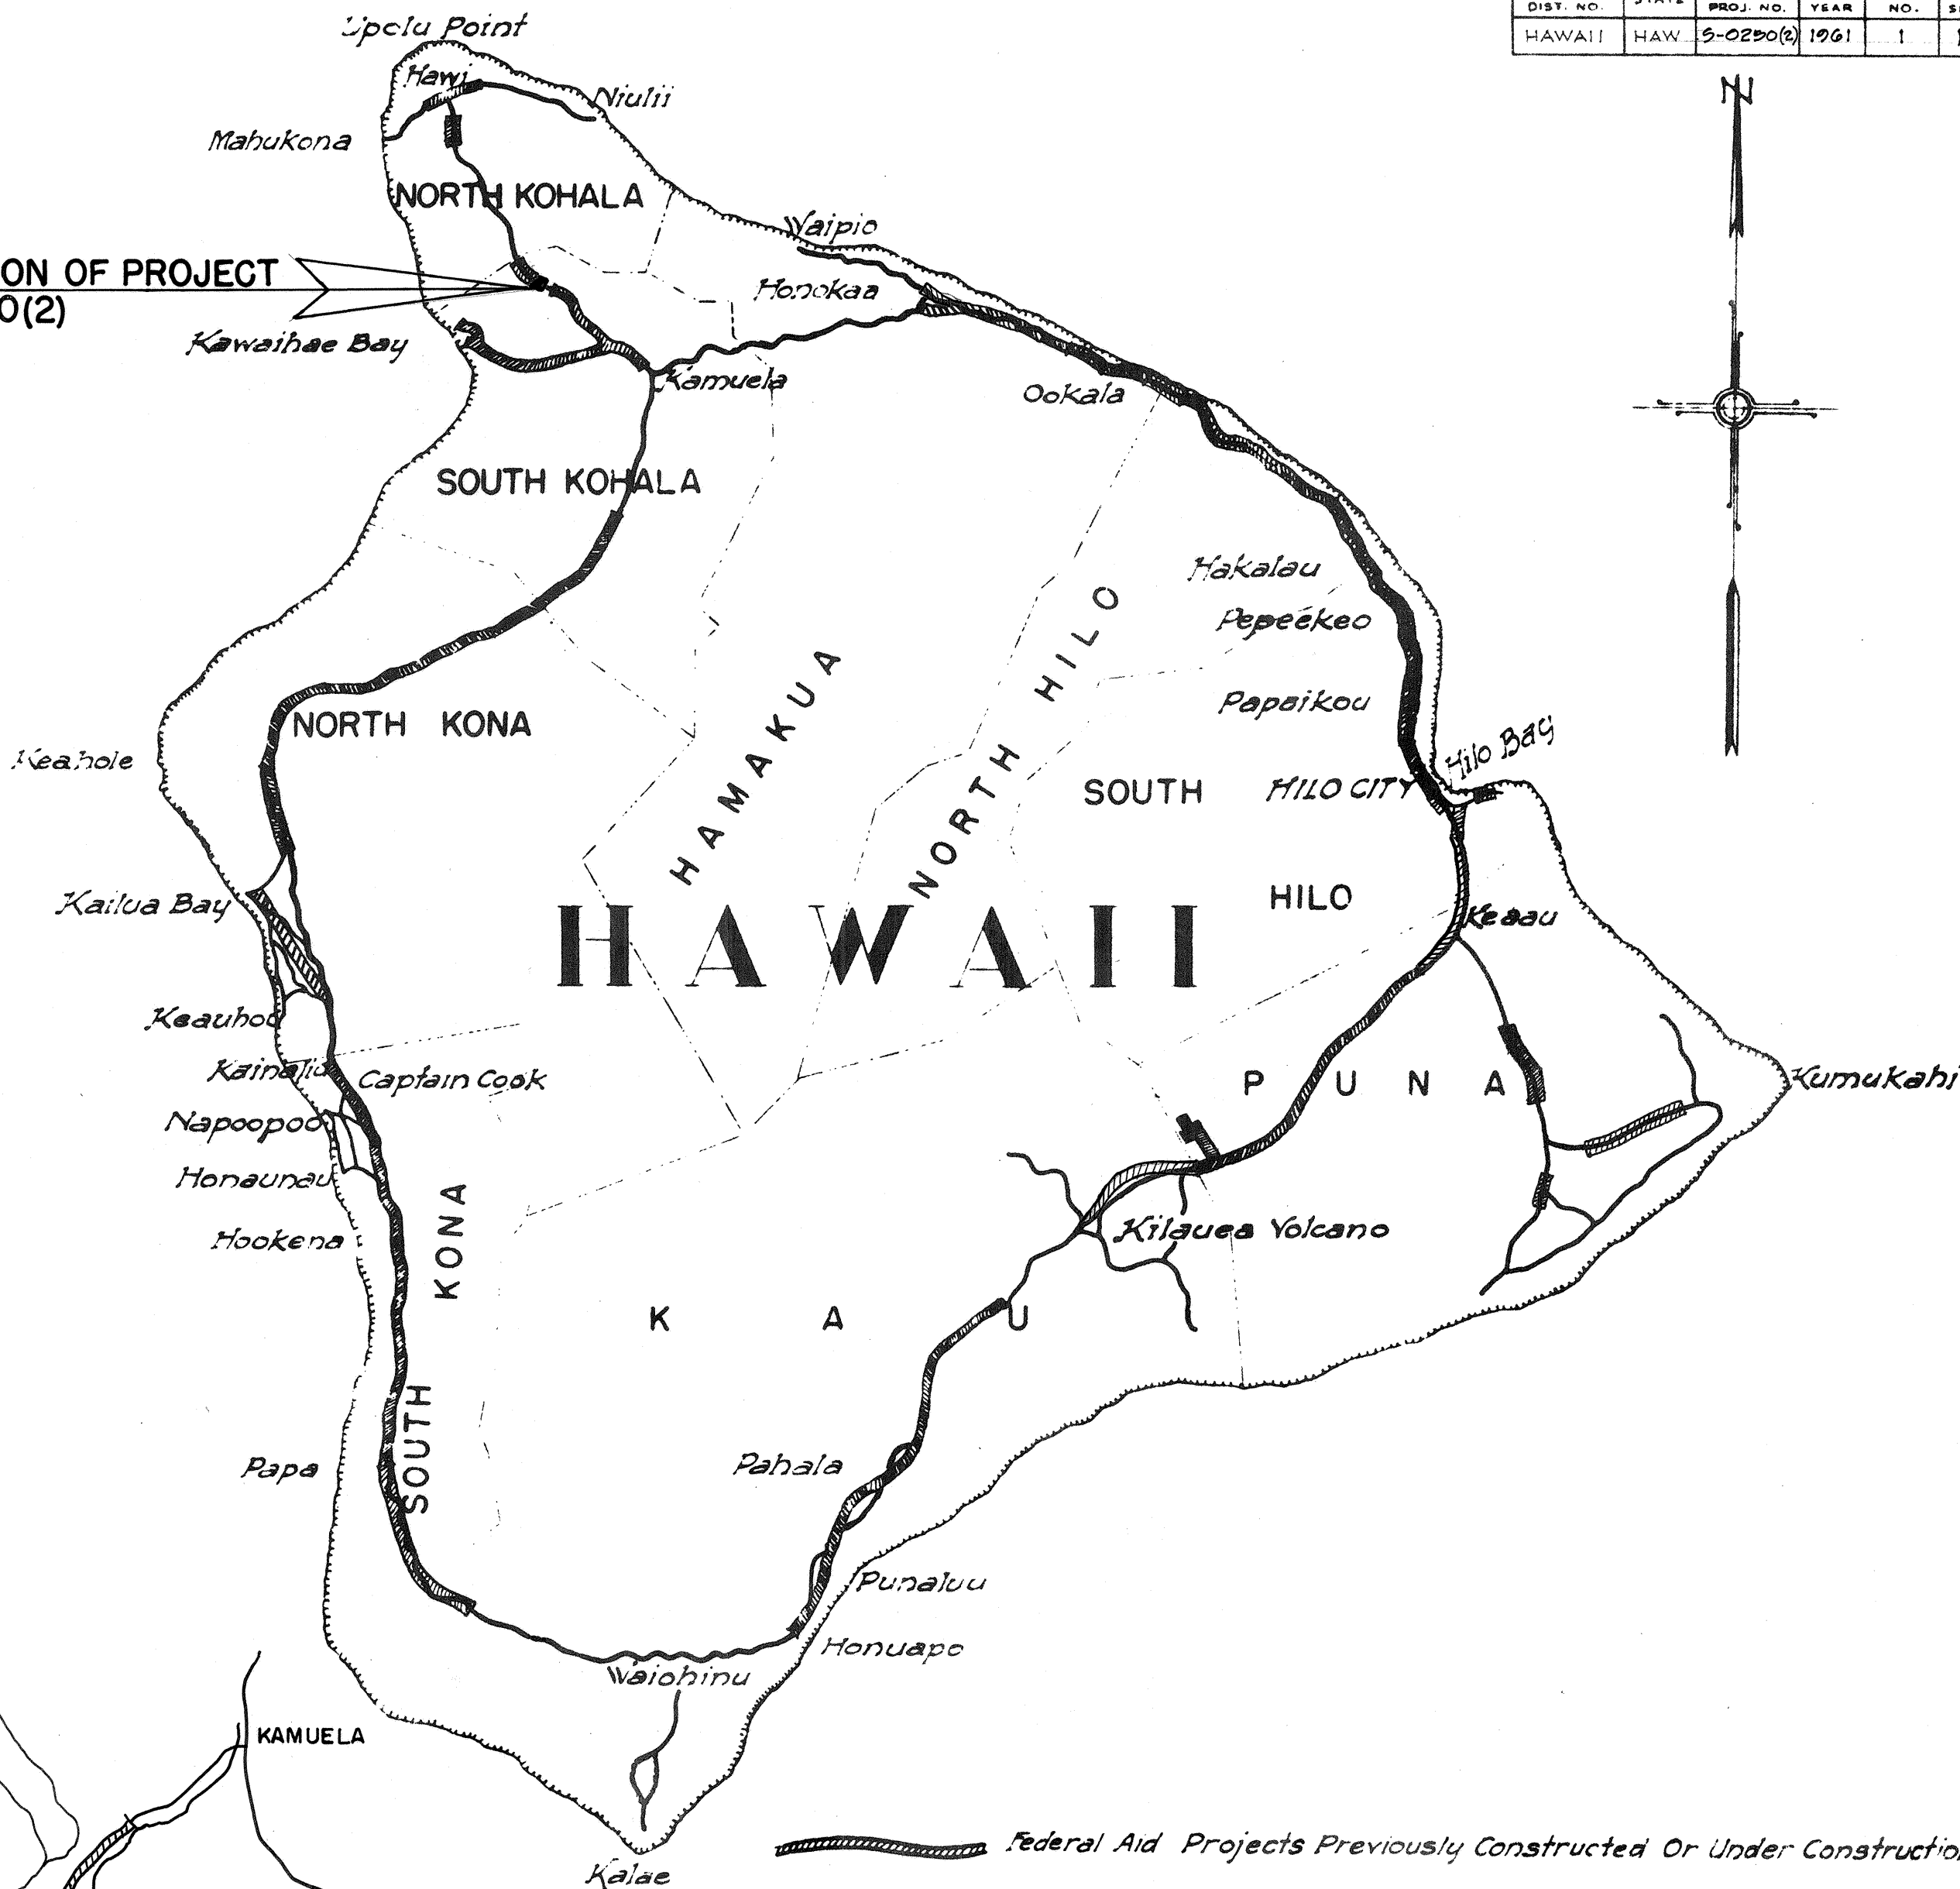

NOTE:

ALL CHANGES MADE DURING CONSTRUCTION

HAVE BEEN NOTED IN RED ON THESE

TRACINGS AND CHECKED BY:

Charles L. Schuster

DISTRICT ENGINEER

11/22/61

DATE

DESIGN CLASSIFICATION

ADT (1958)	300
ADT (1980)	500
DHV	98
D	50%
T	20%
V	50 MPH

APPROVED: *[Signature]* DATE 1/25/61

DIRECTOR OF TRANSPORTATION

DEPARTMENT OF COMMERCE

BUREAU OF PUBLIC ROADS

APPROVED: _____

DIVISION ENGINEER

DATE _____

GROSS AND NET LENGTH OF PROJECT: 0.464 MI.