


FED. ROAD DIST. NO.	STATE	FED. AID PROJ. NO.	FISCAL YEAR	SHEET NO.	TOTAL SHEETS
HAWAII	HAW.	250A-01-86M	1986	3	10

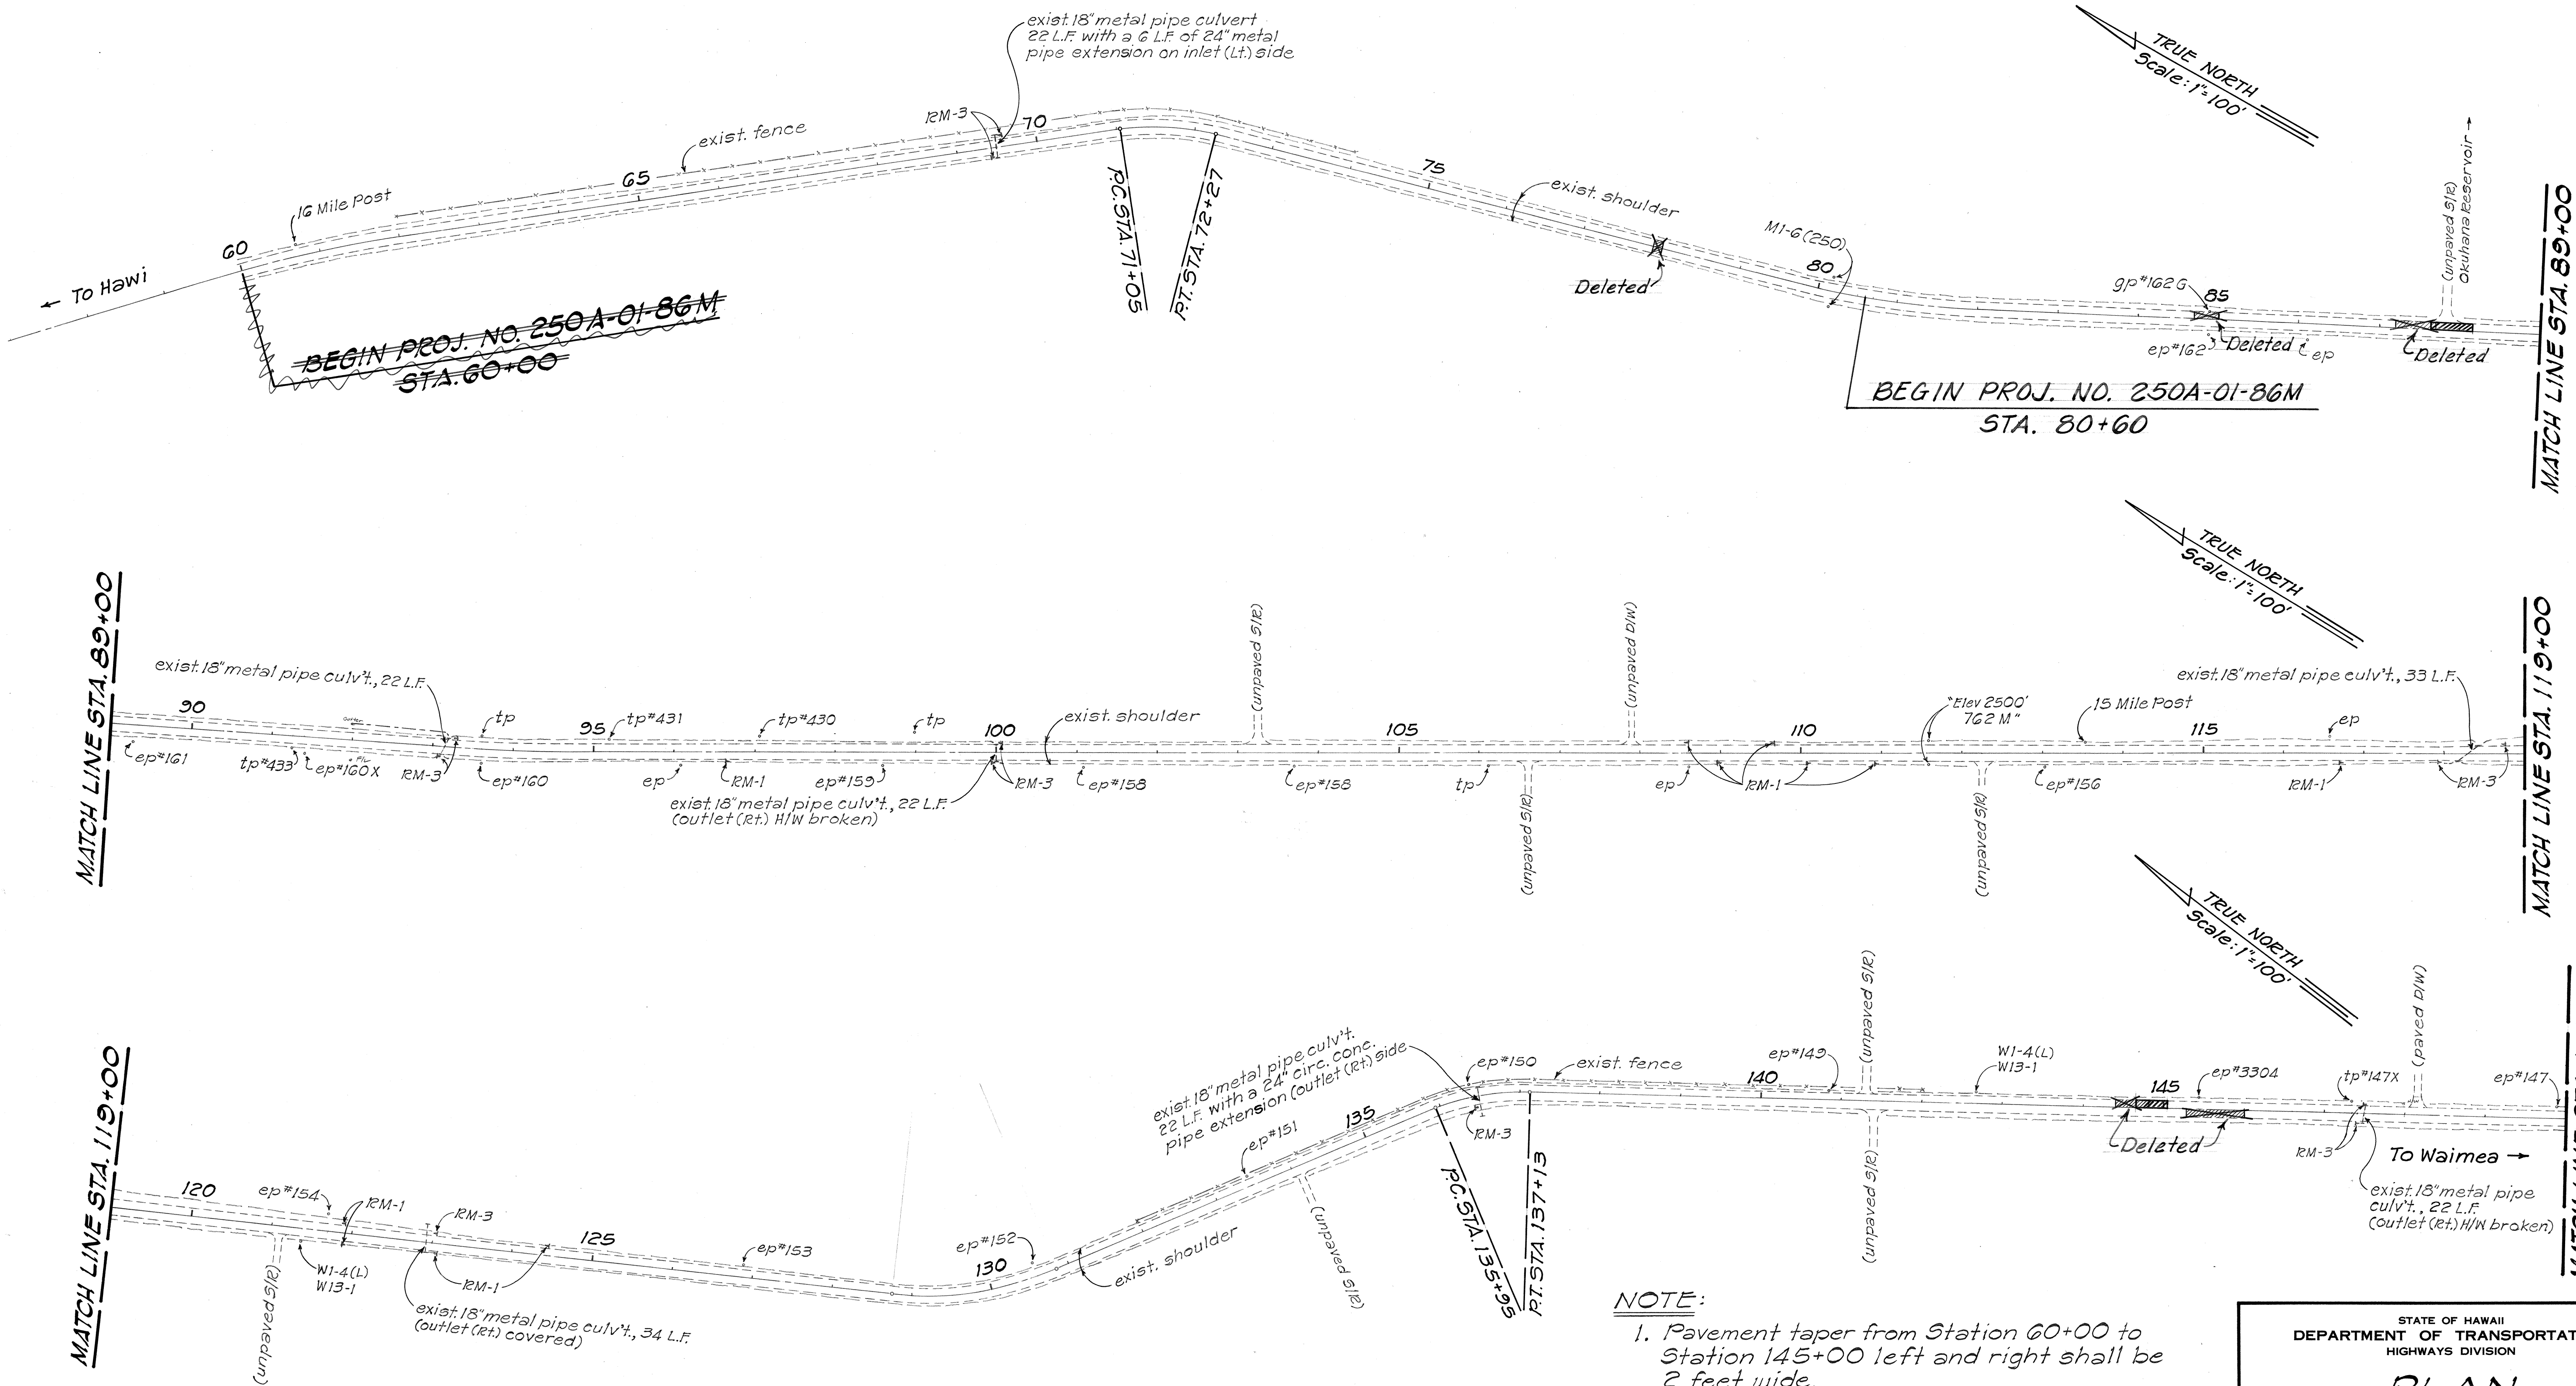

- NOTE:**
- Pavement taper from Station 60+00 to Station 145+00 left and right shall be 2 feet wide.
 - Pavement taper from Station 145+00 to 220+00 left and right shall be 3 feet wide.

LEGEND:

Reconstruction Area
See Sheet 7 for Summary.

STATE OF HAWAII
DEPARTMENT OF TRANSPORTATION
HIGHWAYS DIVISION

PLAN


FOR
KOHALA MT. ROAD, RTE. 250 RESURFACING
KAHUA RANCH TOWARDS HAWI
PROJECT No. 250A-01-86M

Scale: As Noted Date: _____

SHEET NO. 1 OF 2 SHEETS

SURVEY PLOTTED BY	DATE
DRAWN BY	
DESIGNED BY	
QUANTITIES BY	
CHECKED BY	
ORIGINAL PLAN	
NOTE BOOK	
No. 462	

FED. ROAD DIST. NO.	STATE	FED. AID PROJ. NO.	FISCAL YEAR	SHEET NO.	TOTAL SHEETS
HAWAII	HAW.	250A-01-86M	1986	4	10

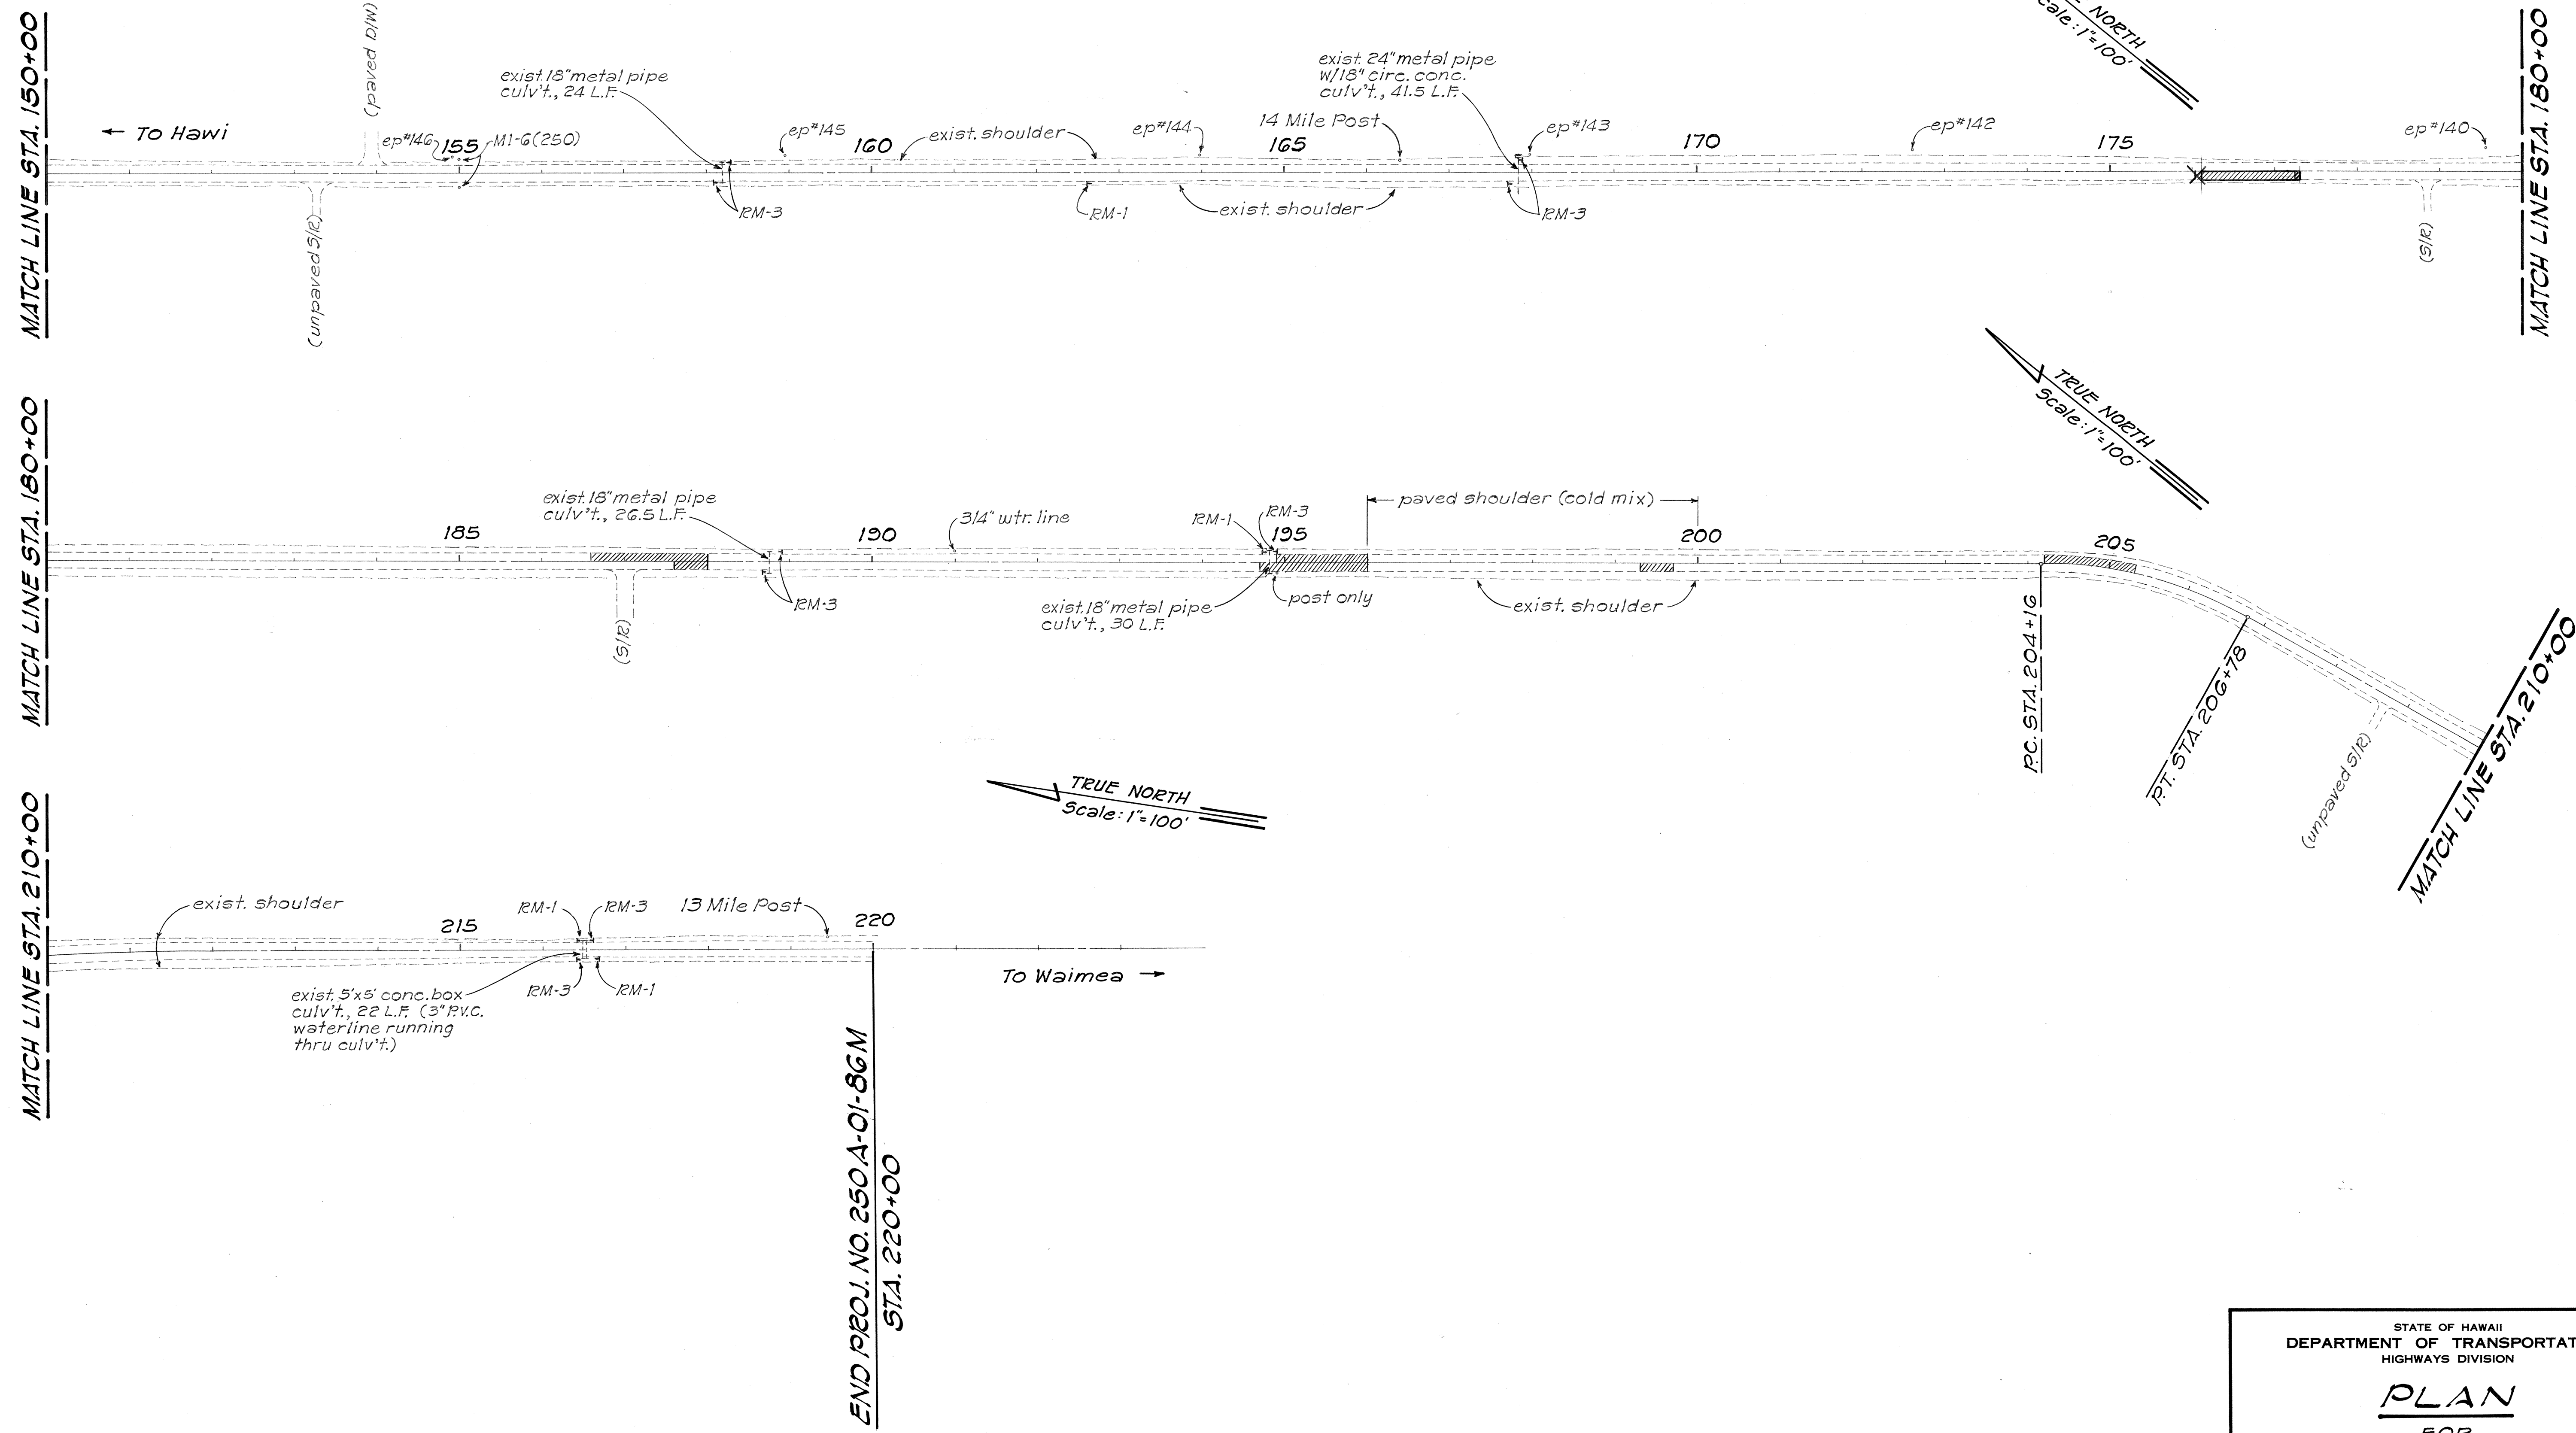

ORIGINAL PLAN	SURVEY PLOTTED BY	DATE
NOTE BOOK	DRAWN BY	
No. 462	DESIGNED BY	
	QUANTITIES BY	
	CHECKED BY	

LEGEND:
 [Hatched Box] Reconstruction Area
 See Sheet 7 for Summary.

STATE OF HAWAII
 DEPARTMENT OF TRANSPORTATION
 HIGHWAYS DIVISION

PLAN
 FOR
 KOHALA MT. ROAD, RTE. 250 RESURFACING
 KAHUA RANCH TOWARDS HAWI
 PROJECT No. 250A-01-86M

Scale: As Noted Date: _____

SHEET NO. 2 OF 2 SHEETS