



FED. ROAD DIST. NO.	STATE	PROJ. NO.	FISCAL YEAR	SHEET NO.	TOTAL SHEETS
HAWAII	HAW.	250A-01-91M	1991	12	12

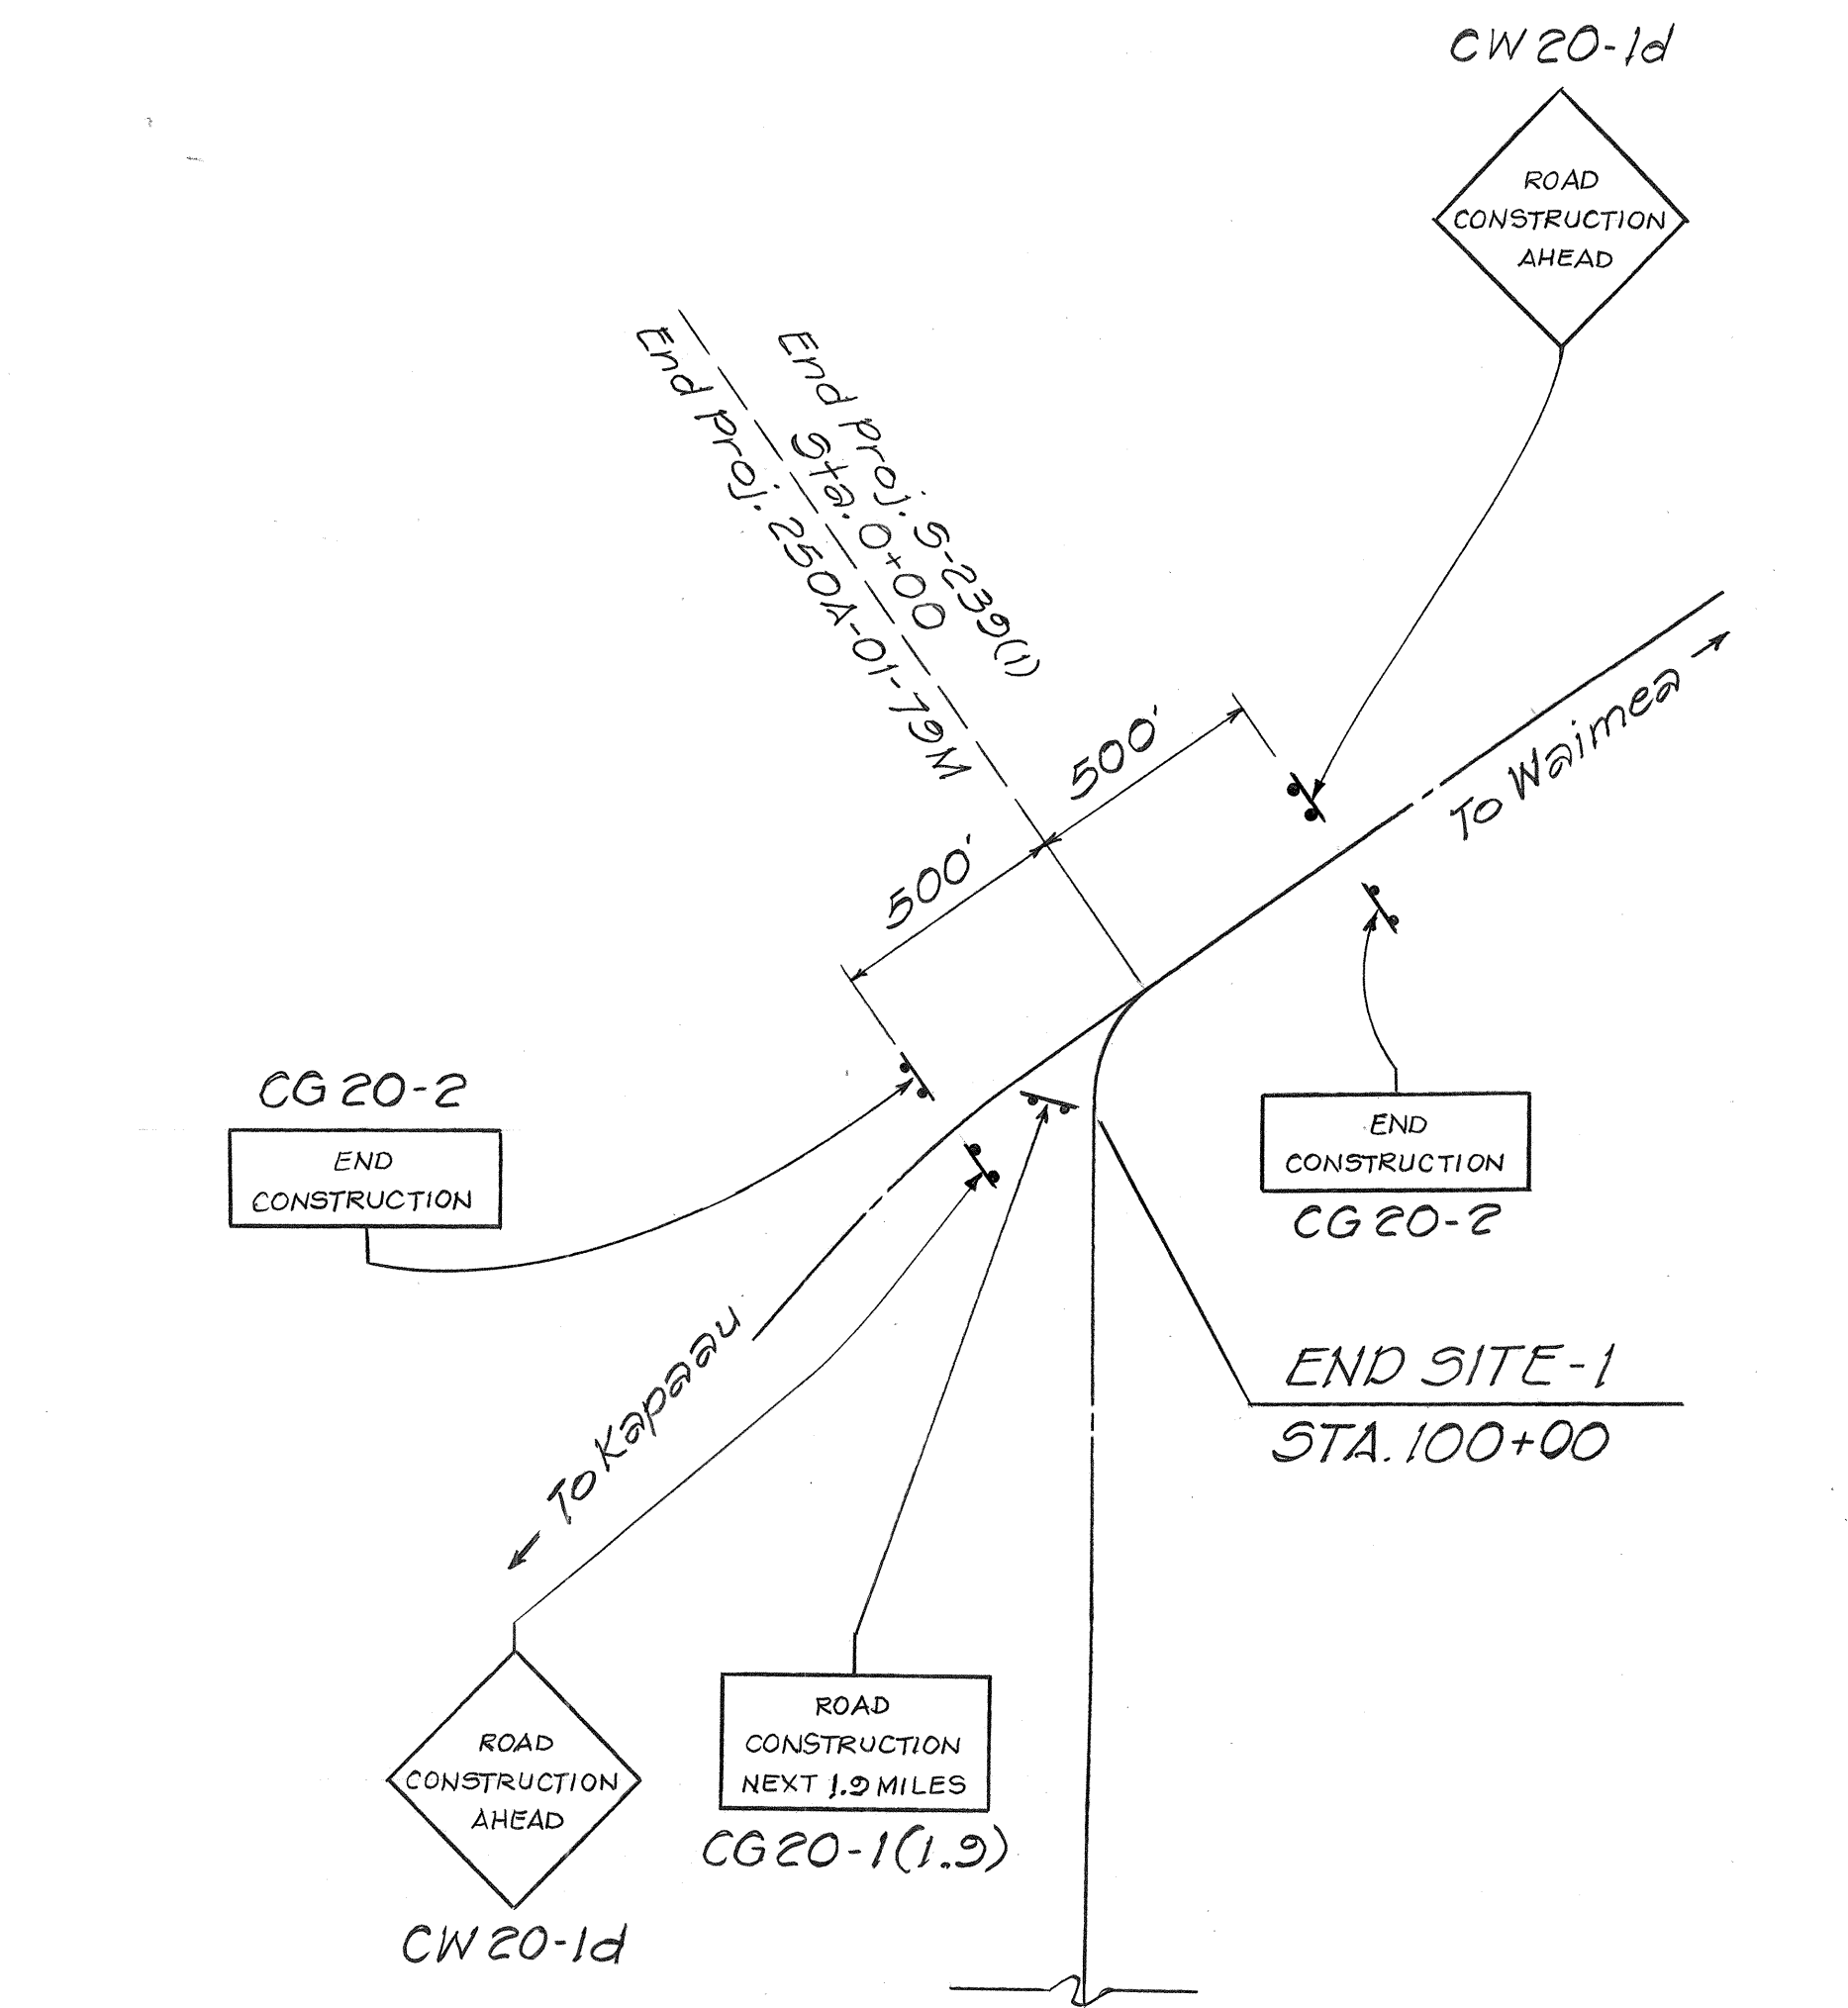


CONSTRUCTION SIGN SCHEDULE				
Exist. PROJ. No.		STATION	ITEM No. 621.7120	
SITE-1	F.A.P. 27-A(1)	334+00 Rt.	CW 20-1d	
		334+00 Lt.	CG 20-2	
	F.A.S. 3-A(1)	344+00 Rt.	CG 20-2	
		344+00 Lt.	CW 20-1d	
	250-A-01-79M	1 + 59.11 Rt.	CG 20-1 (1.9)	
		100+00 Lt.	CG 20-1 (1.9)	
	S-239(1)	- 5+00 Rt.	CW 20-1d	
		- 5+00 Lt.	CG 20-2	
		5+00 Rt.	CG 20-2	
		5+00 Lt.	CW 20-1d	
SITE-2	S-239(1)	352+00 Rt.	CW 20-1d	
		352+00 Lt.	CG 20-2	
		367+00 Rt.	CG 20-1 (3.8)	
	S-0250(1)	569+50 Lt.	CG 20-1 (3.8)	
		574+50 Rt.	CG 20-2	
		574+50 Lt.	CW 20-1d	
TOTAL			16 Each	


SCHEDULE FOR RECONSTRUCTION OF SHOULDER AREAS				
SITE#	STATION	LENGTH	WIDTH	AREA (S.Y.)
SITE-1	12+50-100+70 Rt.	8,820	3	2,940
	30+50-100+70 Lt.	7,020	3	2,340
SITE-2	366+50-405+00 Lt. & Rt.	7,700	3	2,567
	413+00-440+00 Lt. & Rt.	5,400	3	1,800
	493+00 - 532+10 490+71.5 - 533+37.37 Lt. & Rt.	8,277	3	2,759
TOTAL				12,406
				7,126

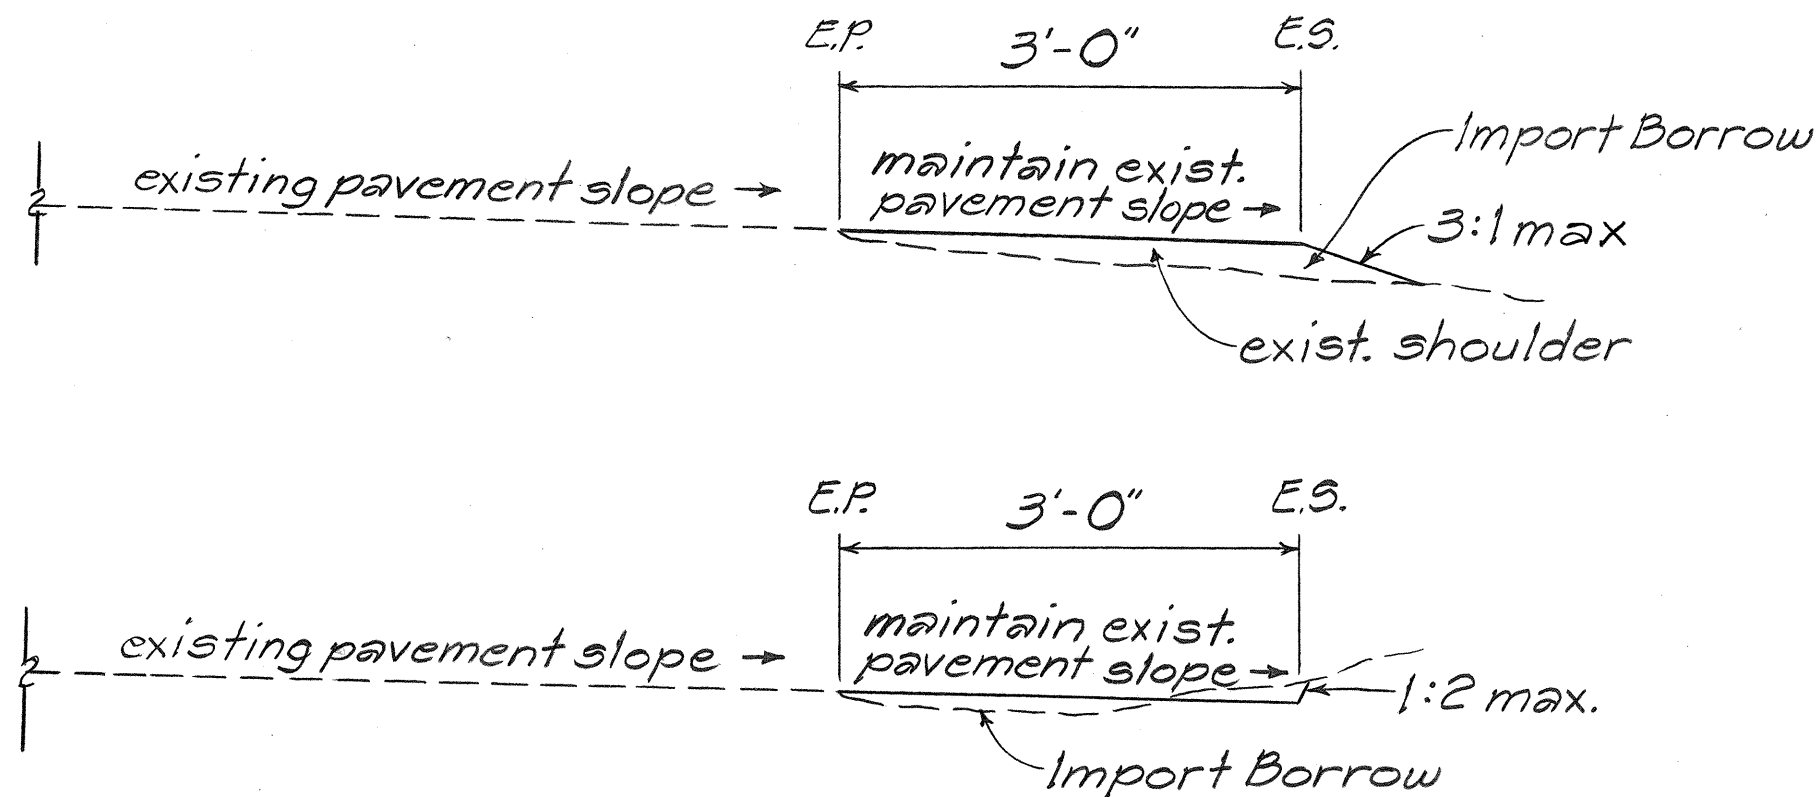

RECONSTRUCTION OF SHOULDER AREAS
Not To Scale

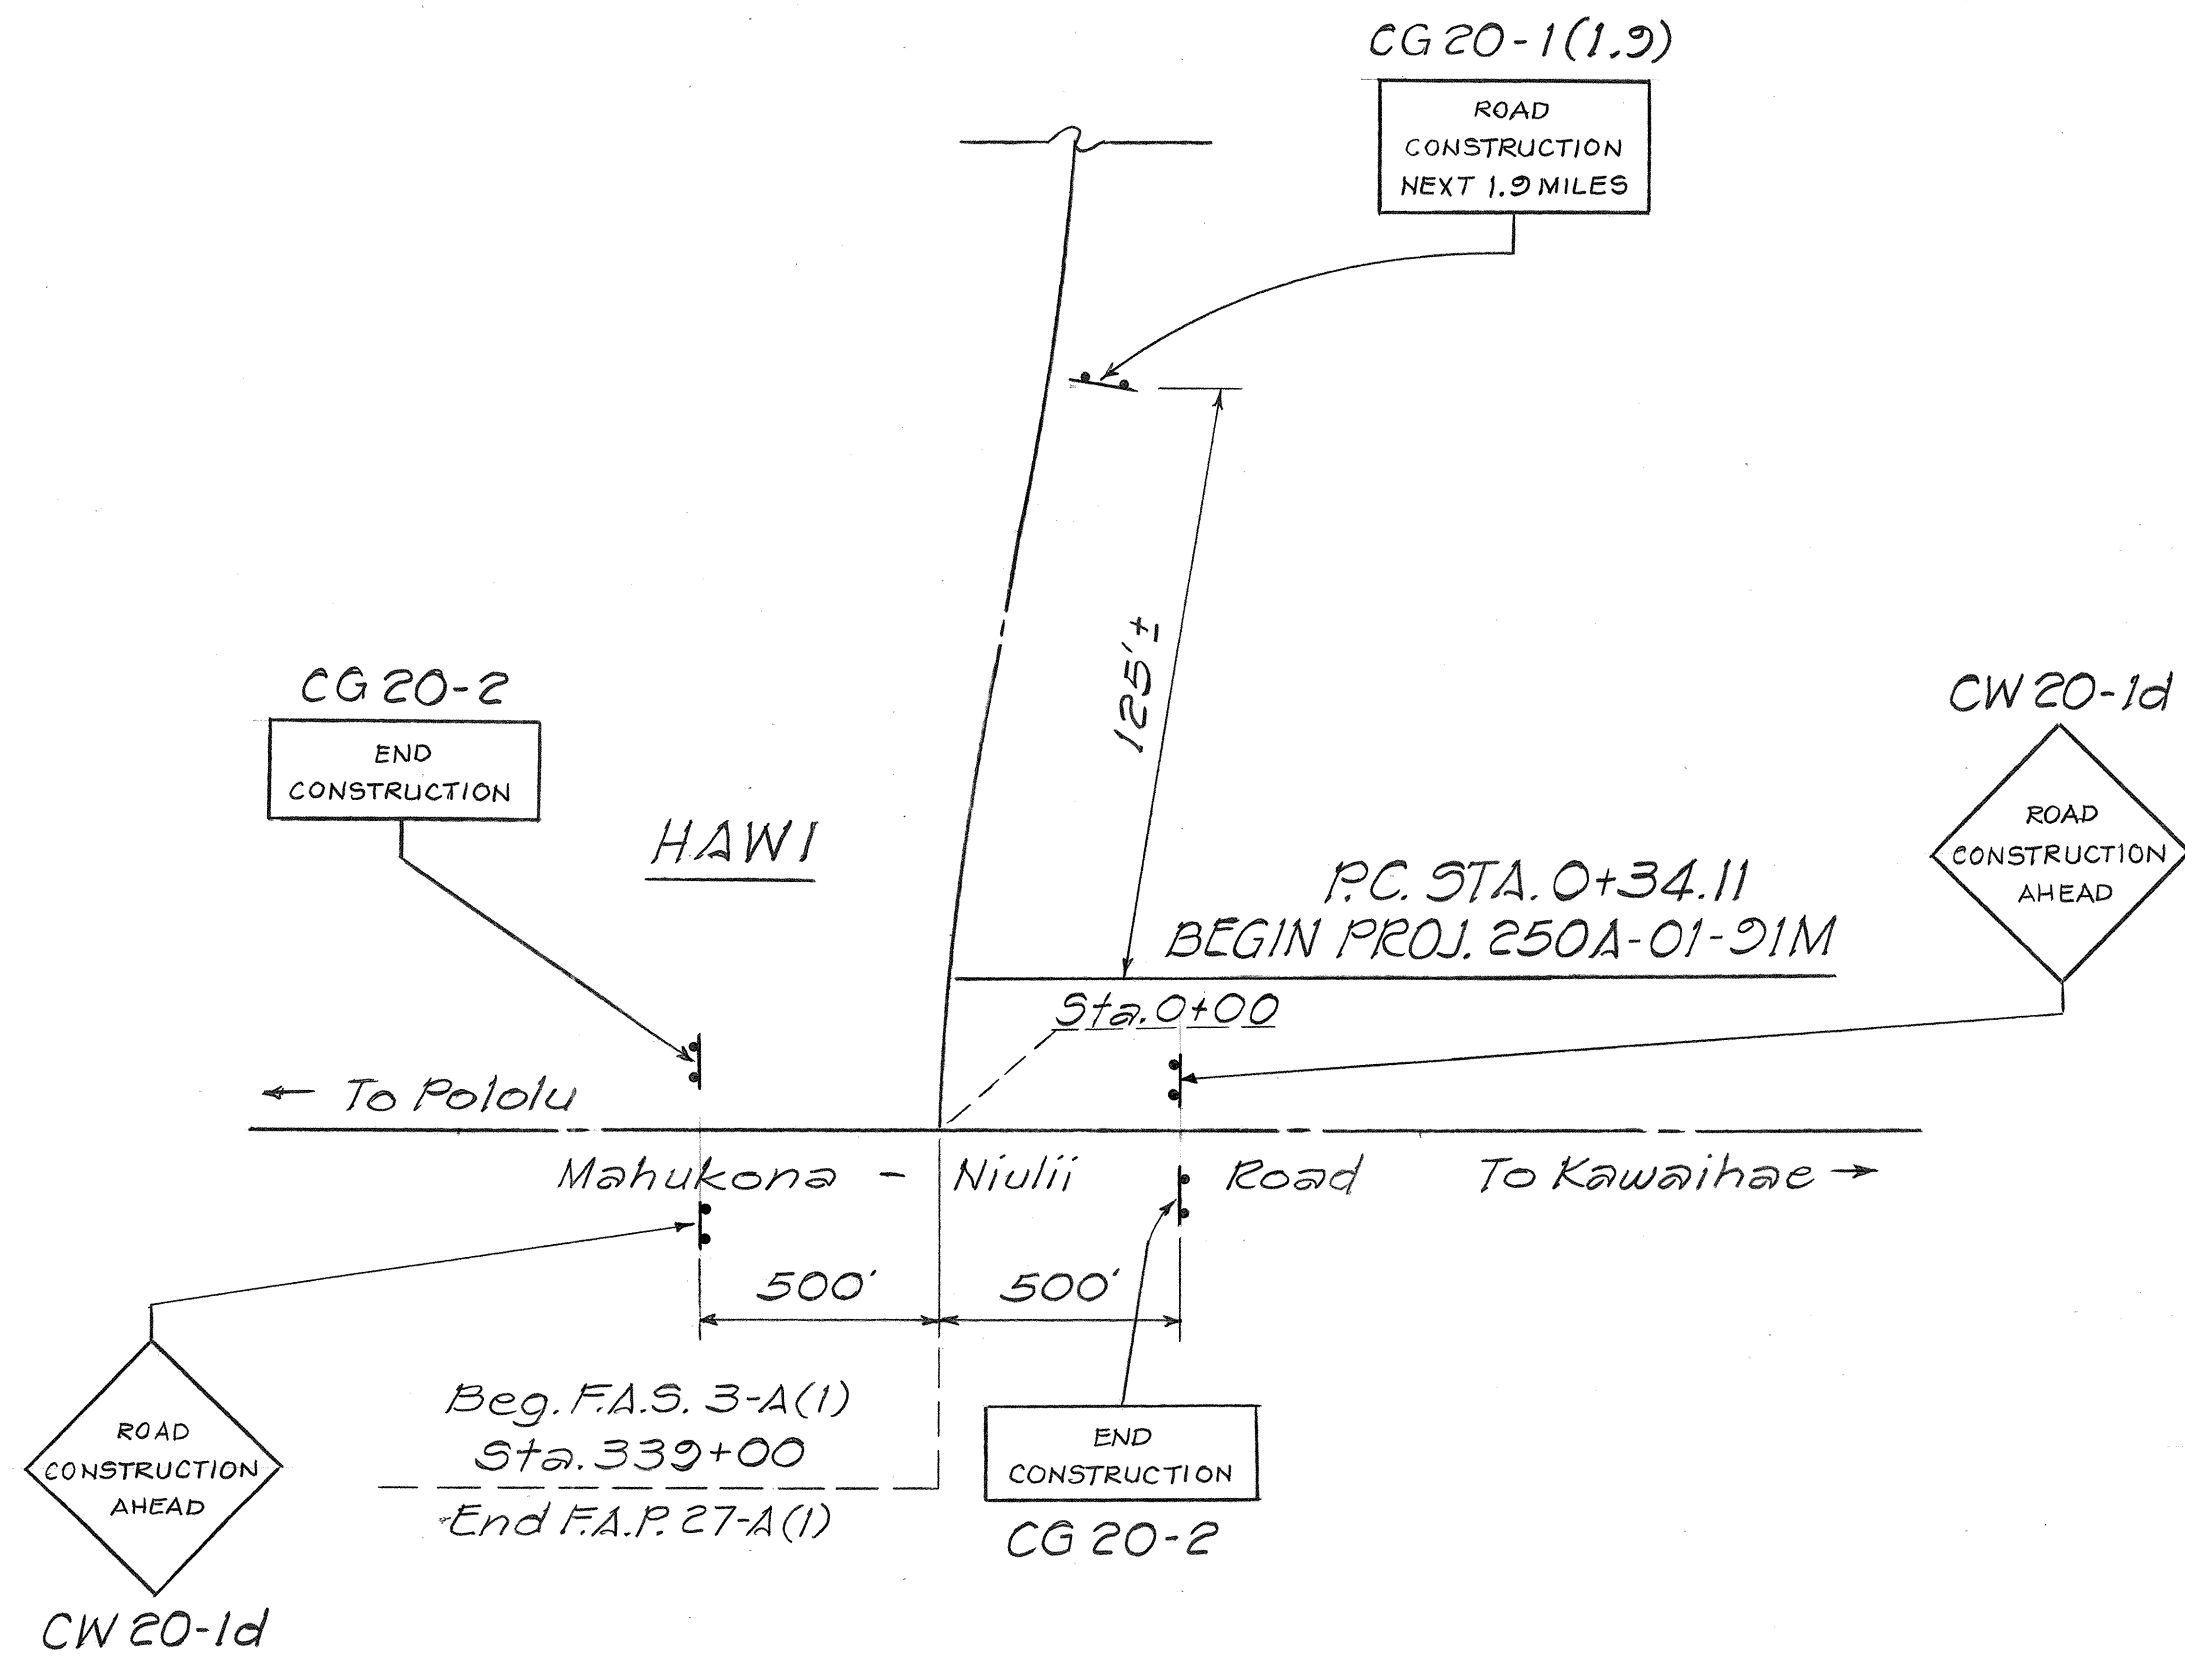

SITE-1 SIGN DETAIL
Not To Scale

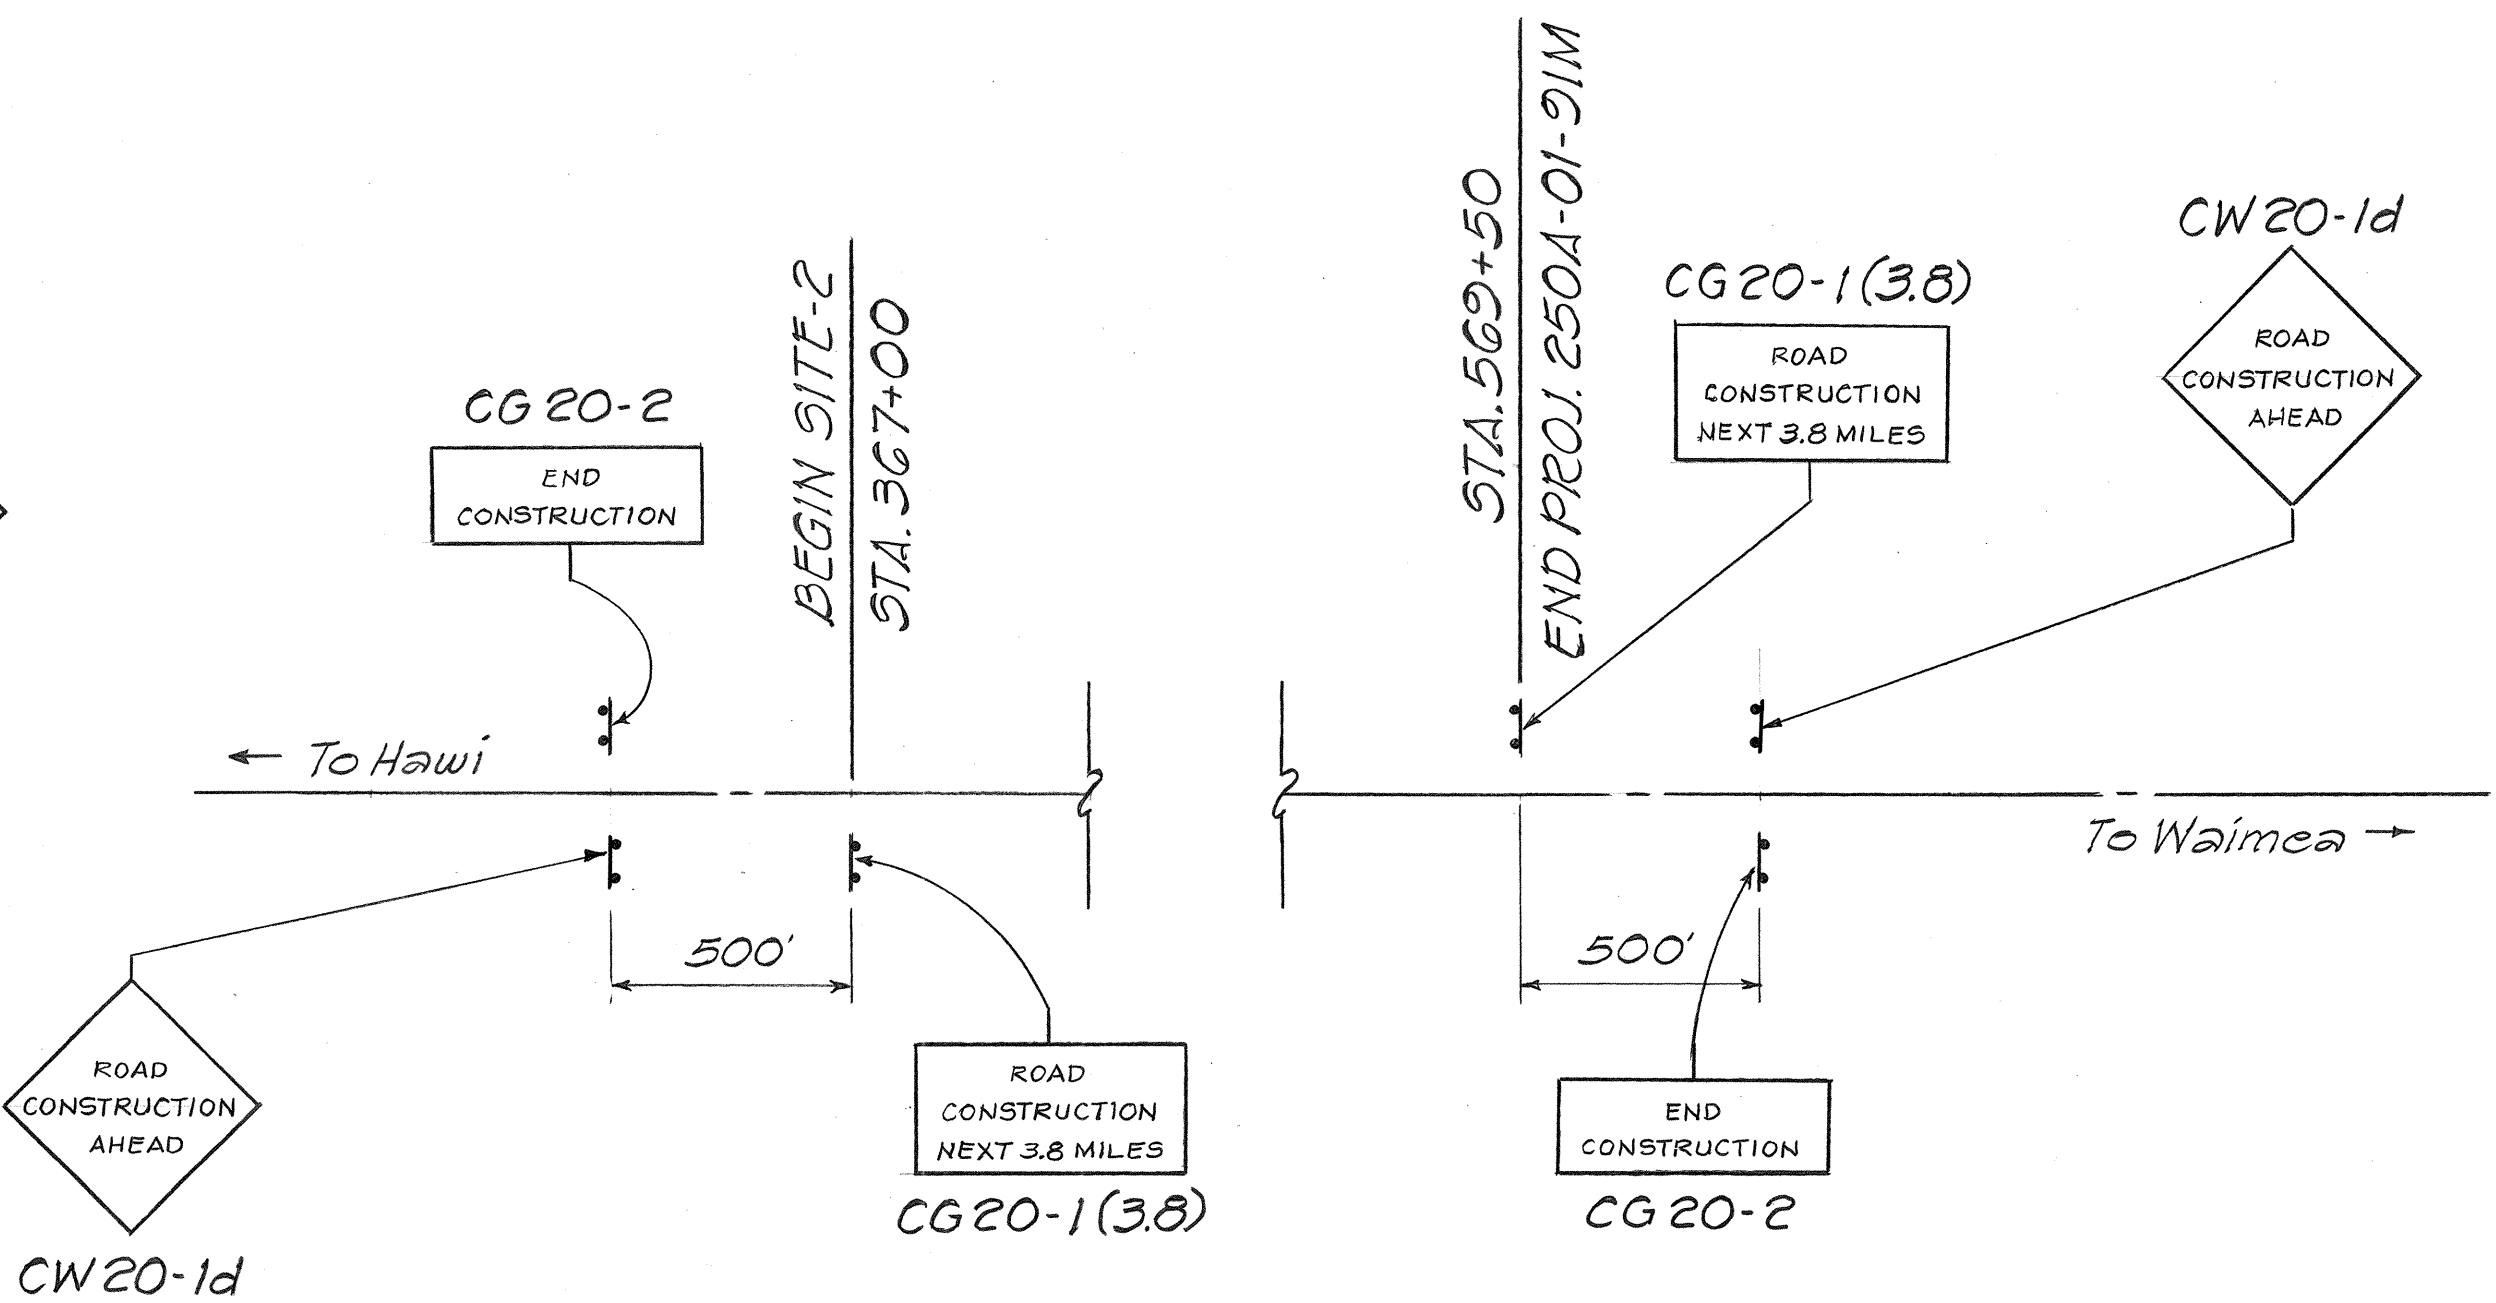

SITE-2 SIGN DETAIL
Not To Scale

STATE OF HAWAII

DEPARTMENT OF TRANSPORTATION

HIGHWAYS DIVISION

CONSTRUCTION SIGN DETAIL

AND SCHEDULE

SITE-1 & SITE-2

KOHALA MTN. RD. RESURF.

PROJ. No. 250A-01-91M

Scale: As Noted Date: Dec. 1990

SHEET NO. 1 OF 1 SHEETS

SURVEY PLOTTED BY	DATE
DRAWN BY	
DESIGNED BY	
CHECKED BY	
ORIGINAL PLAN	
NOTE BOOK	
No.	