

FED. ROAD DIST. NO.	STATE	PROJ. NO.	FISCAL YEAR	SHEET NO.	TOTAL SHEETS
HAWAII	HAW.	250A-01-91M	1991	11	12

PAVEMENT MARKER SCHEDULE - SITE-1

[illegible]

PAVEMENT MARKER SCHEDULE - SITE-2

STATION		DESCRIPTION	TYPE			
FROM	TO		CL	DL	HL	J
366+00	373+25	NO PASSING - L PASSING - R		19	17	68
373+25	375+15	NO PASSING - BOTH SIDES		10		
375+15	383+35	PASSING - L NO PASSING - R		21	20	80
383+35	394+00	NO PASSING - BOTH SIDES		54		
394+00	399+10	NO PASSING - L PASSING - R		13	12	48
399+10	400+00	NO PASSING - BOTH SIDES		5		
400+00	409+25	PASSING - L NO PASSING - R		23	22	88
409+25	<u>432+00</u> 437+56.82	NO PASSING - BOTH SIDES		114		
<u>432+00</u> 437+56.82	455+00	NO PASSING - BOTH SIDES		87		
455+00	464+10	NO PASSING - L PASSING - R		23	22	88
464+10	466+50	NO PASSING - BOTH SIDES		7		
466+50	473+20	PASSING - L NO PASSING - R		17	16	64
473+20	474+90	NO PASSING - BOTH SIDES		9		
474+90	480+00	NO PASSING - L PASSING - R		13	12	48
480+00	484+90	NO PASSING - BOTH SIDES		25		
484+90	490+00	PASSING - L NO PASSING - R		13	12	48
490+00	<u>493+00</u> 490+71.50	NO PASSING - BOTH SIDES		16		
<u>493+00</u> 490+71.50	<u>498+67</u> 497+67	NO PASSING - BOTH SIDES		40		
<u>498+67</u> 497+67	<u>532+10</u> 533+37.37	NO PASSING - BOTH SIDES		172		
<u>532+10</u> 533+37.37	546+75	NO PASSING - BOTH SIDES		67		
546+75	557+00	NO PASSING - L PASSING - R		27	26	104
557+00	567+20	PASSING - L NO PASSING - R		27	26	104
567+20	570+00	NO PASSING - BOTH SIDES		15		
364+00	365+40	" " - "	14	7		
365+40	366+00	NO PASSING L - PASSING R	4	2	1	4
		E.R STRIPING	1,018			
TOTALS			1,036 1,018	826 817	185 184	744 740

CENTERLINE & REFERENCE SURVEY MONUMENT SCHEDULE

Exist. Proj.No.	STATION	*RECONSTRUCT (Item No. 613.0100)	ADJUST EXIST. (Item No. 613.0110)	EOFFSET (FT.)	EXIST. DEPTH (FT.)
SITE - 2	439+06.82		1	0"	0"
	C.S. 445+24.44		1	0"	0"
	P.T. 446+24.44		1	0"	0"
	P.O.T. 455+97.97		1	0"	0"
	P.O.T. 468+50		1	0.1' Lt.	0"
	P.O.T. 475+00		1	0.1' Lt.	0"
	T.S. 487+34.17		1	0.2' Lt.	0"
	S.C.S. 489+84.17		1	0.6' Lt.	0"
	S.T. 492+34.17		1	0.1' Lt.	0"
	P.C. 533+37.37		1	0"	0"
	R.T. 536+68.20		1	0"	0"
	R/W P.C. 537+57.18		1	0"	0"
	R/W P.T. 549+78.61		1	0"	0"
	R/W P.C. 565+27.93		1	0.3' Rt.	0"
S.C. 566+60.70	1		0"	0.1'	
C.S. 568+54.03	1		1.0' Rt.	0.1'	
TOTALS		2 Each	14 Each		


* Remove existing Φ monument. Refer to Standard Plan D-06 for Details of New Φ Monument Installation.

STRIPING NOTES:

1. Pavement markings and striping shall be Thermoplastic Extrusion or Preformed Pavement Marking Tape.
2. Pavement areas to receive pavement markings and striping shall be broomed off prior to installation.
3. Layout of pavement markers, striping and markings shall be done by the Contractor and approved by the Engineer prior to installation.
4. Removal of striping and markings shall be by mechanical means, such as sandblasting, grinding of pavement surface, or other method as approved by the Engineer. Burning-off or painting over will not be allowed.
5. All references to Type "C", Type "D" and Type "H" markers in the Standard Plans shall mean Type "CL", Type "DL" and Type "HL" markers.
6. Contractor's attention is directed to the "Typical Edge of Pavement Markings" detail. Type "CL" pavement markers @ 40'-0"oc shall be installed along the white edge of pavement stripe.
7. Raised pavement markers shall not be installed within crosswalks.
8. All construction signs shall be reflectorized with high intensity reflective sheeting.
9. Final locations of all signs shall be approved by the Engineer prior to any installation work.

SIDE ROADS PAVEMENT MARKER SCHEDULE

STATION		TYPE	
		CL	DL
SITE-1			
	37+96 LT.	4	2
SITE-2	494+75 RT.	4	2
TOTALS		8	4

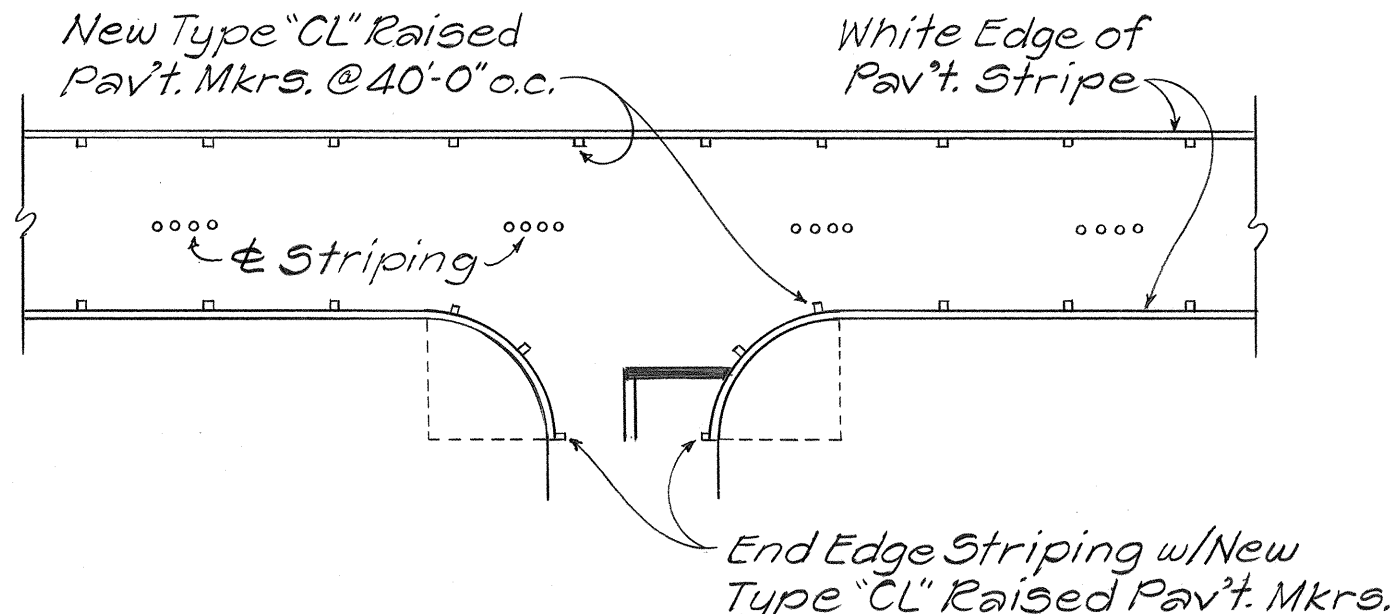

TYPICAL EDGE OF PAVEMENT MARKINGS
Not To Scale

ORIGINAL PLAN	SURVEY PLOTTED BY _____ DATE _____
NOTE BOOK	DRAWN BY _____ *
	TRACED BY _____ *
	DESIGNED BY _____ *
	QUANTITIES BY _____ *
No. _____	CHECKED BY _____ *

AS-BUILT

1