.	INDEX TO DRAWINGS
SHEET NO.	DESCRIPTION
1	TITLE SHEET
2	STANDARD PLANS SUMMARY
3	TYPICAL SECTIONS & DETAILS
4-5	SITE-I, ROADWAY & STRIPING PLAN
6-9	SITE-2, ROADWAY & STRIPING PLAN
10	GENERAL NOTES, DETAILS & MISC. SCHEDULES
11	SITE-1&2 PAVEMENT MARKER AND SURVEY MONUMENT SCHEDULE
12	SITE-182 CONSTRUCTION SIGN DETAIL AND SCHEDULE

STATE OF HAWAII


DEPARTMENT OF TRANSPORTATION


HIGHWAYS DIVISION HONOLULU, HAWAII

"AS-BUILT"

PLANS FOR

KOHALA MOUNTAIN ROAD RESURFACING PROJECT NO. 250A-01-9IM DISTRICT OF NORTH KOHALA ISLAND OF HAWAII

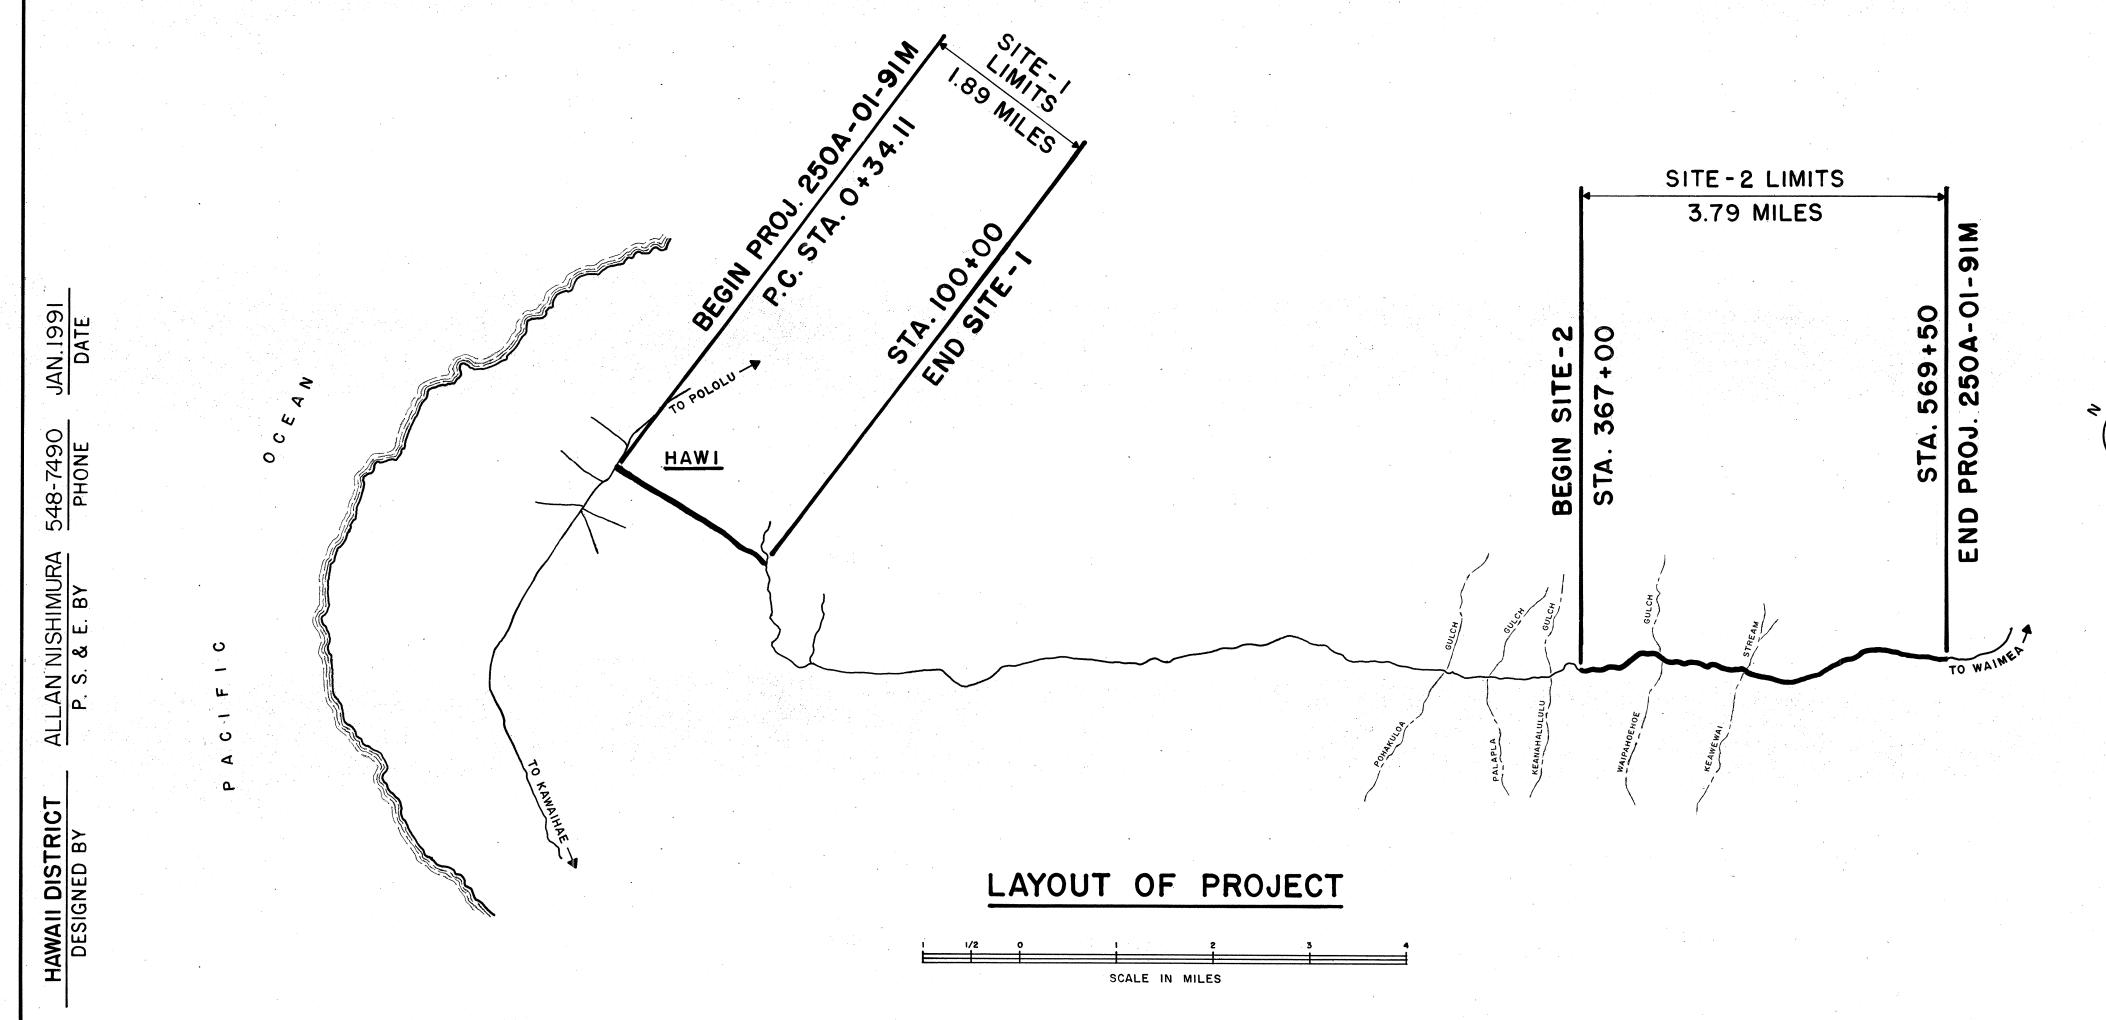

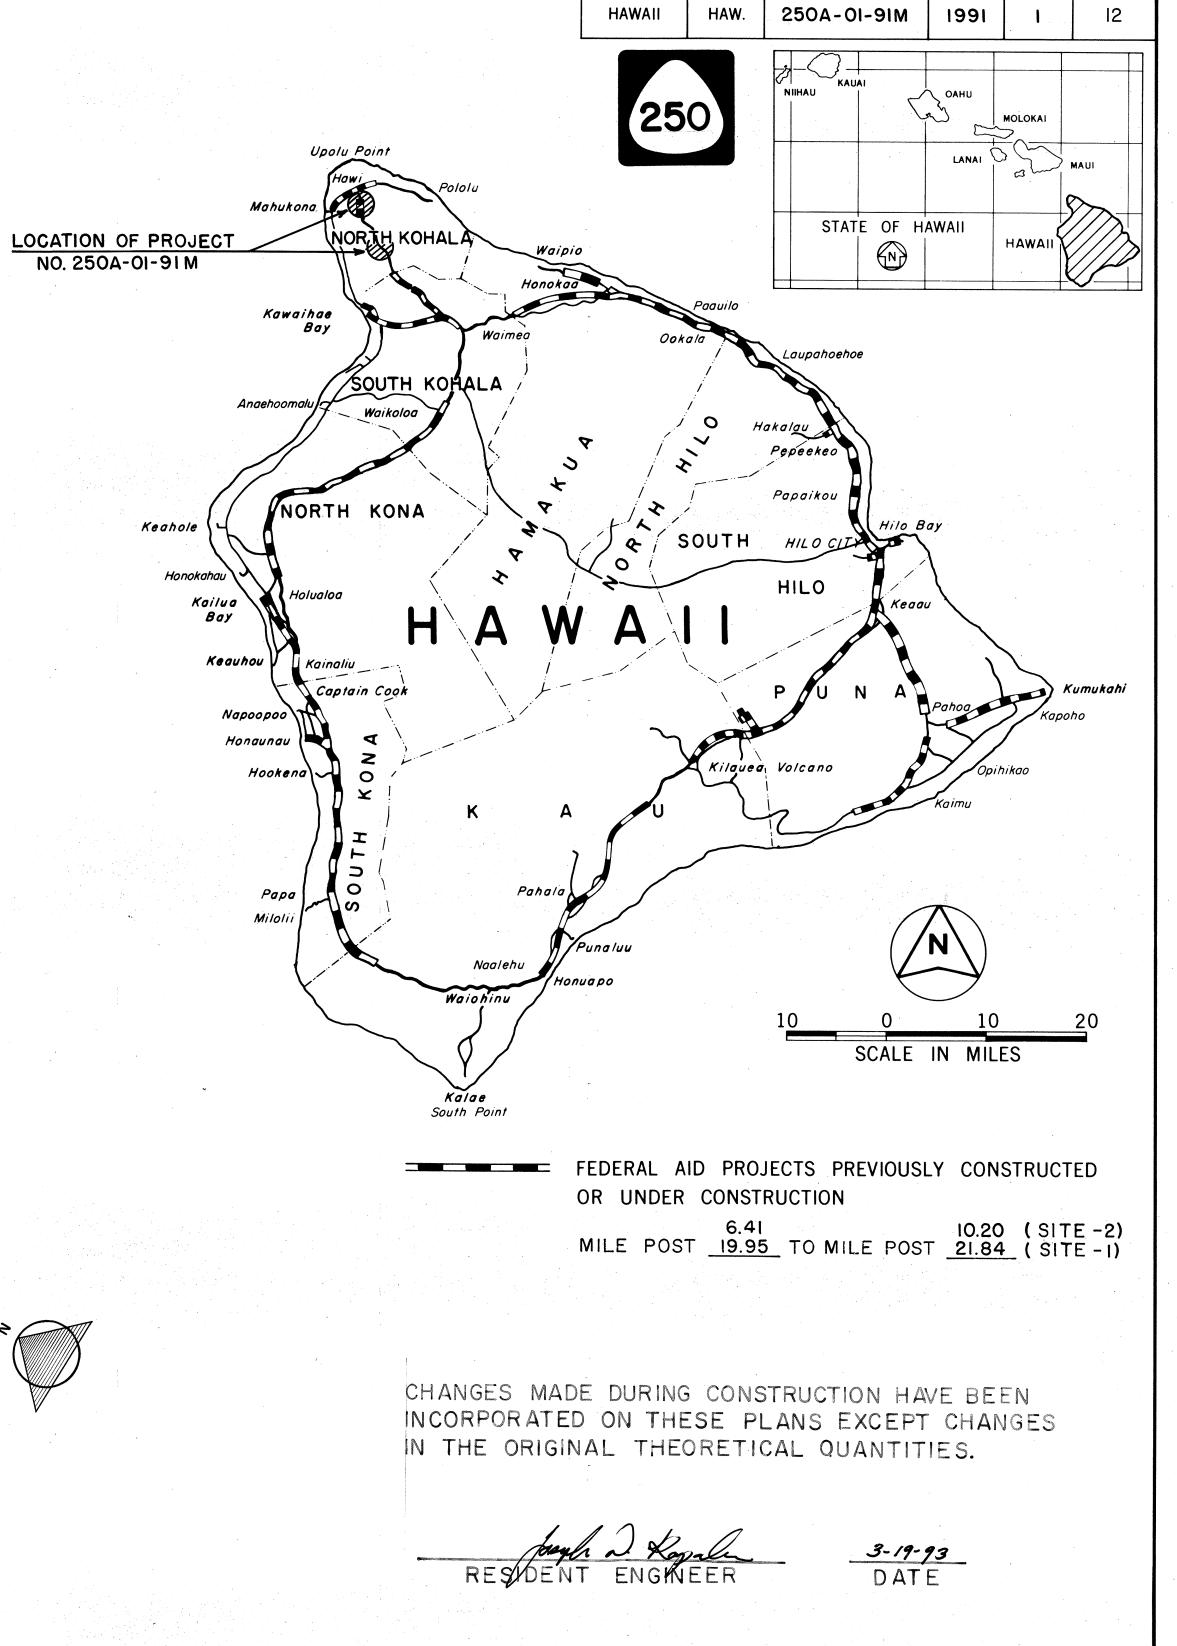

FED. ROAD DIST. NO. SHEET TOTAL NO. SHEETS

FISCAL YEAR

PROJ. NO.

DEPARTMENT OF TRANSPORTATION
STATE OF HAWAII

APPROVED:

Line 2/4/9/
DIR. OF TRANSPORTATION DATE