




FED. ROAD DIST. NO.	STATE	PROJ. NO.	FISCAL YEAR	SHEET NO.	TOTAL SHEETS
HAWAII	HAW.	250A-01-01M	1991	3	12

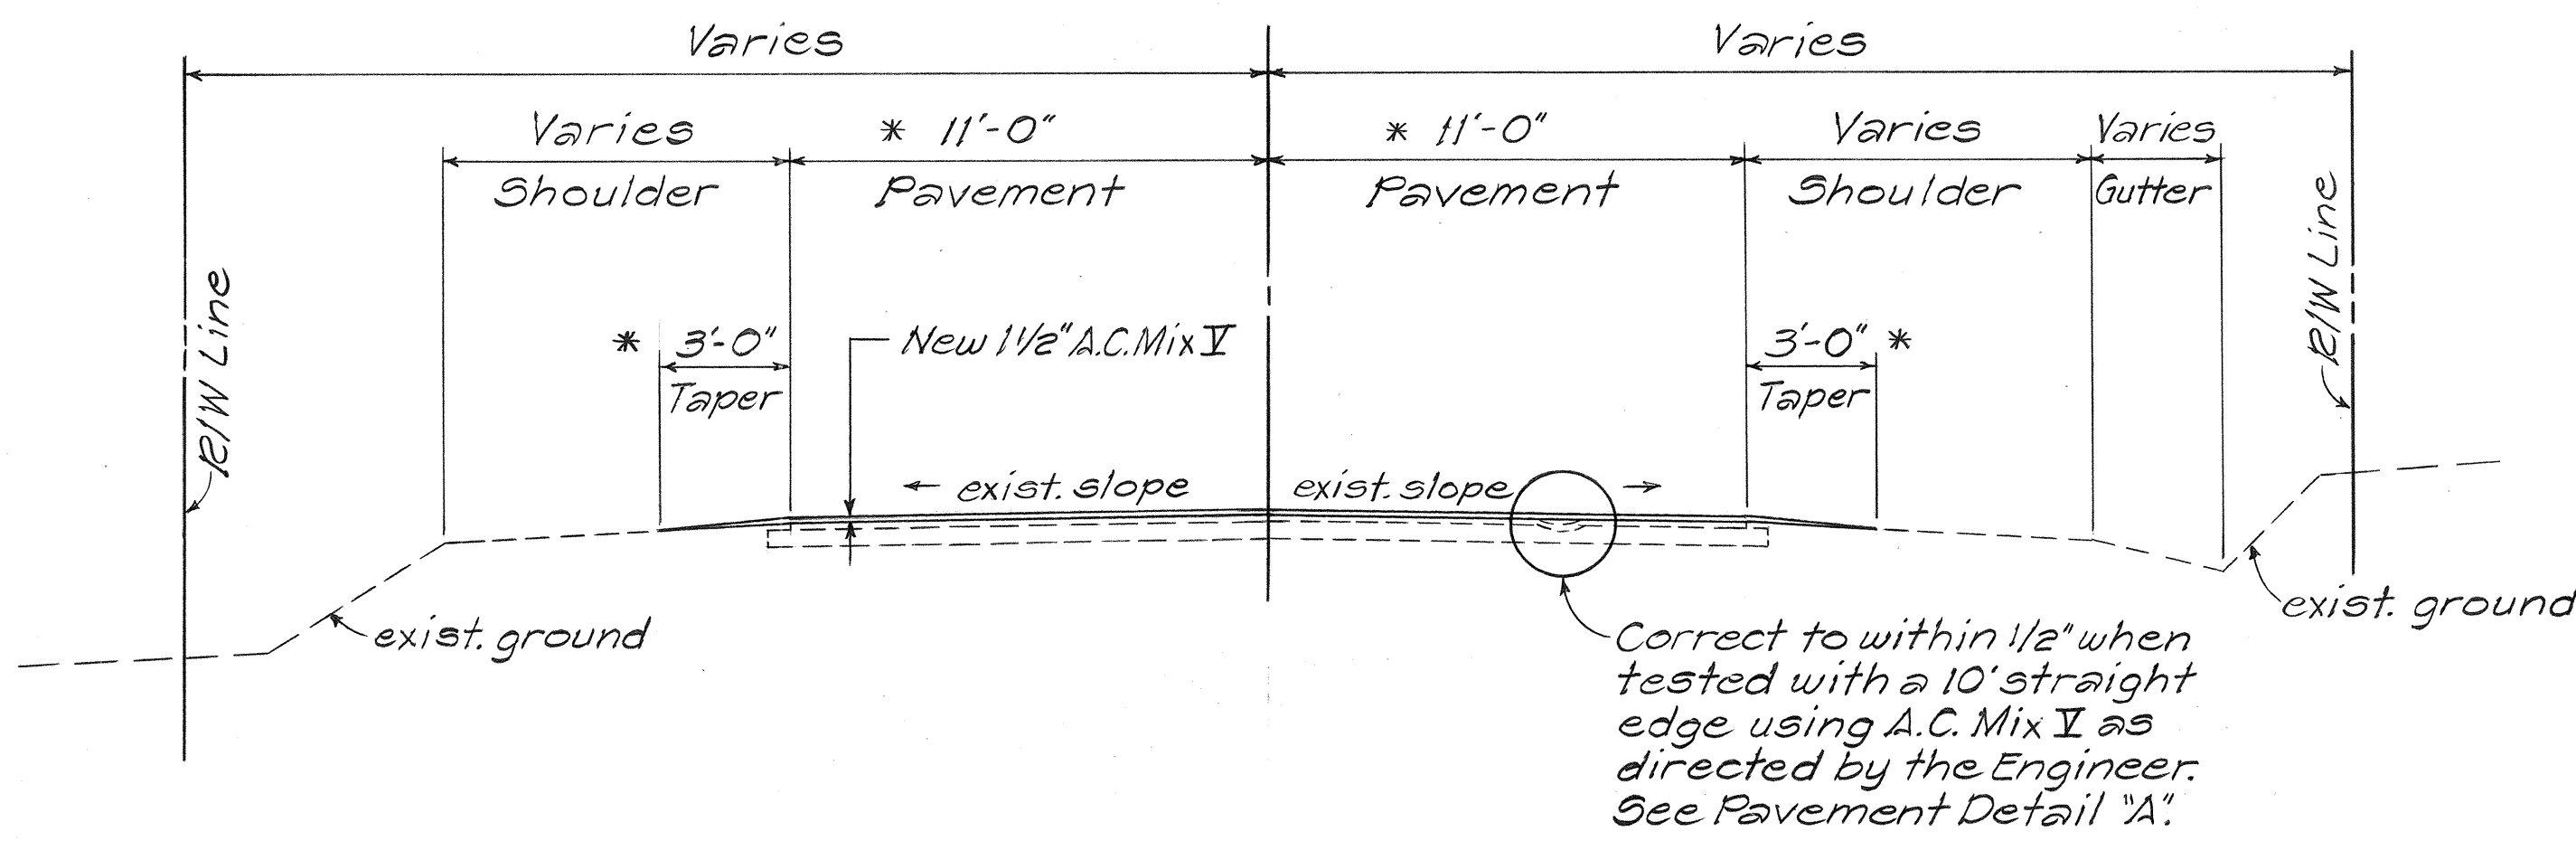

TYPICAL TANGENT SECTION
Not To Scale

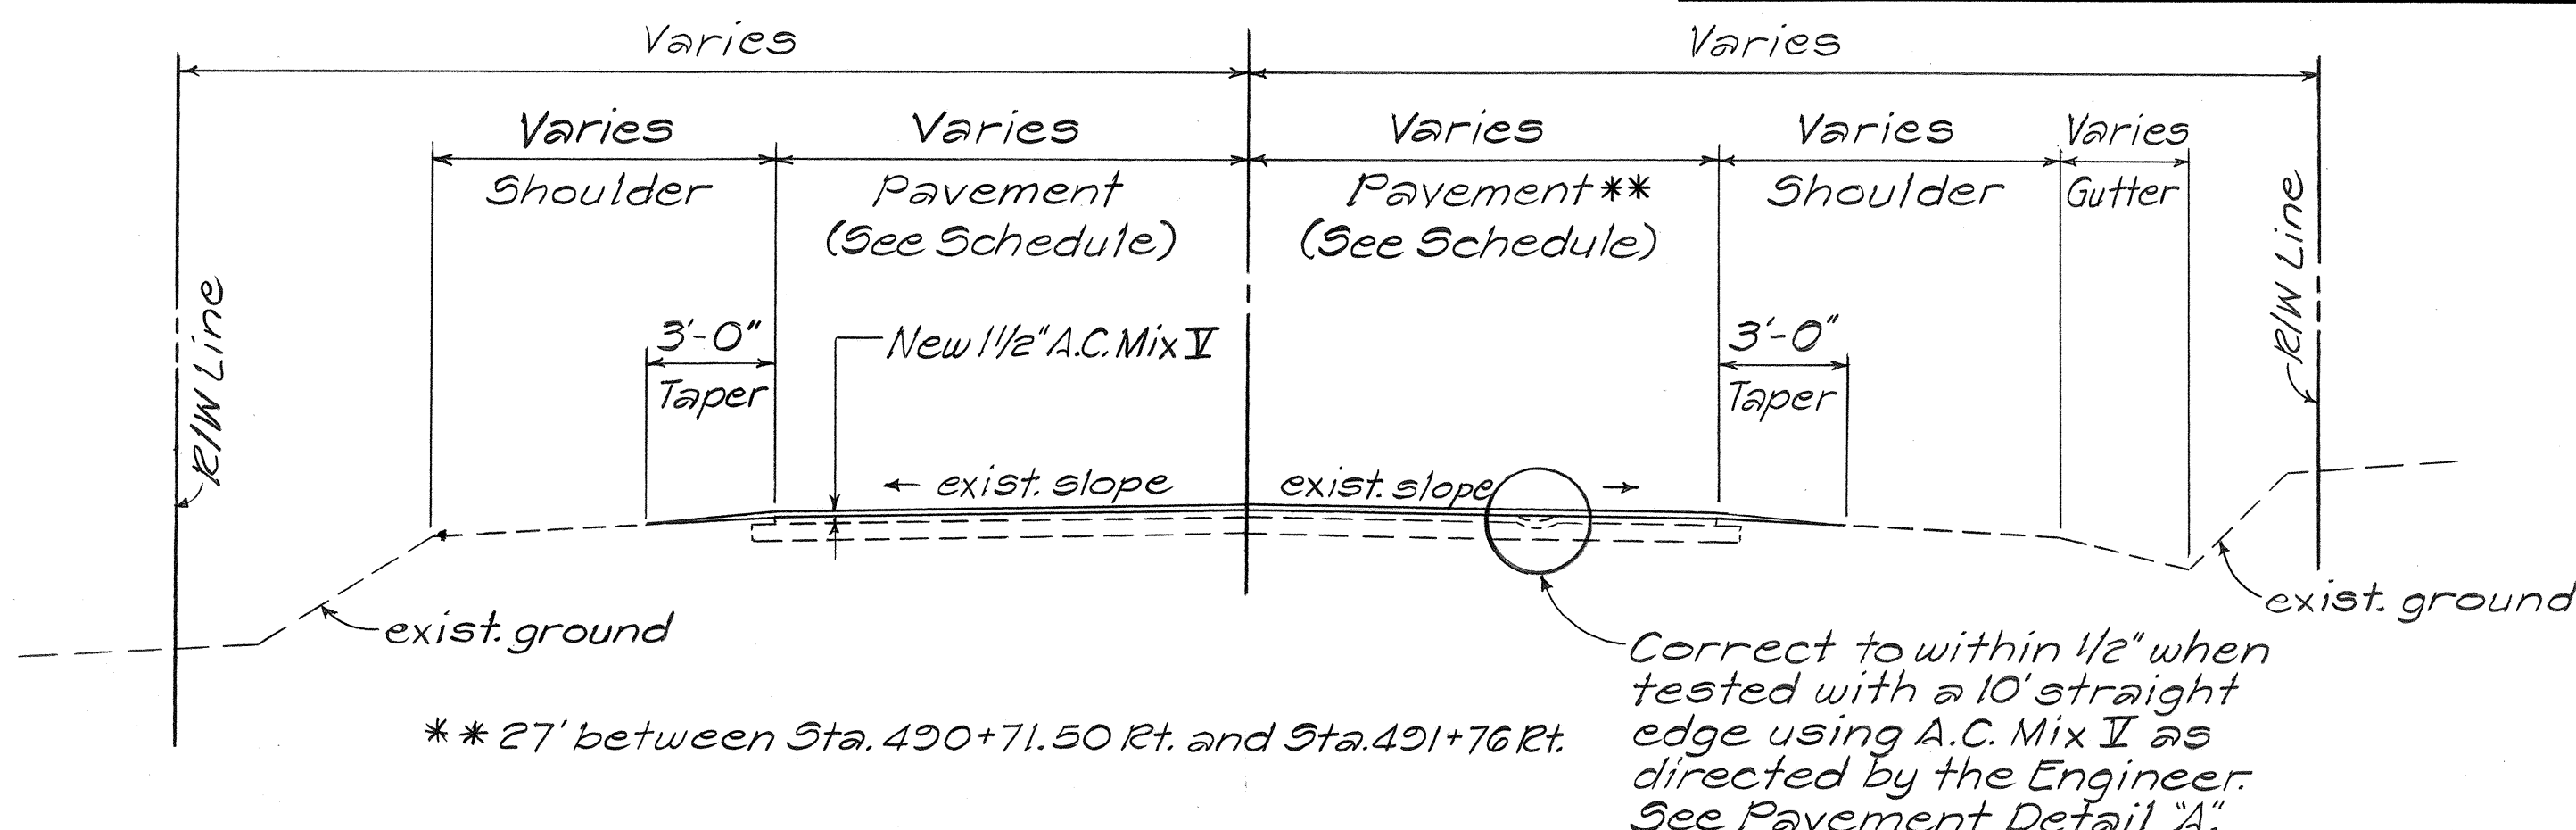


TYPICAL TANGENT SECTION
Not To Scale

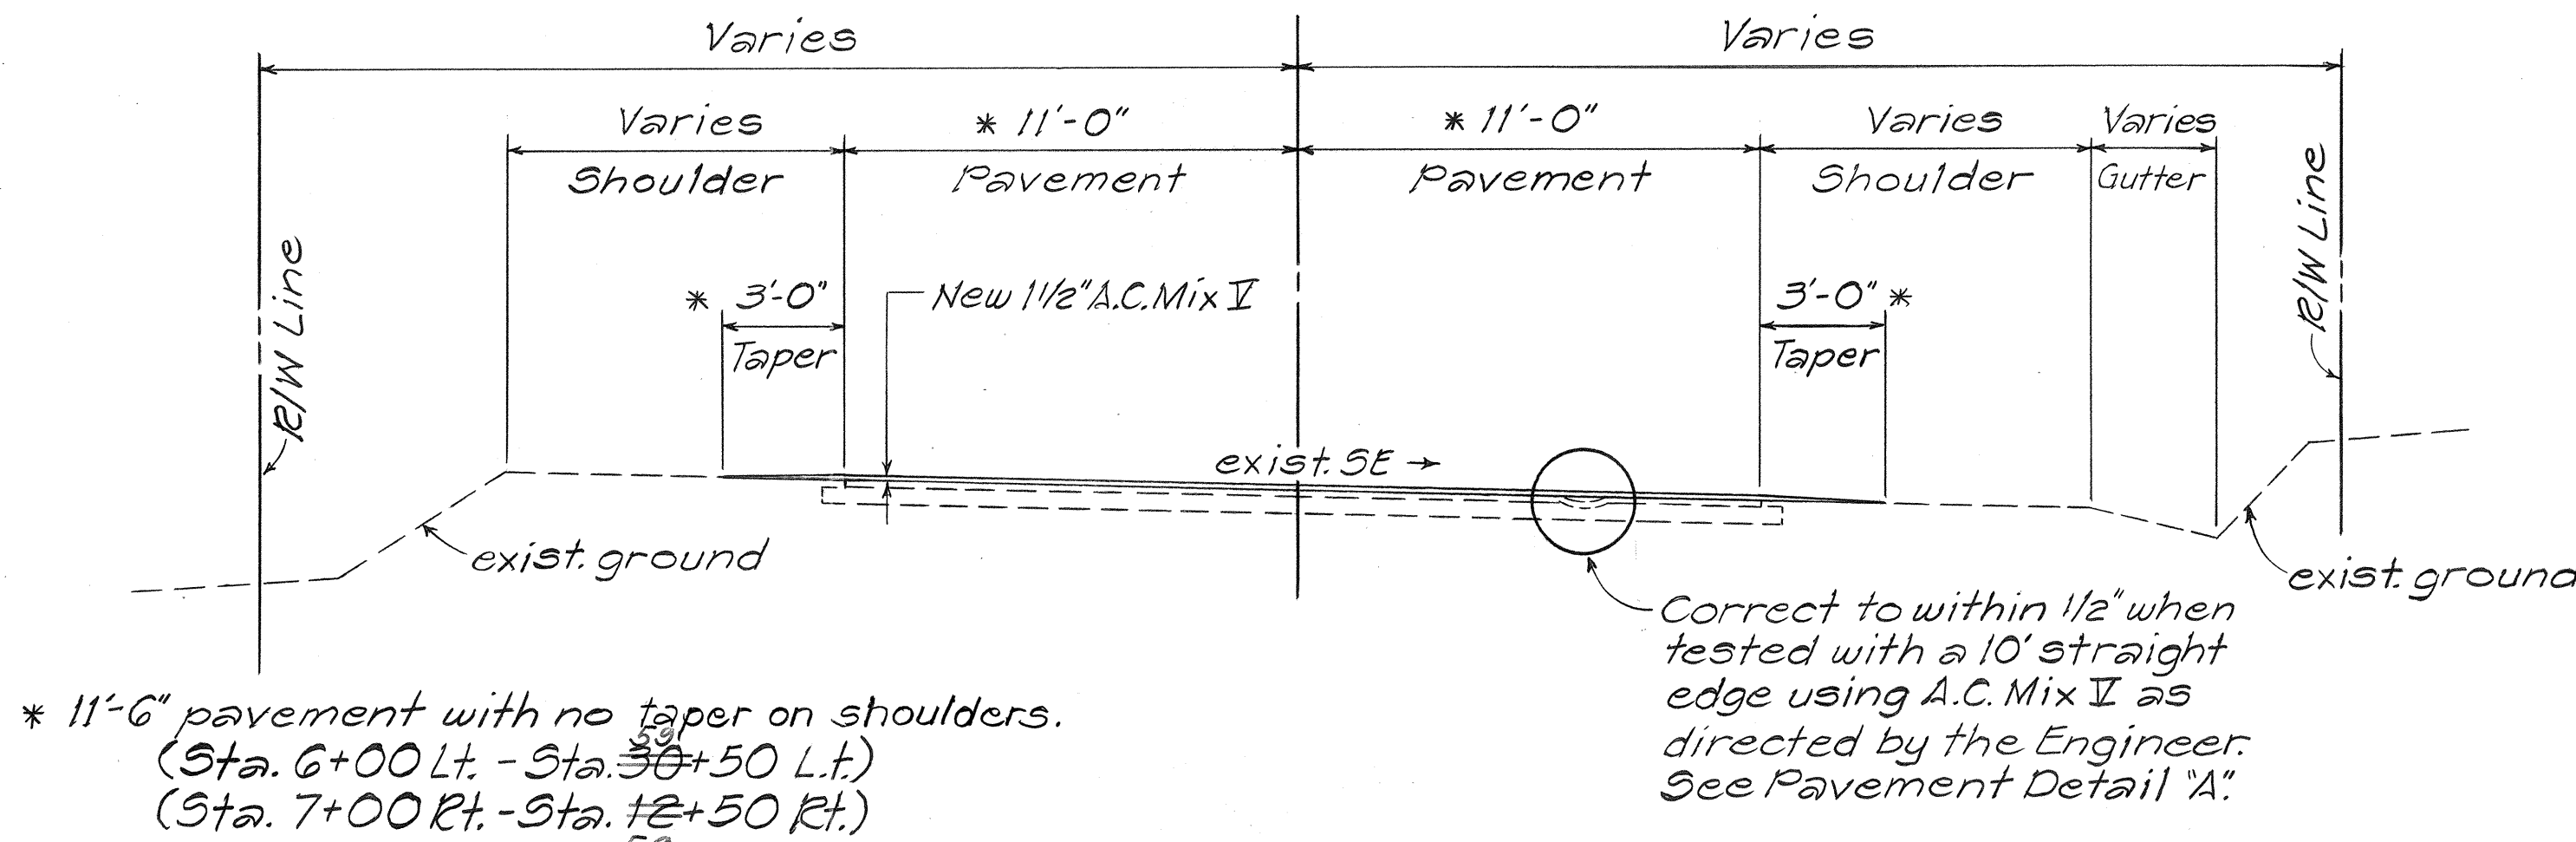


TYPICAL SUPERELEVATED SECTION
Not To Scale

SITE-1 (Sta. 0+30 - Sta. 100+23)

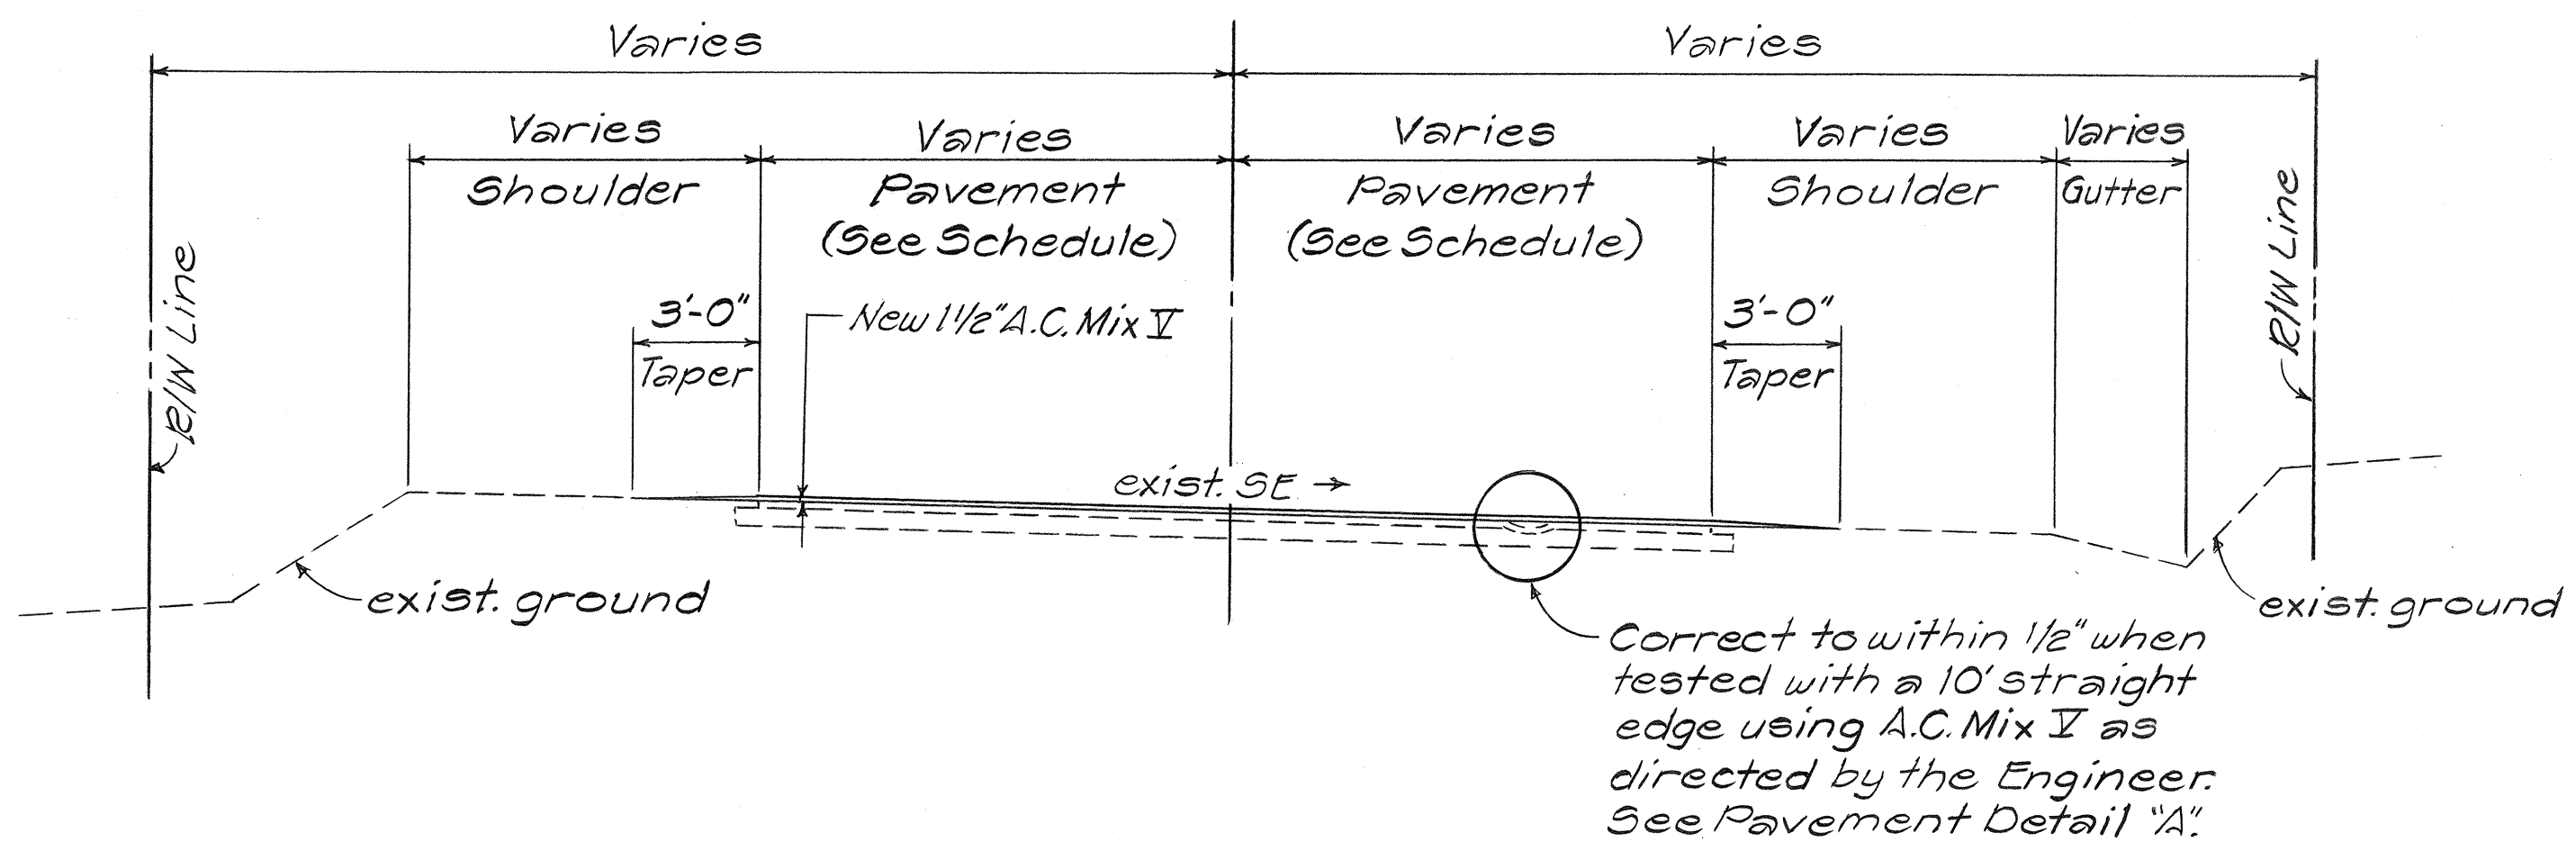


TYPICAL SUPERELEVATED SECTION
Not To Scale


SITE-2 (Sta. 367+00 - Sta. 569+50)

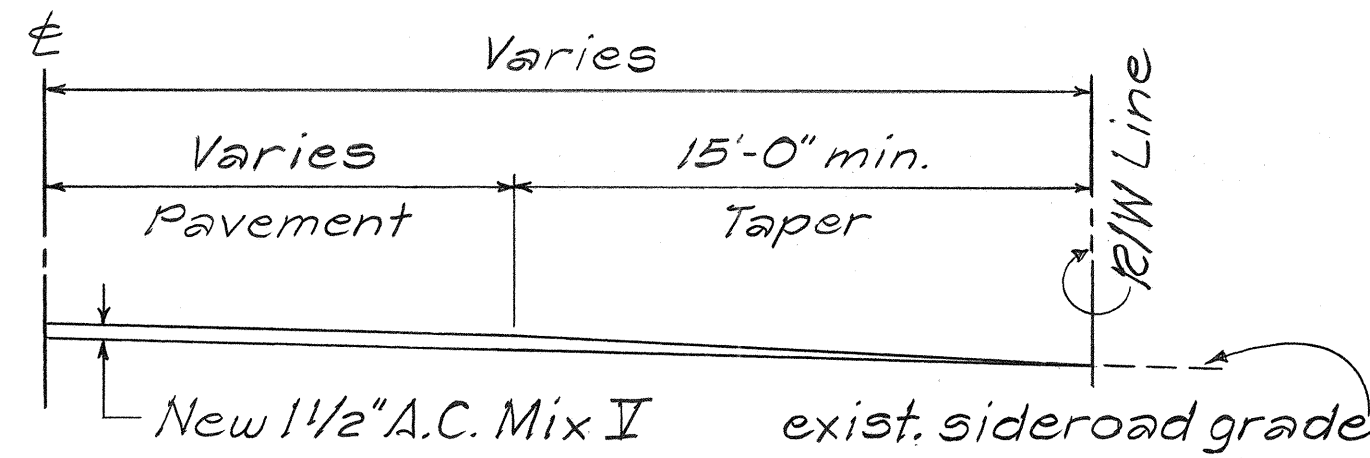

TYPICAL SIDEROAD CONNECTION
Not To Scale

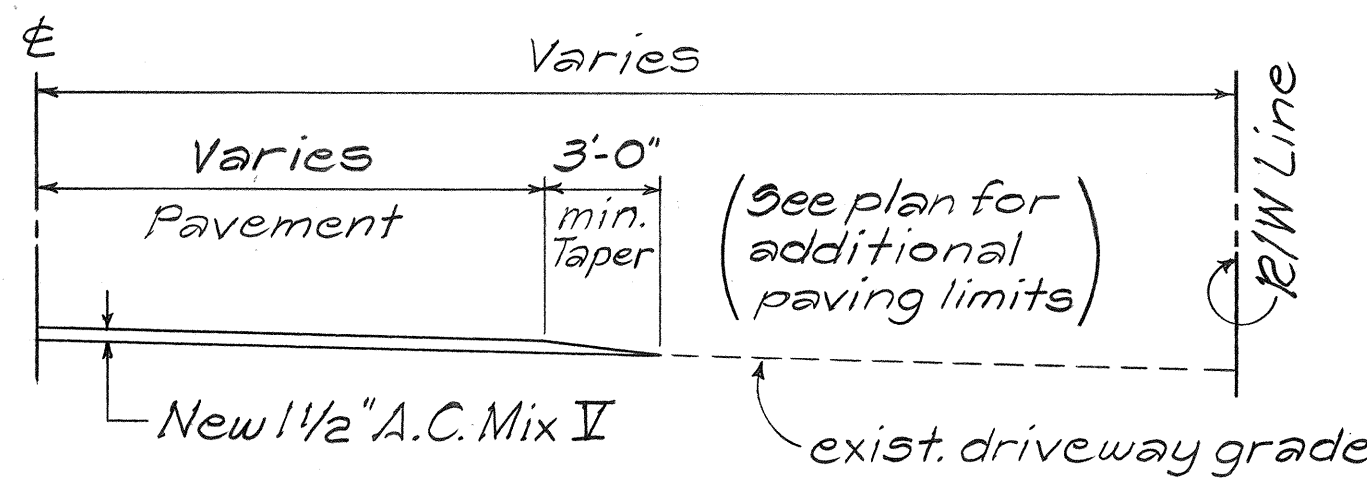

TYPICAL DRIVEWAY CONNECTION
Not To Scale

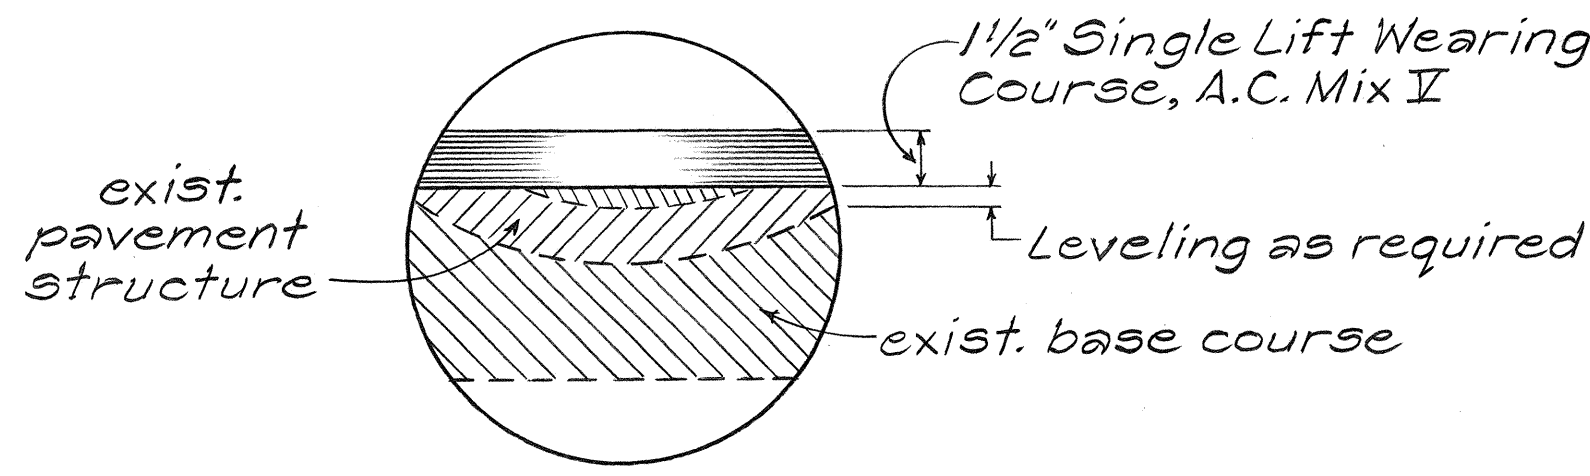

PAVEMENT DETAIL "A"
Not To Scale

STATE OF HAWAII

DEPARTMENT OF TRANSPORTATION

HIGHWAYS DIVISION

TYPICAL SECTIONS

AND DETAILS

SITE-1 & SITE-2

KOHALA MTN. RD. RESURF.

PROJ. No. 250A-01-01M

Scale: As Noted Date: Dec. 1990

SHEET No. 1 OF 1 SHEETS