



FED. ROAD DIST. NO.	STATE	PROJ. NO.	FISCAL YEAR	SHEET NO.	TOTAL SHEETS
HAWAII	HAW.	250A-01-92M	1992	7	9

RECONSTRUCTION AREA SCHEDULE

STATION		OFFSET FROM $\pm$ (FT.)		LENGTH	WIDTH	APPROX. AREA	STATION		OFFSET FROM $\pm$ (FT.)		LENGTH	WIDTH	APPROX. AREA
FROM	TO	Lt.	Rt.	Lin. Ft.	Ft.	Sq. Ft.	FROM	TO	Lt.	Rt.	Lin. Ft.	Ft.	Sq. Ft.
220+00	232+70		8.0	1,270	4	5,080	303+32	305+35	7.0		203	4	812
232+70	232+90		4.5	20	9	180	314+00	315+15		7.5	115	3	345
232+90	234+20		7.0	130	4	520	316+35	316+95		7.0	60	4	240
233+60	233+92	8.0		32	4	128	320+00	322+90		7.0	290	4	1,160
233+92	234+62	5.0		70	10	700	322+23	322+90	7.0		67	4	268
235+65	236+30	4.75		65	9.5	617.5	324+80	325+65	7.0		85	4	340
236+75	239+00		7.0	225	4	900	328+02	329+17	2.0		115	4	460
242+40	245+45		7.0	305	4	1,220	328+45	329+54		7.0	109	4	436
244+55	246+58	7.25		203	4.5	913.5	332+02	332+48	7.0		46	4	184
247+85	251+16	7.25		331	4.5	1,489.5	335+53	336+32	6.5		79	5	395
248+30	249+33		7.0	103	4	412	336+92	337+28	4.5		36	9	324
252+60	256+52	7.25		392	4.5	1,764	337+28	338+34	7.0		106	4	424
256+85	258+07		7.0	122	4	488	338+04	339+94	6.5		190	5	950
261+65	262+55	7.25		90	4.5	405	340+59	340+89		7.0	30	4	120
262+00	262+87		7.0	87	4	348	342+42	343+08	7.0		66	4	264
263+25	263+60		7.0	35	4	140	349+00	353+50	7.0		450	4	1,800
264+18	265+28		7.0	110	4	440	353+50	354+96	4.5		146	9	1,314
264+18	265+42	7.25		124	4.5	558	354+96	355+65	6.5		69	5	345
265+73	268+80		7.0	307	4	1,228	356+68	359+37	7.0		269	4	1,076
267+00	269+15	7.25		215	4.5	967.5	358+52	359+40		7.0	88	4	352
269+80	270+70		7.0	90	4	360	361+24	361+76	7.5		52	5	260
270+70	271+32	7.25		62	4.5	279	361+76	362+59	5.0		83	10	830
272+31	272+75		4.5	44	9	396							
273+45	282+30		7.0	885	4	3,540							
274+95	278+60	7.25		365	4.5	1,642.5							
286+19	287+09	4.75		90	9.5	855							
287+09	288+67	7.25		158	4.5	711							
288+67	289+32	4.75		65	9.5	617.5							
289+32	290+89		7.0	157	4	628							
290+80	292+00	7.0		170	4	680							
293+00	293+40	4.5		40	9	360							
294+27	295+26		7.0	99	4	396							
297+10	297+52	4.5		42	9	378							
297+52	297+80	7.25		28	4.5	126							
							TOTAL						42,167

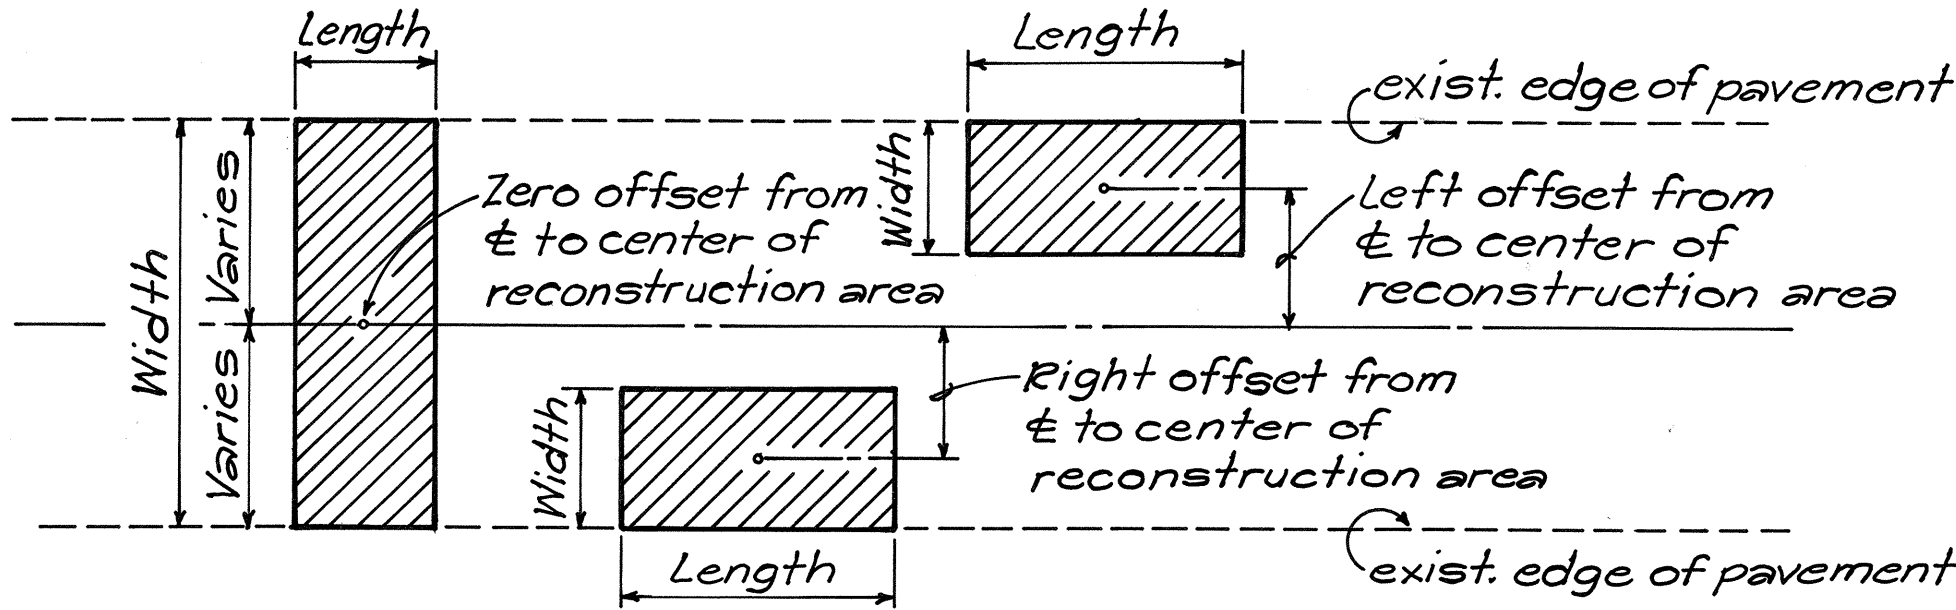

TYPICAL PLAN

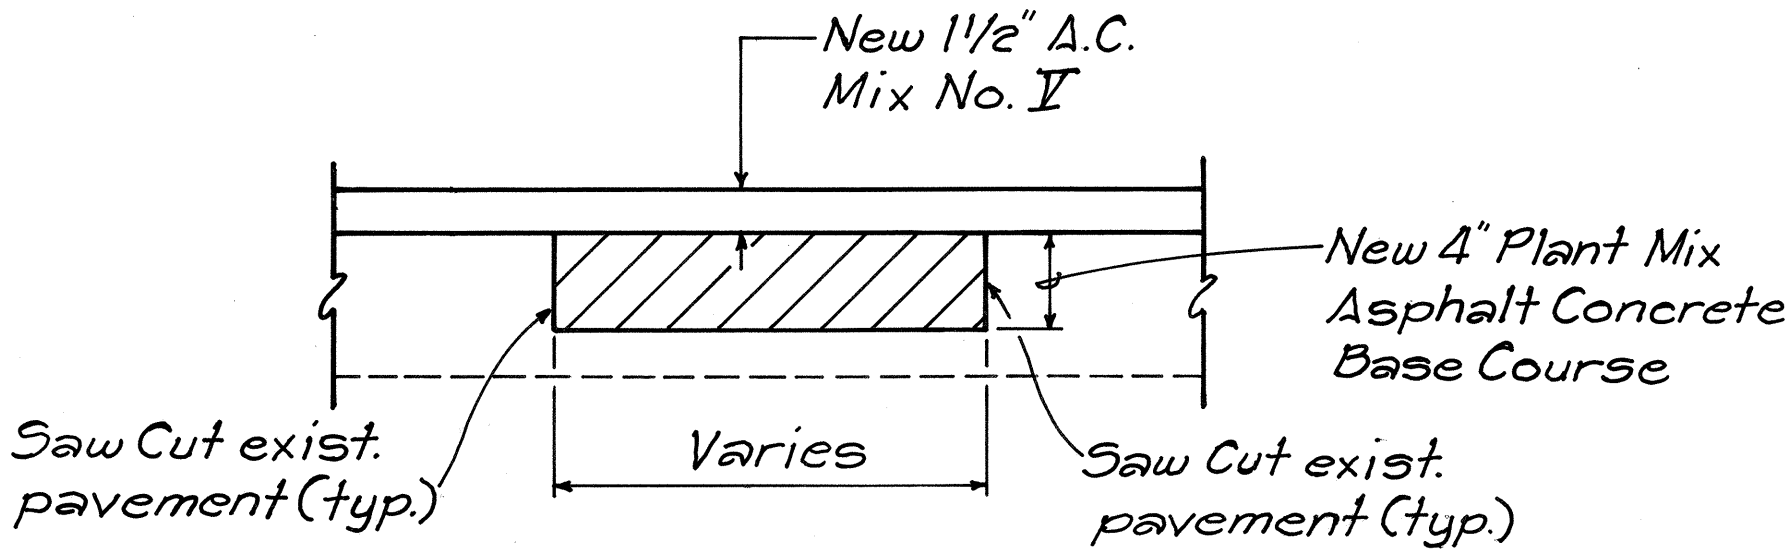

TYPICAL SECTION

PAVEMENT RECONSTRUCTION DETAIL

Not To Scale

STATE OF HAWAII
DEPARTMENT OF TRANSPORTATION
HIGHWAYS DIVISION
**RECONSTRUCTION DETAIL &
MISC. SCHEDULES**
KOHALA MOUNTAIN ROAD RESURFACING
PROJ. No. 250A-01-92 M
No. 8 & 50 KOHALA, HAWAII
Scale: As Noted Date: April, 1992
SHEET NO. 1 OF 1 SHEETS

ORIGINAL PLAN	SURVEY PLOTTED BY	DATE
NOTE BOOK	DRAWN BY	
	DESIGNED BY	
	CHECKED BY	

RECONSTRUCTION AREA SCHEDULE

STATIONS		OFFSET		LENGTH	WIDTH	AREA
FROM	TO	LT.	RT.	LIN. FT.	FT.	SQ. FT.
362 + 59 to 361 + 76		4.5		83	11	913
361 + 76 to 361 + 24		7		52	6	312
359 + 37 to 356 + 68		7.5		269	5	1,345
355 + 65 to 354 + 96		7		69	6	414
354 + 96 to 353 + 50		4.75		146	10.5	1,533
353 + 50 to 349 + 0		7.25		450	5.5	2,475
343 + 8 to 342 + 42		7		66	6	396
359 + 40 to 358 + 52			7.25	88	6	528
338 + 34 to 337 + 28		7		106	6	636
337 + 28 to 336 + 92		5		36	10	360
336 + 92 to 335 + 53		7		139	6	834
332 + 48 to 332 + 2		7		46	6	276
329 + 17 to 328 + 2		7		115	6	690
325 + 65 to 324 + 80		7		85	6	510
322 + 90 to 322 + 23		7		67	6	402
305 + 35 to 303 + 32		7		203	6	1,218
297 + 80 to 297 + 52		7		28	6	168
297 + 52 to 297 + 10		5		42	10	420
314 + 0 to 315 + 15			7	115	4	460
316 + 35 to 316 + 95			5	60	5	300
328 + 45 to 329 + 54			8	109	5	545
338 + 4 to 339 + 94			7.5	190	6	1,140
340 + 59 to 340 + 89			7.5	30	5	150
295 + 26 to 294 + 27			7	99	6	594
290 + 89 to 289 + 32			7.5	157	6	942
293 + 40 to 293 + 0		5		40	10	400
292 + 0 to 290 + 30		7.5		170	5	850
289 + 32 to 288 + 67		4.5		65	11	715
288 + 67 to 287 + 9		7.25		158	5.5	869
287 + 9 to 286 + 19		4.5		90	11	990
282 + 30 to 273 + 45			7.25	885	5	4,425
272 + 75 to 272 + 31			4.5	44	10	440
270 + 70 to 269 + 80			7.5	90	5	450

STATIONS		OFFSET		LENGTH	WIDTH	AREA
FROM	TO	LT.	RT.	LIN. FT.	FT.	SQ. FT.
268 + 80 to 267 + 30		7.25	5	150	5	750
278 + 60 to 274 + 95		7.25		365	5.5	2,008
271 + 32 to 270 + 70		7.25		62	5.5	341
269 + 15 to 267 + 0		7.25		215	5.5	1,183
265 + 42 to 264 + 18		7.25		124	5.5	682
262 + 55 to 261 + 65		7.25		90	5.5	495
256 + 52 to 254 + 0		7.25		252	5.5	1,386
254 + 0 to 252 + 60		7.25		140	5.5	770
251 + 16 to 247 + 85		7.25		331	5.5	1,821
246 + 58 to 244 + 55		7.25		203	5.5	1,117
236 + 30 to 235 + 65		4.75		65	10.5	682.5
234 + 62 to 233 + 92		4.5		70	11	770
233 + 92 to 233 + 60		7.5		32	5	160
220 + 0 to 232 + 70			4.5	1270	5	6,350
232 + 70 to 232 + 90			7.5	20	10	200
232 + 90 to 234 + 20			7.5	130	5	650
267 + 30 to 265 + 73			7.5	157	5	785
265 + 28 to 264 + 18			7.5	110	5	550
263 + 60 to 263 + 25			7.5	35	5	175
262 + 87 to 262 + 0			7.5	87	5	435
258 + 7 to 256 + 85			7.5	122	5	610
249 + 33 to 248 + 30			7.5	103	5	515
245 + 45 to 242 + 40			7.5	305	5	1,525
239 + 0 to 236 + 75			7.5	225	5	1,125
281 + 30 to 282 + 0		6.25		70	7.5	525
TOTALS				9,125		52,309

Note: This tracing prepared during "As-Built" posting.

STATE OF HAWAII
DEPARTMENT OF TRANSPORTATION
HIGHWAYS DIVISION
RECONSTRUCTION DETAIL #
MISC. SCHEDULES
KOHALA MOUNTAIN ROAD RESURFACING
PROJ. NO. 250A-01-92M
No. # So KOHALA, HAWAII
Scale: As Noted Date: April, 1992
SHEET No. 1 OF 1 SHEETS

ORIGINAL
FILED
NOTE BOOK
No.

SURVEY PLOTTED BY
DATE
DESIGNED BY
CHECKED BY
QUANTITIES BY