	3 2 9
	INDEX TO DRAWINGS
SHEET NO.	DESCRIPTION
	TITLE SHEET
2	STANDARD PLANS SUMMARY
3	TYPICAL SECTIONS & DETAILS
4-6	ROADWAY & STRIPING PLAN
① 7	RECONSTRUCTION DETAIL & MISC. SCHEDULES
8	MISC. SCHEDULES
9	CONSTRUCTION SIGN DETAIL,
	E.P. MARKING & SCHEDULES

ALLAN NISHIMURA P. S. & E. BY

HAWAII DISTRICT
DESIGNED BY


Plan Sht. Nos. (1)7 S-1 is a supplementary sheet to this project. TOTAL SHEET COUNT after "AS BUILT" postings. 10 Sheets.

## STATE OF HAWAII

DEPARTMENT OF TRANSPORTATION HIGHWAYS DIVISION HONOLULU, HAWAII "AS-BUILT"
PLANS FOR

## KOHALA MOUNTAIN ROAD RESURFACING PROJECT NO. 250A-01-92 M

DISTRICT OF NORTH & SOUTH KOHALA ISLAND OF HAWAII

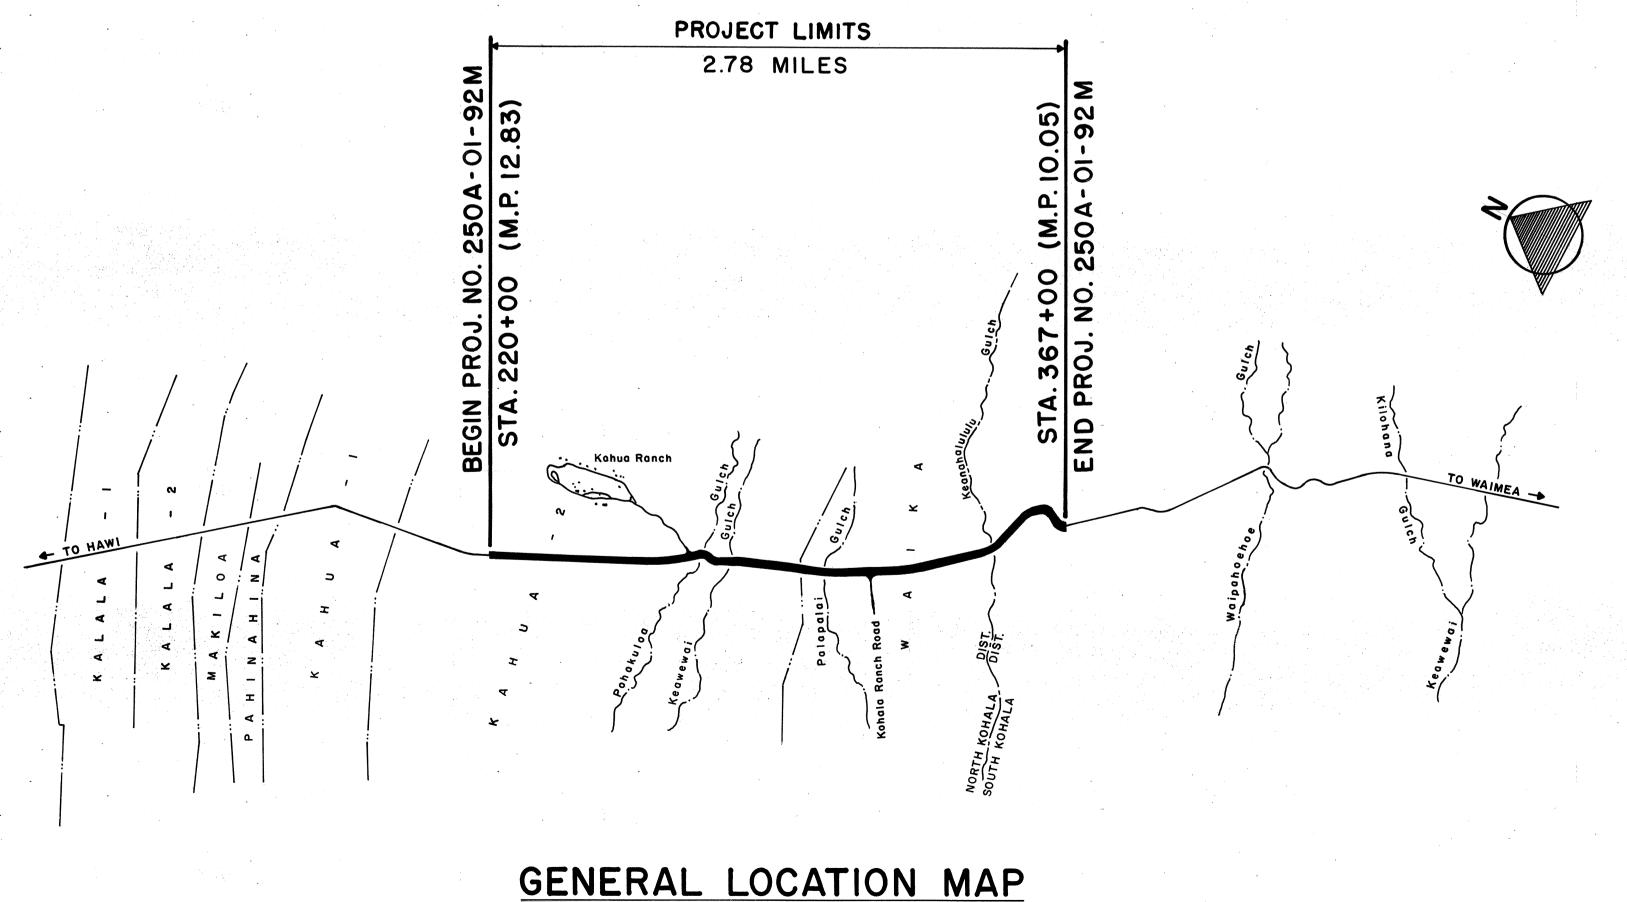

SCALE: IN MILES

STATE OF HAWAII LOCATION OF PROJECT NO. 250A-01-92M HA SCALE IN MILES FEDERAL AID PROJECTS PREVIOUSLY CONSTRUCTED OR UNDER CONSTRUCTION MILE POST 10.05 TO MILE POST 12.83 CHANGES MADE DURING CONSTRUCTION HAVE

FED. ROAD DIST. NO.

FISCAL SHEET TOTAL YEAR NO. SHEETS

PROJ. NO.

250A-01-92M

BEEN INCORPORATED ON THESE PLANS EXCEPT CHANGES IN THE ORIGINAL THEORETICAL QUANTITIES. FOR ACTUAL QUANTITIES, REFER TO PROJECT LEDGER AND/OR COMPUTATION BOOK.

RESIDENT ENGINEER

10-15-93 DATE

DEPARTMENT OF TRANSPORTATION STATE OF HAWAII APPROVED: DIR. OF TRANSPORTATION 4/28/92

DATE

AS-BUIL