

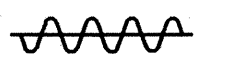
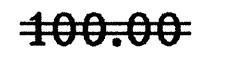
UTILITY SCHEDULE					
SEGMENT	STATION	OFFSET FROM O.B.L. ϕ		TYPE	REMARKS
		MAUKA	MAKAI		
A		Right	Left		
	118+30	8		WV	1.2' x 1.4'
	118+25	12		WV	1.2' x 1.4'
	101+60	27		WV	1.1' x 1.7'
B	101+55	29		WV	1.1' x 1.7'
		Left	Right		
Legend : (●) WV = Water Valve 4 Total					

ROUTE AND MILEPOST MARKER SCHEDULE						
SEGMENT	STATION	MAUKA	MAKAI	ROUTE MARKER SIGN NO. (ROUTE NO.)	REMOVE	INSTALL TYPE A ASSEMBLY
A		Right	Left			
	71+35	●		MI-6C (250)	1	1
	71+20		●	MI-6C (250)	1	1
B		Left	Right			
	4+00	●	●	MI-6C (250)	2	2
	80+15	●	●	MI-6C (250)	2	2
	154+80	●	●	MI-6C (250)	2	2
TOTALS					8	8
SEGMENT	STATION	MAUKA	MAKAI	MILE POST D10-2 (10"X27") MILE POST NO. (RTE. NO.)	REMOVE	INSTALL WITH POST (Bi-Dir)
A		Right	Left			
	97+50	●		19 (250)	1	1
	45+30	●		18 (250)/29 km *	1	1
B	11+95	●		17 (250)	1	1
		Left	Right			
	60+65	●		16 (250)	1	1
	113+05	●		15 (250)	1	1
	166+10	●		14 (250)	1	1
B	218+85	●		13 (250)/21 km *	1	1
TOTALS					7	7

* Contractor shall submit shop drawings of the kilometer-post sign to the Engineer for acceptance. Fabrication and installation of these signs shall be considered incidental to various sign items.

PAVEMENT MARKING SUMMARY		
DESCRIPTION	QUANTITY	
THERMOPLASTIC EXTRUSION or TAPE, TYPE I		
4-Inch Pavement Stripe (Yellow).....	10,700 L.F.	
Double 4-Inch Pavement Stripe (Yellow).....	21,200 L.F.	
THERMOPLASTIC EXTRUSION or TAPE, TYPE II		
4-Inch Pavement Stripe (White).....	41,300 L.F.	
THERMOPLASTIC EXTRUSION or TAPE, TYPE III		
12-Inch Pavement Stripe (White).....	60 L.F.	
PAVEMENT MARKERS		
Type C	1,000	1,750 Each
Type D	970	1,420 Each
Type H	250	270 Each
Type J		1,360 Each

REFLECTOR MARKER SUMMARY	
DESCRIPTION	QUANTITY
RM - 3 (Yellow)	
Flex Post	62
Flex Post (Bi-Directional)	51
TYPE II OBJECT MARKER	
Without Post	19

LEGEND FOR AS-BUILT POSTINGS	
	Squiggly line for as-built deletion
	Double line for as-built deletion
Roadway	Text for as-built posting

STATE OF HAWAII
DEPARTMENT OF TRANSPORTATION
HIGHWAYS DIVISION

MISCELLANEOUS SCHEDULES

KOHALA MOUNTAIN ROAD RESURFACING
IKI ROAD TO KAHUA
PROJECT NO. 250A-01-96M

Date: March, 1996

SURVEY PLOTTED BY	DATE
DESIGNED BY	
TRACED BY	
NOTE BOOK	
QUANTITIES BY	
CHECKED BY	
ORIGINAL PLAN	
1/11/96	
No. 250A	