FED. ROAD DIST. NO.	STATE	PROJ. NO.	FISCAL YEAR	SHEET NO.	TOTAL SHEETS
HAWAII	HAW.	250A-01-96M	1996	21	26

## LEGEND

4 each Type J Raised Pavement Markers Type D Raised Pavement Markers @ 40' - 0" o.c.

4 Each Type J Raised Pavement Markers Type D Raised Pavement Markers @ 40'-0" o.c. Type H Raised Pavement Markers (Reflective Surface facing no-passing direction) 4" Single Solid Yellow Stripe (Tape Type I or Thermoplastic Extrusion)

> 4" Double Solid Yellow Centerline Stripes with Type D Raised Pavement Markers @ 20' - 0" o.c. (Tape Type I or Thermoplastic Extrusion)

> 4"Double Solid Yellow Transverse Median Stripes with Type H Raised Pavement Markers @ 20' - 0" o.c. (Tape, Type I or Thermoplastic Extrusion)

4" or 8" White Edge Stripe (see Stnd. Plan TE-67) with Type C Raised Pavement Markers @ 40'-0" o.c. (Tape Type II or Thermoplastic Extrusion)

8" White Channelizing Stripe with Type C Raised Pavement Markers @ 20'-0' o.c. (Tape, Type I or Thermoplastic Extrusion)

Transverse Median Diagonal Marking 12" Wide @ 20'-0" o.c. (Tape, Type II or Thermoplastic Extrusion)

Channelizing Island or Deceleration Lane Gore (Tape Type II or Thermoplastic Extrusion)

4" White Guide Lines, 2' Stripe with 4'-0" space (Tape, Type III or Thermoplastic Extrusion)

4" White Edge Line Extension, 2' Stripe at 10'-0" o.c. (Tape, Type III or Thermoplastic Extrusion) with Type C Markers at 40'-0" o.c.


## REFLECTOR MARKER LEGEND

RM-3, Yellow Reflector Marker with flex post unless otherwise noted.

otherwise noted.

## NOTES

- Layout of pavement markings and striping shall be done by the Contractor and approved by the Engineer prior to any installation work.
- Existing pavement markings not incorporated in the final traffic pattern shall be removed as directed by the Engineer. Costs shall be incidental to the various pavement marking items.
- Raised pavement markers shall not be installed within crosswalks.
- 4. Final locations of all Stop Lines shall be approved by the Engineer prior to installation.
- All pavement striping shall be as noted on the Legend or plans, or as directed by the Engineer.
- 8. All preformed pavement marking tapes over existing pavement shall be applied with an approved primer as recommended by the tape manufacturer and as approved by the Engineer. The primer shall be allowed to dry to the tacky stage prior to tape application.
- Contractor shall obtain blue raised pavement markers from County of Hawaii Fire Department and install them at the direction of the Engineer. The cost of installing the markers shall be incidental to other Contract Items.

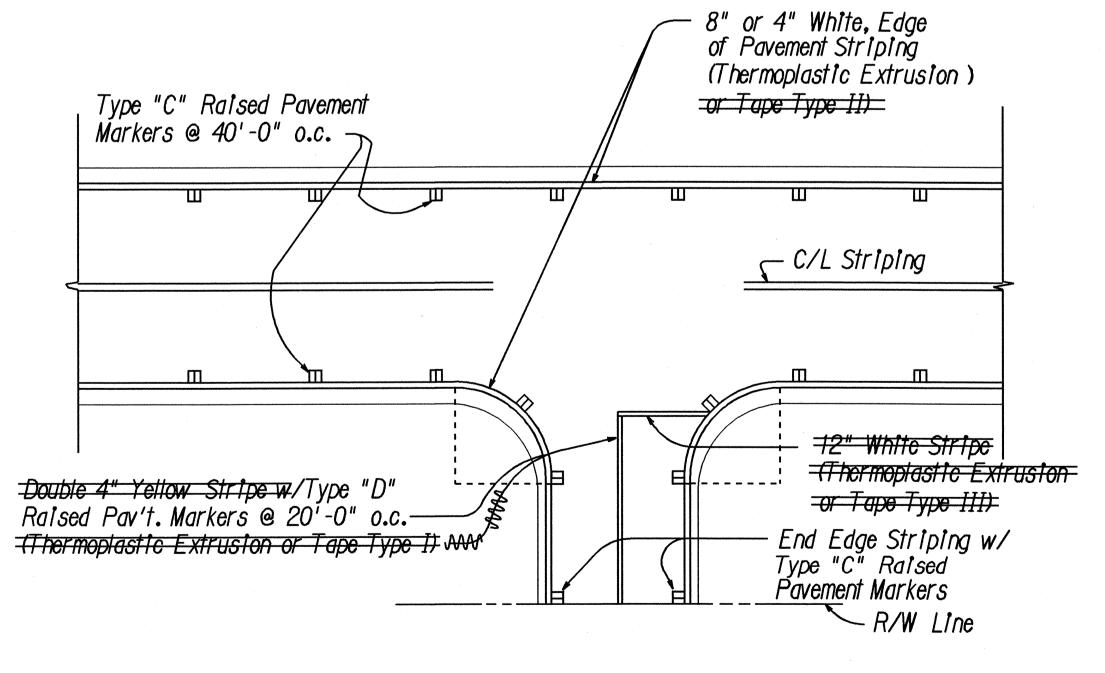

TYPICAL EDGE OF PAVEMENT MARKING Not to Scale

LEGEND FOR AS-BUILT POSTINGS Squiggly line for as-built deletion  $\sim$ Double line for <del>100.00</del>

as-built deletion

Roadway Text for as-built posting

STATE OF HAWAII

DEPARTMENT OF TRANSPORTATION HIGHWAYS DIVISION PAVEMENT MARKING

LEGEND AND NOTES KOHALA MOUNTAIN ROAD RESURFACING IKI ROAD TO KAHUA PROJECT NO. 250A-01-96M

Scale: As Shown

Date: March, 1996 SHEET No. 1 OF SHEETS

"AS-BUILT"