



FED. ROAD DIST. NO.	STATE	PROJ. NO.	FISCAL YEAR	SHEET NO.	TOTAL SHEETS
HAWAII	HAW.	250A-01-96M	1996	23	26

RECONSTRUCTION AREA SCHEDULE						
SEGMENT	STATION		OFFSET FROM RD. C/L TO CENTER RECON. AREA (L.F.)		LENGTH (L.F.)	APPROX. AREA (SQ. FT.)
	FROM	TO	MAUKA	MAKAI		
A			Right	Left		
	94+30	94+00	7.5		30	150
B			Left	Right		
	14+00	219+00	6		20,500	205,000
	81+90	82+70	8		80	320
	14+00	219+00	7.5	6	20,500	205,000
	83+10	85+10			200	1,000
	104+80	106+30	7.5		150	750
	108+00	108+20		7.5	20	100
	108+00	111+50	7.5		350	1,750
	123+20	125+60	7.5		240	1,200
	134+20	134+30		7.5	10	50
	137+60	139+00	7.5		140	700
	139+80	140+80	7.5		100	500
	146+95	147+00		10	5	20
	150+00	150+50		8	50	200
	150+00	152+30	7.5		230	1,150
	156+80	157+00	8		20	80
	157+60	158+40		8	80	320
	158+30	158+80	8		50	200
	173+30	173+60	7.5		30	150
	174+00	175+80	8		180	720
	175+60	175+70		8	10	40
	176+30	177+00	7		70	420
	190+25	190+35	8		10	40
	190+70	190+90	8		20	80
	193+40	193+80		7.5	40	200
	210+15	210+35	7.5		20	100
	213+60	213+70	8		10	40
	214+15	214+35	7.5		20	100
	215+20	215+40	5		20	200
	215+90	216+05	1		15	30
	215+90	216+05		1	15	30
	218+15	218+25	8		10	50
TOTAL						10,690

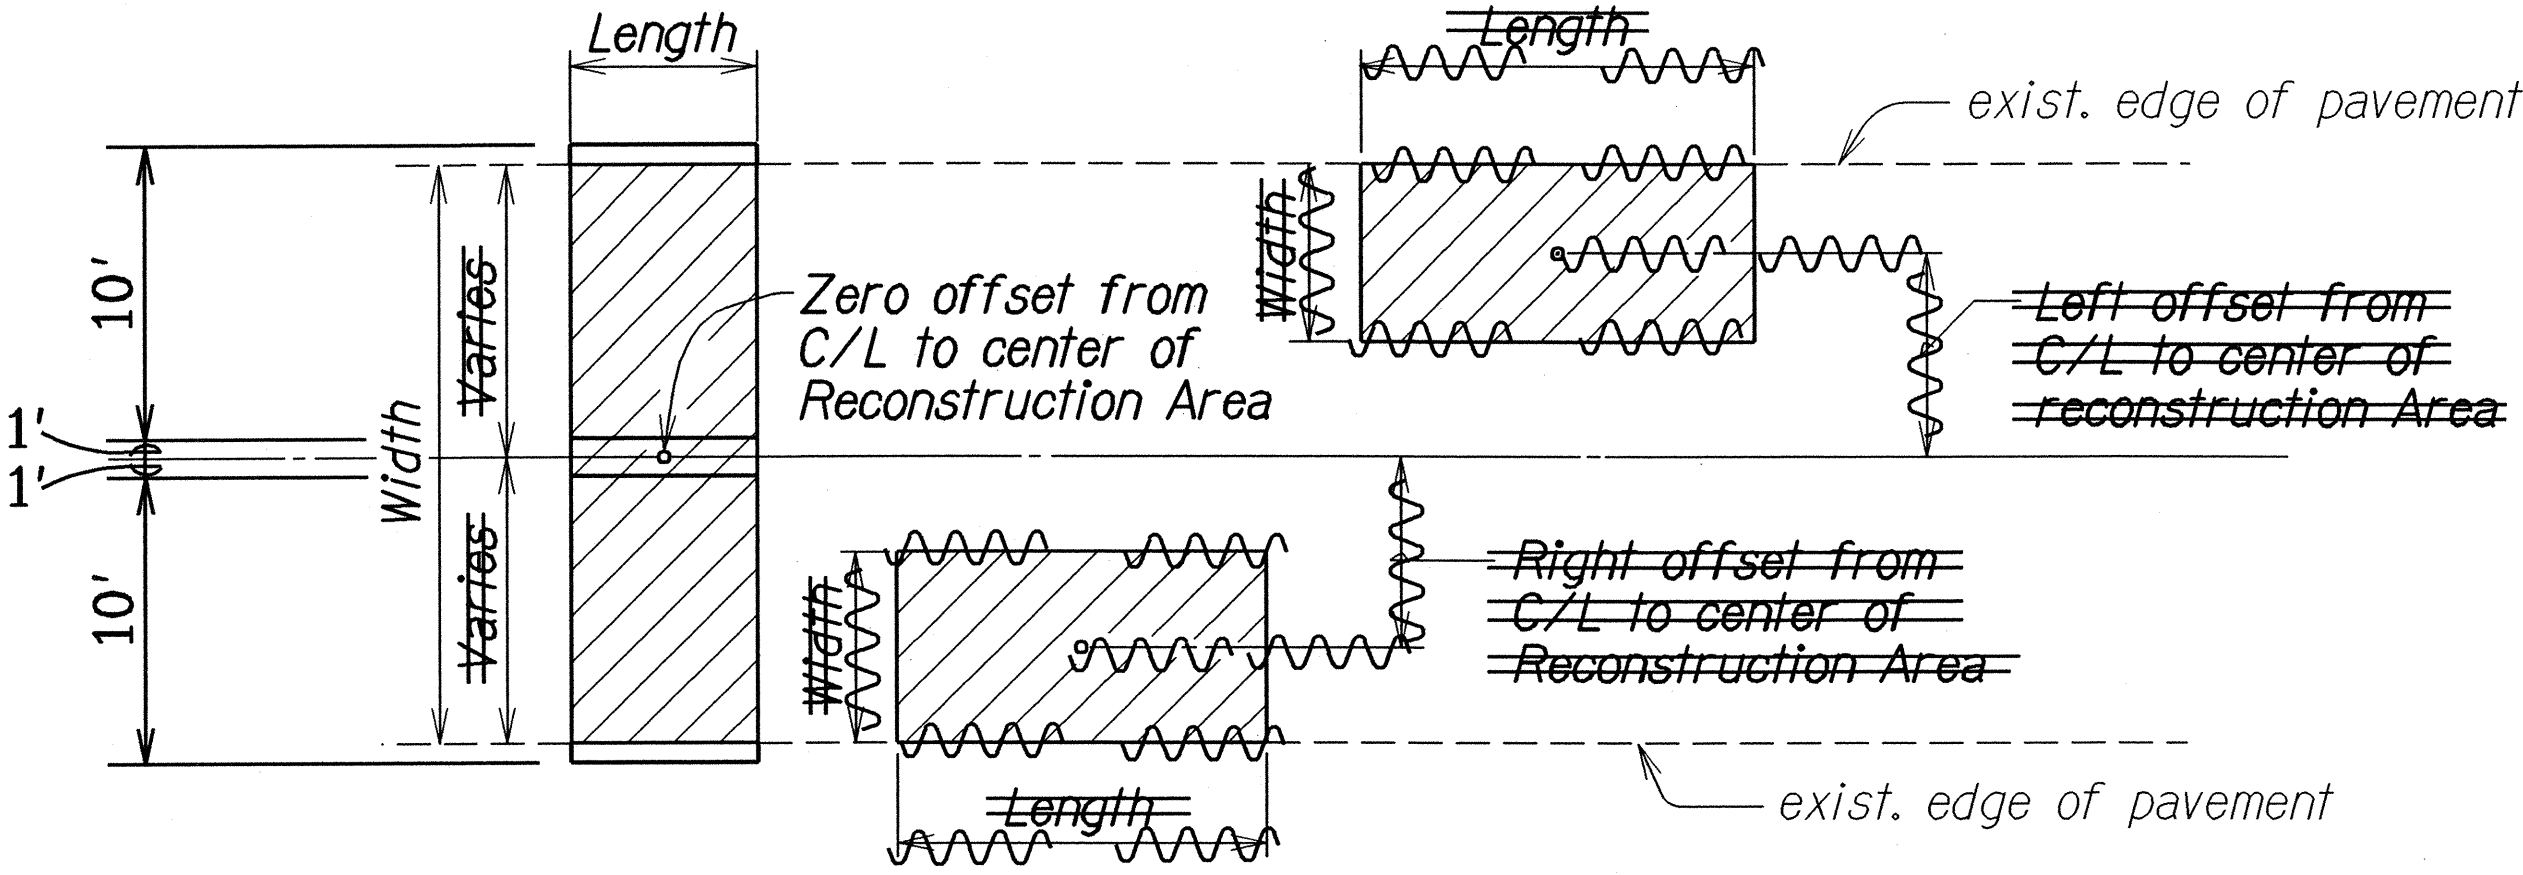

TYPICAL PLAN
Not To Scale

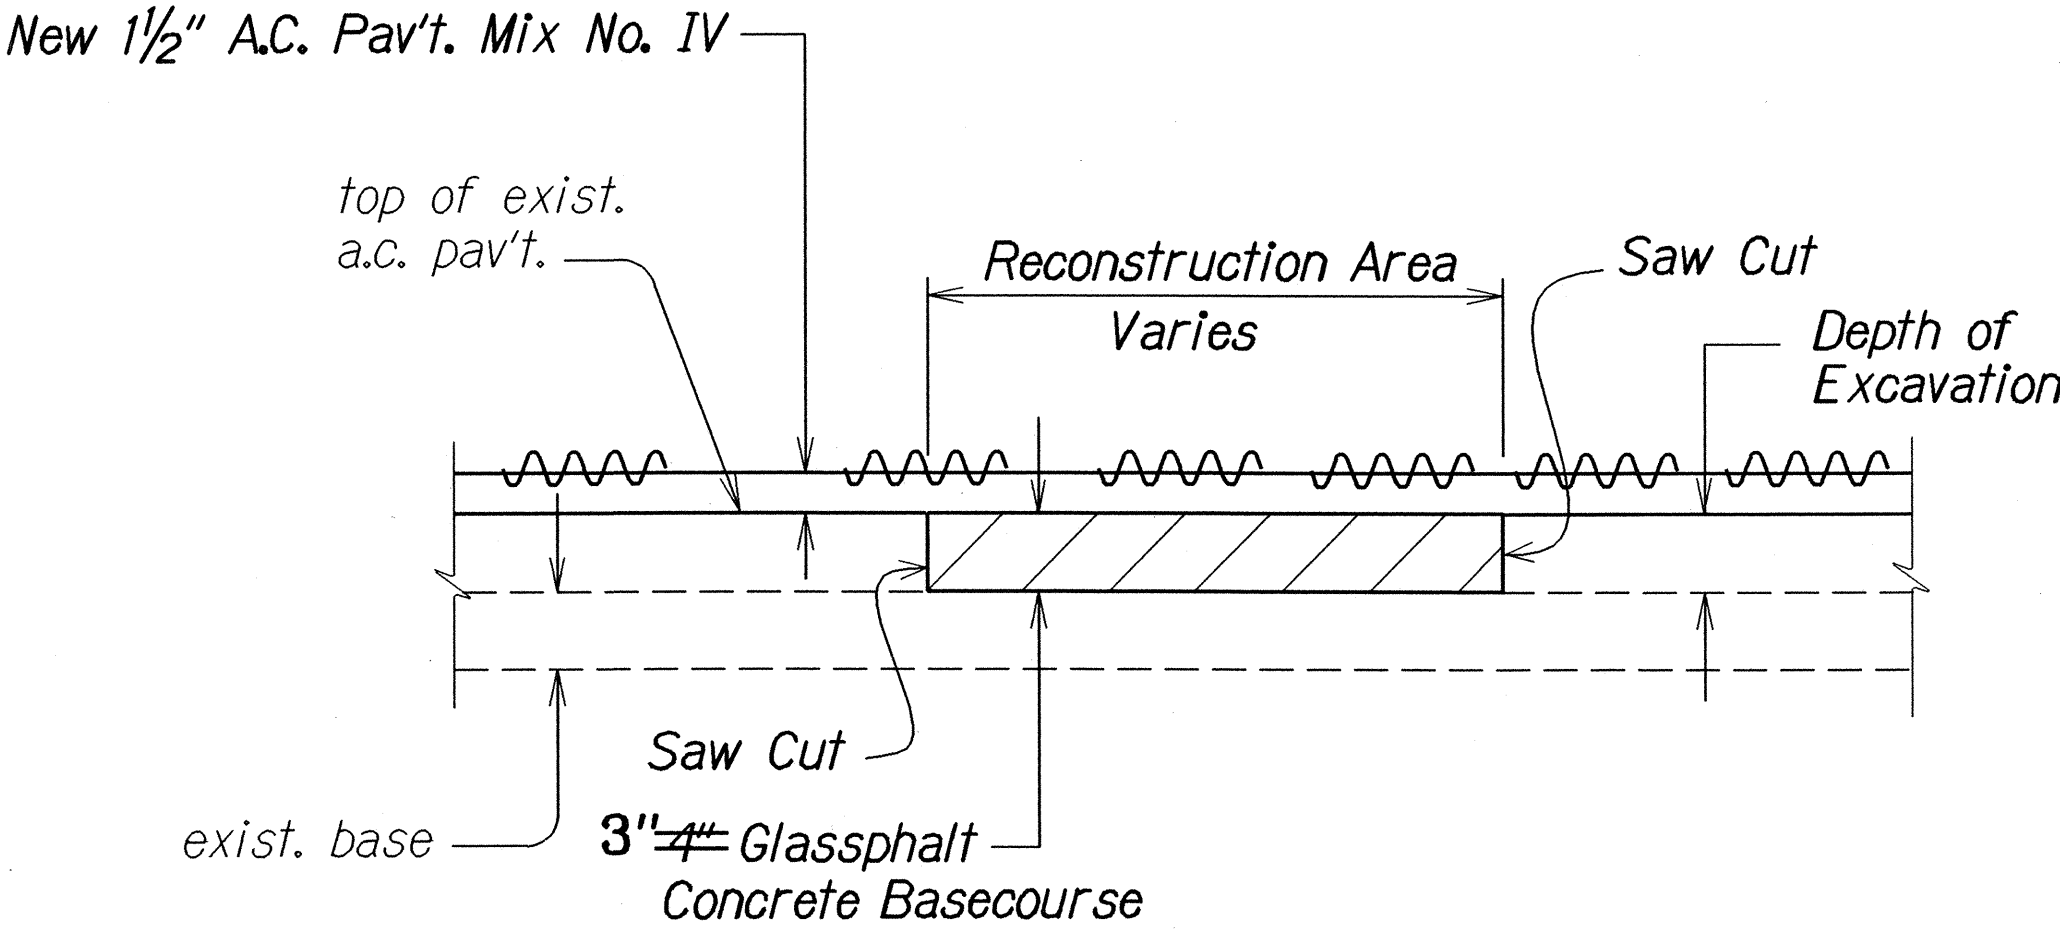

A.C. PAVEMENT RECONSTRUCTION DETAIL
Not To Scale

LEGEND FOR AS-BUILT POSTINGS	
	Squiggly line for as-built deletion
	Double line for as-built deletion
Roadway	Text for as-built posting

STATE OF HAWAII
DEPARTMENT OF TRANSPORTATION
HIGHWAYS DIVISION

RECONSTRUCTION AREA
SCHEDULE AND DETAILS

KOHALA MOUNTAIN ROAD RESURFACING
IKI ROAD TO KAHUA
PROJECT NO. 250A-01-96M

Scale: As Shown Date: March, 1996

SHEET No. 1 OF 1 SHEETS

ORIGINAL PLAN	SURVEY PLOTTED BY	DATE
NOTE BOOK	DRAWN BY	
limited	DESIGNED BY	
quantities	CHECKED BY	
by		