


SIGN NOTES


FED. ROAD DIST. NO.	STATE	PROJ. NO.	FISCAL YEAR	SHEET NO.	TOTAL SHEETS
HAWAII	HAW.	250A-01-96M	1996	22	26

- Lettering
 - Destination Signs: Capitals, 8" Modified Series "E"; Lowercase, 6" Modified Series "E".
 - Street Name and Supplemental Street Name Signs: Use Modified Series "E", unless otherwise specified by the Engineer.
- All signs shall conform to Section 621 of the Special Provisions and the latest editions and amendments of the following FHWA publications:
 - "Manual on Uniform Traffic Control Devices for Streets and Highways" (MUTCD)
 - "Standard Highway Signs"
 - "Standard Alphabets for Highway Signs"
- Borders, messages, arrows, symbols and shield shall conform to details as shown on the plans and as specified in the MUTCD.
- Sign messages shall be as indicated on the plan, or as directed by the Engineer.
- All panels shall be reflectorized in accordance with Section 712.20 of the Standard Specifications. Minimum width of panels shall be 2 ft. abutting edges of panels shall be in only one direction if vertical abutting edges are used, no horizontal abutting edges shall be allowed and vice versa.
- Contractor shall submit all sign splicing details to the Engineer for acceptance. All backing for signs 4 feet by 6 feet or less shall be of one sheet.
- Backing for all new Regulatory and Warning Signs shall not be spliced.
- Final locations of all signs shall be approved by the Engineer prior to any installation work.
- Existing signs that are to be replaced shall not be removed until new signs are installed as replacements, or the messages are no longer necessary.
- Existing signs not shown on these plans shall remain as posted unless otherwise directed by the Engineer. Removal and disposal of existing signs and/or posts as designated on these plans or as directed by the Engineer shall be considered incidental to the various signing items.
- Removal of Existing Delineators and Posts shall be considered incidental to the various signing items.
- All Destination, Street Name, Supplemental Street Name, and Non-Standard signs that are to be replaced shall be identical to the existing sign in size and text, unless otherwise specified.
- All signs shall be installed on square tube posts, unless otherwise noted.
- Sign posts shall be painted with yellow reflective paint, except where located behind guardrails. Such paint work shall be considered incidental to sign items.
- Contractor shall mark the back of all signs using labels and equipment provided by the State. Payment to be incidental to various contract items.
- The Contractor shall submit Shop Drawings to the Engineer for acceptance prior to fabricating Destination, Street Name, Supplemental Street Name, and Non-Standard signs.
- Fabrication and installation of Supplemental Street Name signs shall be considered incidental to installation of W1-2 and W2-2 signs.
- Street Name signs shall be paid for under Item No. 621.5000 - Regulatory and Warning Sign (10 Square Feet or Less) Without Posts.

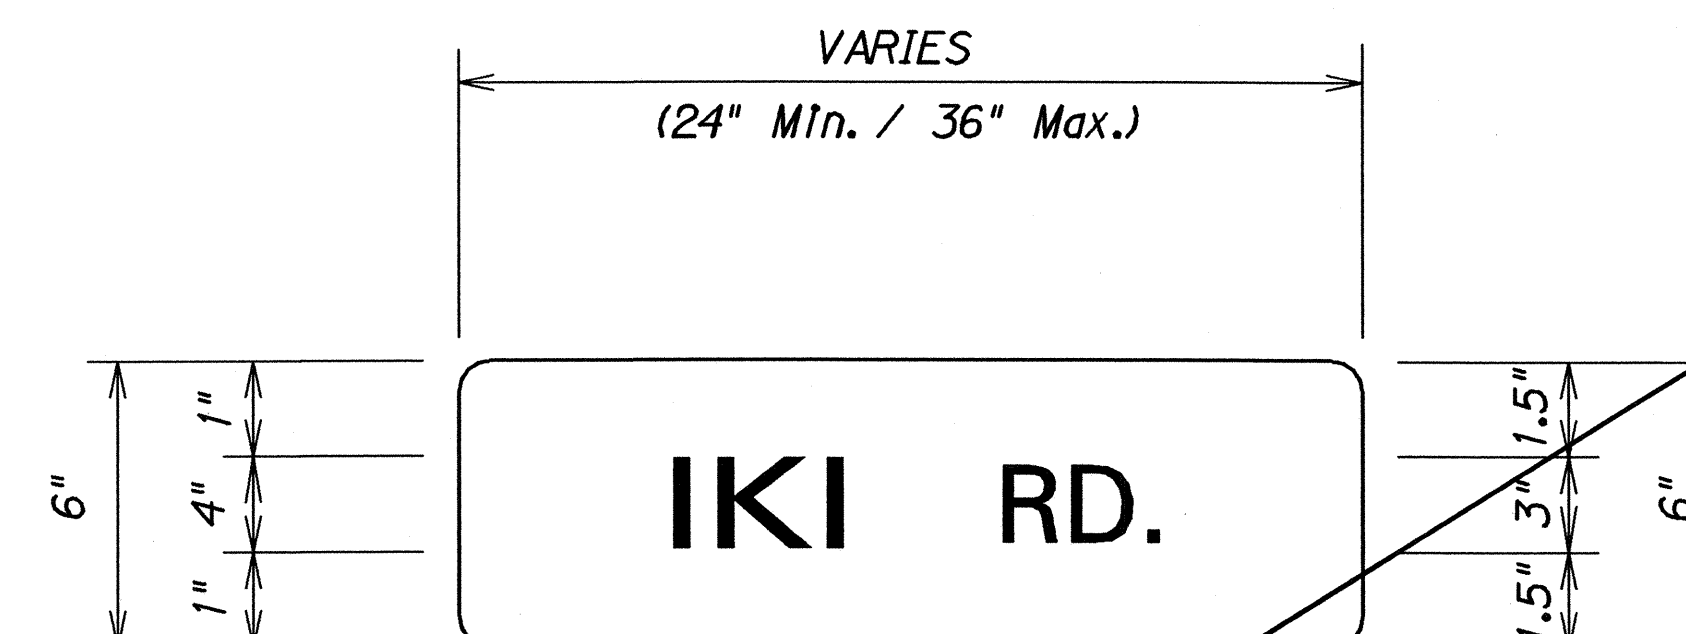

D3-1: STREET NAME SIGNS (1 Total)

LETTERING: WHITE (NON-REFLECTORIZED)
 BACKGROUND: GREEN (REFLECTORIZED)
 Dimensions Typical for: IKI RD.

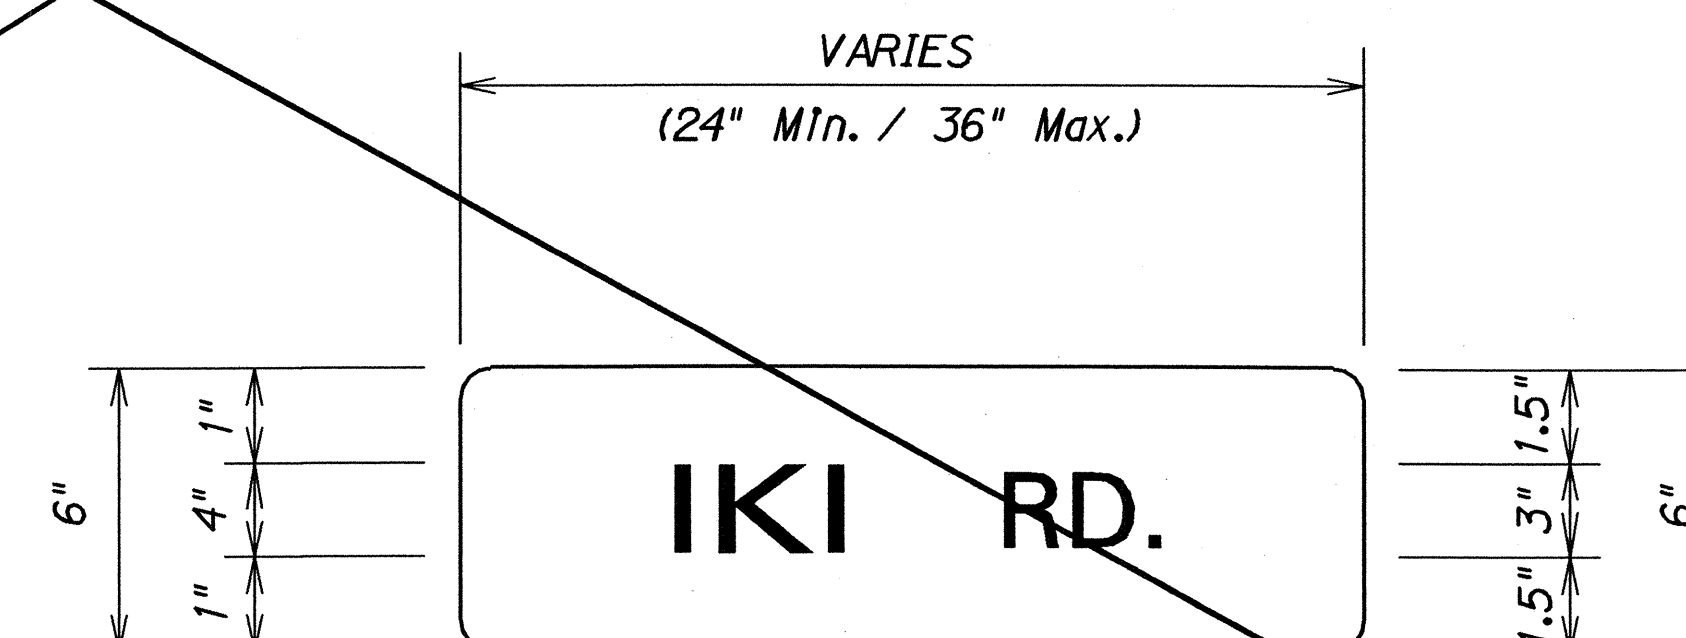

D3-2: SUPPLEMENTAL STREET NAME SIGNS (1 Total)

LETTERING: BLACK (NON-REFLECTORIZED)
 BACKGROUND: YELLOW (REFLECTORIZED)
 Dimensions Typical for: IKI RD.

N O I C

"AS-BUILT"

STATE OF HAWAII DEPARTMENT OF TRANSPORTATION HIGHWAYS DIVISION	
<u>SIGN DETAILS AND NOTES</u>	
KOHALA MOUNTAIN ROAD RESURFACING	
IKI ROAD TO KAHUA	
PROJECT NO. 250A-01-96M	
Scale: Not To Scale	Date: March, 1996
SHEET No. 1 OF 1 SHEETS	