

INDEX TO DRAWINGS	
SHEET NO.	DESCRIPTION
1	TITLE SHEET
2	STANDARD PLANS SUMMARY
3	GENERAL NOTES
4	TYPICAL SECTION AND DETAILS
5-20	ROADWAY PLANS
21	PAVEMENT MARKING LEGEND & NOTES
22	SIGN DETAILS AND NOTES
23	RECONSTRUCTION AREA SCHEDULE AND DETAILS
24	SIGN SCHEDULE
25	MISCELLANEOUS SCHEDULES
26	CONSTRUCTION SIGN PLAN AND SCHEDULE

STATE OF HAWAII

DEPARTMENT OF TRANSPORTATION

HIGHWAYS DIVISION

HONOLULU, HAWAII

"AS-BUILT"

PLANS FOR

KOHALA MOUNTAIN ROAD RESURFACING



IKI ROAD TO KAHUA

PROJECT NO. 250A-01-96M


DISTRICT OF NORTH KOHALA

ISLAND OF HAWAII

FED. ROAD DIST. NO.	STATE	PROJ. NO.	FISCAL YEAR	SHEET NO.	TOTAL SHEETS
HAWAII	HAW.	250A-01-96M	1996	1	26

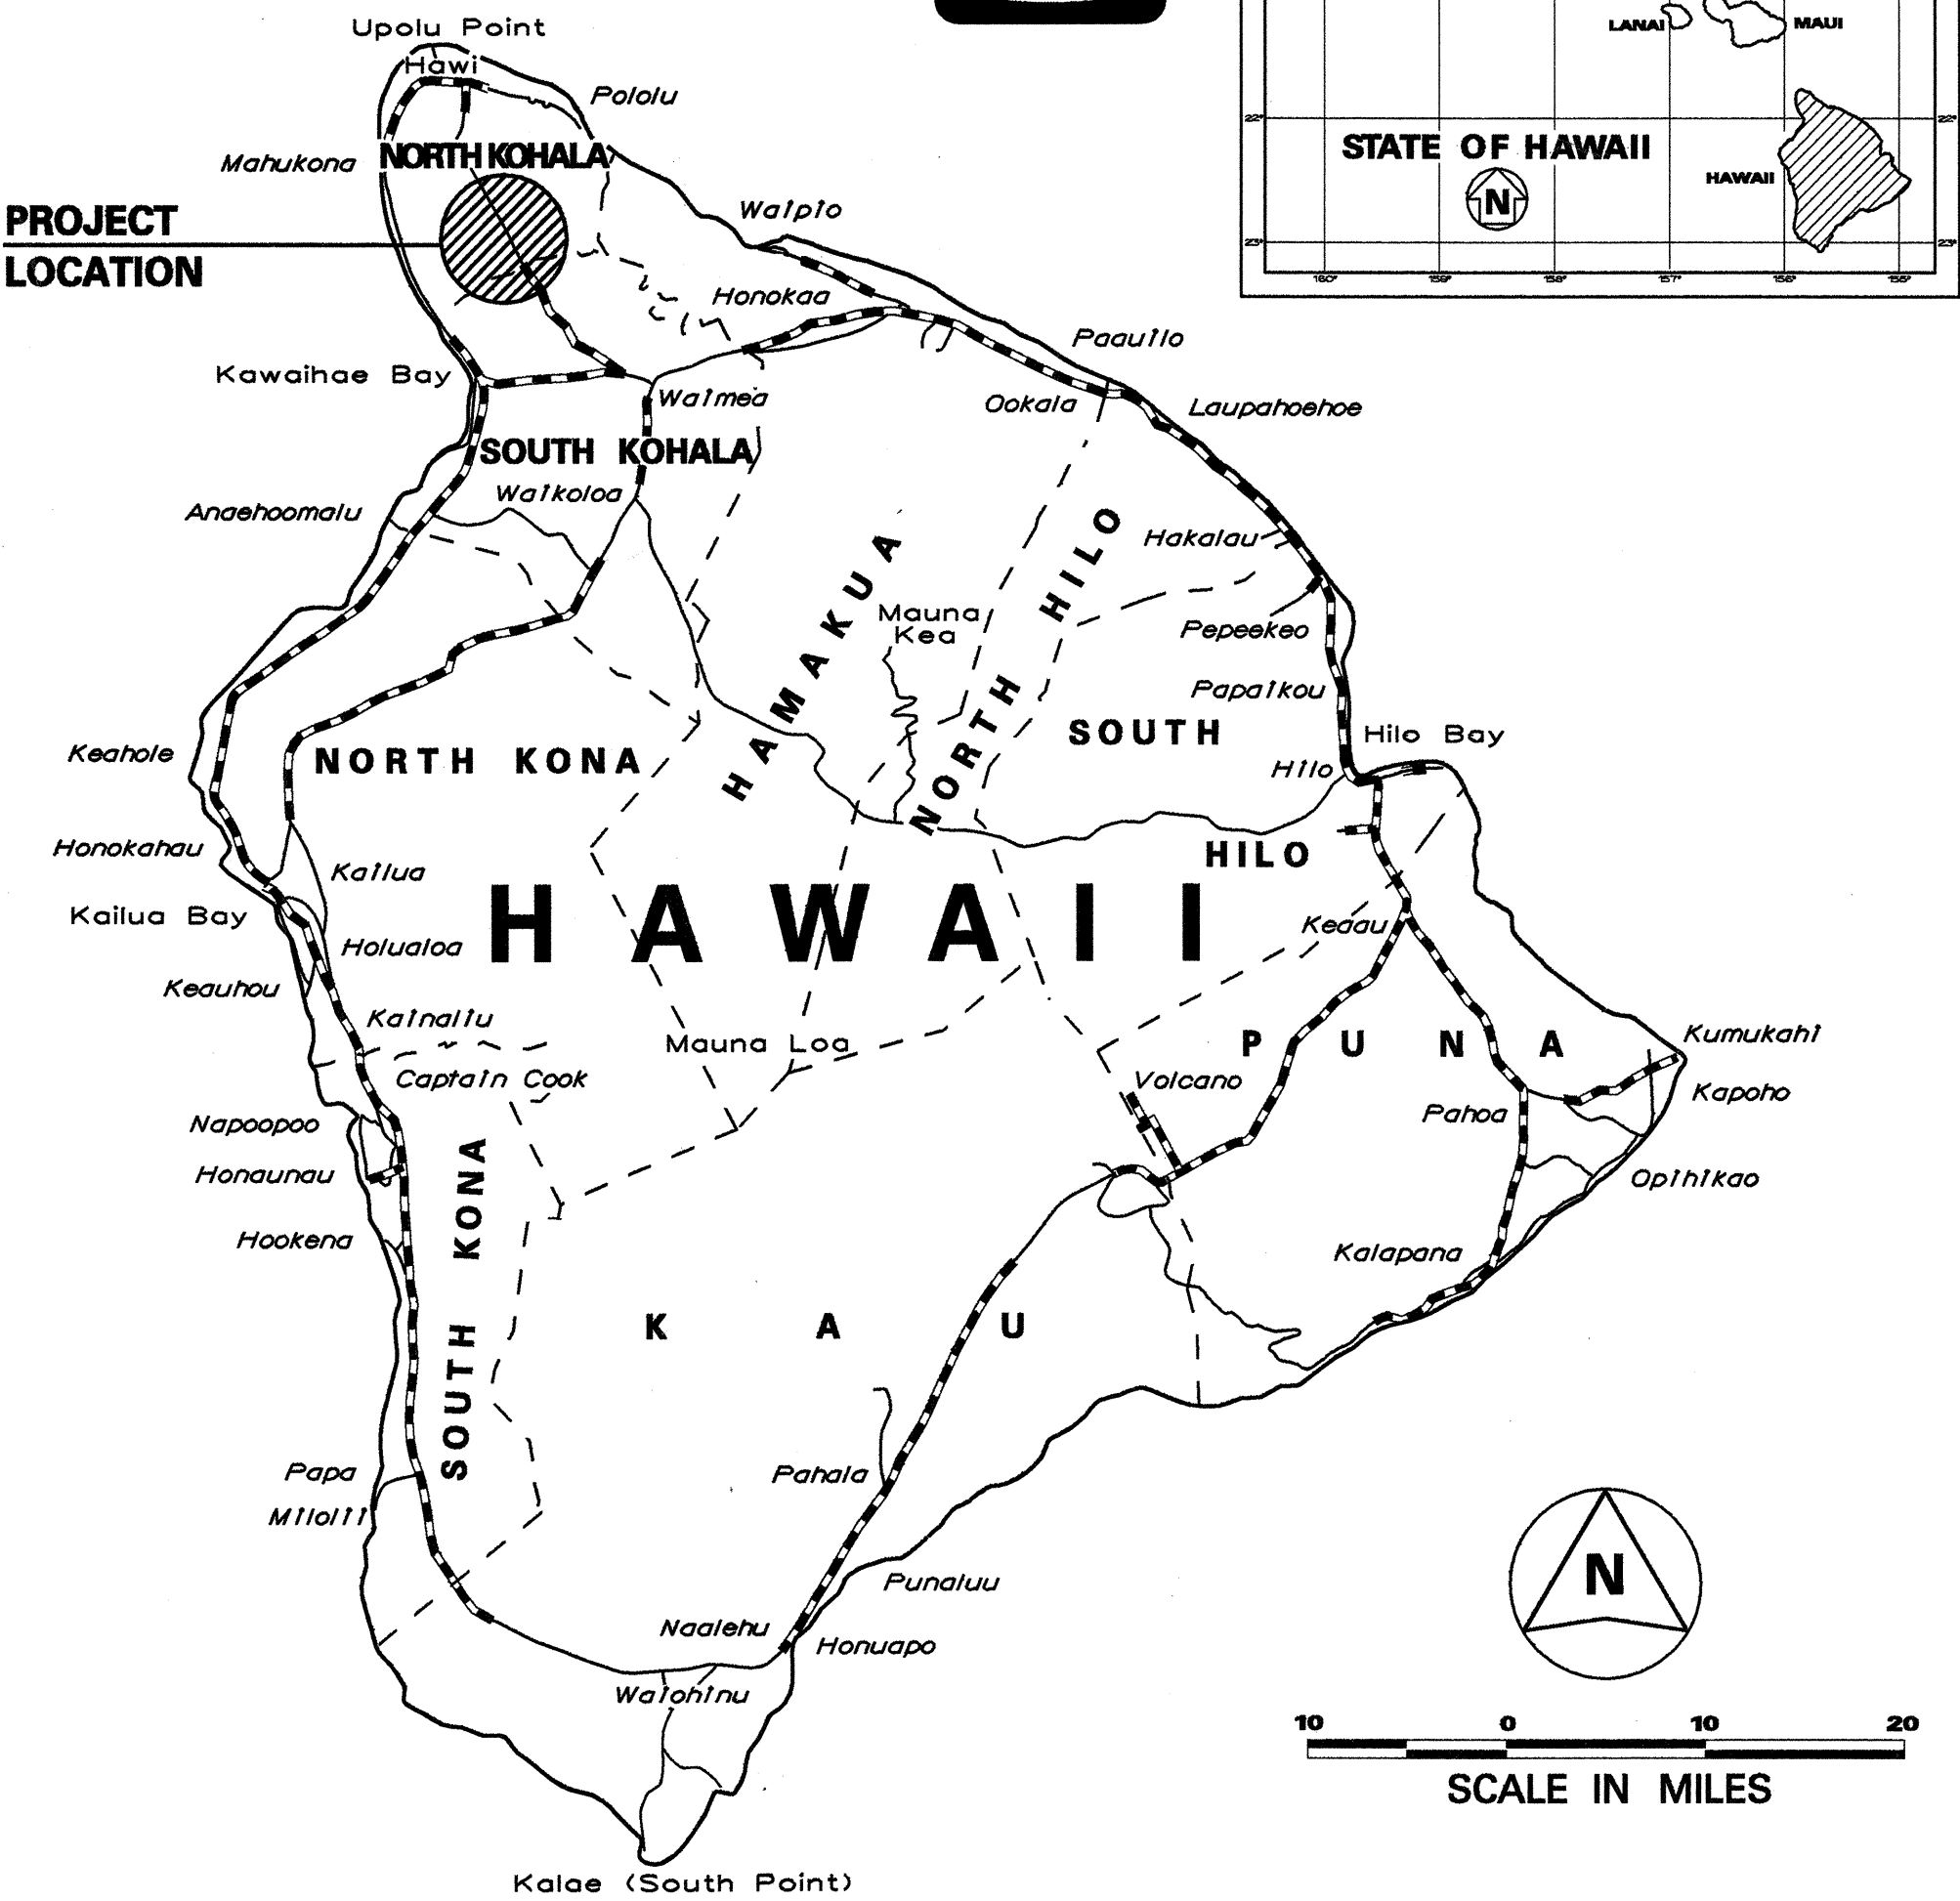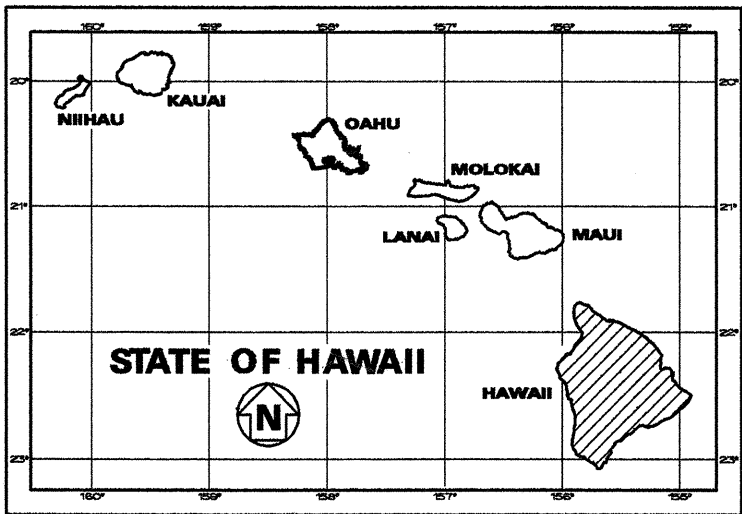


PACIFIC OCEAN

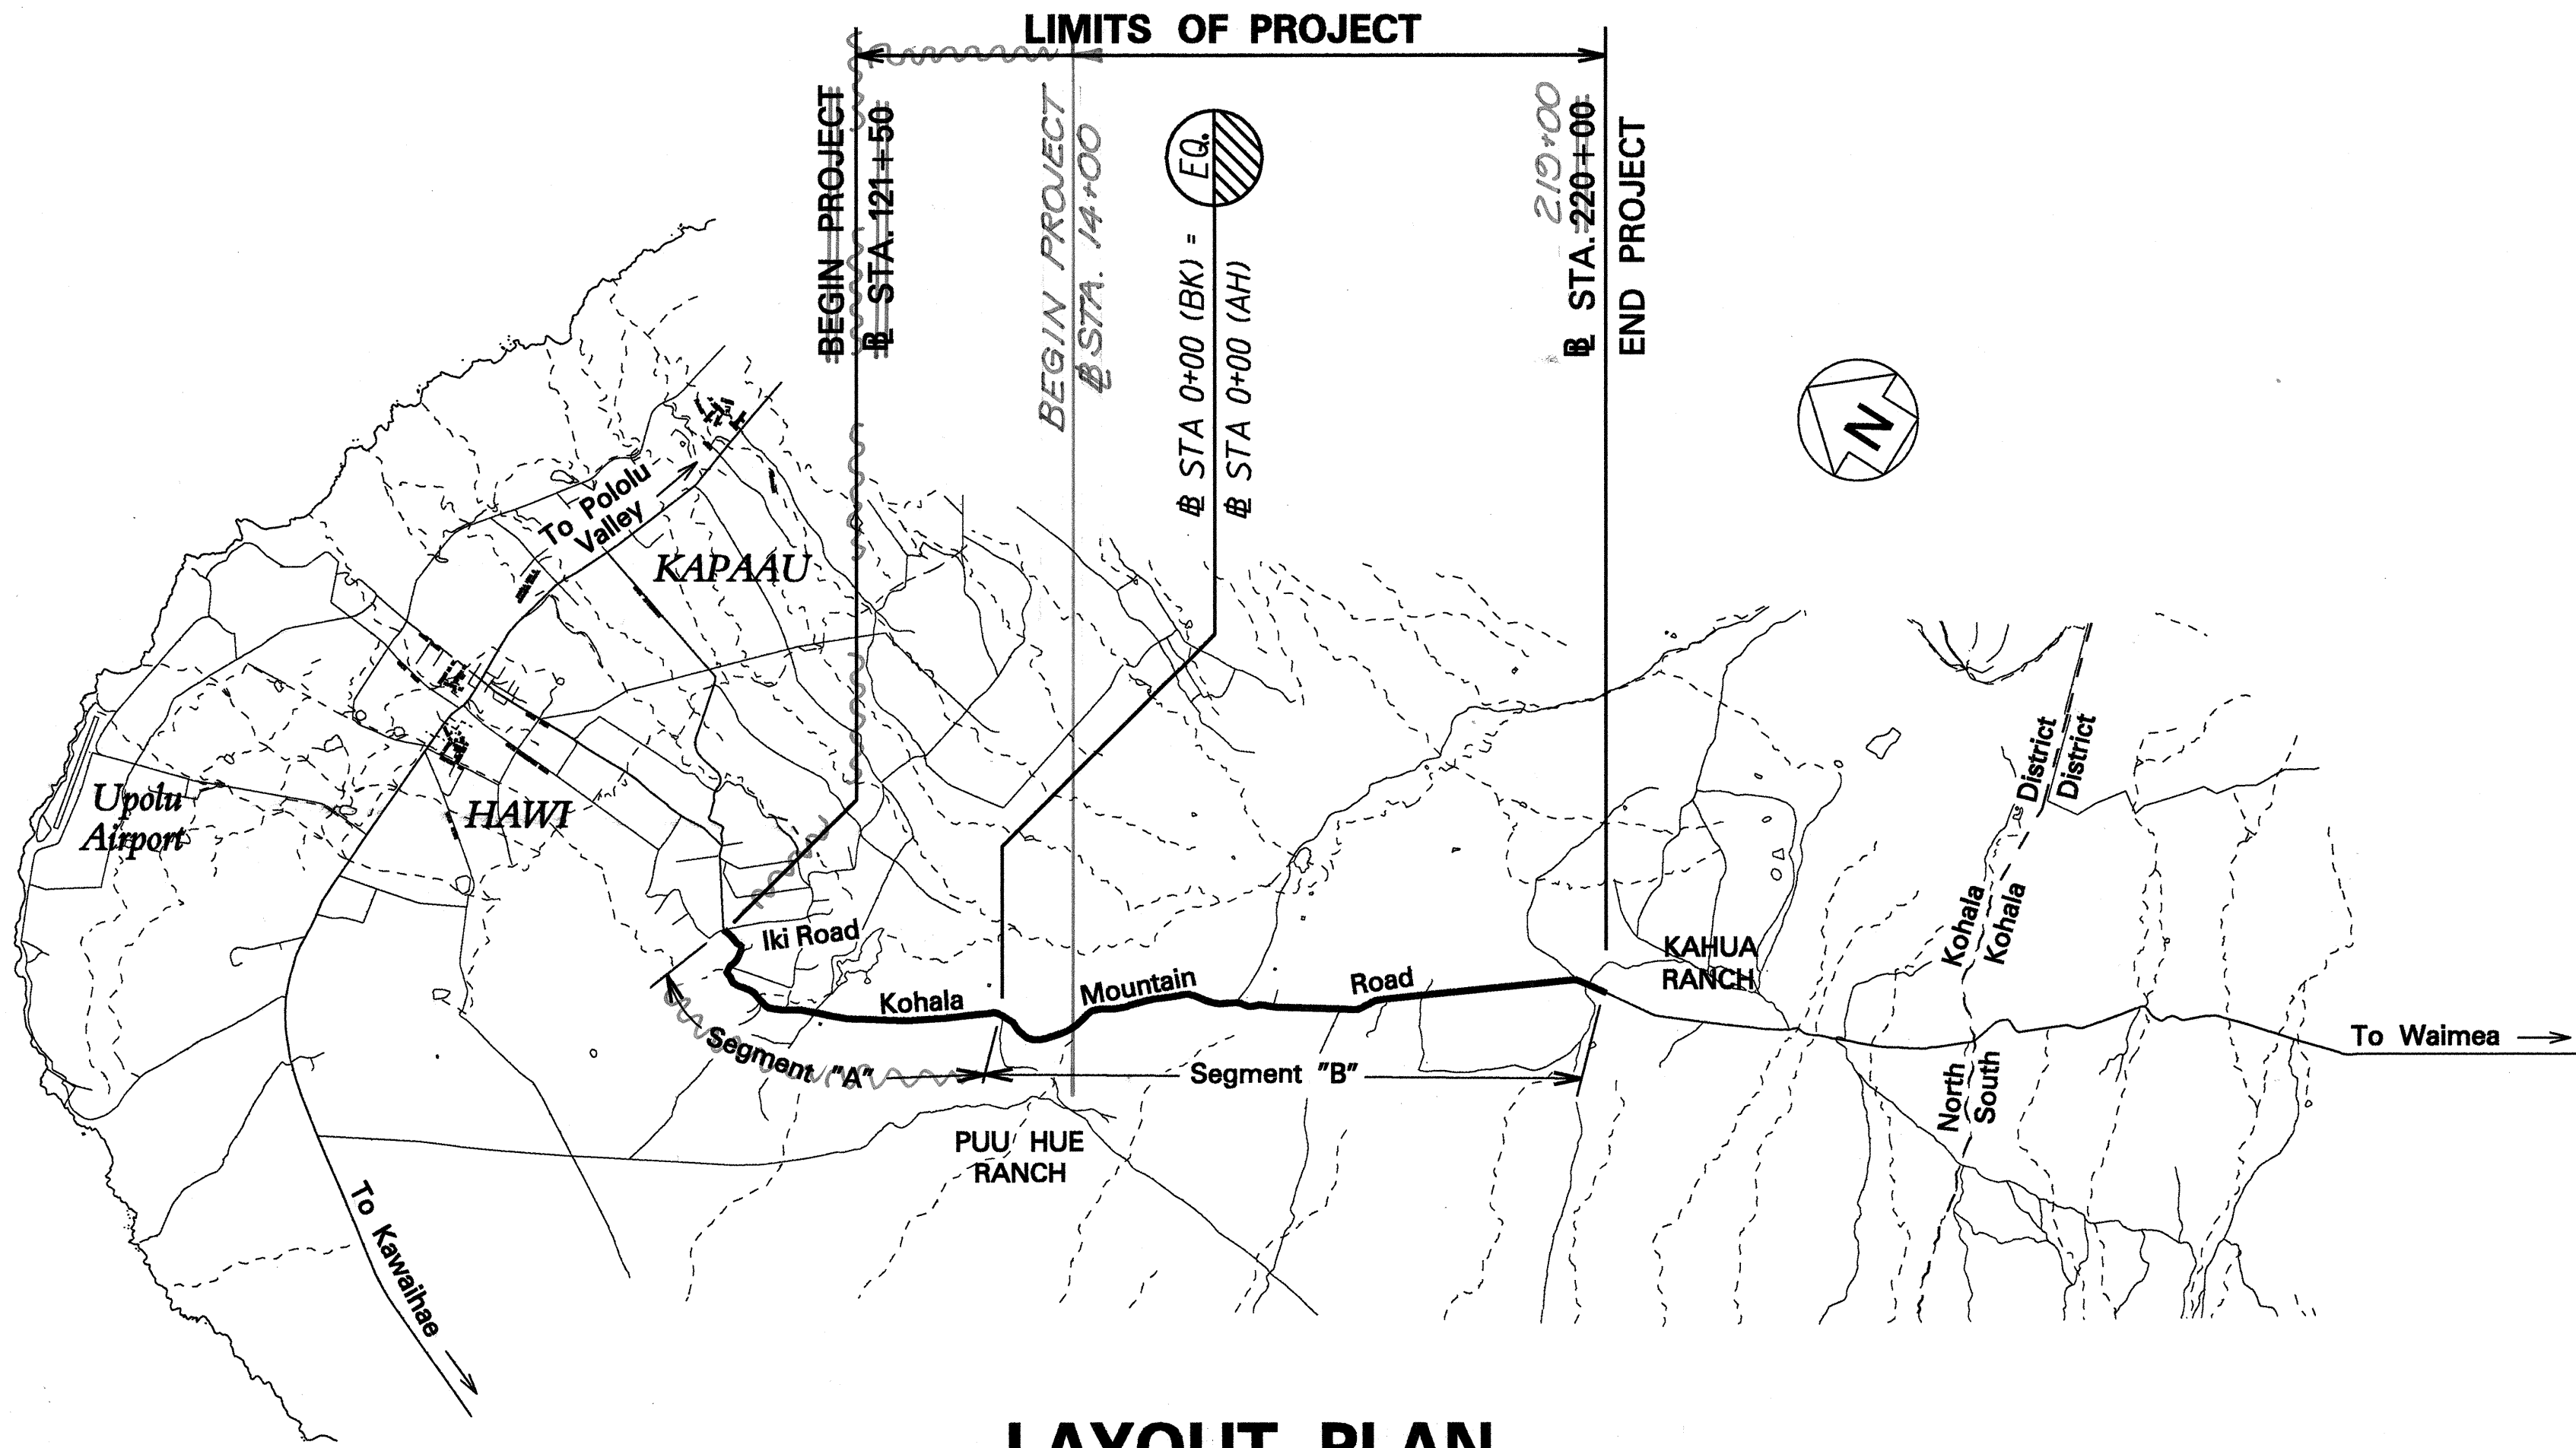

LAYOUT PLAN

GROSS LENGTH OF PROJECT.....6.47 MILES
NET LENGTH OF PROJECT.....6.47 MILES

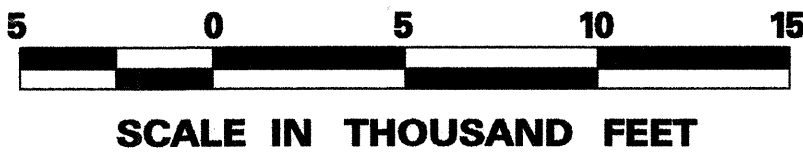

FEDERAL AID PROJECTS PREVIOUSLY CONSTRUCTED OR UNDER CONSTRUCTION

MILE POST ~~16.83~~ TO MILE POST ~~13.00~~

CHANGES MADE DURING CONSTRUCTION HAVE BEEN INCORPORATED ON THESE PLANS EXCEPT CHANGES IN THE ORIGINAL THEORETICAL QUANTITIES. FOR ACTUAL QUANTITIES, REFER TO PROJECT LEDGER AND/OR COMPUTATION BOOK.

RESIDENT ENGINEER DATE

DEPARTMENT OF TRANSPORTATION
STATE OF HAWAII

APPROVED: *[Signature]* 5/14/96
DIR. OF TRANSPORTATION DATE

HAWAII DISTRICT DESIGNED BY KEVIN ITO P.S. & E. BY 587-2238 PHONE MARCH, 1996 DATE