

FED. ROAD DIST. NO.	STATE	PROJ. NO.	FISCAL YEAR	SHEET NO.	TOTAL SHEETS
HAWAII	HAW.	250A-01-02M	2002	33	34

ROUTE AND MILEPOST MARKER SCHEDULE							
SEGMENT	STATION	MAUKA	MAKAI	ROUTE MARKER SIGN NO. (ROUTE NO.)	REMOVE	INSTALL TYPE A ASSEMBLY	RM-3 WO/ POST
A		Right	Left				
	71+20	●	●	MI-6C (250)	2	2	2
B		Left	Right				
	4+00	●	●	MI-6C (250)	2	2	2
	80+00	●	●	MI-6C (250)	2	2	2
	155+00	●	●	MI-6C (250)	2	2	2
				TOTALS	8	8 *	8
CONTRACT ITEM NUMBER						621.6110	621.4030

* - State Provided Materials

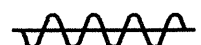
REFLECTOR MARKER SUMMARY	
DESCRIPTION	QUANTITY
RM - 3 (Yellow) Flex Post (Yellow Post) CONTRACT ITEM NO. 621.4130	12
RM - 3 (Yellow) Flex Post (Yellow Post) - State Provided Material CONTRACT ITEM NO. 621.4135	61
RM - 3 (Yellow) Flex Post (Bi-Directional, Yellow Post) CONTRACT ITEM NO. 621.4630	1
RM - 3 (Yellow) Flex Post (Bi-Directional, Yellow Post) - State Provided Material CONTRACT ITEM NO. 621.4635	5 82
TYPE II OBJECT MARKER Without Post CONTRACT ITEM NO. 621.4700	36

SEGMENT	STATION	MAUKA	MAKAI	MILE POST D10-2 (10"X27") MILE POST NO. (RTE. NO.)	REMOVE	INSTALL WITH POST (Bi-Dir)	RM-3 WO/ POST
A		Right	Left				
	97+60	●		19 (250)	1	1	
	45+30	●		18 (250)/29 km *	1	1	
	8+00	●		17 (250)	1	1	
B		Left	Right				
	60+65	●		16 (250)	1	1	
	113+05	●		15 (250)	1	1	
	166+10	●		14 (250)	1	1	
	218+85	●		13 (250)/21 km **	1	1	
CONTRACT ITEM NUMBER 621.7610				TOTALS	7	7	

** Contractor shall submit shop drawings of the kilometer-post sign to the Engineer for acceptance. Fabrication and installation of these signs shall be considered incidental to various sign items.

UTILITY SCHEDULE					
SEGMENT	STATION	OFFSET FROM O.B.L. ∇		TYPE	REMARKS
		MAUKA	MAKAI		
A		Right	Left		
	118+30	8		WV	1.2' x 1.4'
	118+25	12		WV	1.2' x 1.4'
	101+60	27		WV	1.1' x 1.7'
	101+55	29		WV	1.1' x 1.7'
B		Left	Right		
Legend : (●) WV = Water Valve 4 Total ***					

*** CONTRACT ITEM NO. 604.4550

LEGEND FOR AS-BUILT POSTINGS	
	Squiggly line for as-built deletion
	Double line for as-built deletion
Roadway	Text for as-built posting

STATE OF HAWAII DEPARTMENT OF TRANSPORTATION HIGHWAYS DIVISION
MISCELLANEOUS SCHEDULES
KOHALA MOUNTAIN ROAD RESURFACING IKI ROAD TO KAHUA PROJECT NO. 250A-01-02M
Date: March, 2002
SHEET No. 1 OF 1 SHEETS

"AS-BUILT"