

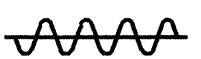
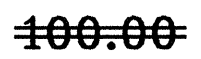
FED. ROAD DIST. NO.	STATE	PROJ. NO.	FISCAL YEAR	SHEET NO.	TOTAL SHEETS
HAWAII	HAW.	250A-01-02M	2002	29	34

SIGN REPLACEMENT, REMOVAL, AND INSTALLATION SCHEDULE

STATION	MAUKA (Right)	MAKAI (Left)	TYPE	SIGN TO REMAIN	REMOVE	INSTALL (10 SQ. FT. OR LESS)		DESTINATION SIGN PANEL (S.F.)	RM-3 WO/ POST
						W/POST	WO/POST		
Segment A									
119+90		●	W (Caution: Windy Road....)	1					
119+85		●	W1-8 (Bi-Directional)		1				
119+50		●	W1-8 (Bi-Directional)		1	1	1		
119+15		●	W1-8 (Bi-Directional)		1				
118+80 to 117+40		●	W1-8 (Bi-Directional)		1	3	3		
118+35		●	RI-1		1	1			1
118+25	●		RI-1/D3-1 (IKI RD.)		2	1	1		1
116+00		●	W1-5 (R)/W13-1 (25)			1	1		1
115+70	●		W2-2h(R)/W (Hidden Driveway) (24"x18")/D3-2 (IKI RD.)		2	1	2		1
115+30		●	W1-5 (R)/W13-1 (25)		2				
114+80	●		W1-2 (R)/W13-1 (25)		2	1	1		1
113+85	●		D-1 (Elevation/1500 ft/457 m) (30"x18")		1			3.75	1
113+75		●	D-1 (Elevation/1500 ft/457 m) (30"x18")		1			3.75	1
110+60 to 108+10	●		W1-8 (Bi-Directional)			6	6		
106+40	●		W1-2 (L)/W13-1 (25)			1	1		1
104+50		●	W2-2 (L)/W13-1 (25)		2	1	1		1
101+70	●		RI-1		1	1			1
101+75		●	W1-2 (L)/W13-1 (25)			1	1		1
100+20 to 98+20		●	W1-8 (Bi-Directional)			5	5		
97+59	●		W2-2 (R)/W13-1 (25)		2	1	1		1
95+55 to 93+55		●	W1-8 (Bi-Directional)			5	5		
90+00	●		W1-5 (R)/W13-1 (25)		2	1	1		1
84+50		●	W1-2 (L)/W13-1 (25)		2	1	1		1
80+20 to 78+80		●	W1-8 (Bi-Directional)			3	3		
73+95	●		W1-2 (R)/W13-1 (25)		2	1	1		1
46+00	●	●	R2-1 (35) (40)		1	2			2
7+30		●	W1-2 (R)/W13-1(25)		2	1	1		1
4+95		●	W2-2 (R)/W13-1(25)		1	1	1		1
1+55 to 0+75	●		W1-8 (Bi-Directional)			3	3		

STATION	MAUKA (Left)	MAKAI (Right)	TYPE	SIGN TO REMAIN	REMOVE	INSTALL (10 SQ. FT. OR LESS)		DESTINATION SIGN PANEL (S.F.)	RM-3 WO/ POST
						W/POST	WO/POST		
Segment B									
0+75		●	RI-1		1	1			1
2+20		●	WI-4 (R)/WI3-I(25)		2	1	1		1
2+50	●		WI-2 (L)/WI3-I(25)		2	1	1		1
2+70		●	"Adopt-A-Highway"	1					
5+50	●		W2-2 (L)/WI3-I(25)		1	1	1		1
5+60	●		"Adopt-A-Highway"	1					
5+95	●	●	D-2 (Elevation/2000 ft/610 m) (30"x18")		2			7.50	2
14+15	●		WI-4 (R)/WI3-I(25)		2	1	1		1
23+50		●	WI-5 (L)		2	1			1
43+00	●		WI-4 (L)		1				
50+00	●		WI-5 (R)		2	1			1
59+55	●	●	R2-1 (35) (40)		1	2			2
67+00		●	WI-2 (R)			1			1
75+00	●		WI-2 (L)			1			1
77+00		●	WI-2 (L)			1			1
85+70	●		WI-2 (R)			1			1
111+45	●	●	D-3 (Elevation/2500 ft/762 m) (30"x18")		2			7.50	2
115+85		●	"Adopt-A-Highway"	1					
116+05	●		"Adopt-A-Highway"	1					
121+35		●	WI-4 (L)/WI3-I(30)		2	1	1		1
128+35		●	WI-8 (Bi-Directional)			1	1		
128+80		●	WI-8 (Bi-Directional)		1				
129+15		●	WI-8 (Bi-Directional)			1	1		
129+25		●	WI-8 (Bi-Directional)		1				
129+95 to 130+75		●	WI-8 (Bi-Directional)			2	2		
135+85	●		WI-8 (Bi-Directional)		1				

(Continued)

LEGEND FOR AS-BUILT POSTINGS	
	Squiggly line for as-built deletion
	Double line for as-built deletion
Roadway	Text for as-built posting

STATE OF HAWAII
DEPARTMENT OF TRANSPORTATION
HIGHWAYS DIVISION

SIGN SCHEDULE

KOHALA MOUNTAIN ROAD RESURFACING
IKI ROAD TO KAHUA
PROJECT NO. 250A-01-02M

Date: March, 2002

SHEET No. 1 OF 2 SHEETS

ORIGINAL PLAN	SURVEY PLOTTED BY	DATE
NOTE BOOK	DRAWN BY	
2/1/03/250A-01-02M	DESIGNED BY	
2/1/03/250A-01-02M	CHECKED BY	
2/1/03/250A-01-02M		

"AS-BUILT"

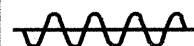
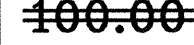
FED. ROAD DIST. NO.	STATE	PROJ. NO.	FISCAL YEAR	SHEET NO.	TOTAL SHEETS
HAWAII	HAW.	250A-01-02M	2002	30	34

SIGN REPLACEMENT, REMOVAL, AND INSTALLATION SCHEDULE									
STATION	MAUKA (Left)	MAKAI (Right)	TYPE	SIGN TO REMAIN	REMOVE	INSTALL (10 SQ. FT. OR LESS)		DESTINATION SIGN PANEL (S.F.)	RM-3 WO/ POST
						W/POST	WO/POST		
Segment B									
135+05 to 137+70	●		W1-8 (Bi-Directional)		1	4	4		
142+05	●		W1-2 (L)/W13-1 (30)		2	1	1		1
165+30	●	●	R2-1 (35) (40)	2	2	2			2
166+10		●	W (Horse and Ranch Xing)	1					
200+00		●	W1-2 (R)/W13-1 (30)			1	1		1
204+00 to 206+80	●		W1-8 (Bi-Directional)			5	5		
209+50	●		W1-2 (L)/W13-1 (30)			1	1		1
218+70	●		"Adopt-A-Highway"	1					
219+65		●	"Adopt-A-Highway"	1					
TOTALS				10 8	56 58	73 75	61	22.50	42
(CONTRACTOR PROVIDED MATERIAL) SUBTOTALS				10	56	21	18	22.50	42
CONTRACT ITEM NUMBER						621.5100	621.5000	621.0200	621.4030
(STATE PROVIDED MATERIAL) SUBTOTALS						52	43		
CONTRACT ITEM NUMBER						621.5110	621.5010		

NOTE:

1. See sheet 28 for Sign Details and Notes.

ORIGINAL PLAN	SURVEY PLOTTED BY _____		DATE _____
	DRAWN BY <u>X</u> _____		
NOTE BOOK <u>1016455011</u>	TRACED BY _____		•
	DESIGNED BY <u>X</u> _____		•
	QUANTITIES BY _____		•
	CHECKED BY _____		•

LEGEND FOR AS-BUILT POSTINGS	
	Squiggly line for as-built deletion
	Double line for as-built deletion
Roadway	Text for as-built posting

STATE OF HAWAII
DEPARTMENT OF TRANSPORTATION
HIGHWAYS DIVISION

SIGN SCHEDULE

KOHALA MOUNTAIN ROAD RESURFACING
IKI ROAD TO KAHUA
PROJECT NO. 250A-01-02M

Date: March, 2002

SHEET No. 2 OF 2 SHEETS