

INDEX TO DRAWINGS	
SHEET NO.	DESCRIPTION
1	TITLE SHEET
2	STANDARD PLANS SUMMARY
3	GENERAL NOTES
4	TYPICAL SECTION AND DETAILS
5	RECONSTRUCTION AREA SCHEDULE AND DETAILS
6 - 7	WATER POLLUTION AND EROSION CONTROL NOTES
8 - 23	ROADWAY PLANS
24	PAVEMENT MARKING LEGEND & NOTES
25 - 27	STRIPING AND PAVEMENT MARKING SCHEDULE
28	SIGN DETAILS AND NOTES
29 - 30	SIGN SCHEDULE
31 - 32	CENTERLINE AND REFERENCE SURVEY MONUMENT SCHEDULE
33	MISCELLANEOUS SCHEDULES
34	CONSTRUCTION SIGN PLAN AND SCHEDULE

SHEETS NO. ① 255-1, ② 265-1 AND ③ 275-1 ARE SUPPLEMENTAL TO THIS PROJECT. TOTAL SHEET COUNT AFTER "AS BUILT" POSTING IS 37 SHEETS.

STATE OF HAWAII

DEPARTMENT OF TRANSPORTATION

HIGHWAYS DIVISION

HONOLULU, HAWAII

"AS-BUILT"

PLANS FOR

KOHALA MOUNTAIN ROAD RESURFACING




IKI ROAD TO KAHUA

PROJECT NO. 250A-01-02M

DISTRICT OF NORTH KOHALA

ISLAND OF HAWAII

FED. ROAD DIST. NO.	STATE	PROJ. NO.	FISCAL YEAR	SHEET NO.	TOTAL SHEETS
HAWAII	HAW.	250A-01-02M	2002	1	34

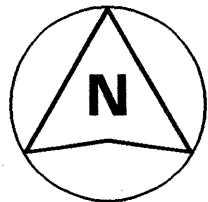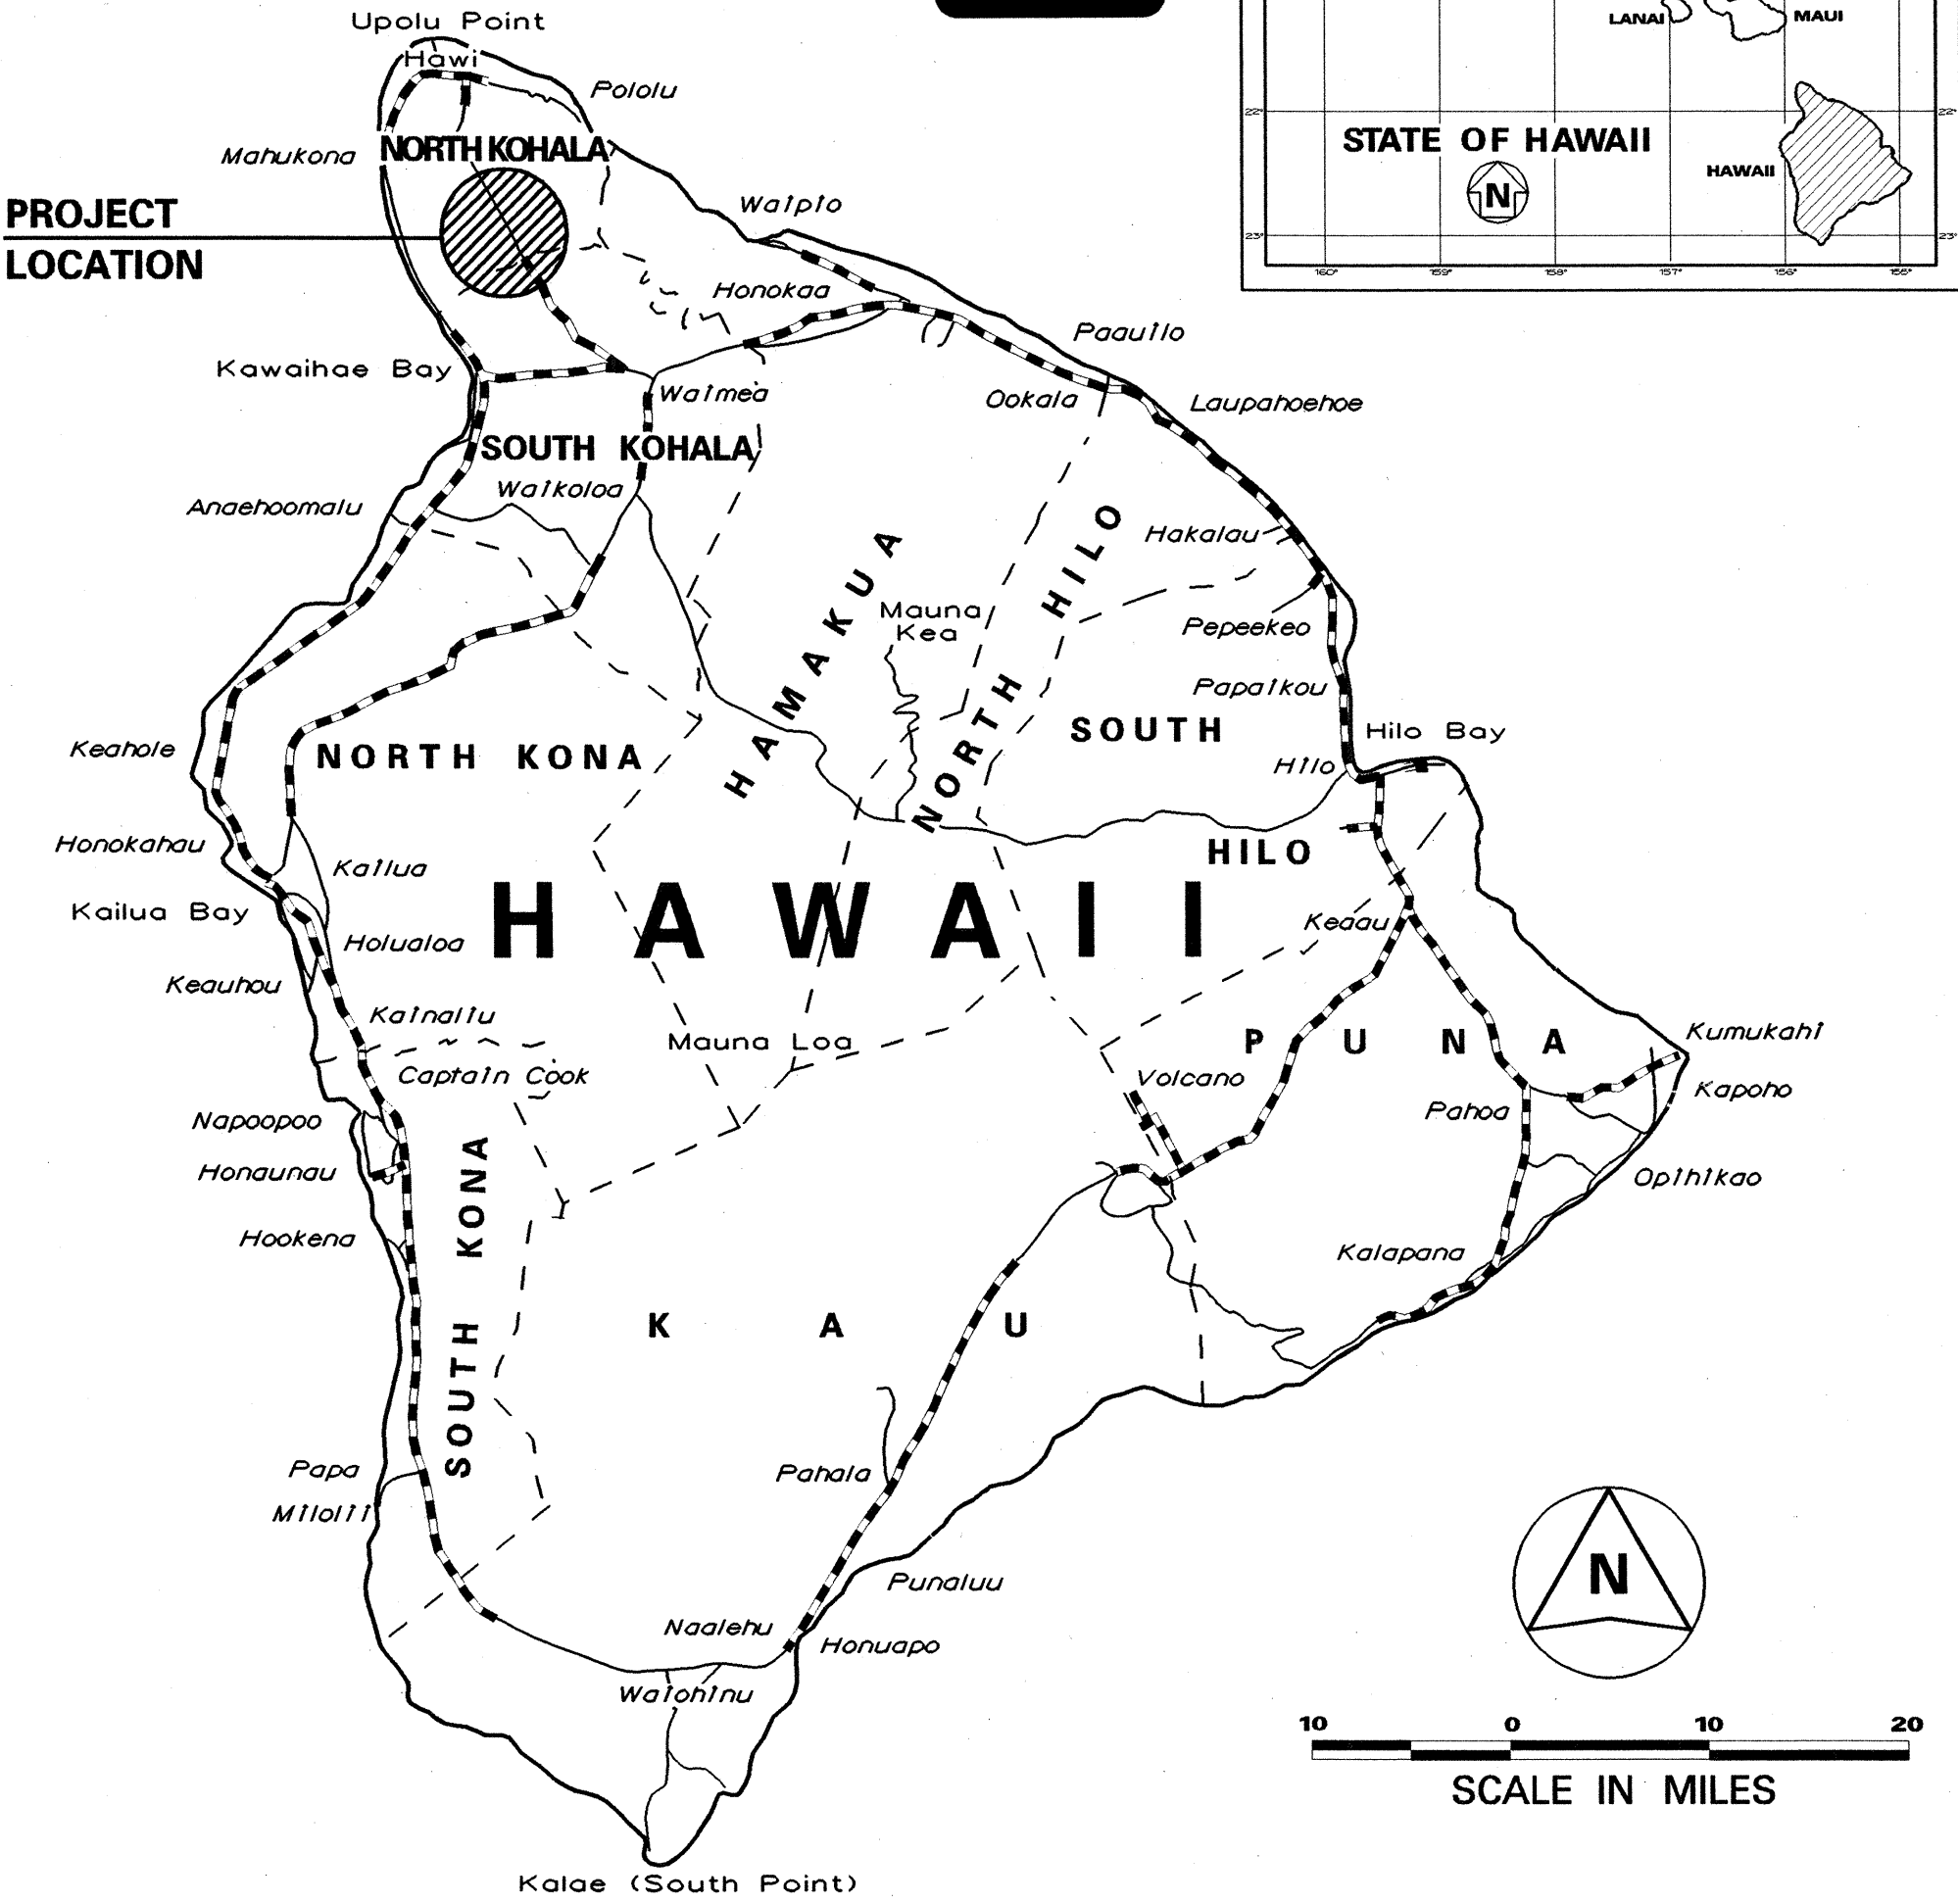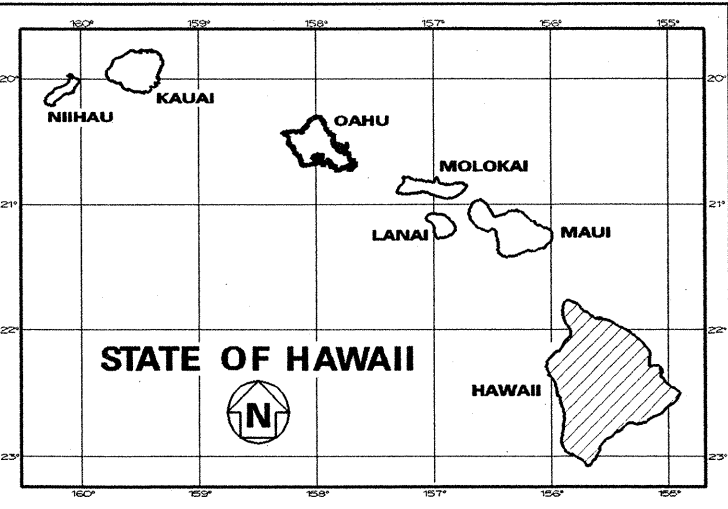

SCALE IN MILES


FEDERAL AID PROJECTS PREVIOUSLY CONSTRUCTED OR UNDER CONSTRUCTION

MILE POST 19.45 TO MILE POST 12.98

CHANGES MADE DURING CONSTRUCTION HAVE BEEN INCORPORATED ON THESE PLANS EXCEPT CHANGES IN THE ORIGINAL THEORETICAL QUANTITIES. FOR ACTUAL QUANTITIES, REFER TO PROJECT LEADER AND/OR COMPLETION BOOK.
Charles A. Scheraga 3-3-06
REQUEST CHANGES DATE

April, 2002 DATE
933-8866 PHONE
Robert Taira P. S. & E. BY
HAWAII DISTRICT DESIGNED BY

PACIFIC OCEAN

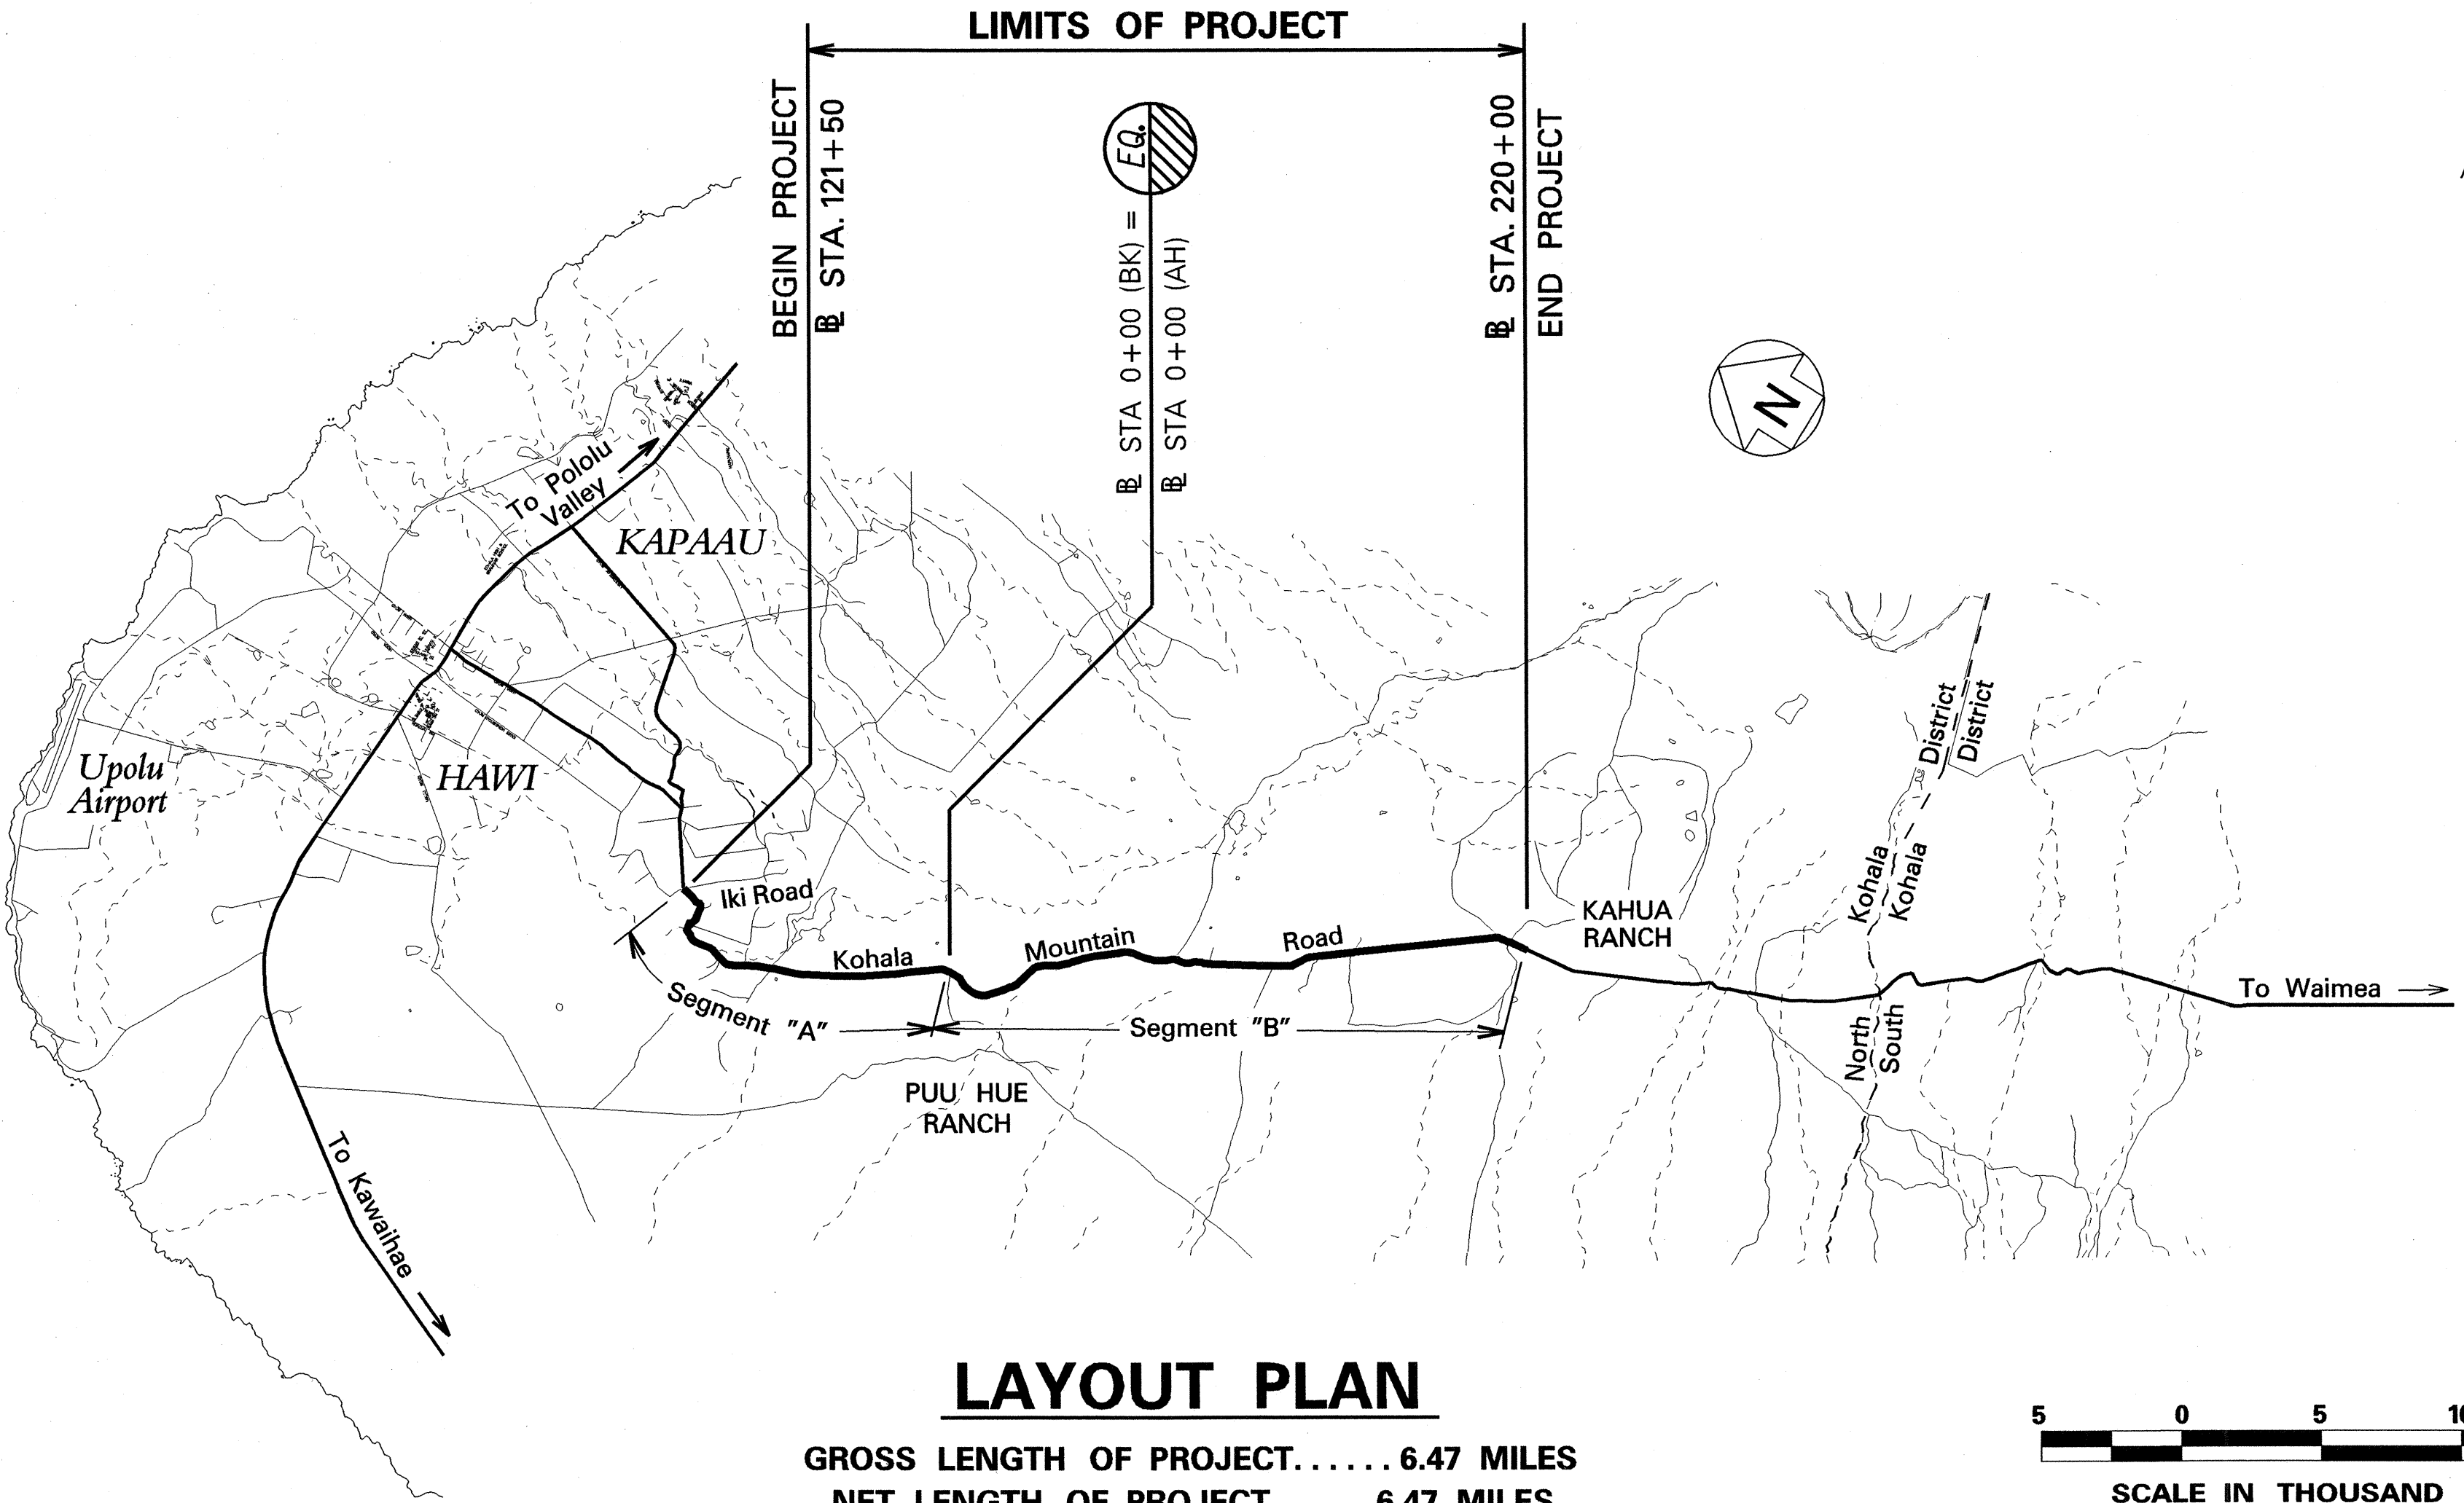

LAYOUT PLAN

GROSS LENGTH OF PROJECT.....6.47 MILES
NET LENGTH OF PROJECT.....6.47 MILES

SCALE IN THOUSAND FEET

DEPARTMENT OF TRANSPORTATION
STATE OF HAWAII

APPROVED:

for DIR. OF TRANSPORTATION 5-13-02 DATE