

INDEX TO DRAWINGS	
SHEET NO.	DESCRIPTION
1	TITLE SHEET
2	STANDARD PLAN SUMMARY
3-4	GENERAL NOTES
5-6	WATER POLLUTION & EROSION CONTROL NOTES
7	TYPICAL SECTIONS & DETAILS
8-27	ROADWAY PLAN & PROFILE
28	PAVEMENT MARKING, LEGEND, DETAILS & NOTES
29	SIGNAGE NOTES
30-40	SIGNING AND STRIPING PLAN
41	SIGN SCHEDULE
42	GUARDRAIL SCHEDULE
43	REFLECTOR & OBJECT MARKER AND STRIPING SCHEDULE
44	WORK ZONE SIGNING PLAN, NOTES AND DETAILS
45	GABION WALL DETAIL
46	DRAIN INLET RECONSTRUCTION DETAIL
47	GUARDRAIL DETAIL AND NOTES
48	STRONG POST W-BEAM GUARDRAIL
49	FLEAT-350
50-51	MODIFIED TYPE "A-1" FLARE
52	FLARE TYPE "G" MODIFIED GUARDRAIL
53	REFLECTOR MARKER DETAIL
54-55	CROSS SECTION

STATE OF HAWAII

DEPARTMENT OF TRANSPORTATION

HIGHWAYS DIVISION

HONOLULU, HAWAII

"AS-BUILT"

PLANS FOR



KOHALA MOUNTAIN ROAD PAVEMENT REPAIRS

WAIKA JUNCTION TOWARD HAWI


PROJECT NO. 250A-01-06M

DISTRICT OF SOUTH KOHALA

ISLAND OF HAWAII

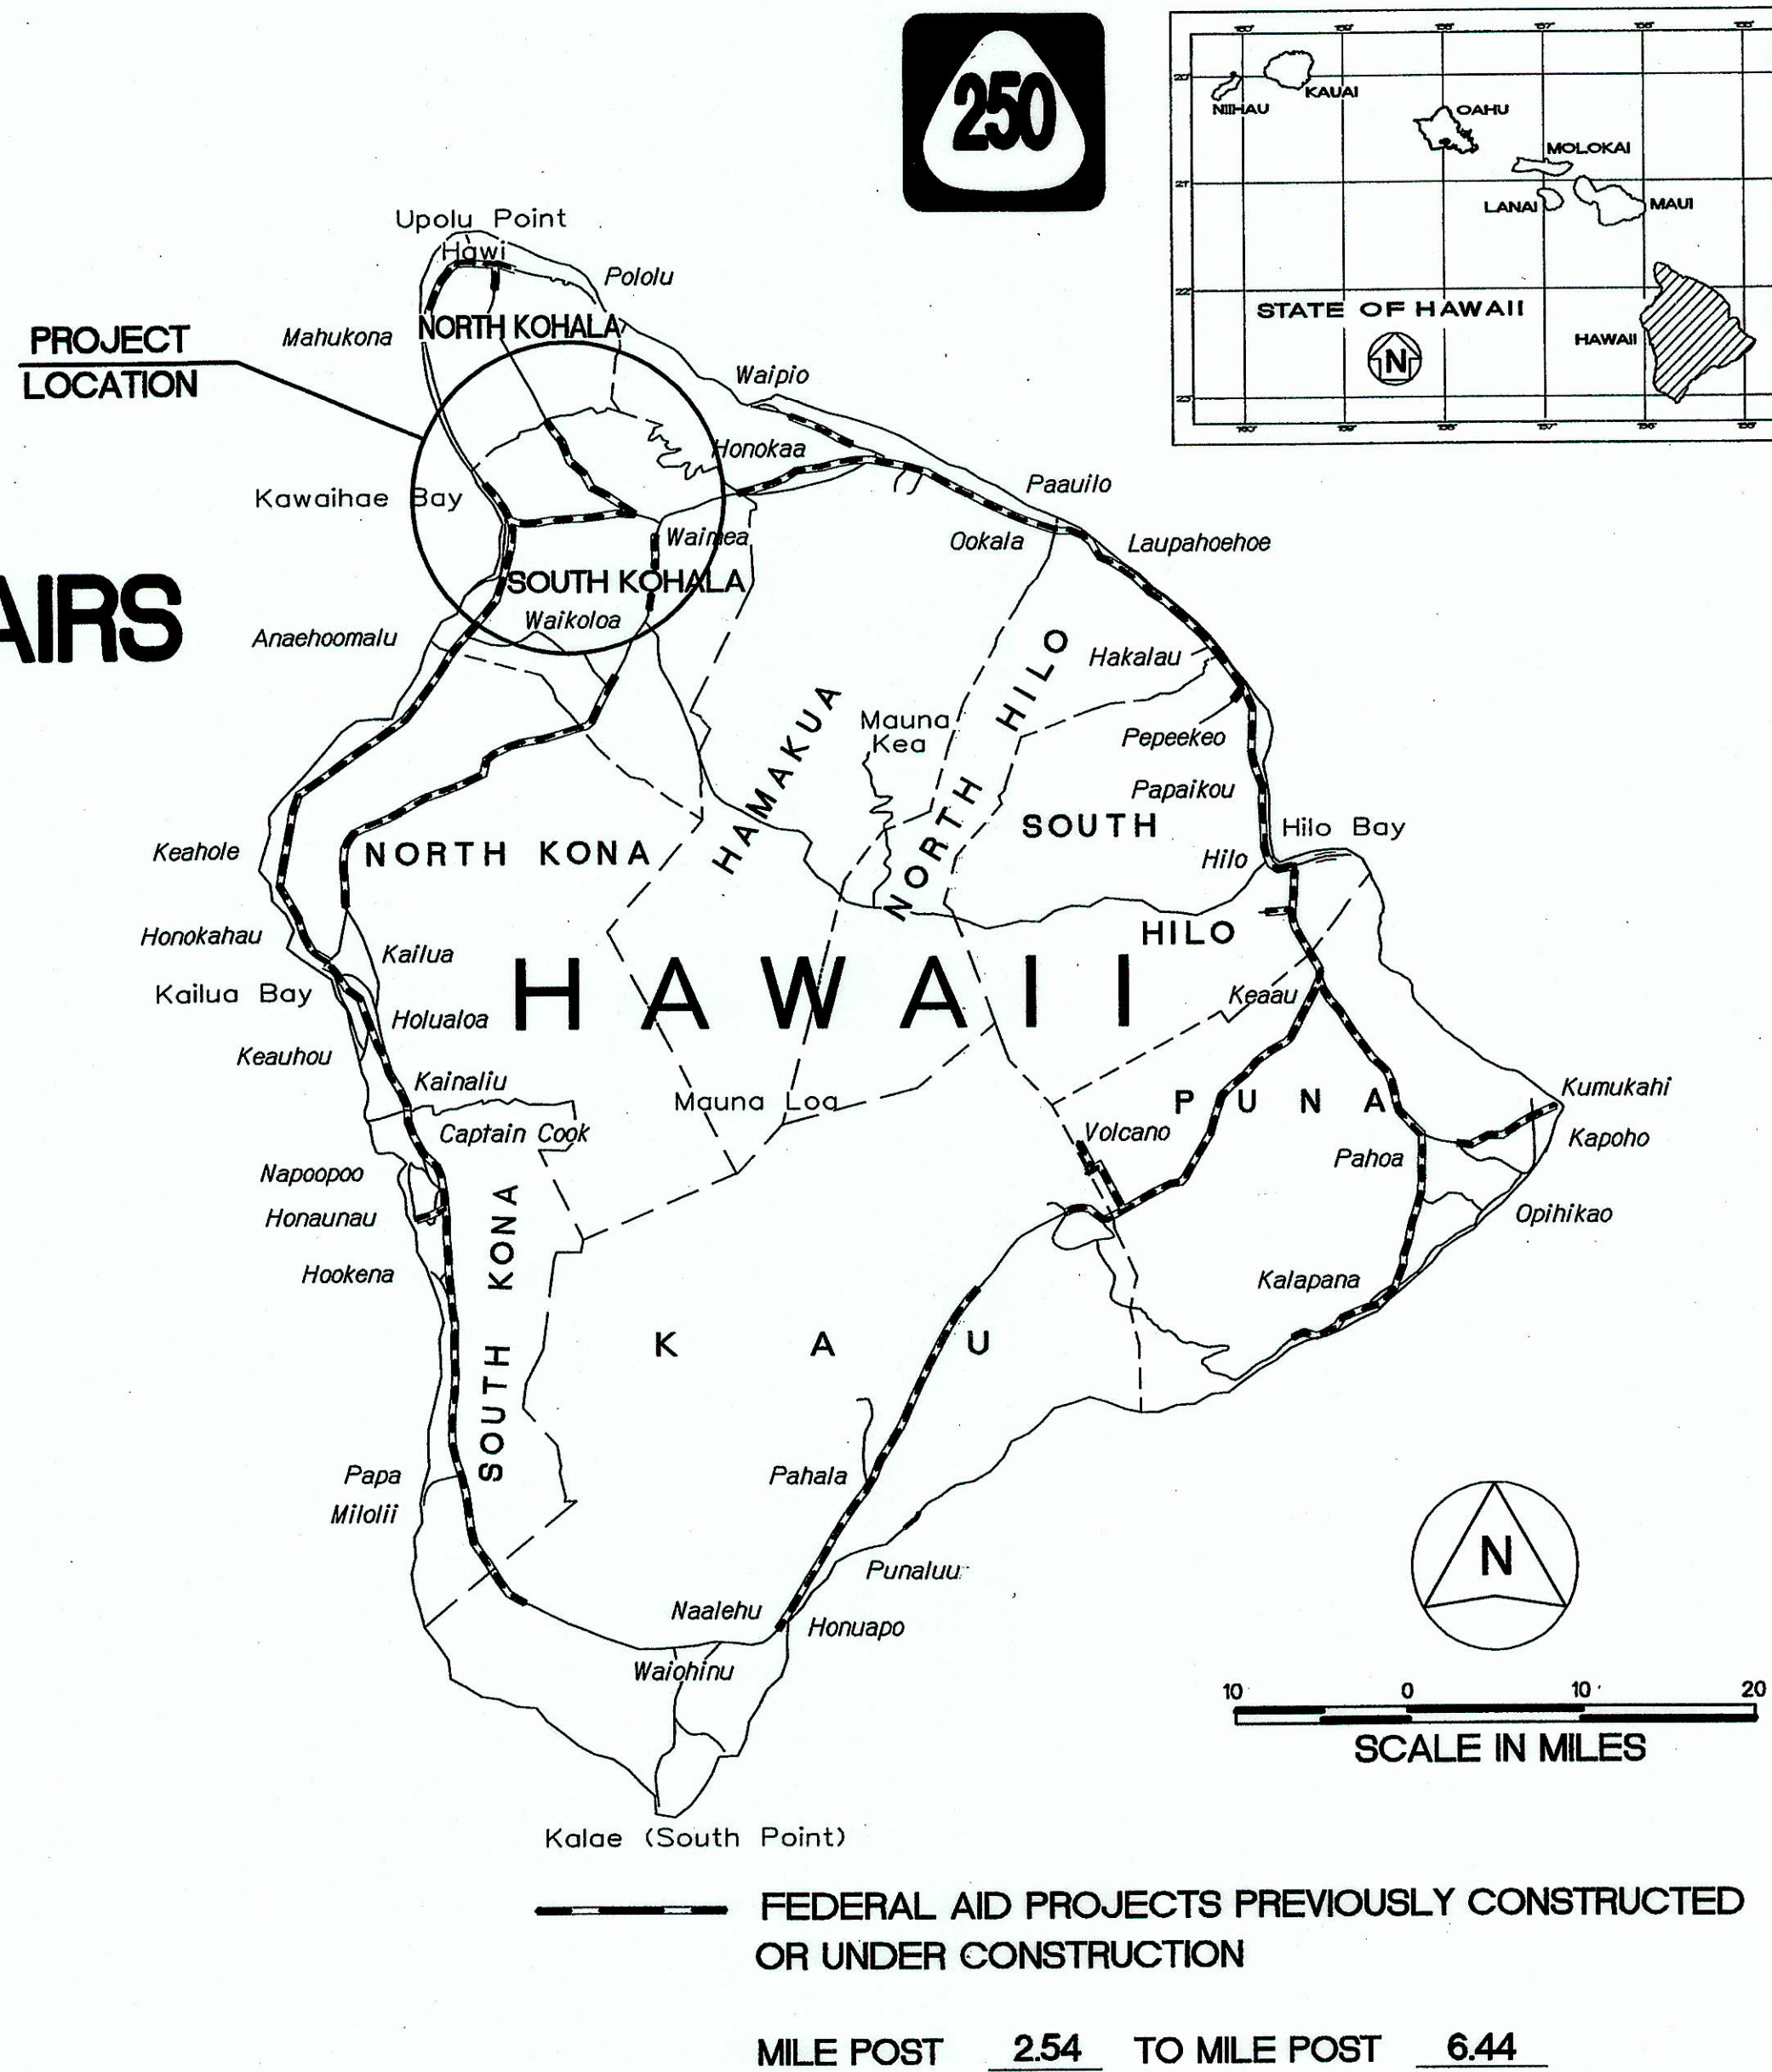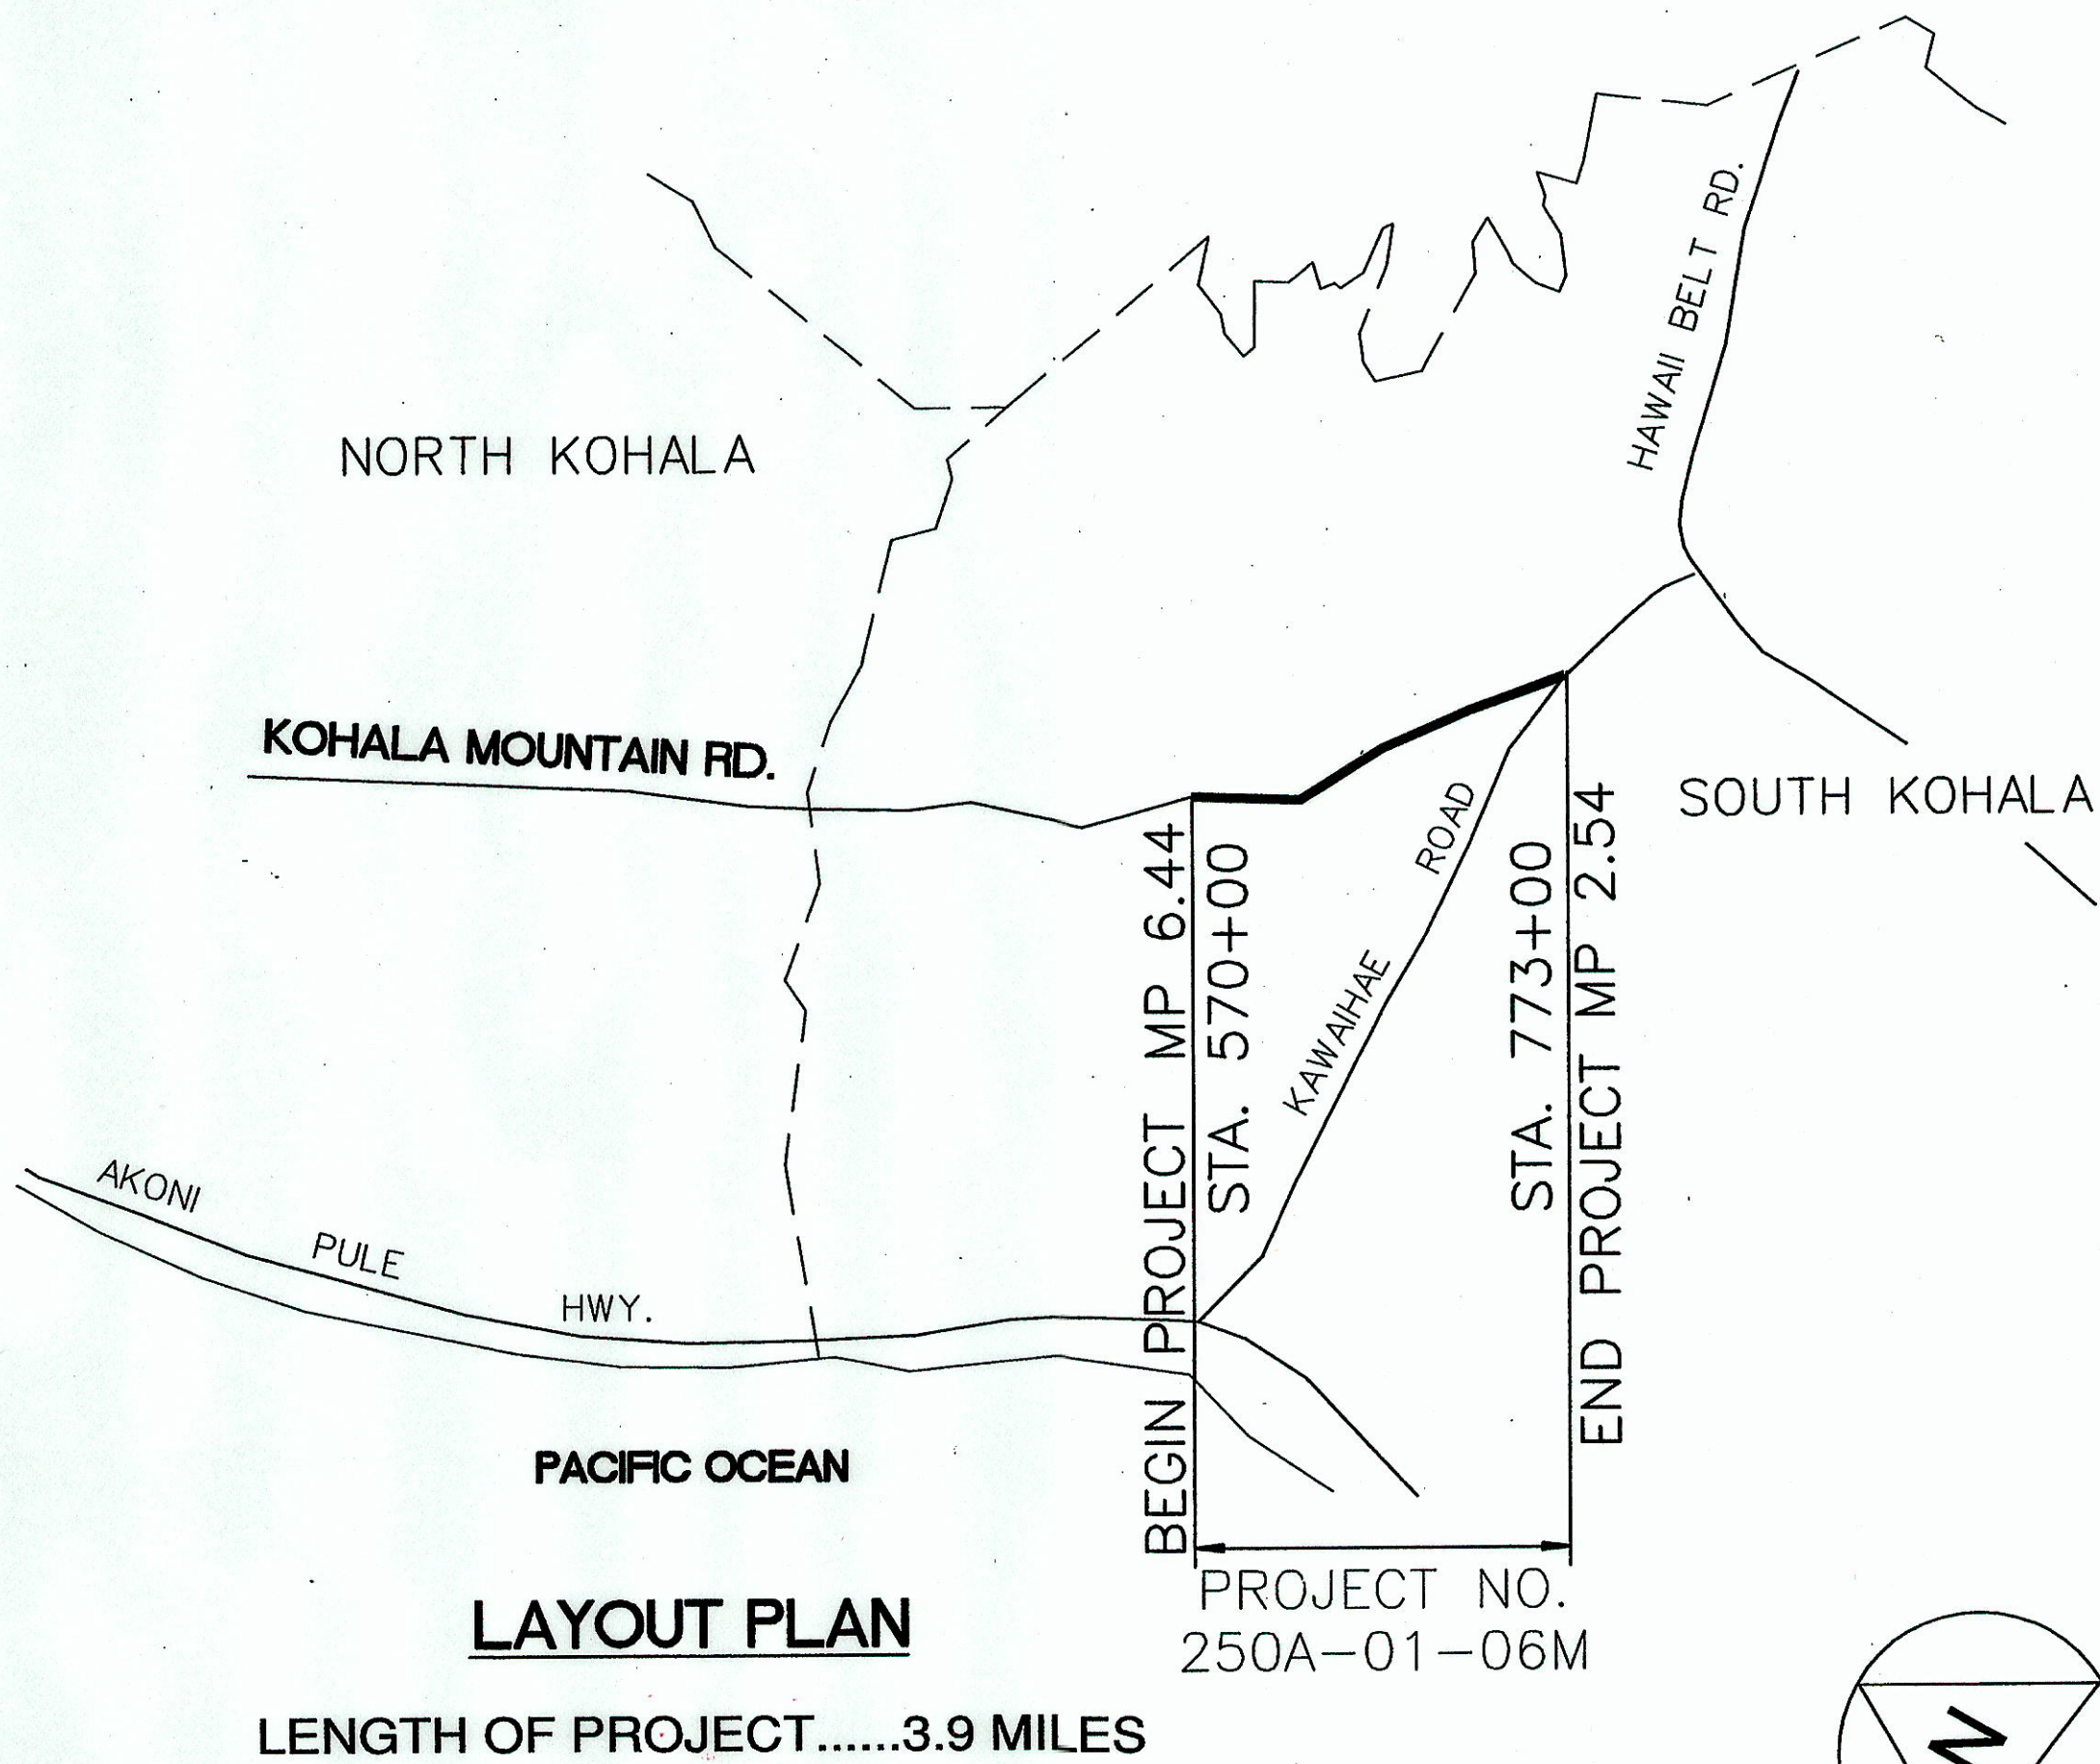

FED. ROAD DIST. NO.	STATE	PROJ. NO.	FISCAL YEAR	SHEET NO.	TOTAL SHEETS
HAWAII	HAW.	250A-01-06M	2009	1	55

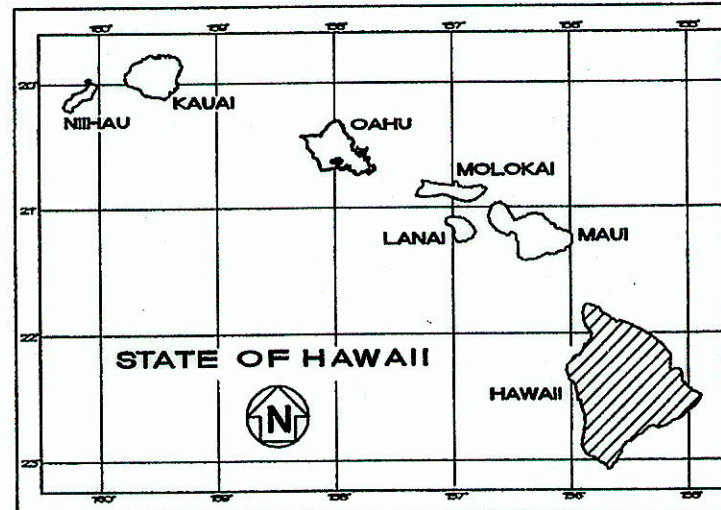

DESIGNED BY
WESLEY R. SEGAWA & ASSOC.

MANAGED BY
HWY-H

PHONE
933-8866

DATE
APRIL 2009

NO SIGNIFICANT CHANGES WERE MADE DURING CONSTRUCTION ON THESE PLANS EXCEPT CHANGES IN THE ORIGINAL THEORETICAL QUANTITIES FOR ACTUAL QUANTITIES, REFER TO PROJECT LOGS AND AS-BUILT RECORDS.

K. R. du 0/24/13

DEPARTMENT OF TRANSPORTATION
STATE OF HAWAII

APPROVED:
S. D. on 5-13-09
DIR. OF TRANSPORTATION DATE