



FED. ROAD DIST. NO.	STATE	PROJ. NO.	FISCAL YEAR	SHEET NO.	TOTAL SHEETS
HAWAII	HAW.	250A-02-09	2012	12	14

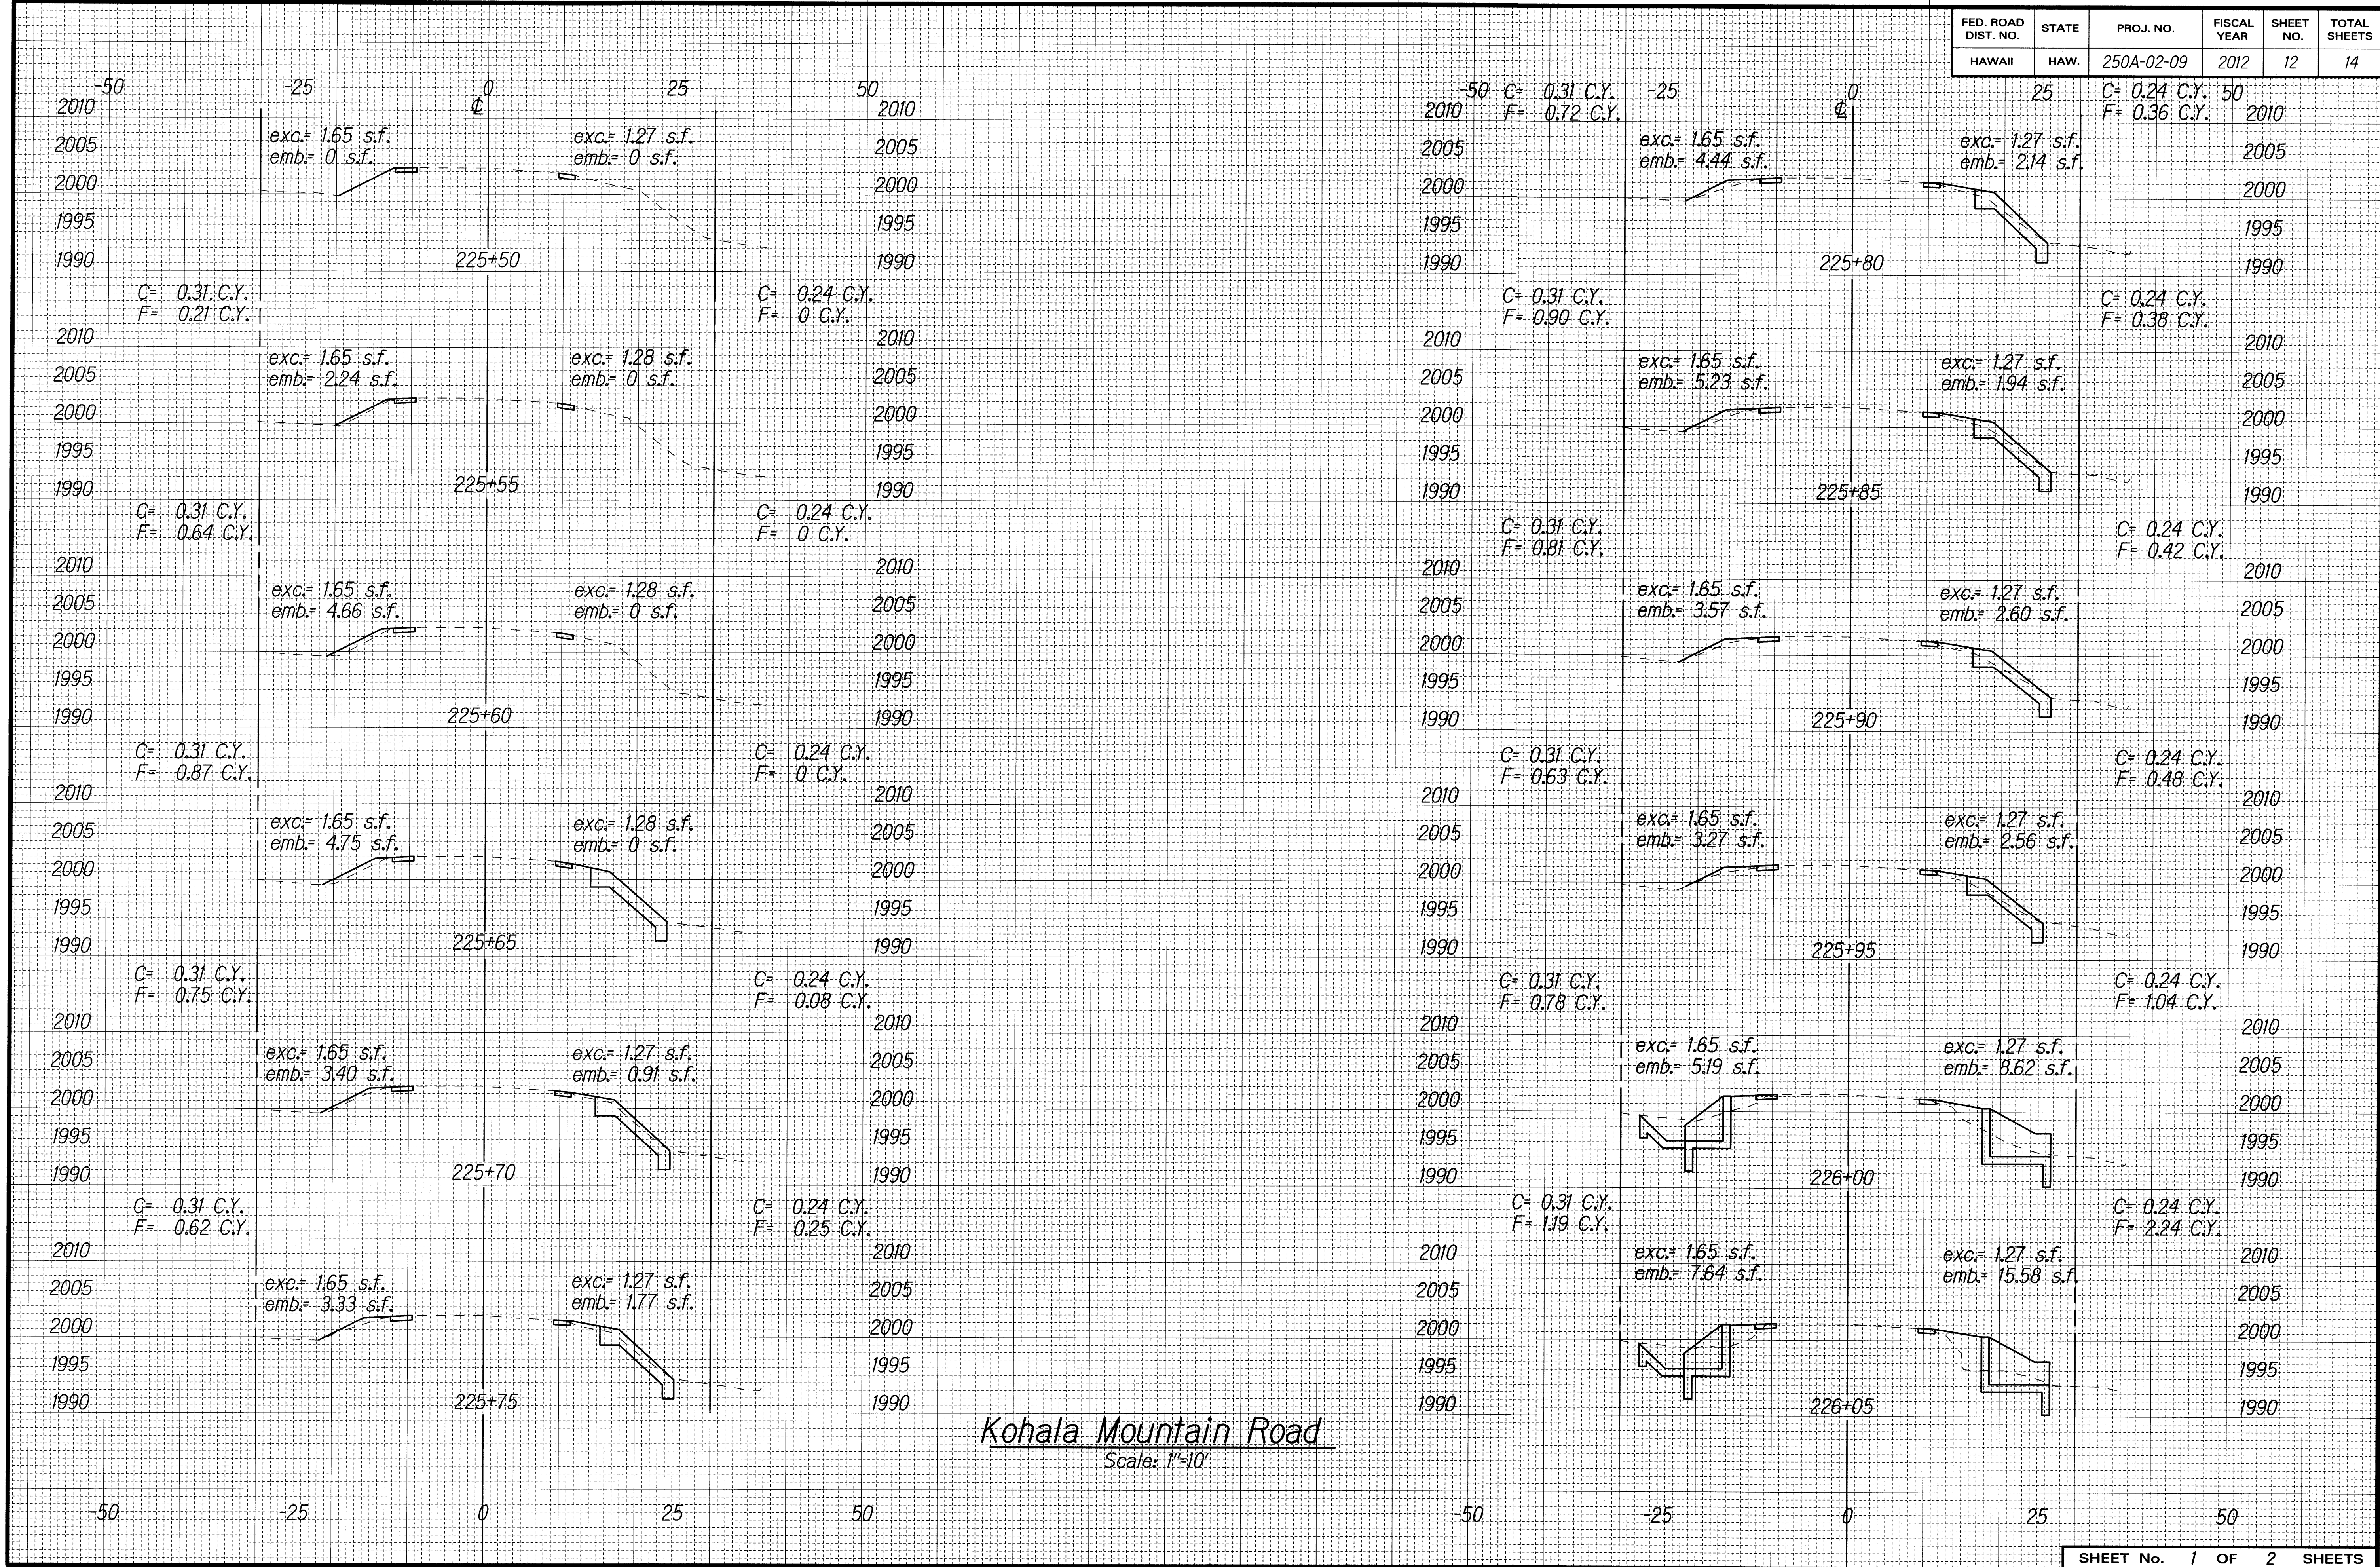

SURVEY PLOTTED BY _____ DATE _____
 DRAWN BY _____
 CHECKED BY _____
 NOTE BOOK _____
 QUANTITIES BY _____
 CHECKED BY _____
 N. _____

FED. ROAD DIST. NO.	STATE	PROJ. NO.	FISCAL YEAR	SHEET NO.	TOTAL SHEETS
HAWAII	HAW.	250A-02-09	2012	13	14

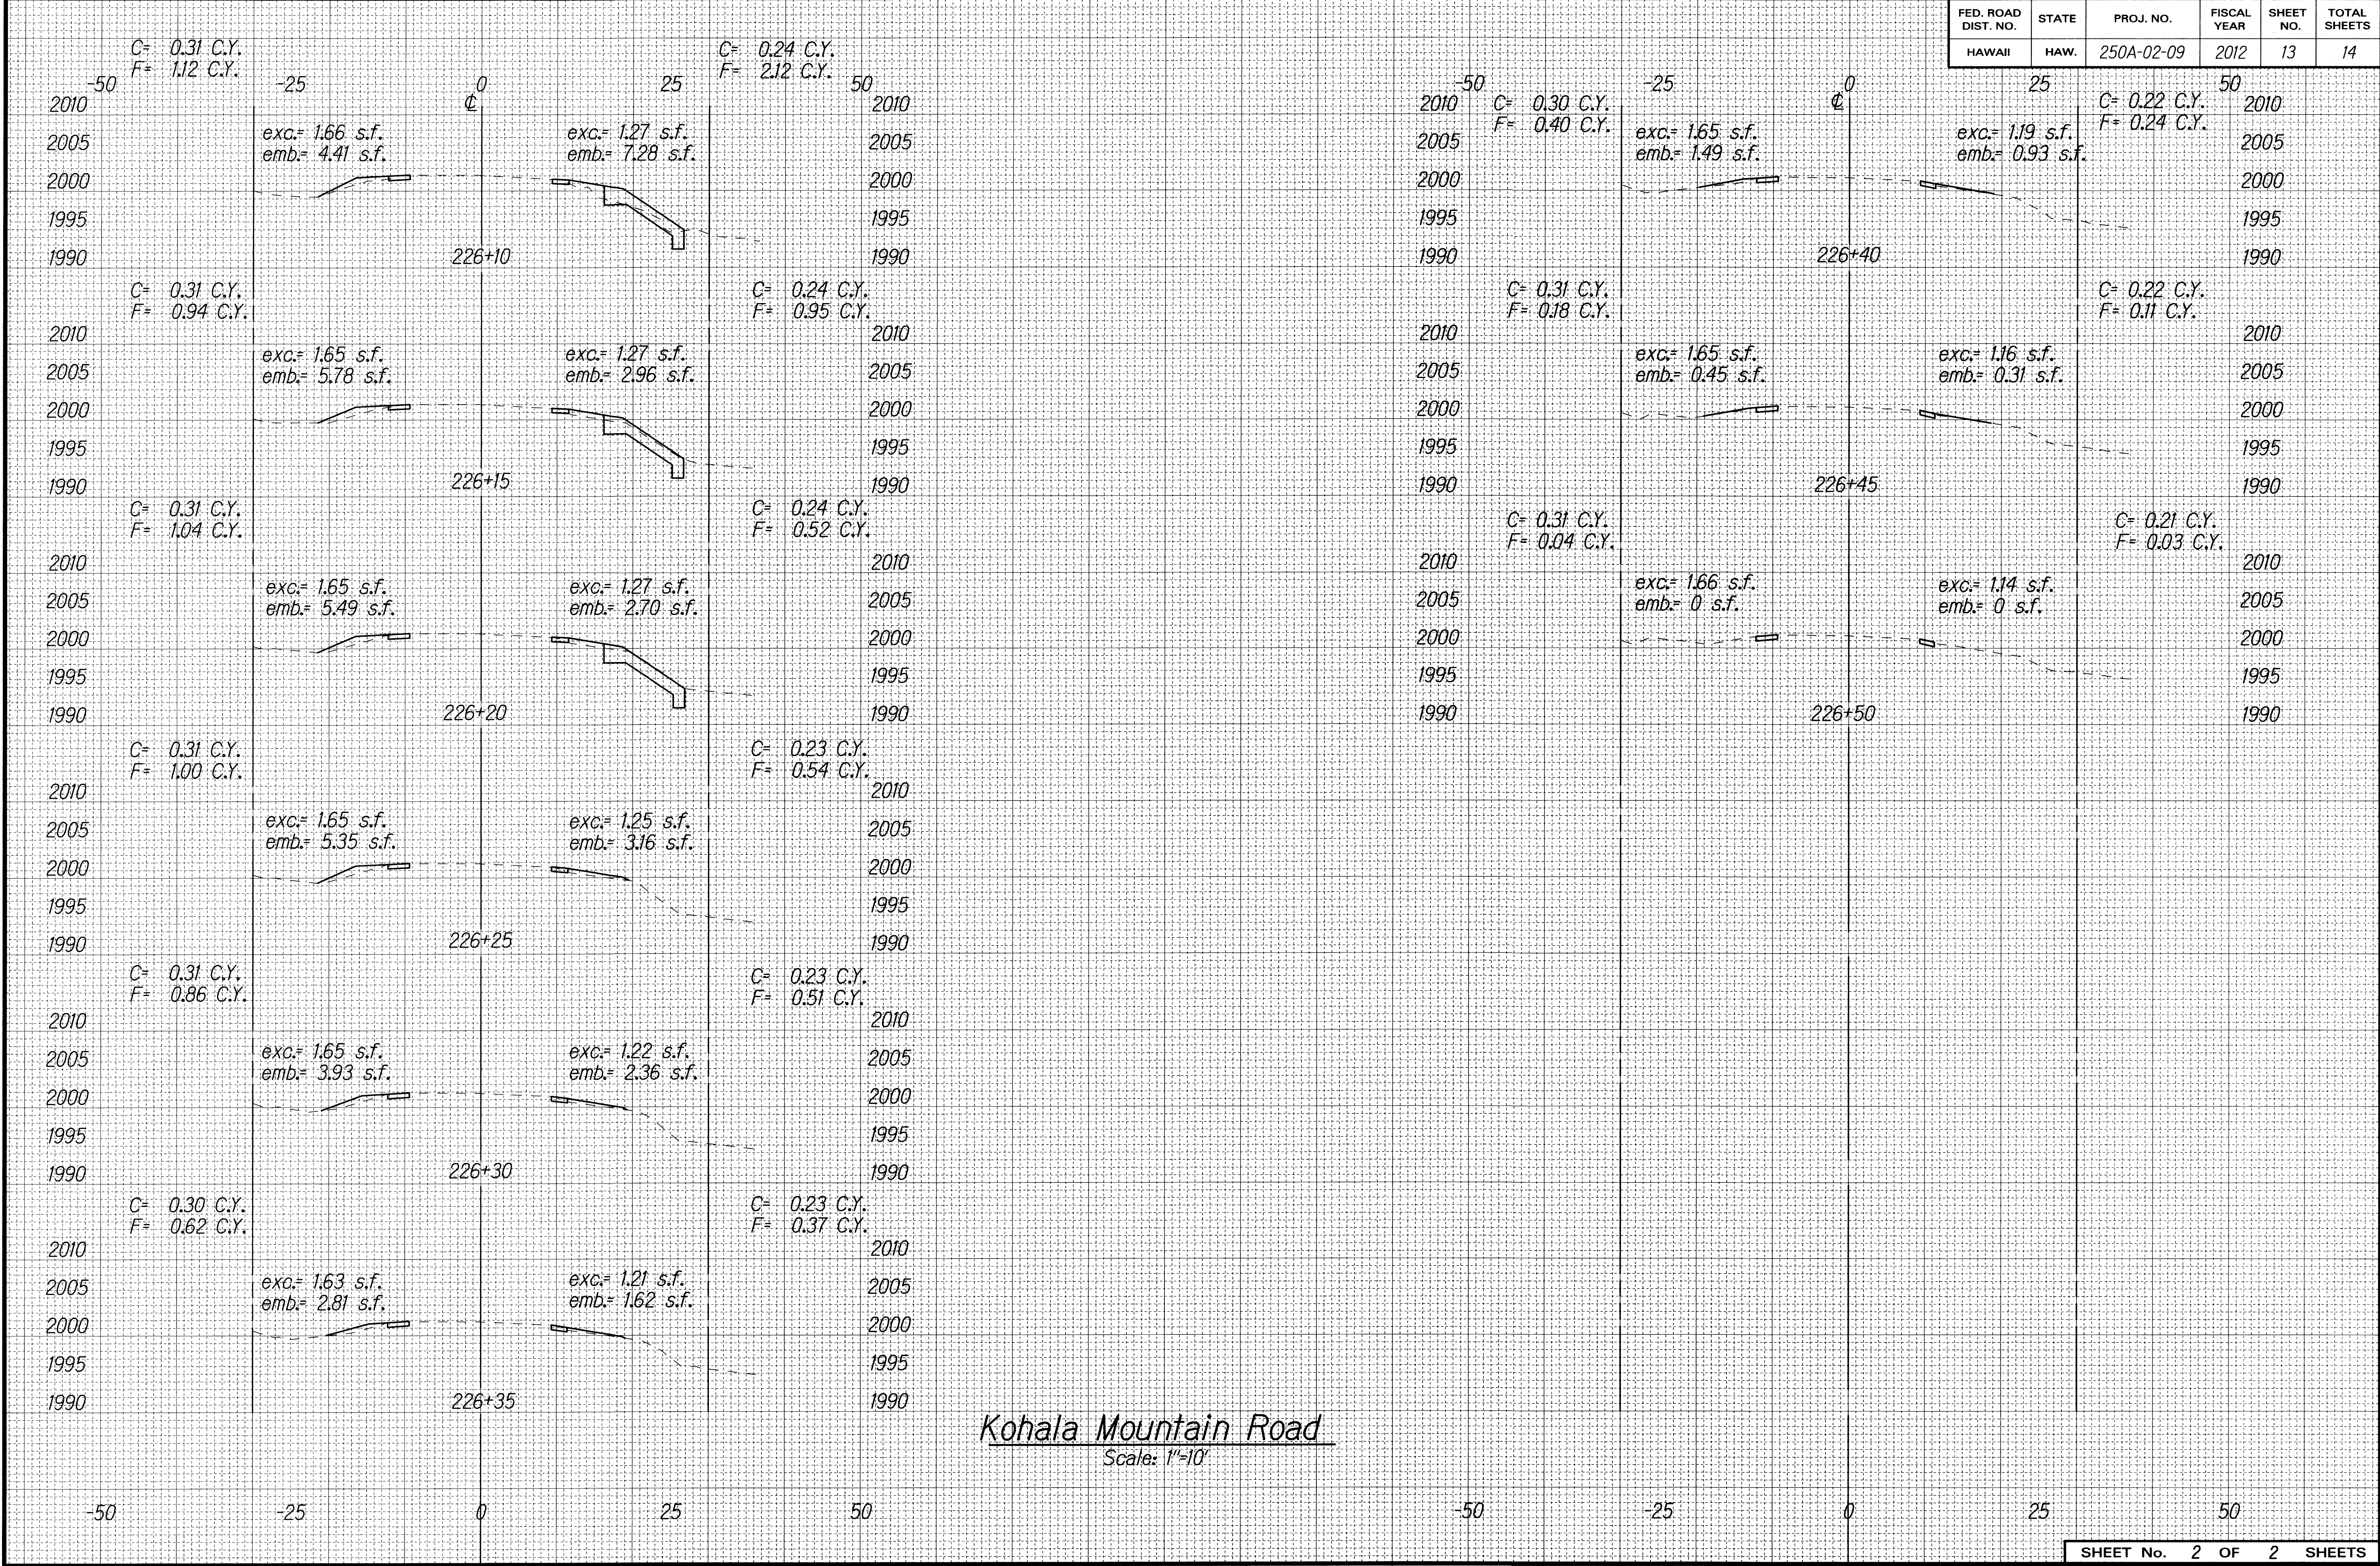

Kohala Mountain Road
Scale: 1"=10'

SURVEY PLOTTED BY	DATE
DRAWN BY	
NOTED BY	
CHECKED BY	