




FED. ROAD DIST. NO.	STATE	PROJ. NO.	FISCAL YEAR	SHEET NO.	TOTAL SHEETS
HAWAII	HAW.	250A-02-09	2012	10	14

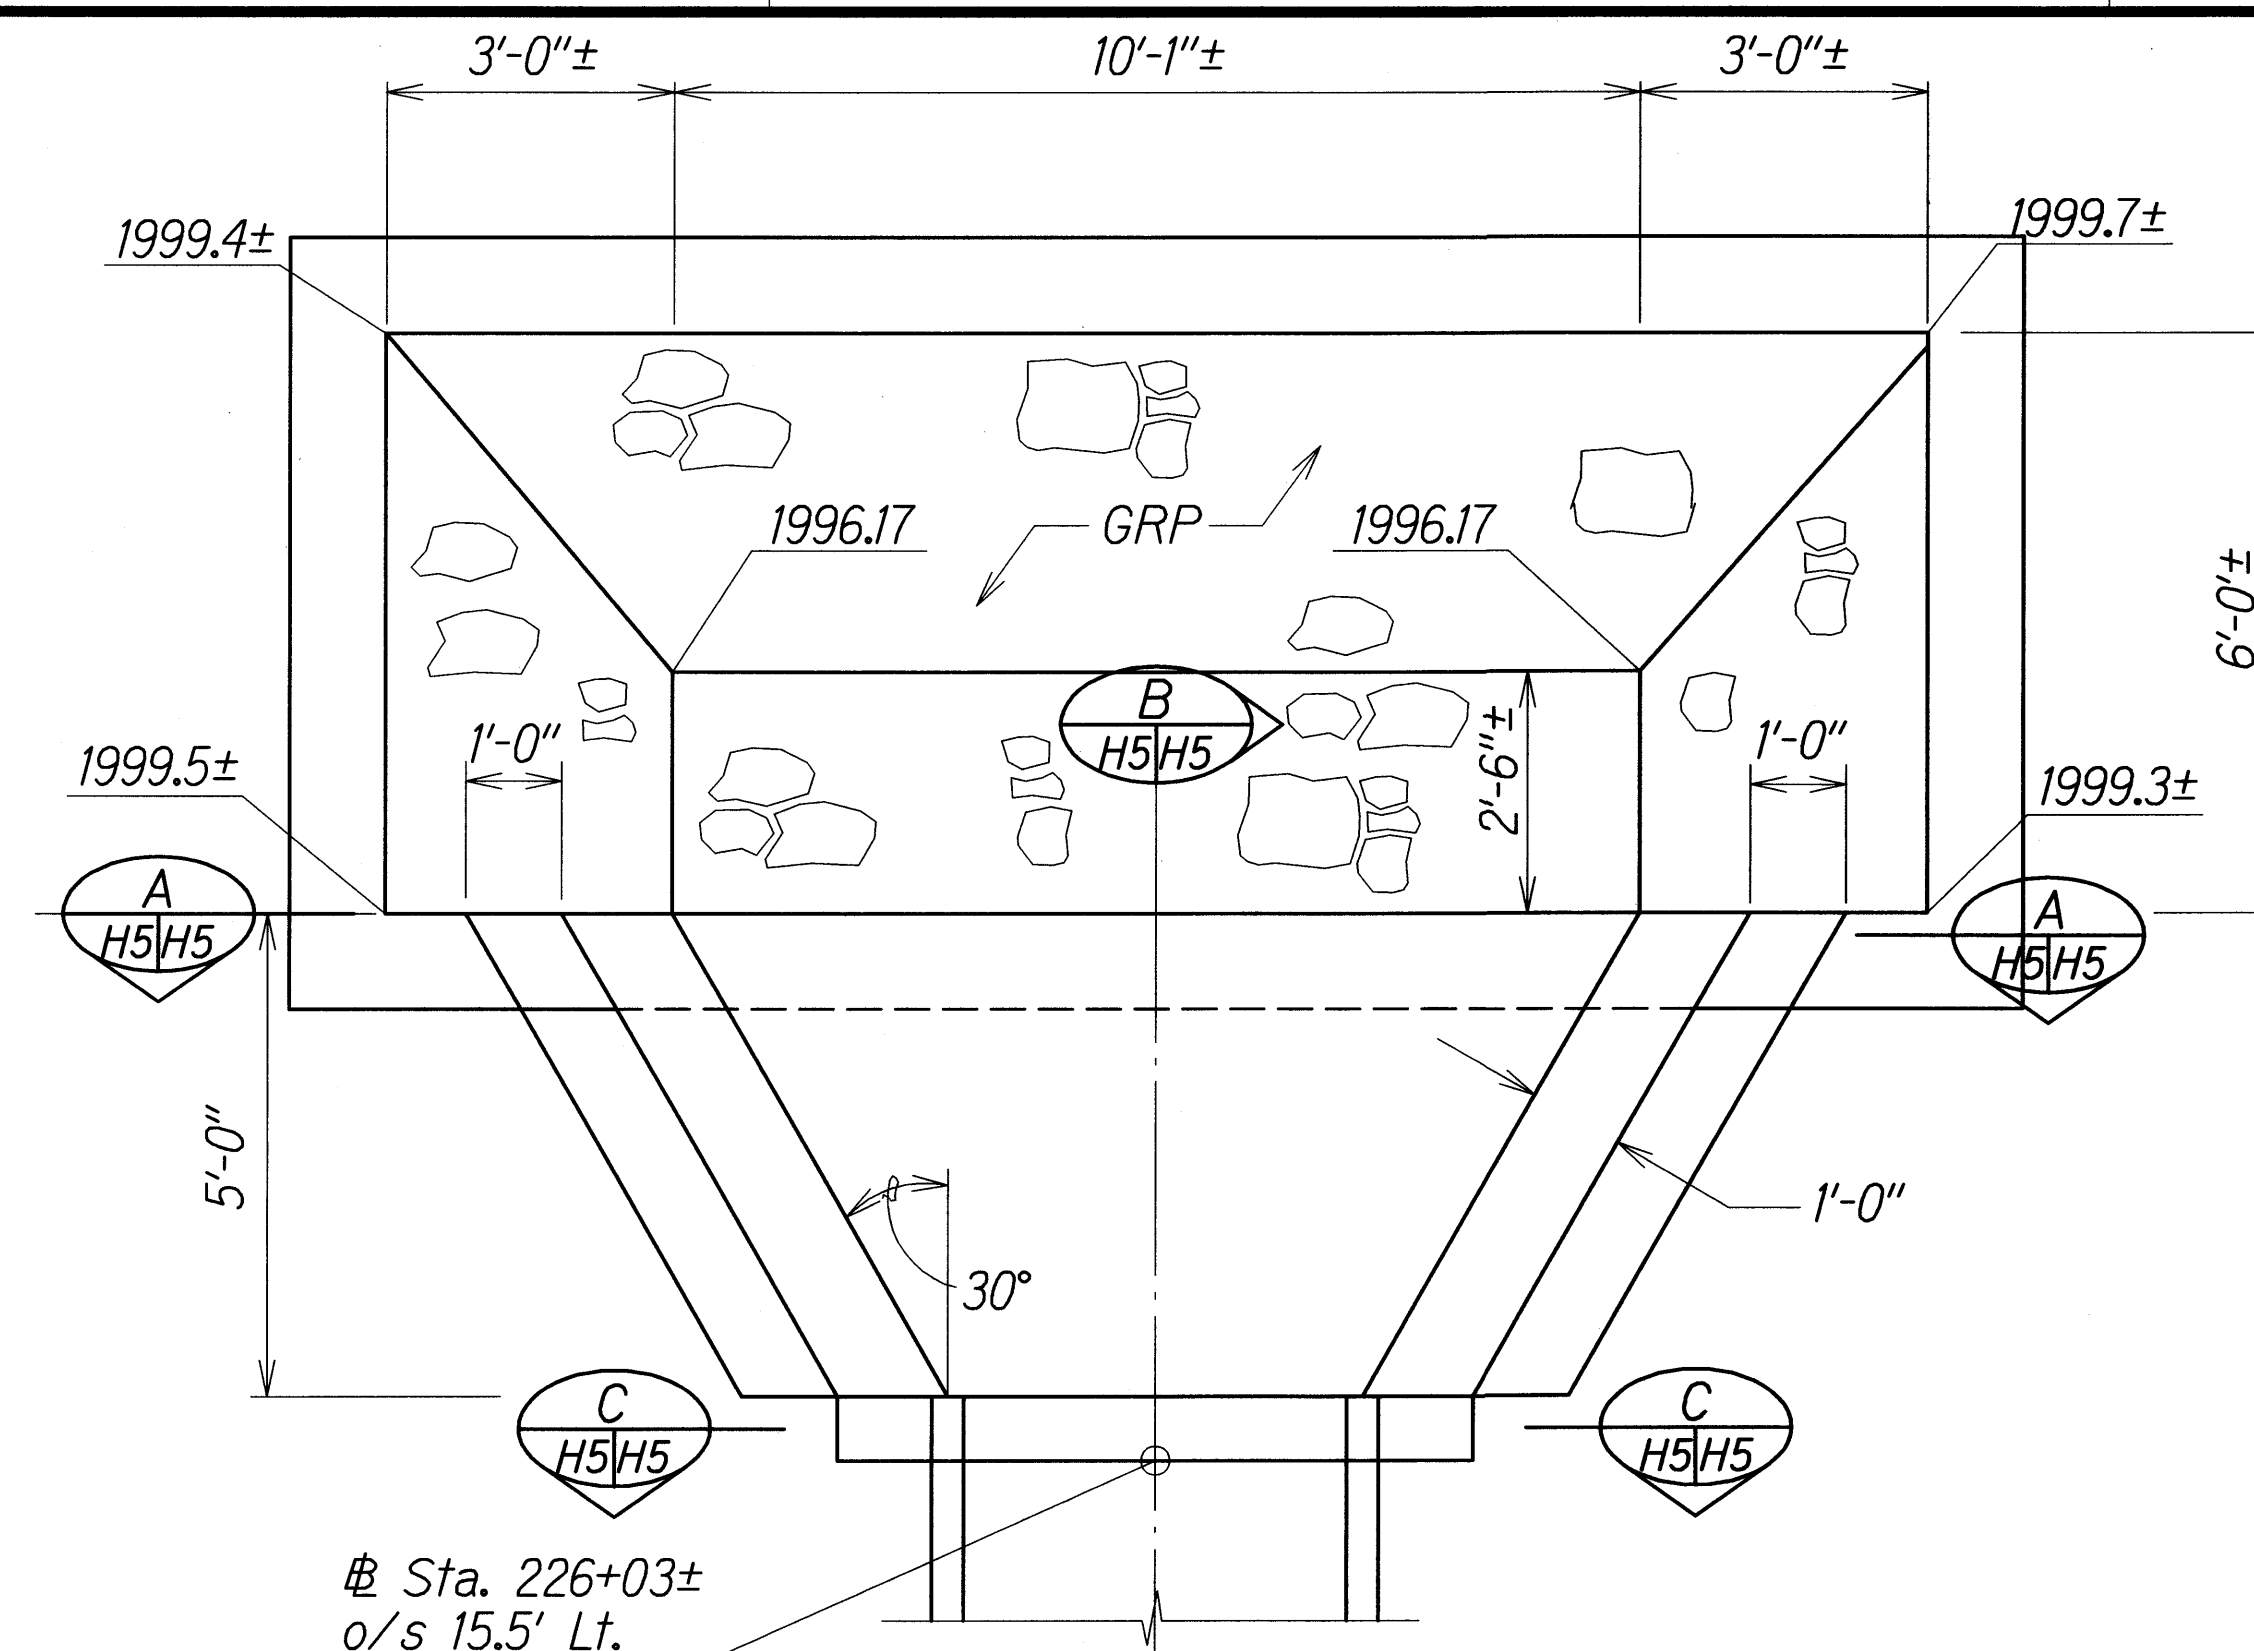


PLAN

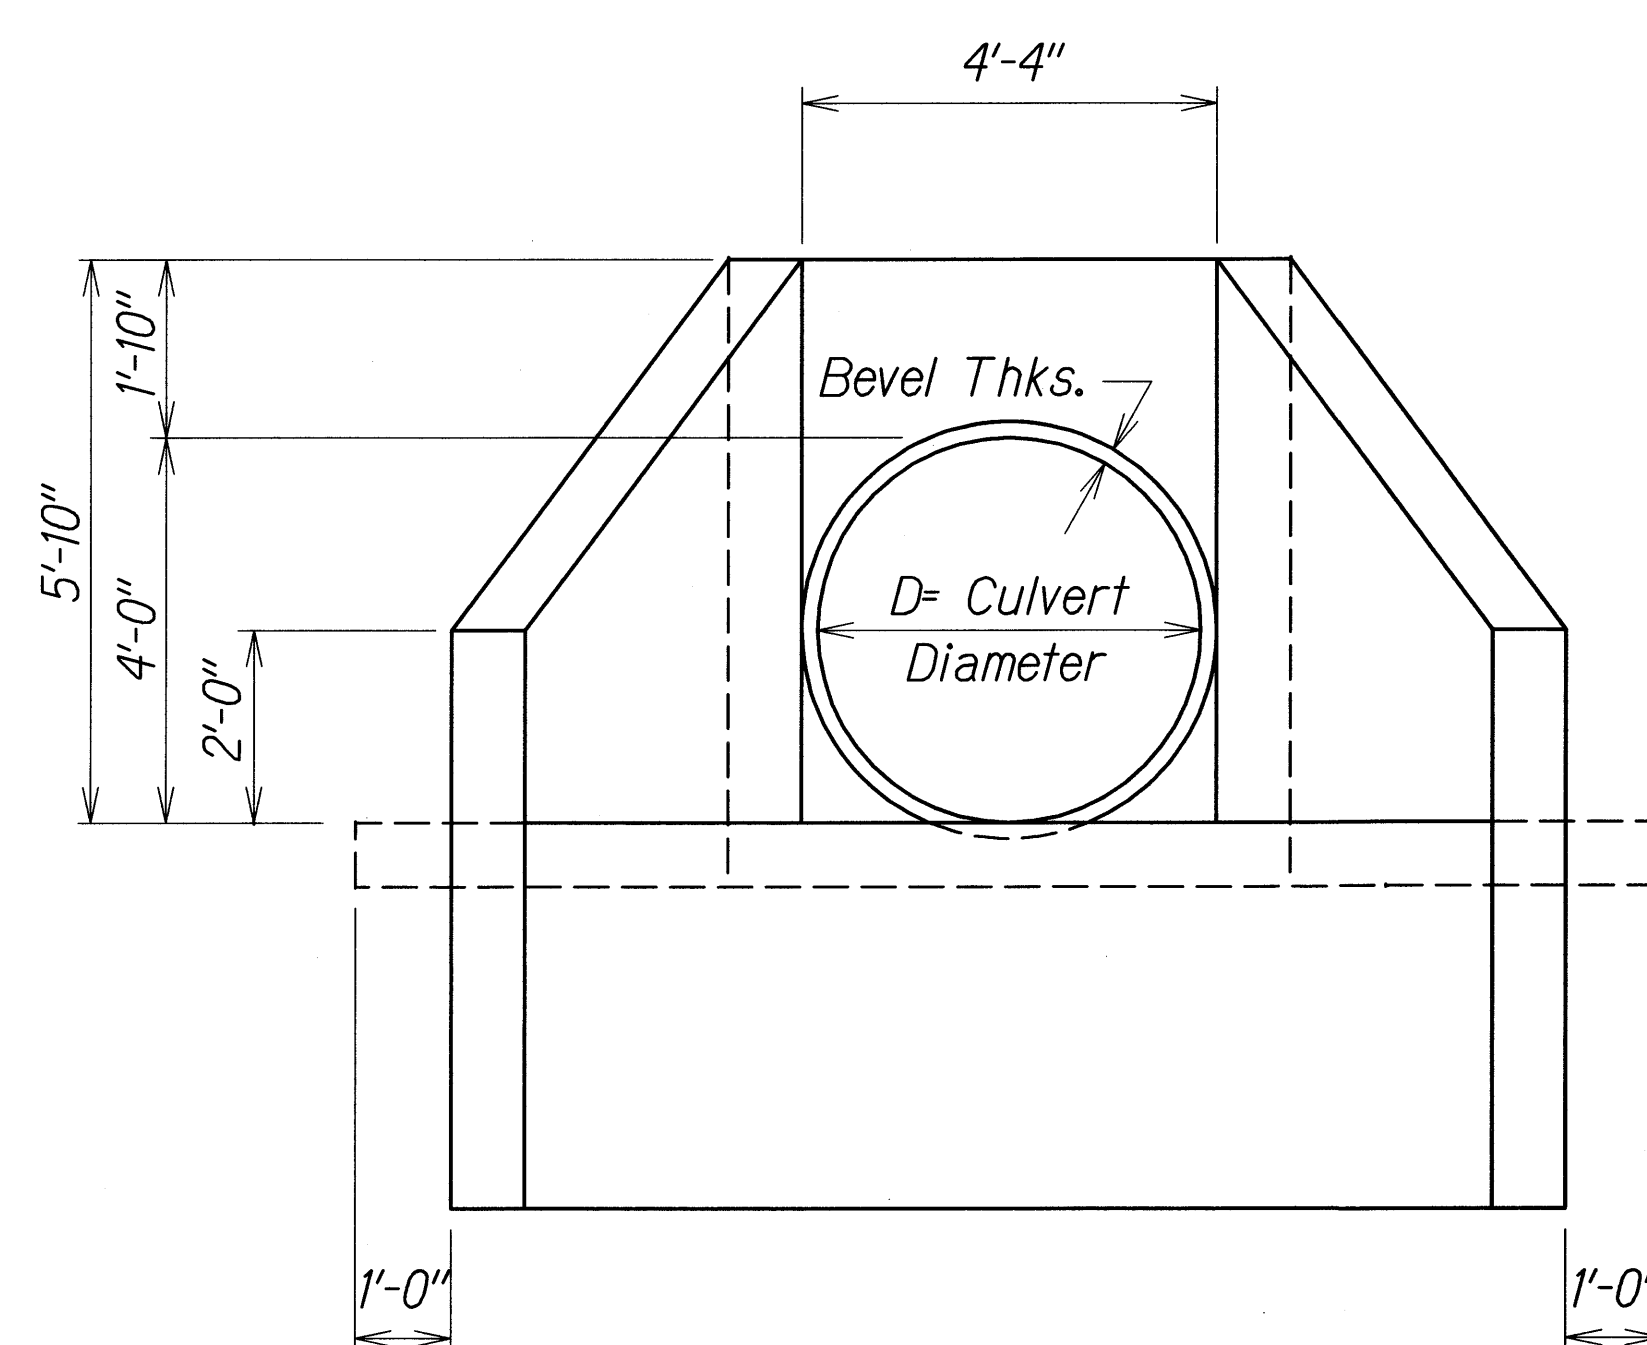


SECTION A
H5/H5

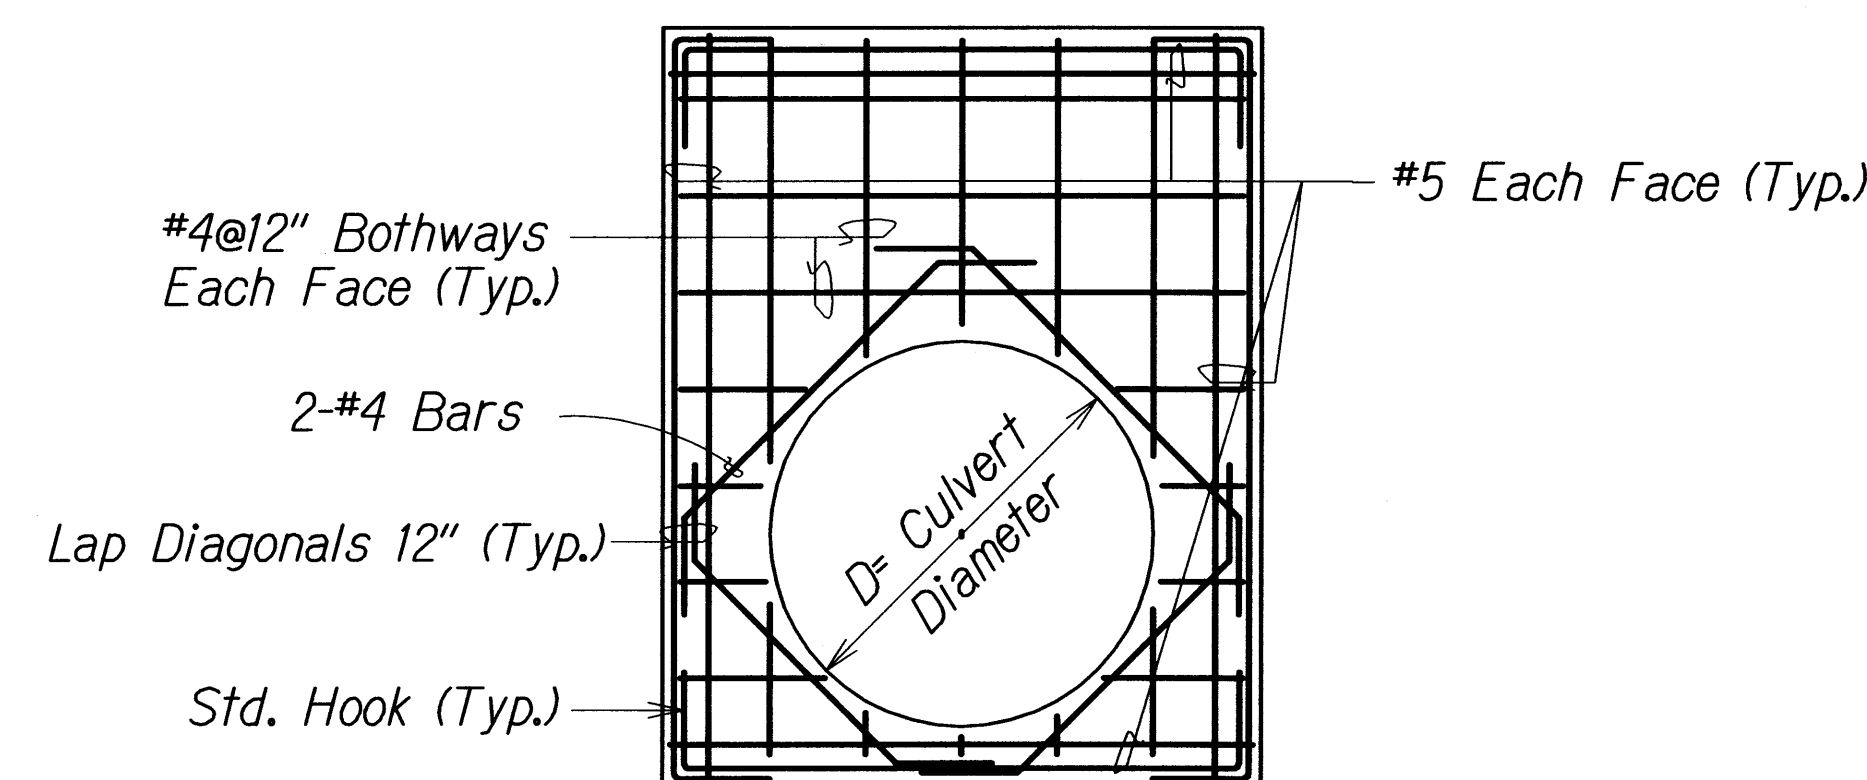

SECTION C
H5/H5

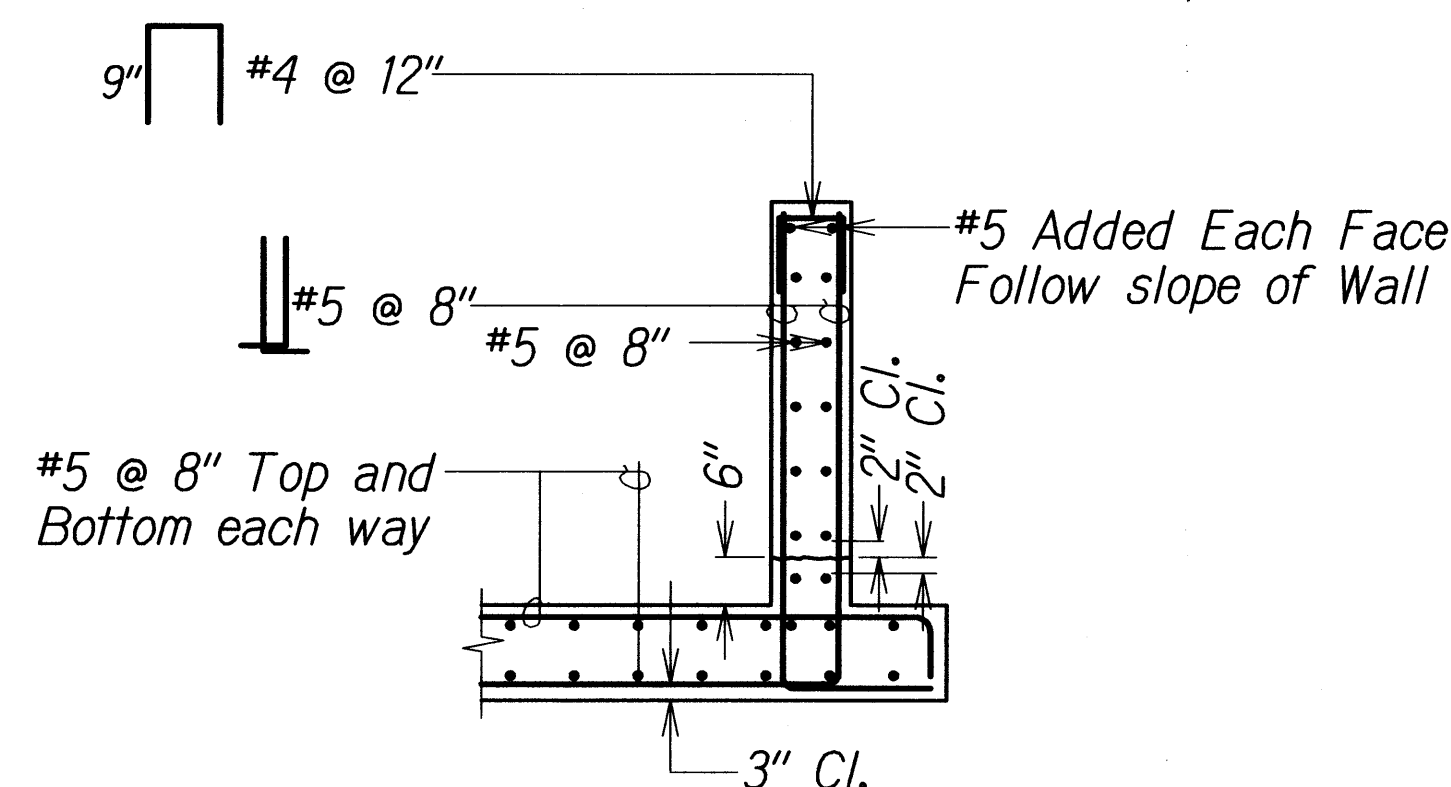

TYPICAL WING WALL REINFORCING SECTION

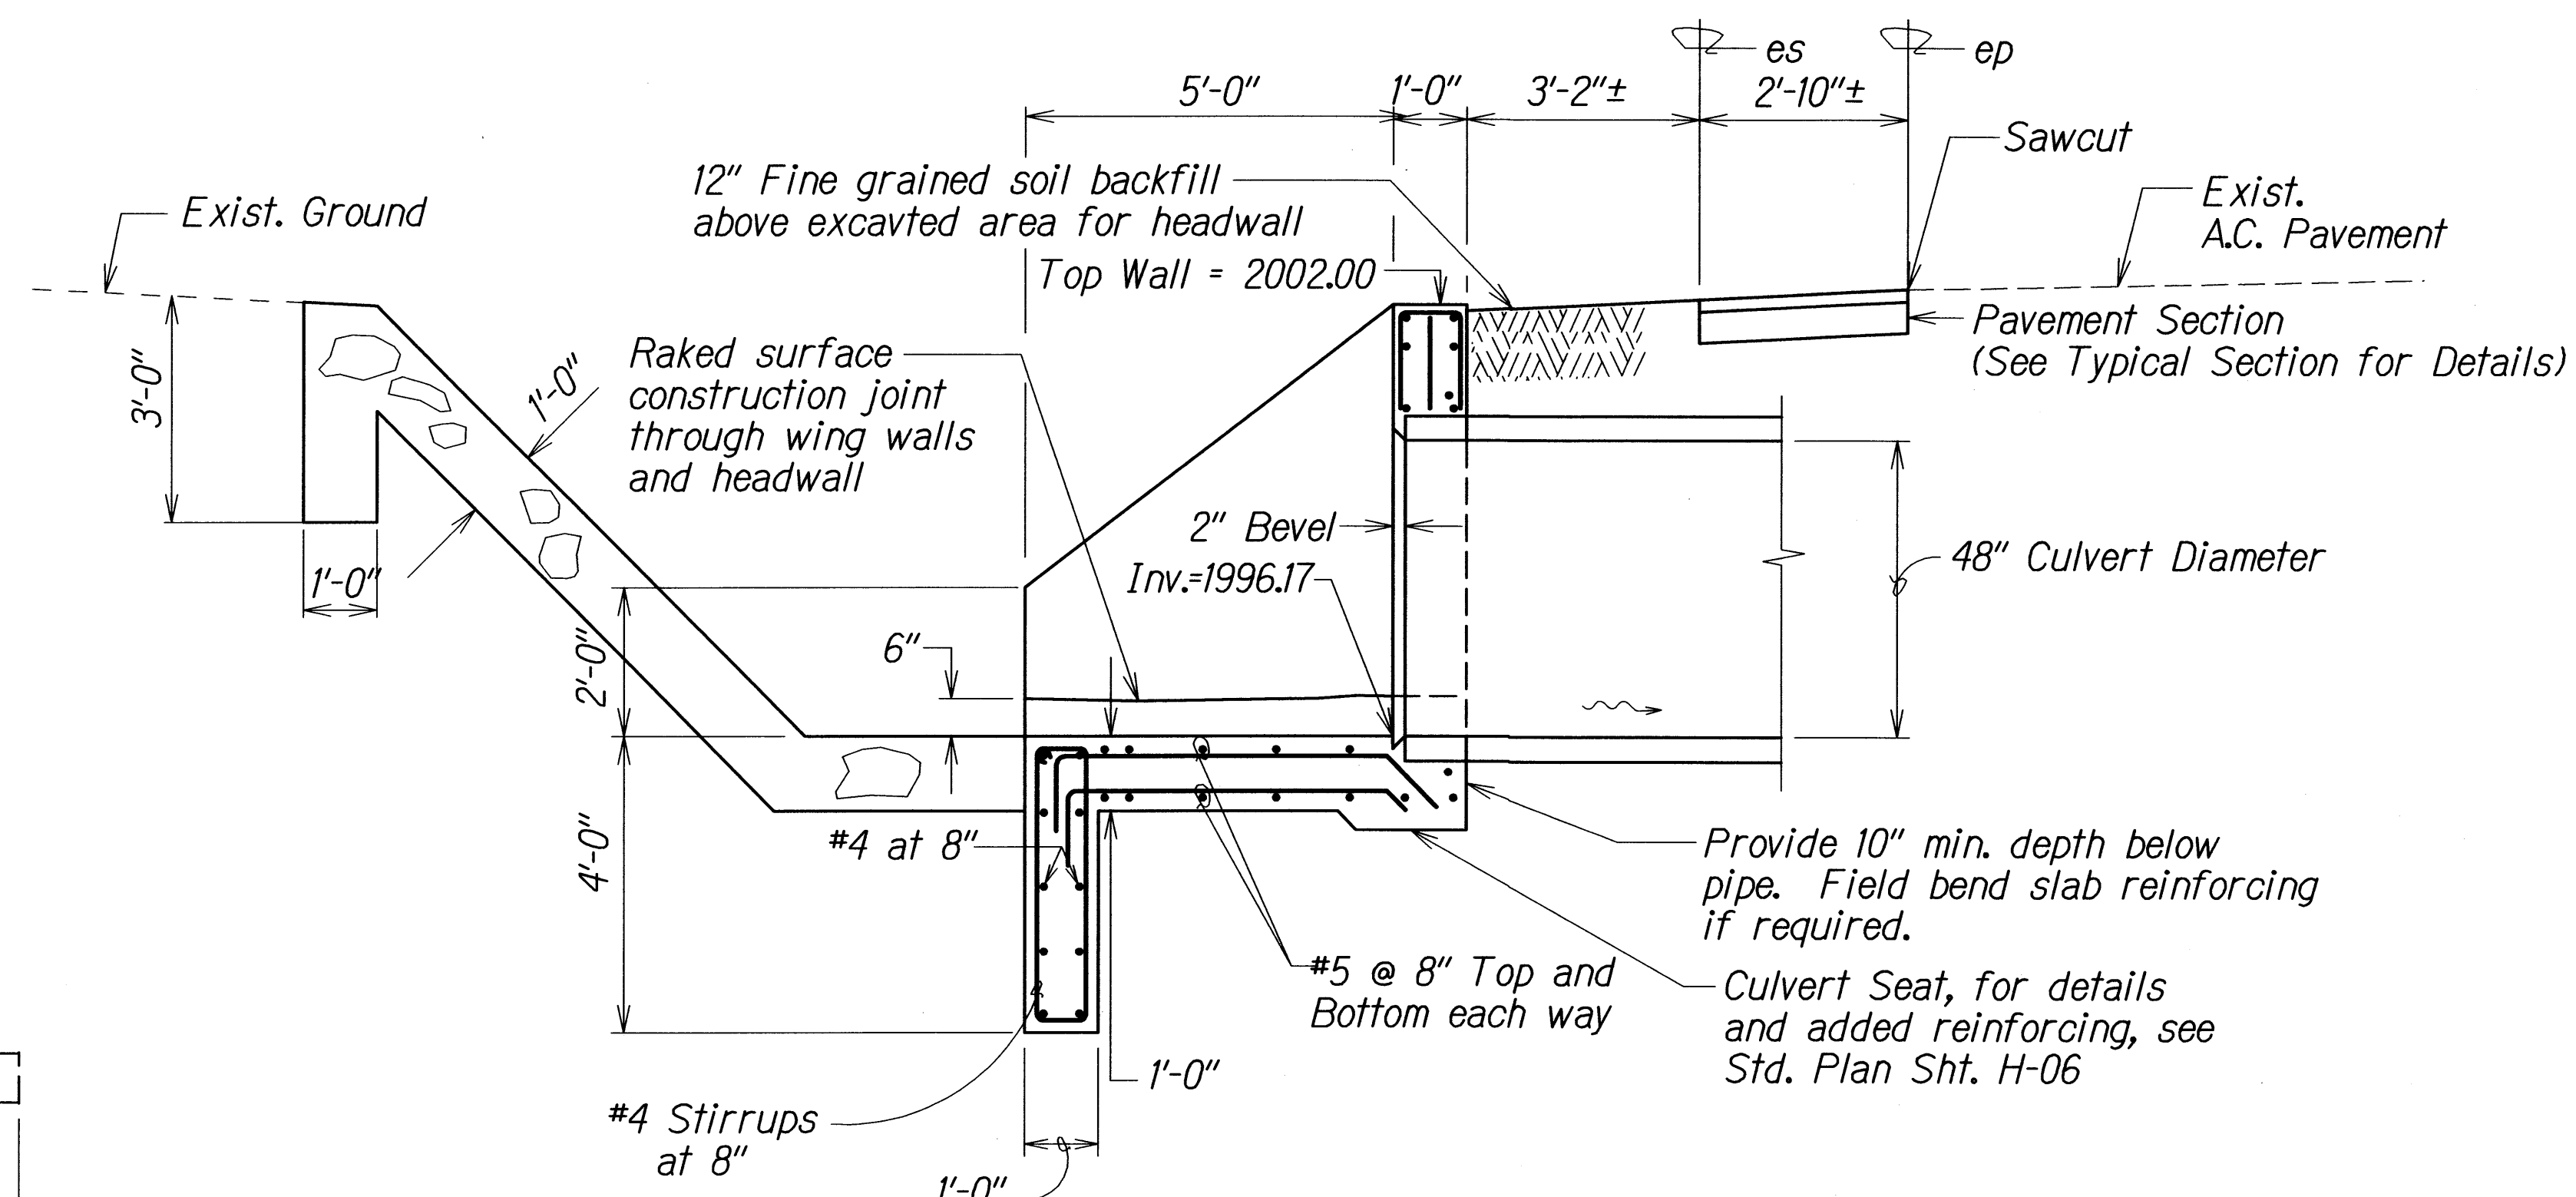

SECTION B
H5/H5

DETAILS OF TYPE "1" INLET STRUCTURE

ORIGINAL PLAN	SURVEY PLOTTED BY	DATE
DRAWN BY		
NOTE BOOK		
CHECKED BY		

STATE OF HAWAII
DEPARTMENT OF TRANSPORTATION
HIGHWAYS DIVISION

DRAINAGE DETAILS

KOHALA MOUNTAIN ROAD
DRAINAGE IMPROVEMENTS, PHASE 2
VICINITY OF M.P. 12.88
Project No. 250A-02-09
Scale: 1/2" = 1'-0" Date: March 2012

SHEET No. H5 OF 6 SHEETS