


FED. ROAD DIST. NO.	STATE	PROJ. NO.	FISCAL YEAR	SHEET NO.	TOTAL SHEETS
HAWAII	HAW.	250A-03-09	2010	6	16

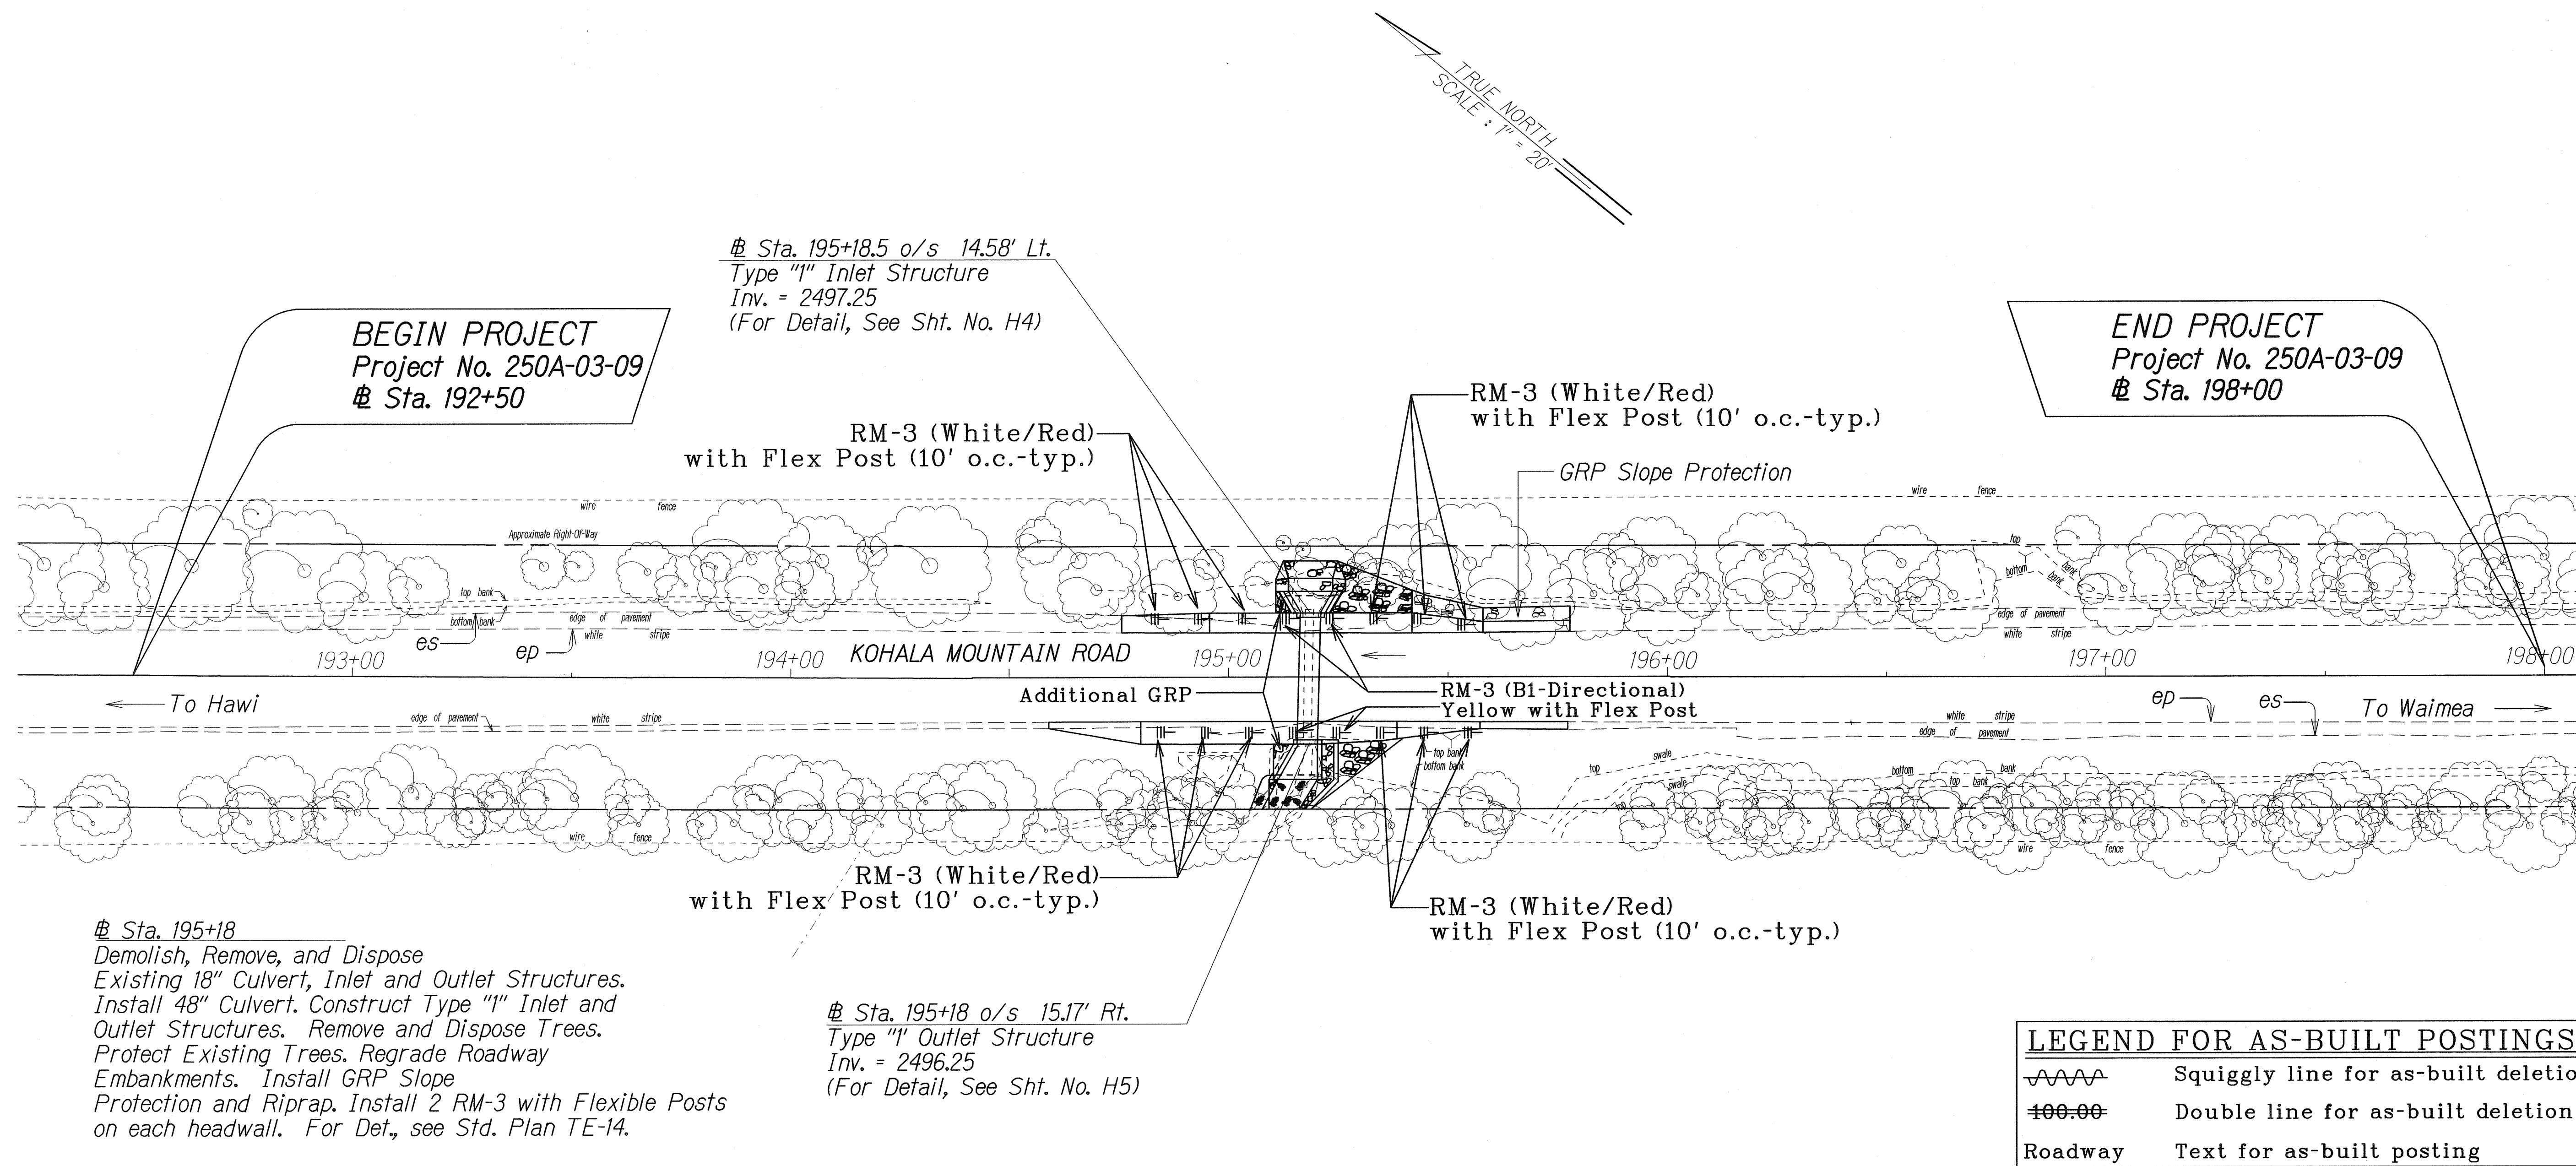

Notes:

- Existing drainage systems will be functional at all times during construction. The Contractor is to furnish materials, equipment, labor, tools and incidentals necessary to accomplish maintenance of flow. The cost shall be incidental to the various Contract Items.
- The Contractor shall verify the locations of all existing culverts and utilities in the field. Any existing culverts and utilities damaged during construction shall be repaired or replaced by the Contractor at his own expense.
- For added reinforcing around culverts at new drainage structures, see Standard Plan H-06.
- Chamfer all exposed concrete edges 1".
- For details of 48-inch Culvert trench restoration, see Sheet No. H3.

- All exposed finish grade shall be hydromulched. The work shall be considered incidental to the various Contract Items.
- Replace Pavement Striping and Markings damaged by the Contractor. The cost shall be considered incidental to the various Contract Items.
- Concrete shall be Class A unless otherwise noted.
- The Contractor shall obtain permission from adjacent landowners if the Contractor elects to work outside the R/W.
- Demolish, remove, and dispose existing 18" culvert and Inlet and Outlet Structures shall not be paid for separately, but shall be considered incidental to the various Contract Items.
- Trench Backfill Material A or Structure Backfill Material A shall be used for Trench Backfill in culvert trench restoration. Trench Backfill Material B, Structure Backfill Material B, and on-site soils shall not be used. The cost shall be considered incidental to Item 206.2020 Excavation for Drainage Facilities.

LEGEND FOR AS-BUILT POSTINGS	
	Squiggly line for as-built deletion
	Double line for as-built deletion
Roadway	Text for as-built posting

5/4/10	Revised Note 11
DATE	REVISION
STATE OF HAWAII DEPARTMENT OF TRANSPORTATION HIGHWAYS DIVISION ROADWAY PLAN KOHALA MOUNTAIN ROAD DRAINAGE IMPROVEMENTS, PHASE 3 VICINITY OF M.P. 13.47 Project No. 250A-03-09 Scale: 1" = 20' Date: April, 2008	
SHEET No. 1 OF 1 SHEETS	

"AS-BUILT"

ADD. 6