




FED. ROAD DIST. NO.	STATE	PROJ. NO.	FISCAL YEAR	SHEET NO.	TOTAL SHEETS
HAWAII	HAW.	250A-03-09	2010	7	16

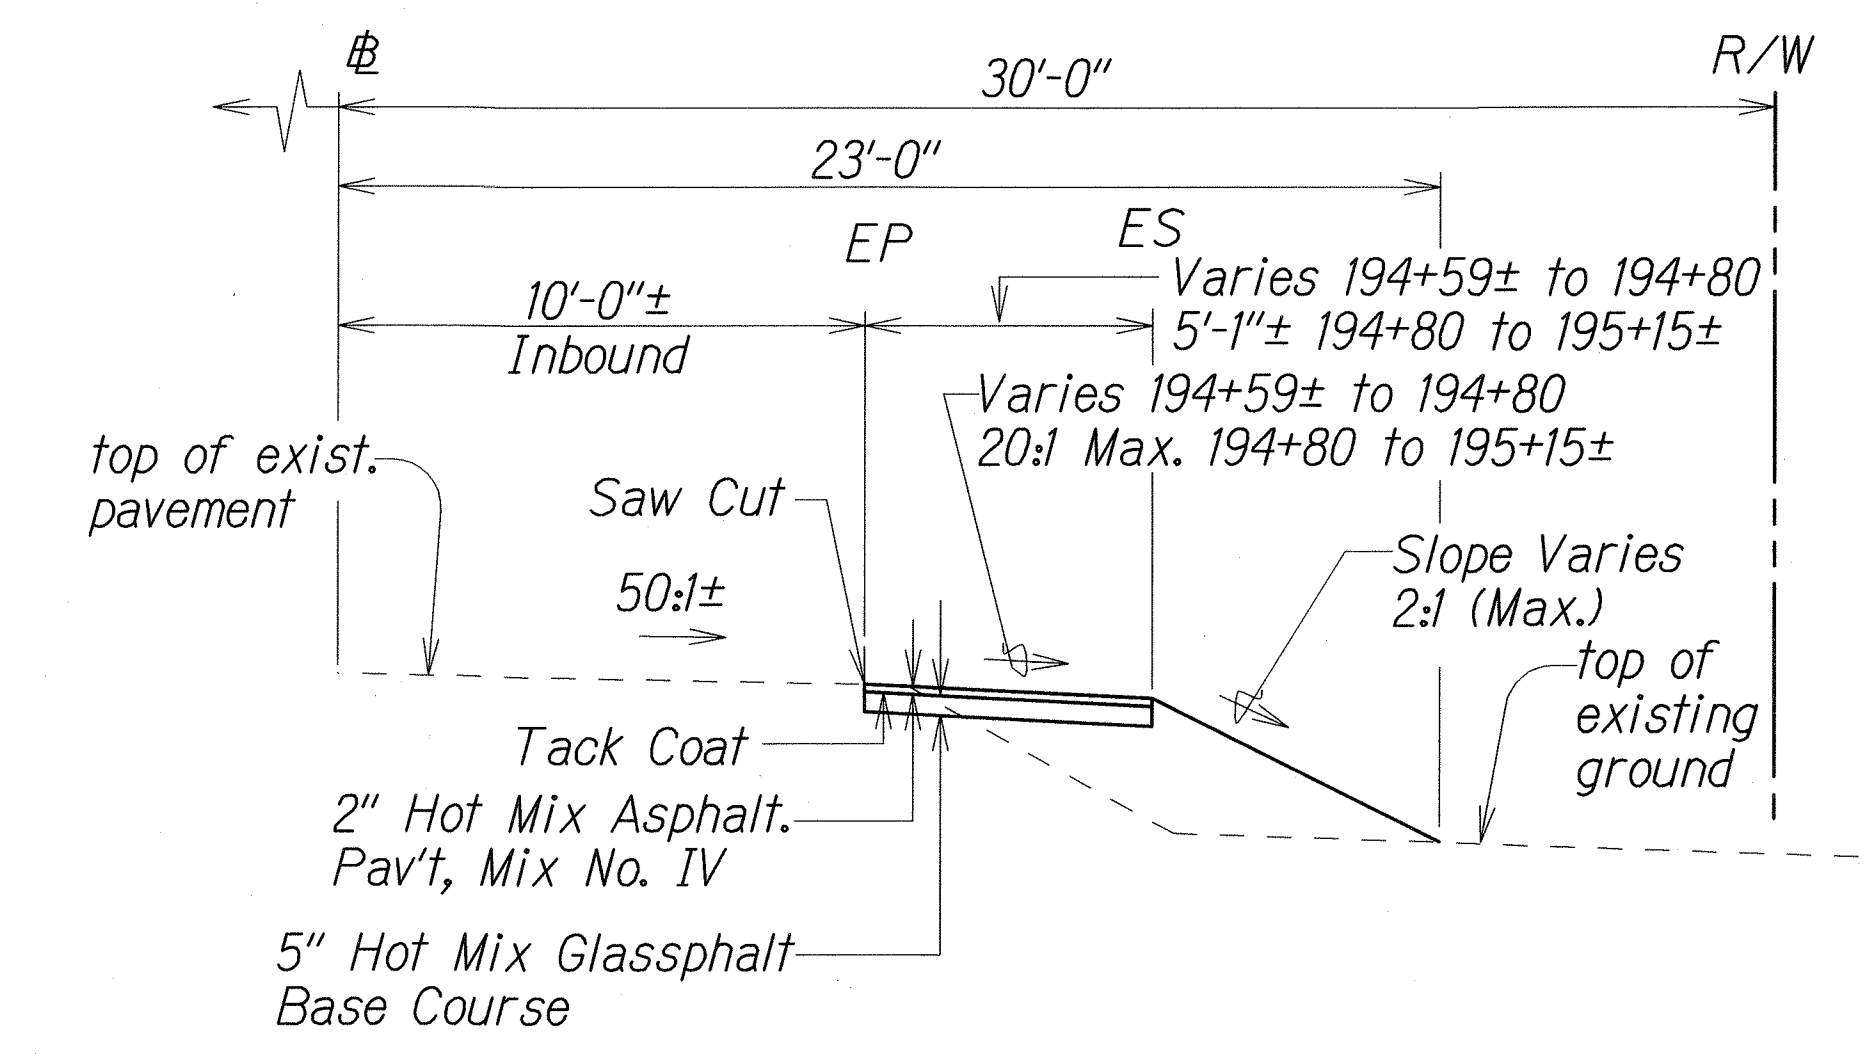


PARTIAL TYPICAL SECTION
STA. 194+59.5 RT. TO STA. 195+15.5 RT. (INBOUND)
07±

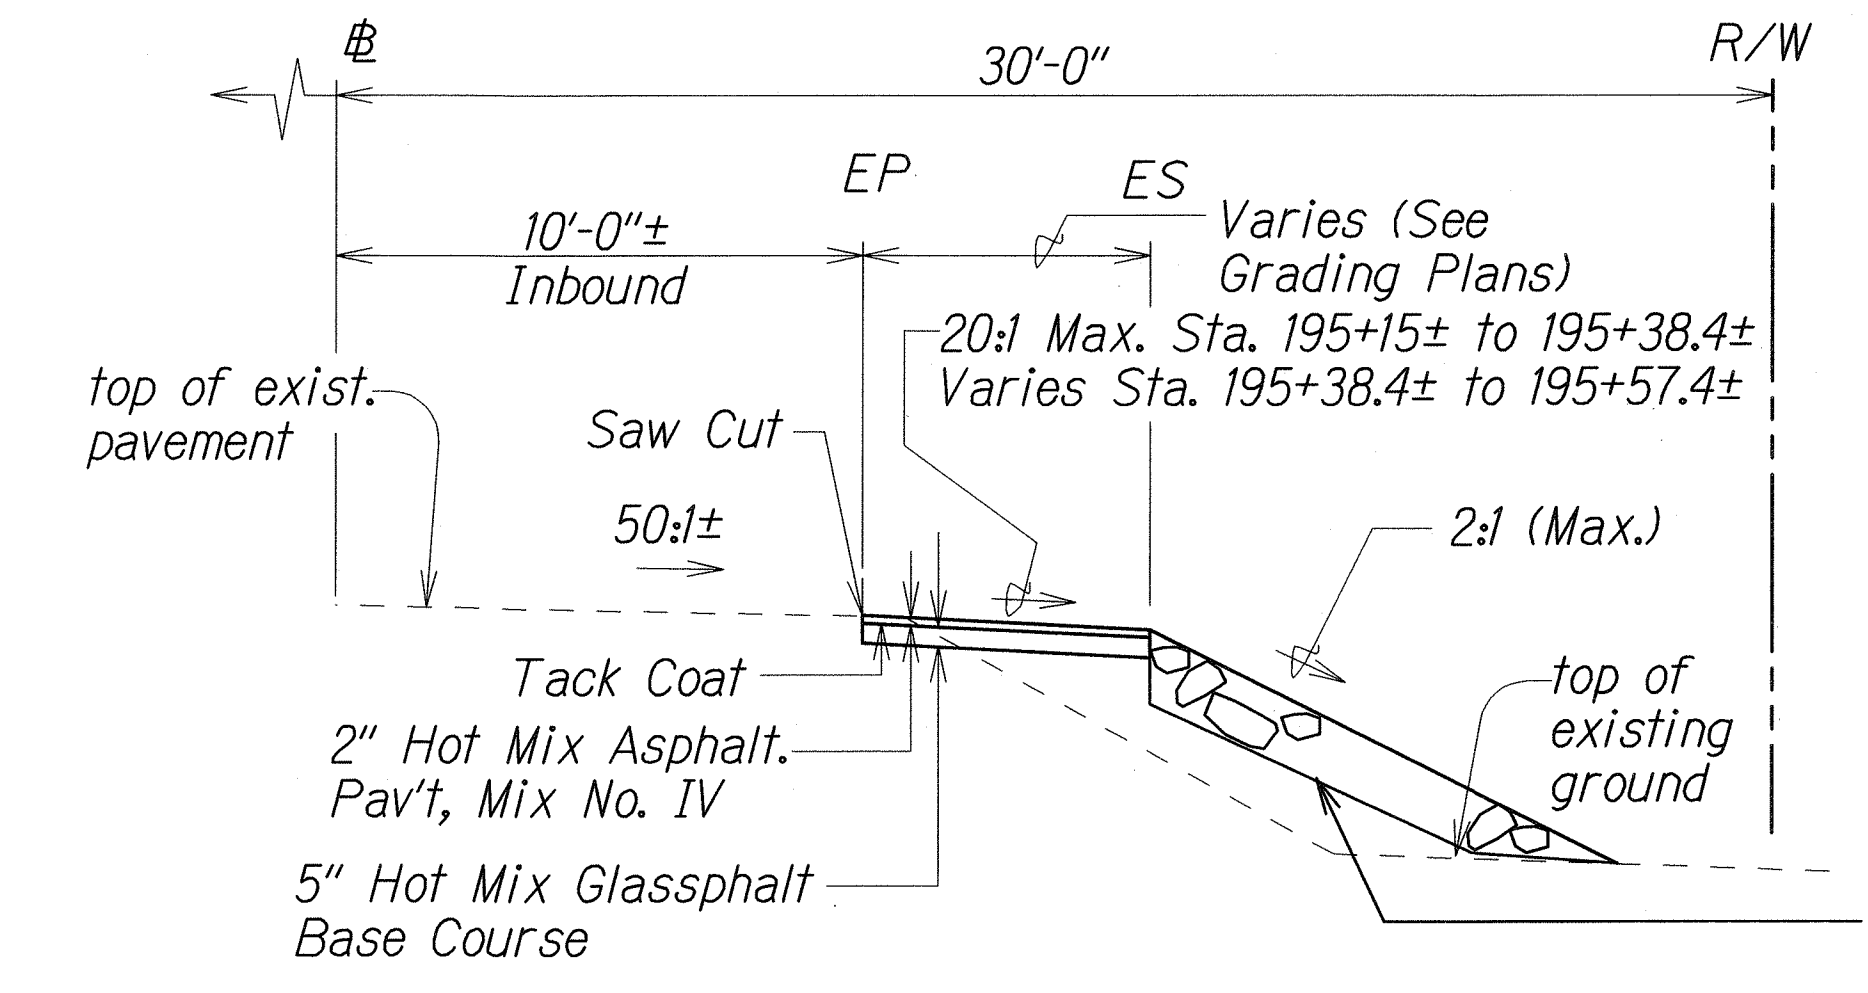


PARTIAL TYPICAL SECTION
STA. 195+15.5 RT. TO STA. 195+57.4 RT. (INBOUND)
07± STA. 195+38± RT. (END GRP)

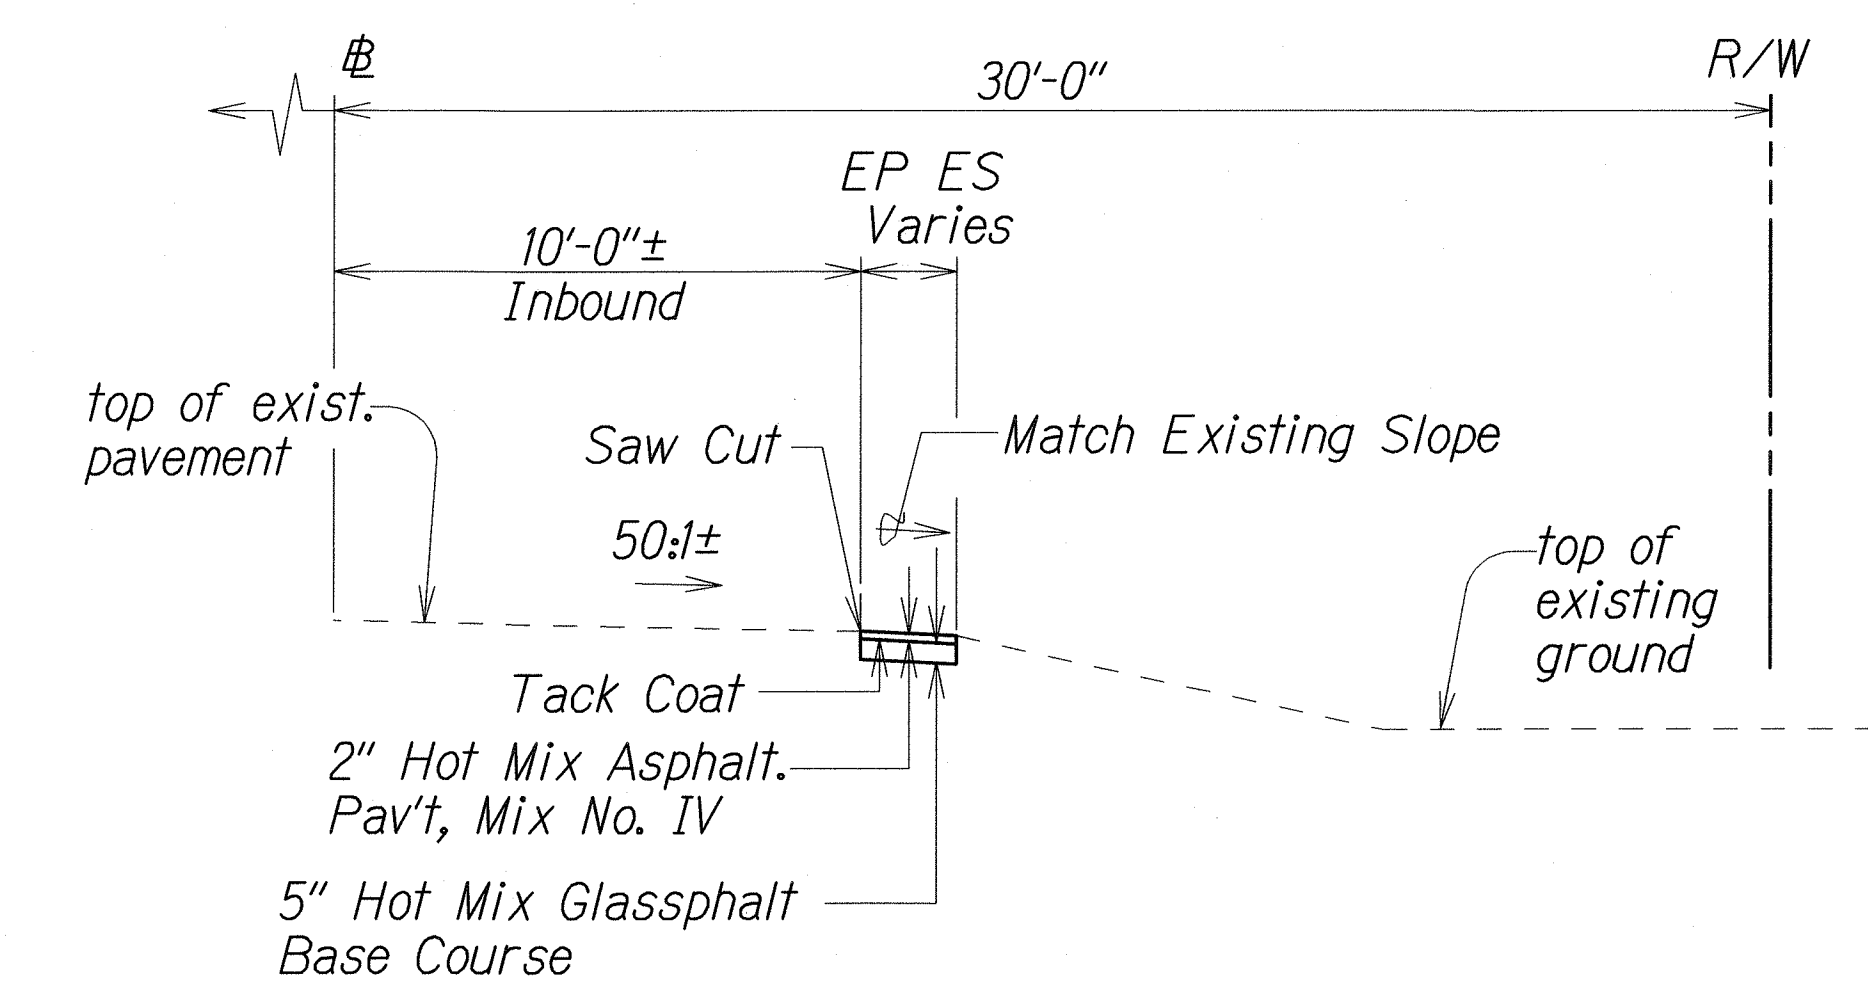


PARTIAL TYPICAL SECTION
STA. 195+57.4 RT. TO STA. 195+77.4 RT. (INBOUND)

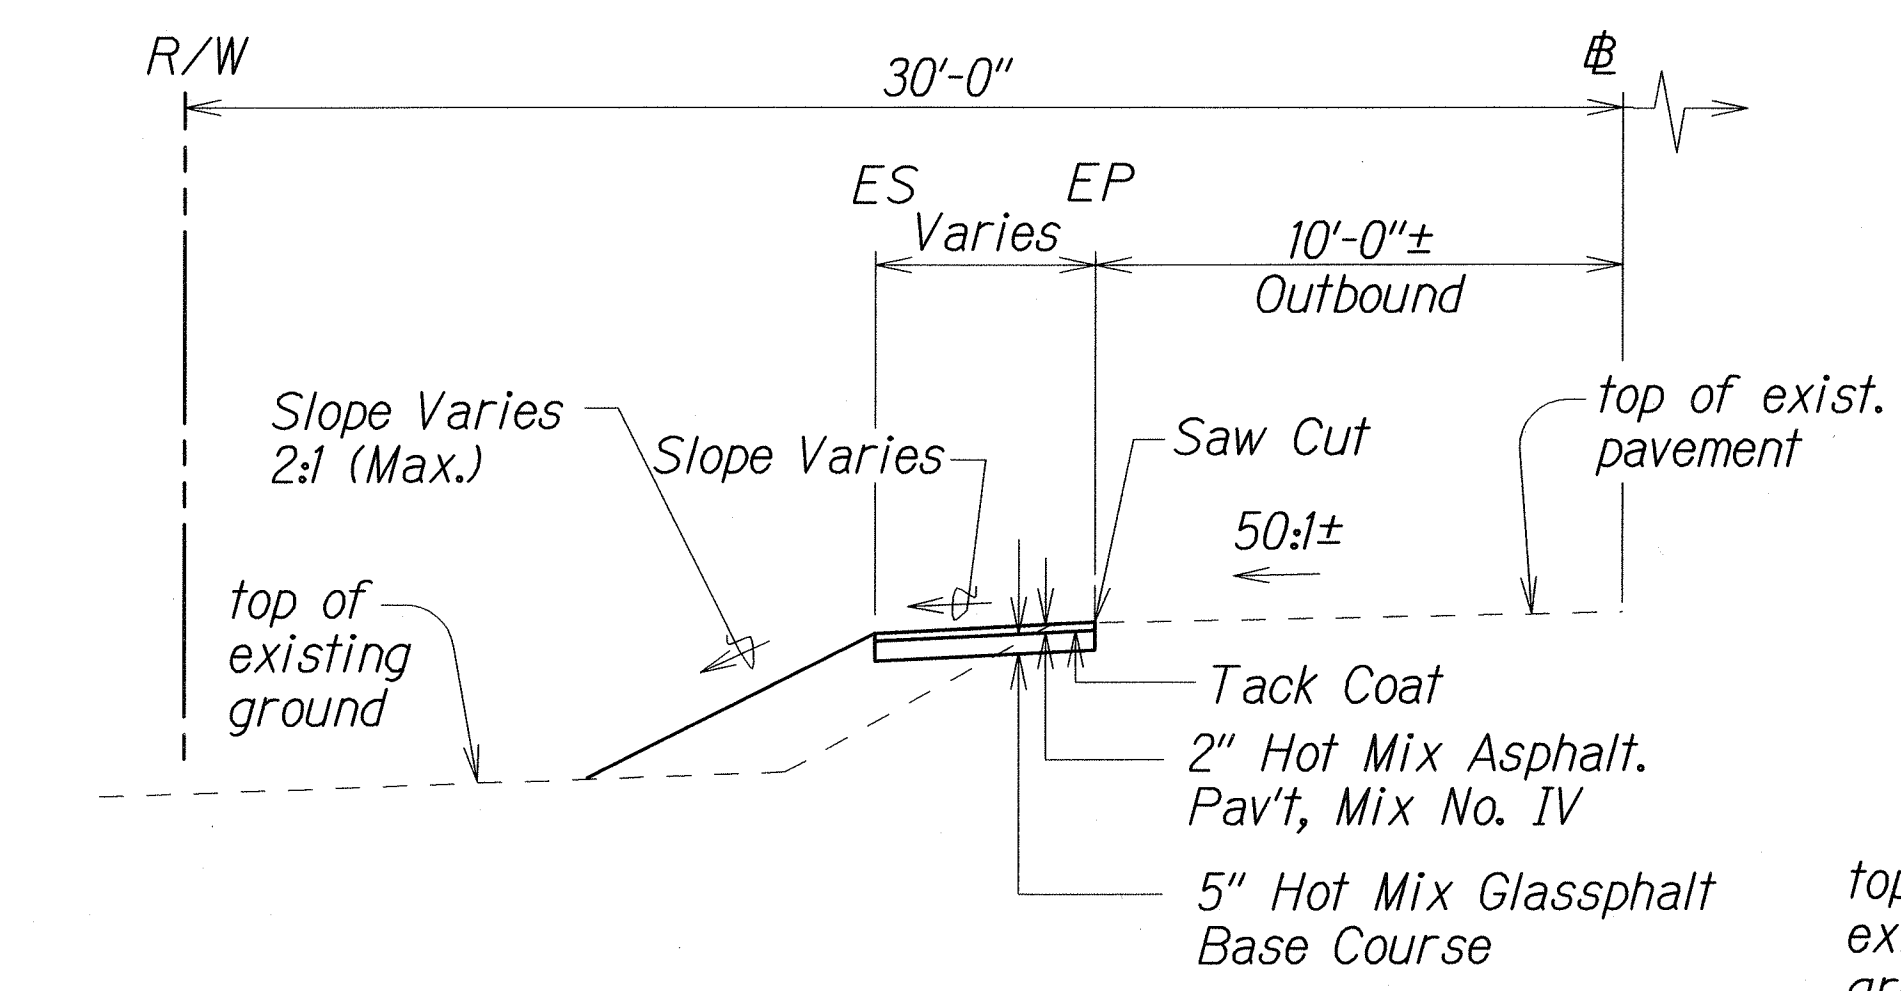


PARTIAL TYPICAL SECTION
STA. 194+75.5 LT. TO STA. 194+95.5 LT. (OUTBOUND)

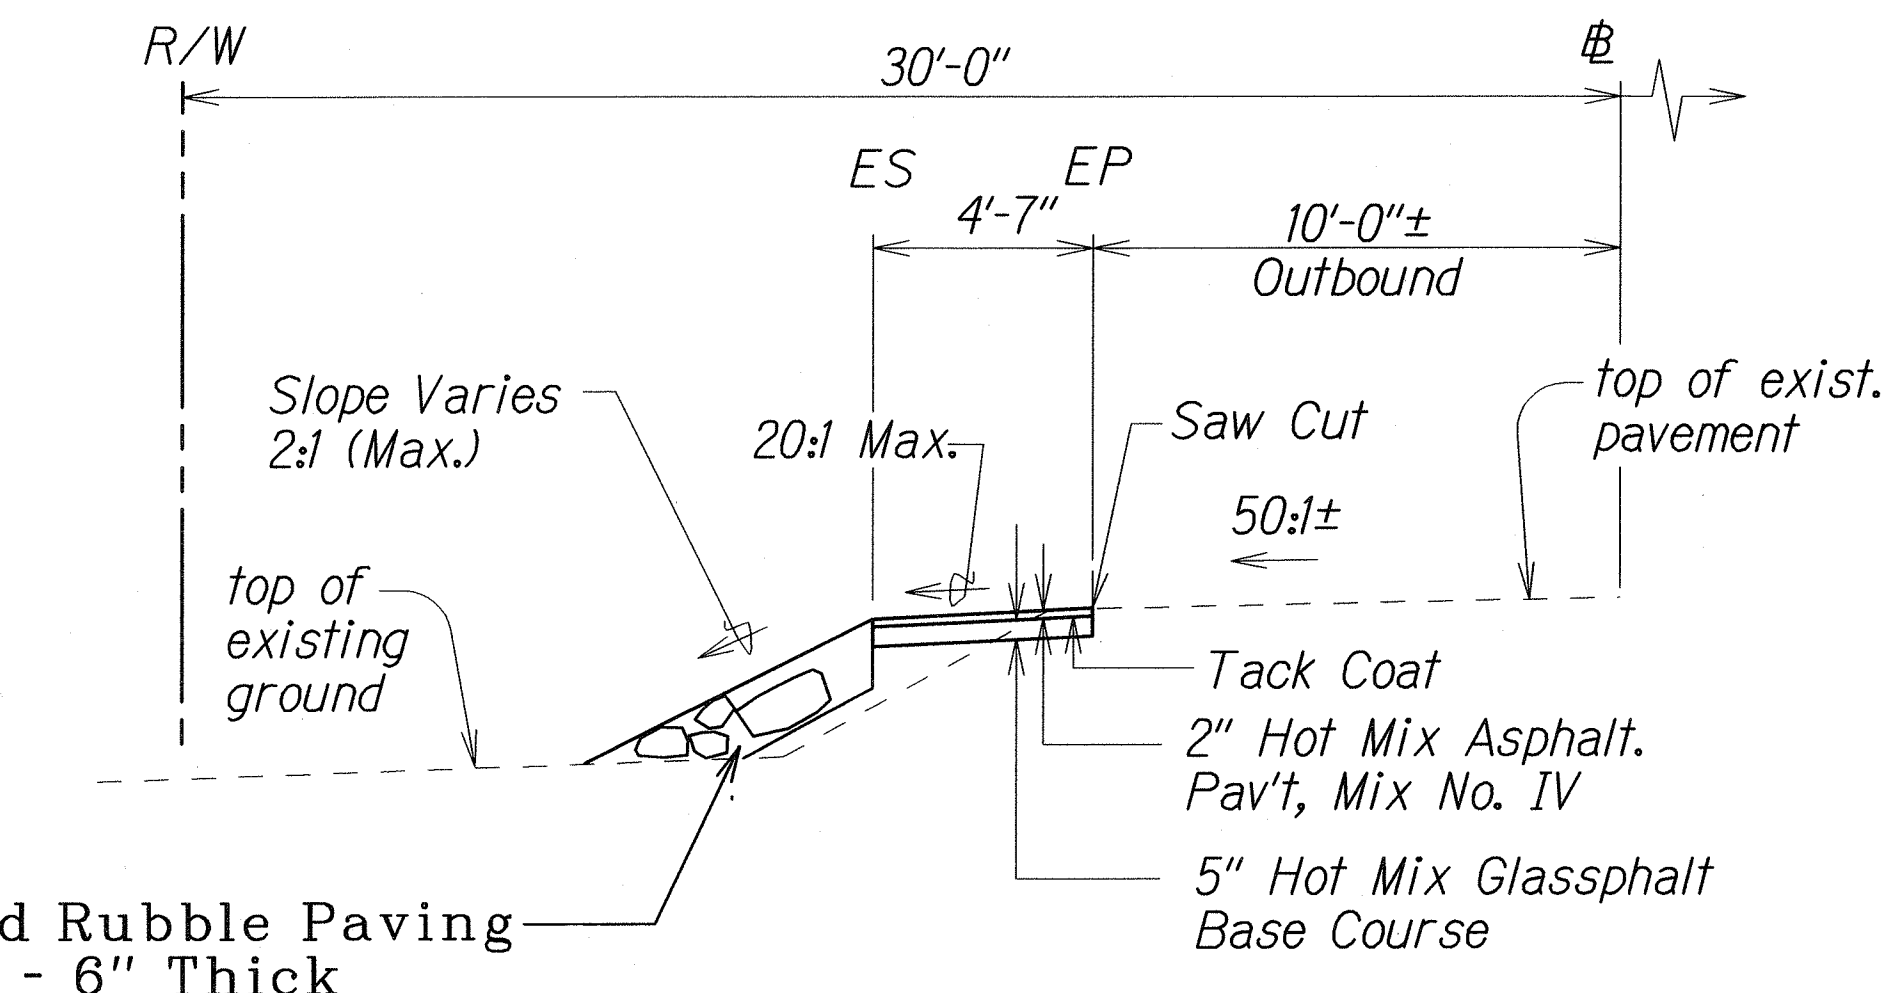

PARTIAL TYPICAL SECTION
STA. 194+95.5 LT. TO STA. 195+42 LT. (OUTBOUND)
STA. 195+13± LT. (BEGIN GRP)

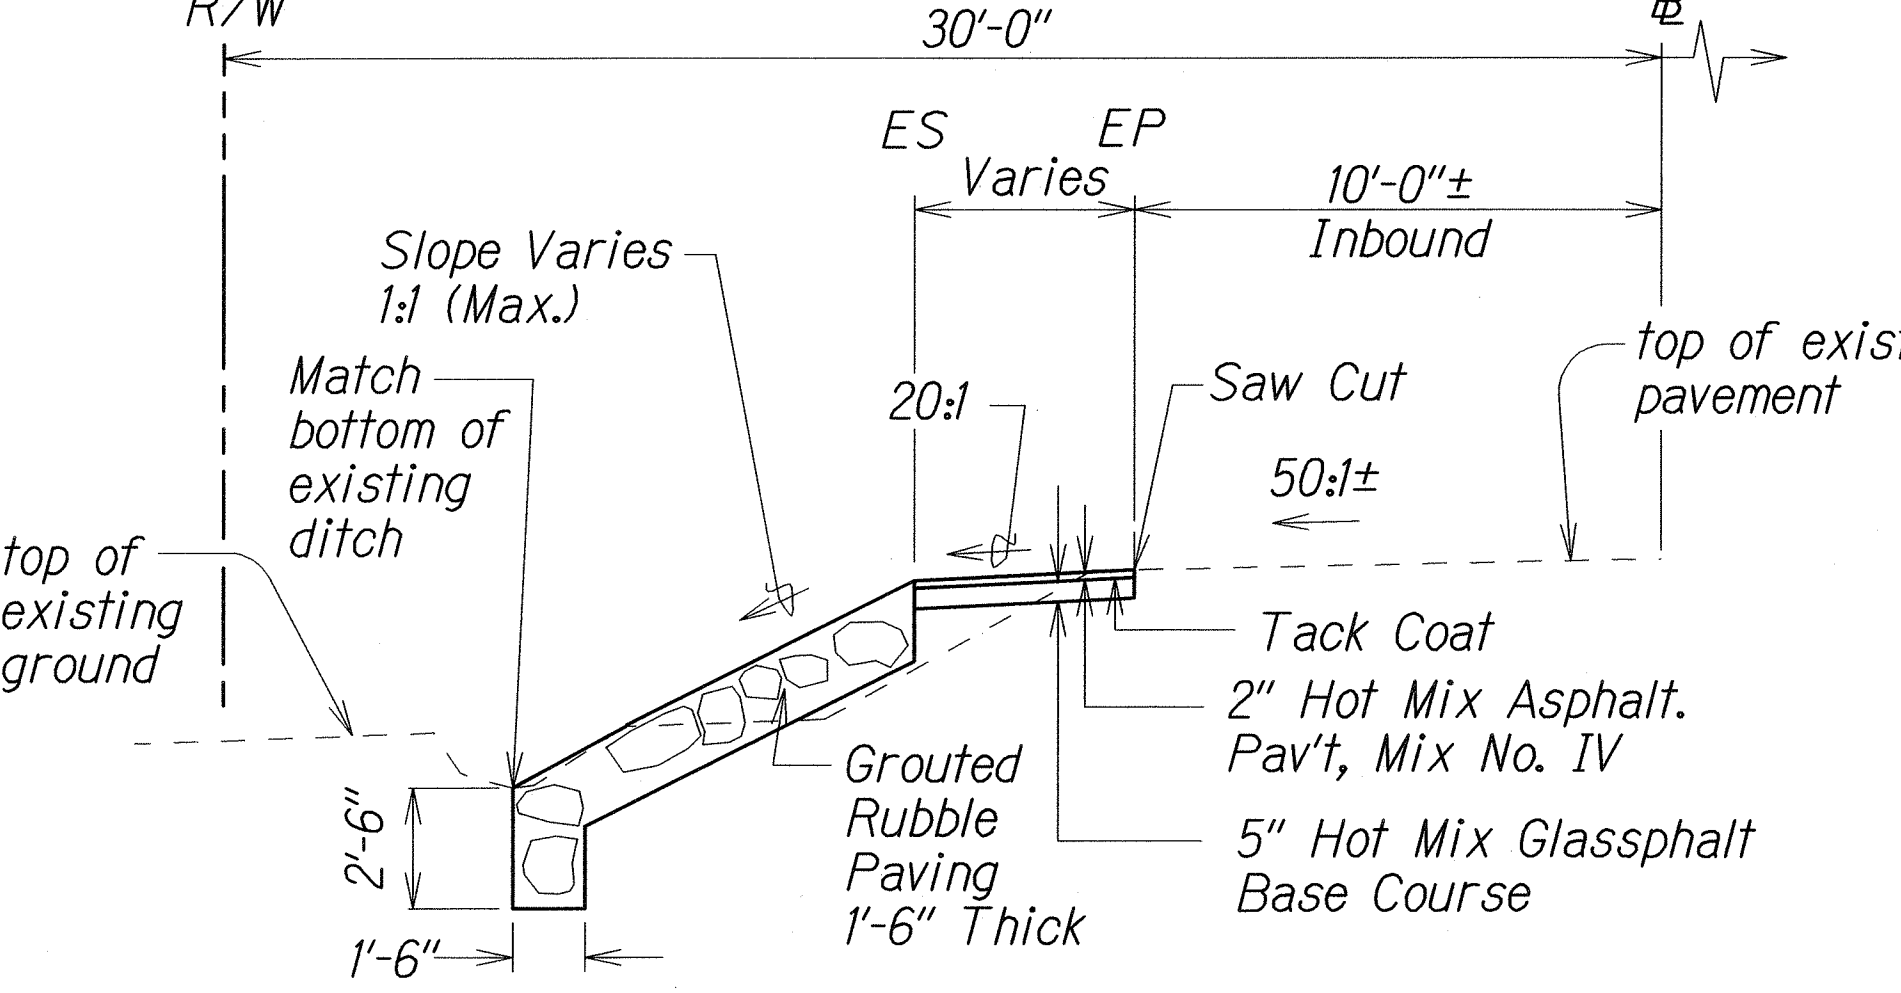

PARTIAL TYPICAL SECTION
STA. 195+42 LT. TO STA. 195+58 LT. (OUTBOUND)

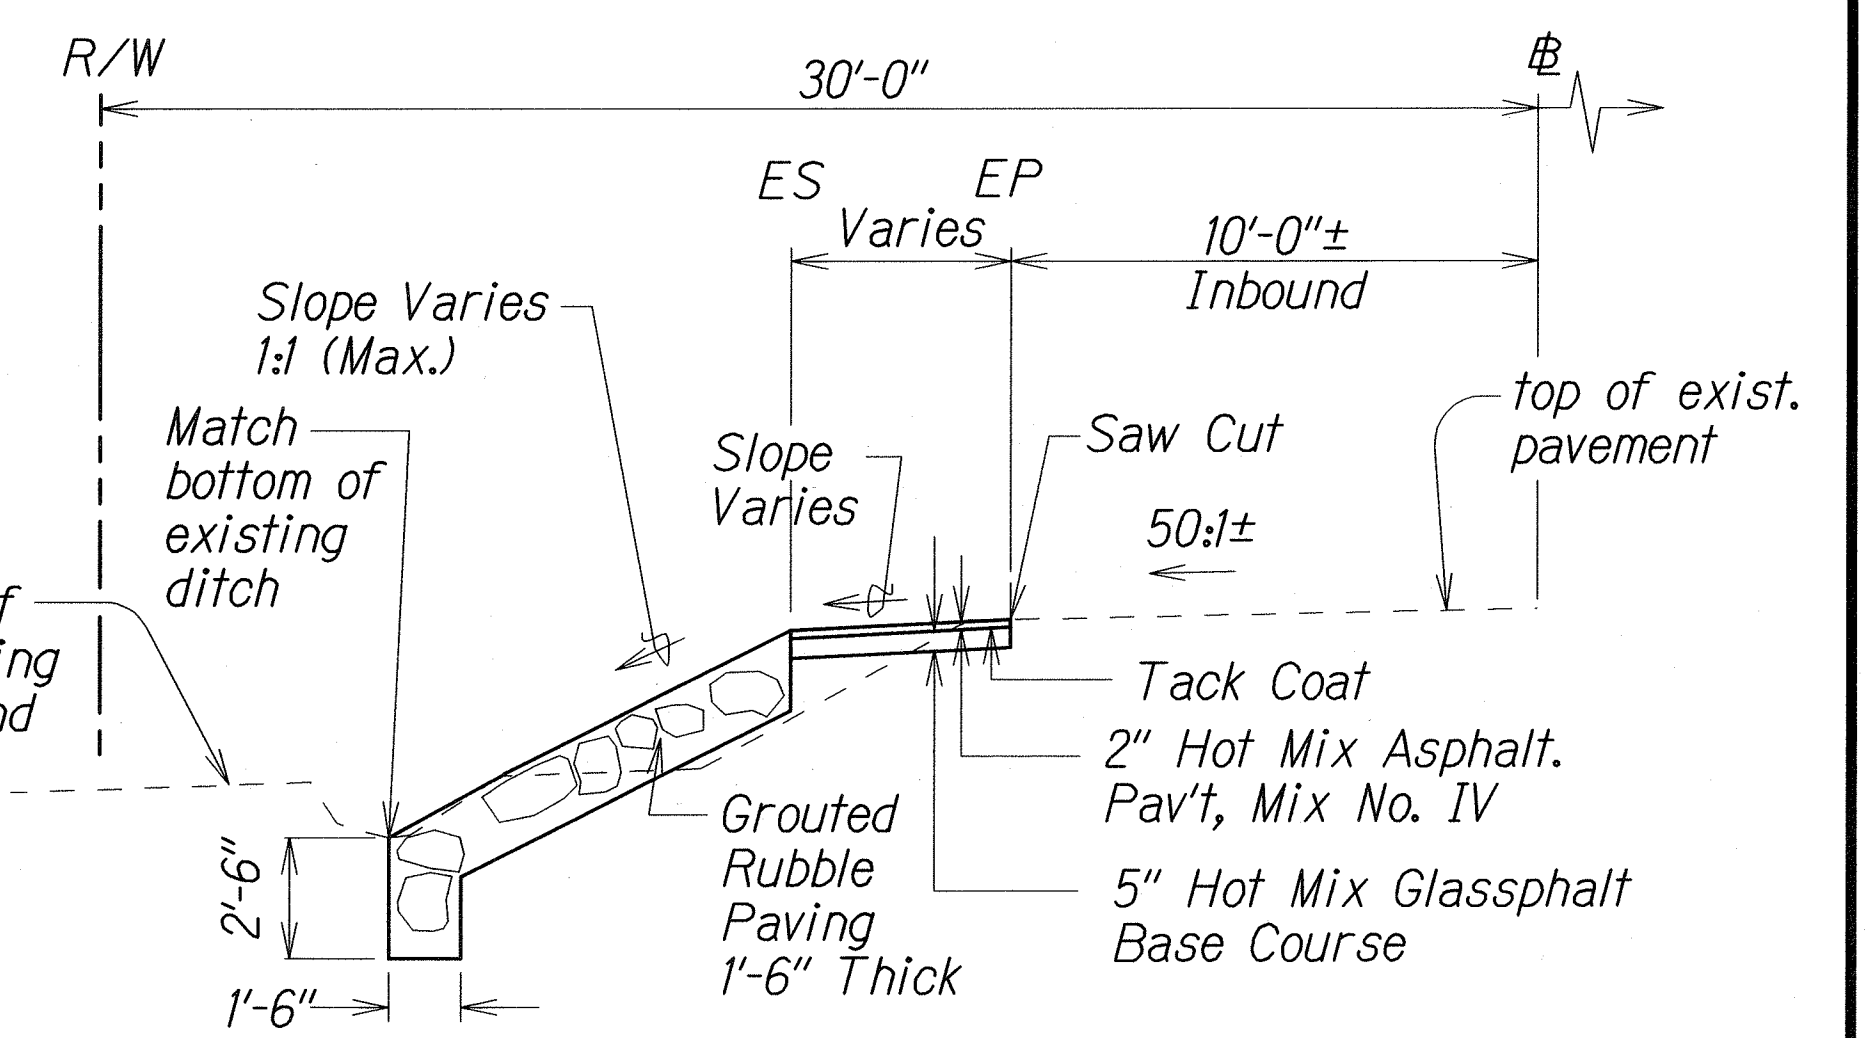

PARTIAL TYPICAL SECTION
STA. 195+58 LT. TO STA. 195+77.8 LT. (OUTBOUND)

LEGEND FOR AS-BUILT POSTINGS	
	Squiggly line for as-built deletion
	Double line for as-built deletion
Roadway	Text for as-built posting

STATE OF HAWAII
DEPARTMENT OF TRANSPORTATION
HIGHWAYS DIVISION

TYPICAL SECTIONS
KOHALA MOUNTAIN ROAD
DRAINAGE IMPROVEMENTS, PHASE 3
VICINITY OF M.P. 13.47
Project No. 250A-03-09
Scale: 1/4"=1'-0" Date: May, 2008
SHEET No. 1 OF 1 SHEETS

SURVEY PLOTTED BY	DATE
DRAWN BY	
NOTED BY	
CHECKED BY	
DATE	